
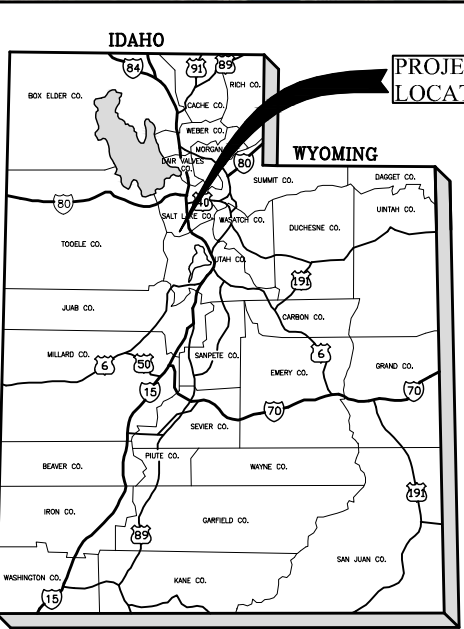
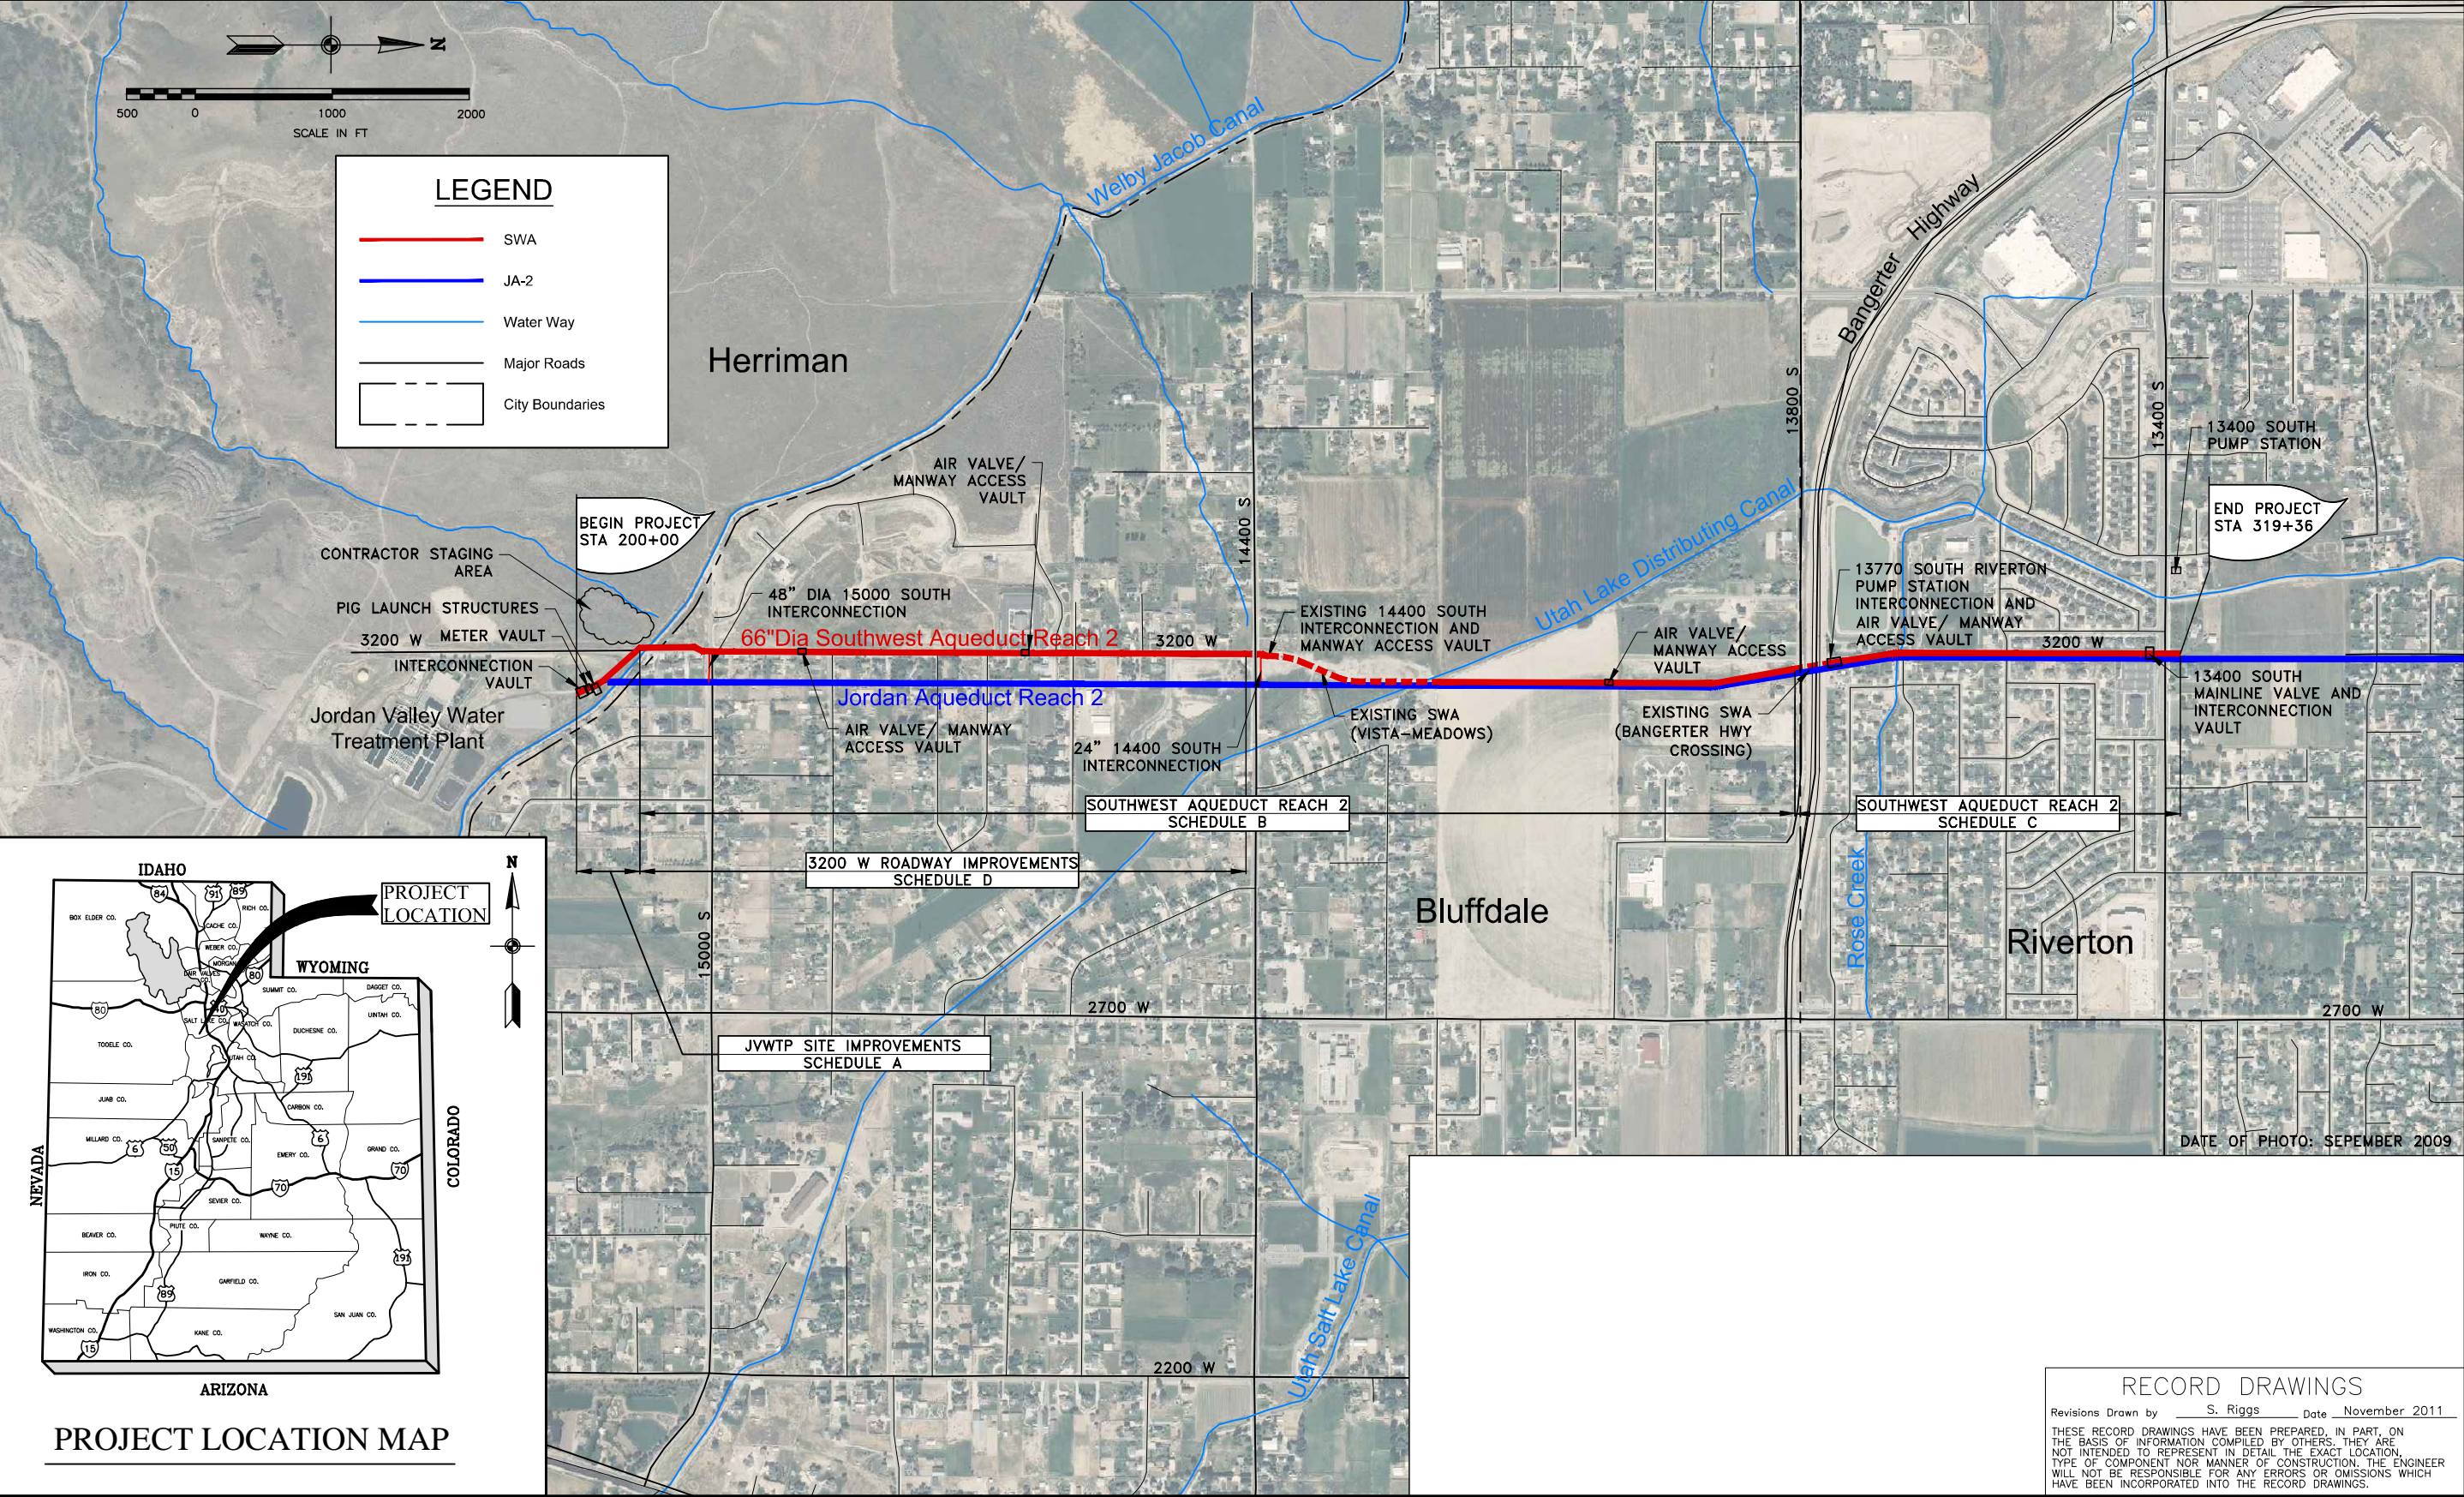


DRAWINGS FOR CONSTRUCTION OF
SOUTHWEST AQUEDUCT REACH 2 PROJECT
Jordan Valley Water Conservancy District

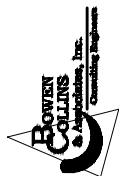

PROJECT LOCATION MAP

JORDAN VALLEY WATER CONSERVANCY DISTRICT
SOUTHWEST AQUEDUCT REACH 2 PROJECT


GENERAL
PROJECT LOCATION MAP,
AND VICINITY MAP
DATE: FEBRUARY 2010 PROJECT 010-08-03
NUMBER

NO.	DATE	REV. BY	DESCRIPTION	REVISIONS

DESIGN	REVIEW	VERIFY SCALE
DESIGN T. OLSEN	CHECKED M. COLLINS	BAR IS ONE INCH ON ORIGINAL DRAWING
DRAWN R. GARCIA	APPROVED J. LUETTINGER	

RECORD DRAWINGS
Revisions Drawn by S. Riggs Date November 2011
THESE RECORD DRAWINGS HAVE BEEN PREPARED, IN PART, ON THE BASIS OF INFORMATION COMPILED BY OTHERS. THEY ARE NOT INTENDED TO REPRESENT IN DETAIL THE EXACT LOCATION, TYPE OF COMPONENT NOR MANNER OF CONSTRUCTION. THE ENGINEER WILL NOT BE RESPONSIBLE FOR ANY ERRORS OR OMISSIONS WHICH HAVE BEEN INCORPORATED INTO THE RECORD DRAWINGS.

DRAWING NO.
G-1
SHEET 1 OF 110

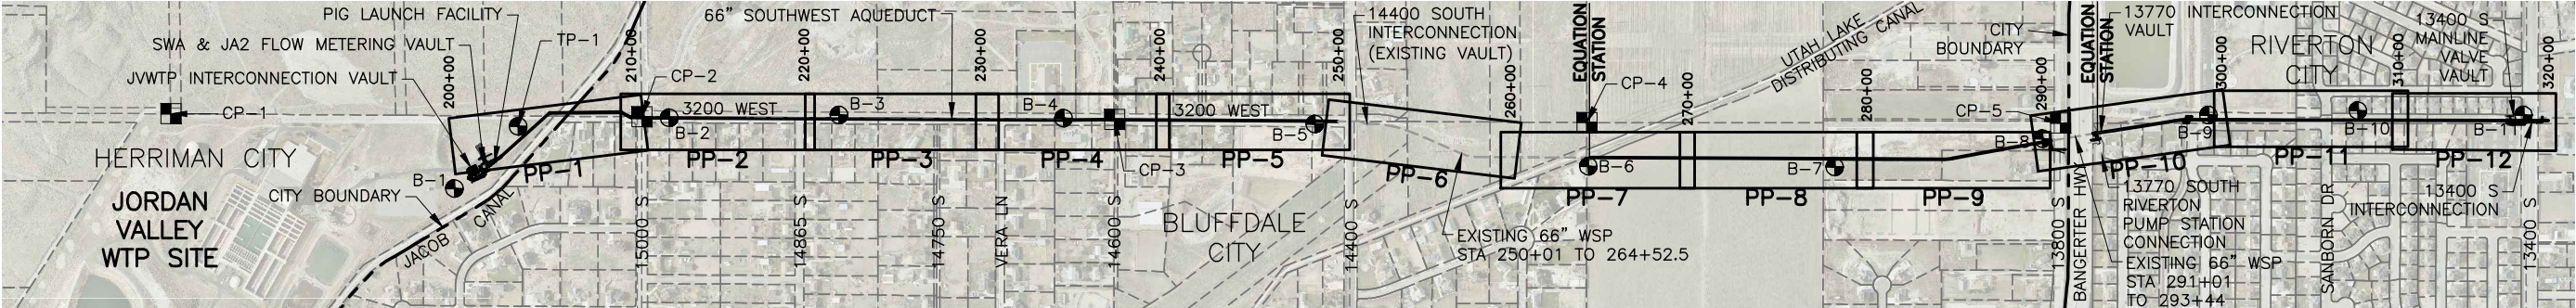

EXISTING SWA
VISTA MEADOWS
REACH (NIC)

EXISTING SWA
BANGERTE HIGHWAY
REACH (NIC)

HORIZONTAL CONTROL: LOCAL
VERTICAL CONTROL: NAVD 88
SURVEY CONTROL AND TOPOGRAPHIC MAP ARE BASED ON INFORMATION
PROVIDED BY: ROBINSON, BIEHN, AND BIEHN, INC. PROFESSIONAL LAND
SURVEYORS. SALT LAKE CITY, UTAH 84117. (801) 266-1118
CONTACT: TED BIEHN, PLS

 = GEOTECHNICAL BORING LOCATION

NUMBER	NORTHING	EASTING	NAVD 88 ELEV	DESCRIPTION	BC = BRASS CAP R&L = RING AND LID
CP1	N 27452.19	E 59061.70	4787.31	BC MONUMENT	
CP2	N 30095.14	E 59078.20	4693.84	BC MONUMENT	
CP3	N 32745.43	E 59094.46	4617.35	BC MONUMENT	
CP4	N 35395.63	E 59111.13	4573.44	BC MONUMENT	
CP5	N 38051.96	E 59114.27	4546.06	BC MONUMENT	


1. SEE PP SHEETS FOR UTILITY POTHOLE LOCATIONS.
2. GEOTECHNICAL INVESTIGATION REPORT PROVIDED BY
GEOSTRATA
781 WEST 14600 SOUTH
BLUFFDALE, UT 84065
(801) 501-0583
CONTACT: HIRAM ALBA, P.E., P.G.

1. OWNER HAS PREPURCHASE STEEL MATERIALS 6-INCH IN DIAMETER AND LARGER. CONTRACTOR WILL BE ASSIGNED THE OWNERS PURCHASE ORDER FOLLOWING NOTICE OF AWARD. CONTRACTOR SHALL REVIEW STEEL PIPE PREPURCHASE DOCUMENTS PRIOR TO BID. ADDITIONAL PIPE MATERIALS REQUIRED FOR CONTRACTORS INSTALLATION PLAN INCLUDING DISHD HEADS, WELD PASS HOLES, CUT TO FIT SECTIONS, BUTTSTRAPS, ETC. NOT INCLUDED IN THE PREPURCHASE DOCUMENTS SHALL BE PROVIDE BY THE CONTRACTOR.
2. CONTRACTOR SHALL COORDINATE DELIVERING AND SHALL BE RESPONSIBLE FOR OFF-LOADING AND STORAGE PRIOR TO INSTALLATION. REFER TO THE SPECIFICATIONS FOR DETAILS.

Revisions Drawn by S. Riggs Date November 2011

THESE RECORD DRAWINGS HAVE BEEN PREPARED, IN PART, ON THE BASIS OF INFORMATION COMPILED BY OTHERS. THEY ARE NOT INTENDED TO REPRESENT IN DETAIL THE EXACT LOCATION, TYPE OF COMPONENT NOR MANNER OF CONSTRUCTION. THE ENGINEER WILL NOT BE RESPONSIBLE FOR ANY ERRORS OR OMISSIONS WHICH HAVE BEEN INCORPORATED INTO THE RECORD DRAWINGS.

SOUTHWEST AQUEDUCT REACH 2 OVERALL PROFILE & HYDROSTATIC TEST DATA

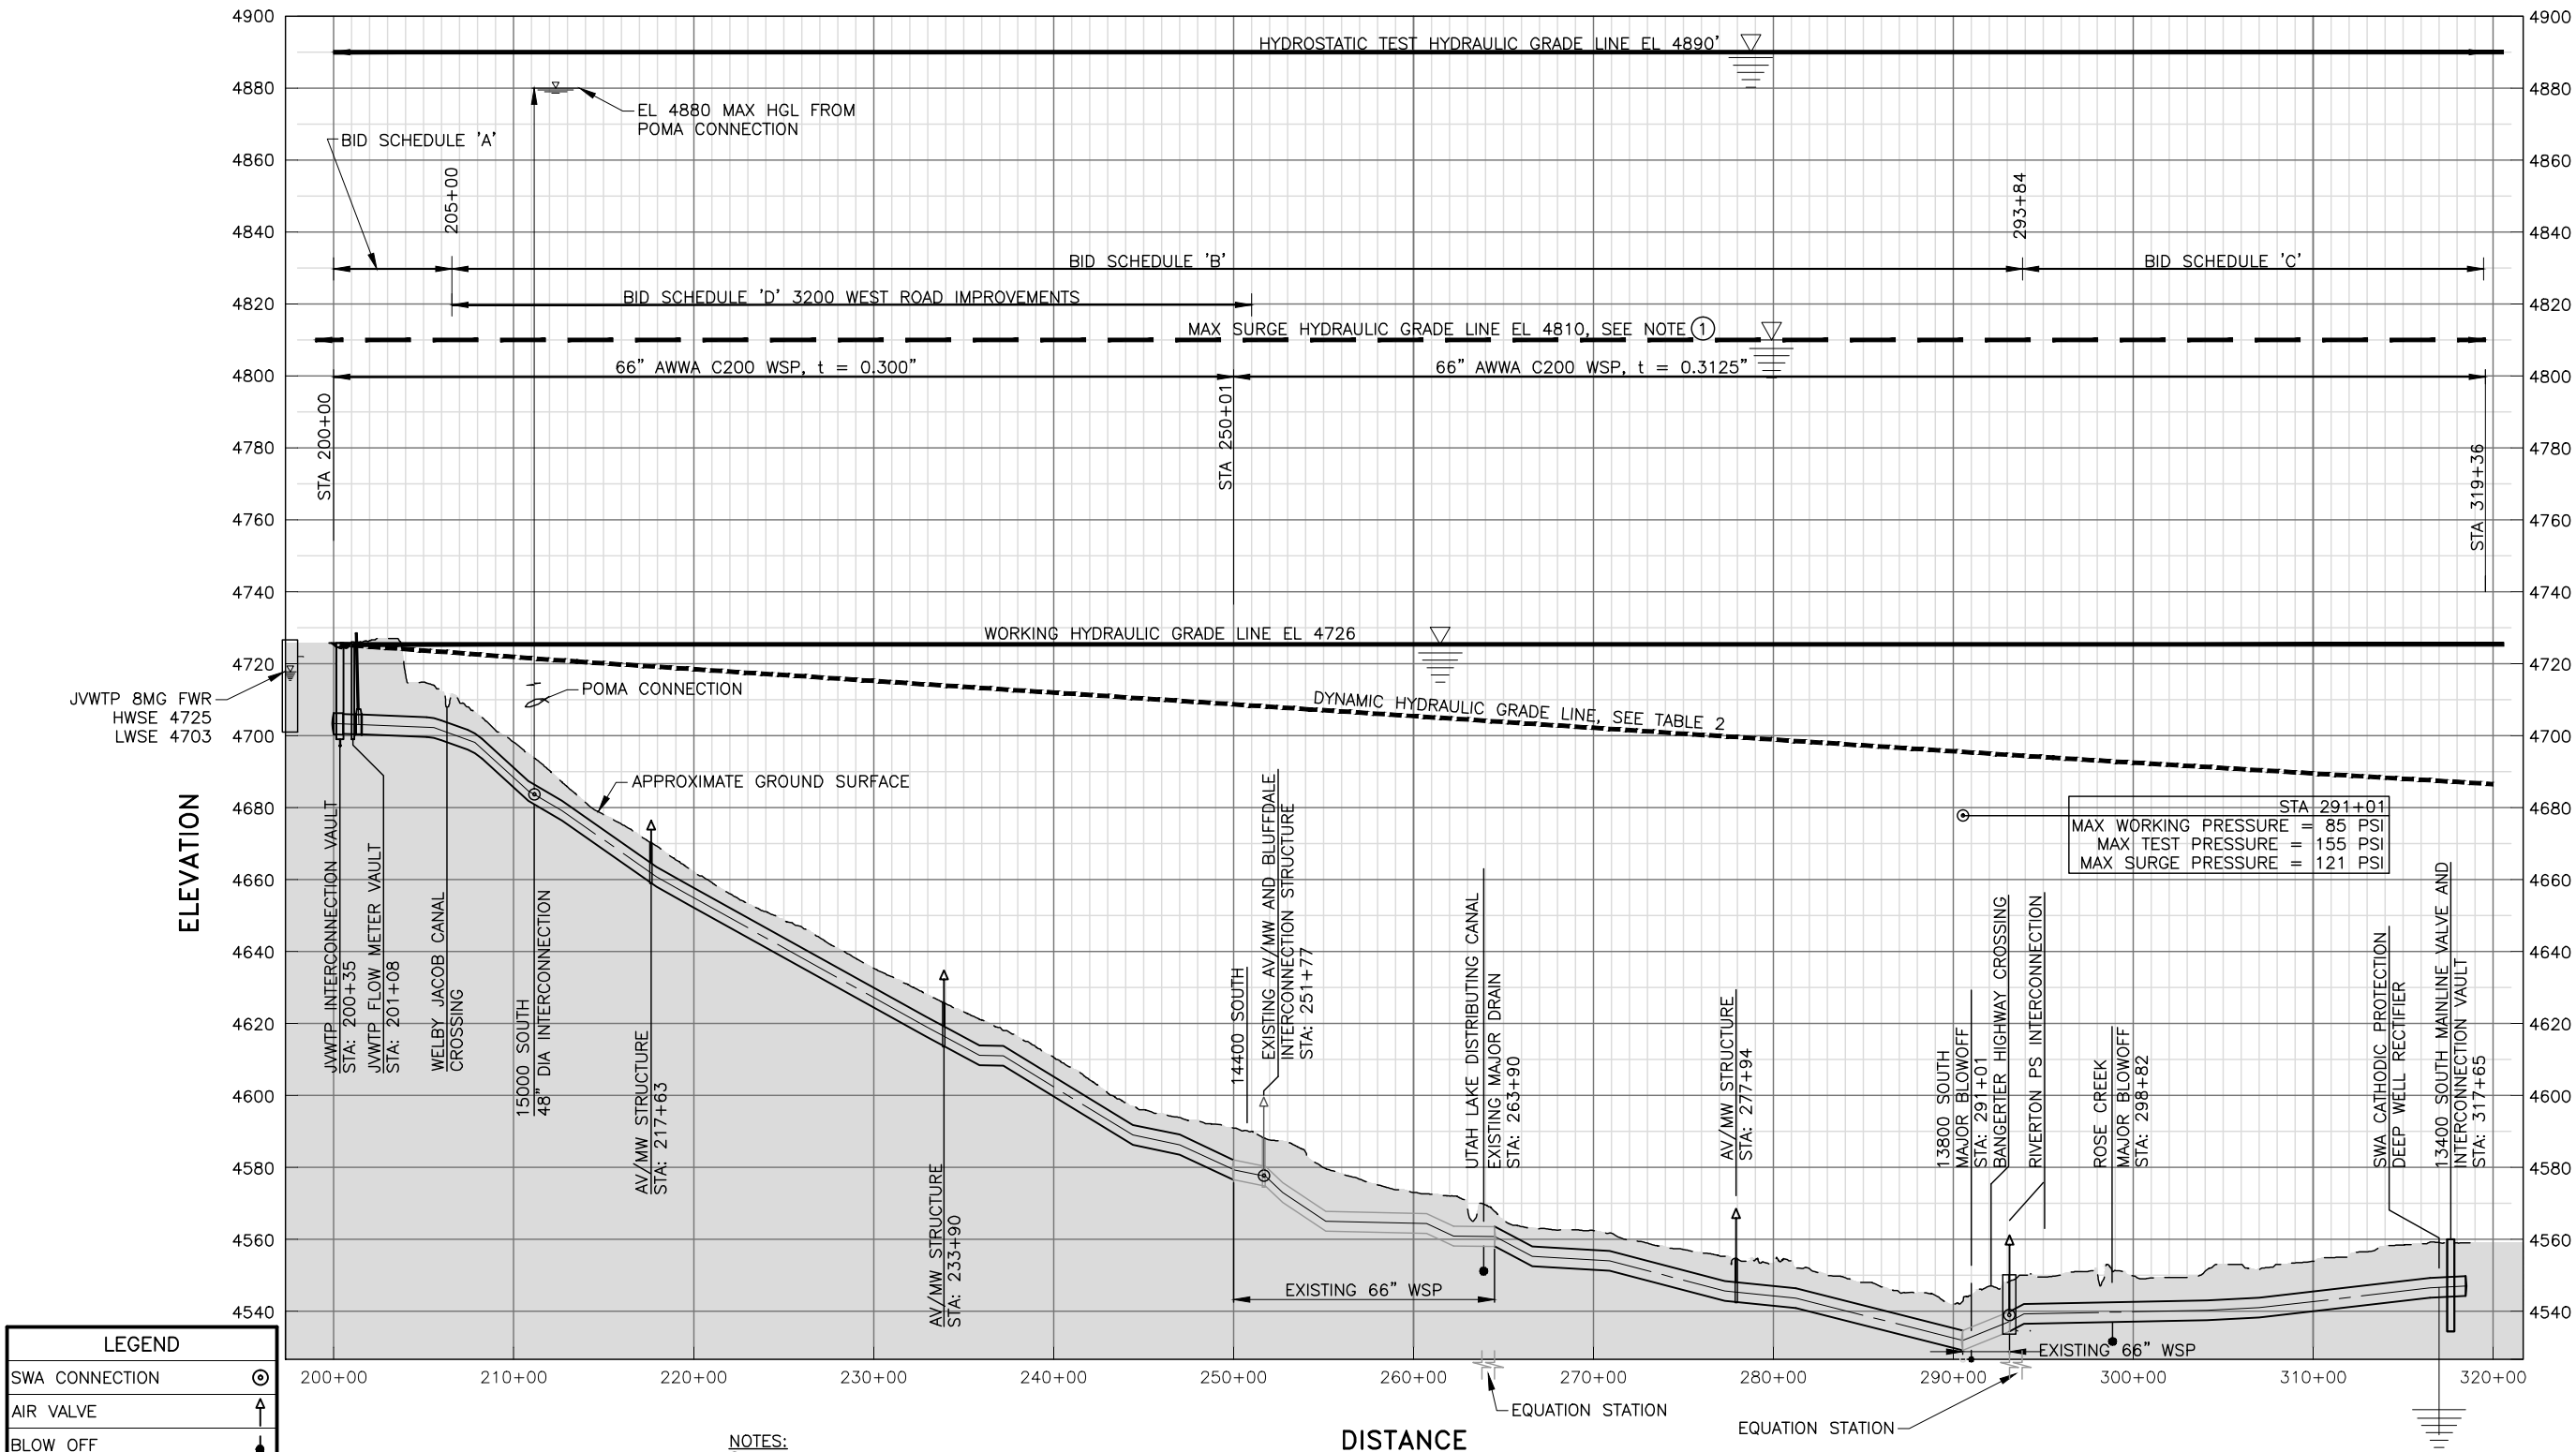

LEGEND	
SWA CONNECTION	⊙
AIR VALVE	↑
BLOW OFF	•

TABLE 1 HYDRAULIC CAPACITY	
EXISTING JWTP CAPACITY	180 mgd (279 cfs)
FUTURE JWTP CAPACITY	255 mgd (395 cfs)
JA-2 MAX CAPACITY (3)	158 mgd (245 cfs)
SWA MAX CAPACITY	120 mgd (185 cfs)
FUTURE CWP CAPACITY	22.6 mgd (35 cfs)
WATER SURFACE ELEVATION AT JWTP	4725 feet
HAZEN WILLIAMS "C"	120

- NOTES:
- ① BASED UPON DATA PROVIDED IN "JWCD SURGE ANALYSIS - SOUTHWEST BOOSTER PUMP STATION" BY CH2M HILL DATED AUGUST 21, 2006.
- ② ELEVATIONS REFERENCE THE NAVD 88 VERTICAL DATUM
- ③ EXPECTED DEMANDS WERE OBTAINED FROM THE DEMAND, SUPPLY AND MAJOR CONVEYANCE STUDY COMPLETED BY BOWEN, COLLINS & ASSOCIATES, JANUARY 2005

TABLE 2 SWA CONNECTIONS HYDRAULIC INFORMATION					
SWA CONNECTION LOCATION	APPROX STATION	AGENCY RECIVING SWA WATER	EXPECTED DEMANDS AT CONNECTIONS (3)		SWA APPROX HGL (ft)
			(mgd)	(cfs)	
15000 SOUTH (FUTURE)	210+86	HERRIMAN CITY	2	3	4722
15000 SOUTH	210+86	JWCD	6.08	9.4	4722
14400 SOUTH	251+66	BLUFFDALE CITY	4	6	4712
RIVERTON PUMP STATION	293+95	RIVERTON CITY	2	3	4703
13400 SOUTH	317+03	SOUTH JORDAN	20.7	32	4698

RECORD DRAWINGS

Revisions Drawn by S. Riggs Date November 2011

THESE RECORD DRAWINGS HAVE BEEN PREPARED, IN PART, ON THE BASIS OF INFORMATION COMPILED BY OTHERS. THEY ARE NOT INTENDED TO REPRESENT IN DETAIL THE EXACT LOCATION, TYPE OF COMPONENT NOR MANNER OF CONSTRUCTION. THE ENGINEER WILL NOT BE RESPONSIBLE FOR ANY ERRORS OR OMISSIONS WHICH HAVE BEEN INCORPORATED INTO THE RECORD DRAWINGS.

JORDAN VALLEY WATER CONSERVANCY DISTRICT

SOUTHWEST AQUEDUCT REACH 2 PROJECT

DESIGN

DESIGN T. OLSEN

DRAWN R. DARGER

REVIEW

CHECKED M. COLLINS

APPROVED J. LUTTINGER

VERIFY SCALE

BAR IS ONE INCH ON ORIGINAL DRAWING

NO.

DATE

REV. BY

DESCRIPTION

REVISIONS

GENERAL

OVERALL HYDRAULIC PROFILE AND DESIGN CRITERIA

PROJECT NUMBER 010-08-03

DATE: FEBRUARY 2010

DRAWING NO. G-3

SHEET 3 OF 110

INDEX OF DRAWINGS

SHT NO.	DWG NO.	DESCRIPTION	CAD FILE NAME
GENERAL			
1	G-1	PROJECT LOCATION MAP, AND VICINITY MAP	0100803_G-01.dwg
2	G-2	DRAWING INDEX MAP, HORIZONTAL ALIGNMENT CONTROL, AND SURVEY CONTROL	0100803_G-02.dwg
3	G-3	OVERALL HYDRAULIC PROFILE AND DESIGN CRITERIA	0100803_G-03.dwg
4	G-4	INDEX TO DRAWINGS	0100803_G-04.dwg
5	G-5	GENERAL NOTES, AND SYMBOLS	0100803_G-05.dwg
6	G-6	ABBREVIATIONS	0100803_G-06.dwg
7	G-7	SYMBOLS	0100803_G-07.dwg
PLAN & PROFILES			
8	PP-1	SWA PLAN & PROFILE - 1 STA 200+00 TO STA 209+00	0100803_PP-01.dwg
9	PP-2	SWA PLAN & PROFILE - 2 STA 209+00 TO STA 219+00	0100803_PP-02.dwg
10	PP-3	SWA PLAN & PROFILE - 3 STA 219+00 TO STA 229+00	0100803_PP-03.dwg
11	PP-4	SWA PLAN & PROFILE - 4 STA 229+00 TO STA 239+00	0100803_PP-04.dwg
12	PP-5	SWA PLAN & PROFILE - 5 STA 239+00 TO STA 249+00	0100803_PP-05.dwg
13	PP-6	SWA PLAN & PROFILE - 6 STA 249+00 TO STA 259+00	0100803_PP-06.dwg
14	PP-7	SWA PLAN & PROFILE - 7 STA 259+00 TO STA 270+00	0100803_PP-07.dwg
15	PP-8	SWA PLAN & PROFILE - 8 STA 270+00 TO STA 280+00	0100803_PP-08.dwg
16	PP-9	SWA PLAN & PROFILE - 9 STA 280+00 TO STA 290+00	0100803_PP-09.dwg
17	PP-10	SWA PLAN & PROFILE - 10 STA 290+00 TO STA 300+00	0100803_PP-10.dwg
18	PP-11	SWA PLAN & PROFILE - 11 STA 300+00 TO STA 310+00	0100803_PP-11.dwg
19	PP-12	SWA PLAN & PROFILE - 12 STA 310+00 TO STA 319+36.38	0100803_PP-12.dwg
20	PP-13	15000 S. AND 14400 S. INTERCONNECTION PLAN & PROFILE	0100803_PP-13.dwg
21	PP-14	13400 S. PUMP STATION INTERCONNECTION PLAN AND PROFILE	0100803_PP-14.dwg
CIVIL			
22	C-1	ENLARGED CIVIL PLANS (JVWTP INTERCONNECTION, METER VAULT, AND PIG LAUNCH VAULT)	0100803_C-01.dwg
23	C-2	ENLARGED CIVIL PLANS (RIVERTON PUMP STATION)	0100803_C-02.dwg
24	C-3	ENLARGED CIVIL PLANS (13400 SOUTH MAINLINE INTERCONNECTION PIPING AND VAULT)	0100803_C-03.dwg
25	C-4	PROFILES - 1	0100803_C-04.dwg
26	C-4A	PROFILES - 2	0100803_C-04A.dwg
27	C-5	CROSS SECTIONS	0100803_C-05.dwg
28	C-6	CROSS SECTIONS	0100803_C-06.dwg
29	C-7	EXISTING JA-2 PIG LAUNCH STRUCTURE DEMOLITION	0100803_C-07.dwg
30	C-8	CATHODIC PROTECTION DETAILS	0100803_C-08.dwg
31	C-9	CATHODIC PROTECTION DETAILS	0100803_C-09.dwg
32	C-10	CATHODIC PROTECTION DETAILS	0100803_C-10.dwg
33	C-11	CATHODIC PROTECTION DETAILS	0100803_C-11.dwg
34	C-12	CATHODIC PROTECTION DETAILS	0100803_C-12.dwg
35	C-13	3200 WEST ROAD IMPROVEMENTS OVERALL PLAN	0100803_C-13.dwg
36	C-14	3200 WEST CONSTRUCTION SCHEDULE AND DETOUR PLAN	0100803_C-14.dwg
37	C-15	3200 WEST PRIVATE IMPROVEMENTS AND DEMOLITION PLAN-1	0100803_C-15.dwg
38	C-16	3200 WEST PRIVATE IMPROVEMENTS AND DEMOLITION PLAN-2	0100803_C-16.dwg
39	C-16A	SCHEDULE OF PRIVATE IMPROVEMENTS	0100803_C-16A.dwg
40	C-17	PLAN AND PROFILE-1 STA 100+00 TO STA 105+00	0100803_C-17.dwg
41	C-18	PLAN AND PROFILE-2 STA 105+00 TO STA 110+00	0100803_C-18.dwg
42	C-19	PLAN AND PROFILE-3 STA 110+00 TO STA 115+00	0100803_C-19.dwg
43	C-20	PLAN AND PROFILE-4 STA 115+00 TO STA 120+00	0100803_C-20.dwg
44	C-21	PLAN AND PROFILE-5 STA 120+00 TO STA 125+00	0100803_C-21.dwg
45	C-22	PLAN AND PROFILE-6 STA 125+00 TO STA 130+00	0100803_C-22.dwg
46	C-23	PLAN AND PROFILE-7 STA 130+00 TO STA 135+00	0100803_C-23.dwg
47	C-24	PLAN AND PROFILE-8 STA 135+00 TO STA 140+00	0100803_C-24.dwg
48	C-25	PLAN AND PROFILE-9 STA 140+00 TO STA 145+00	0100803_C-25.dwg
49	C-26	TYPICAL ROAD SECTIONS	0100803_C-26.dwg
50	C-27	TYPICAL ROAD SECTIONS	0100803_C-27.dwg
51	C-28	TYPICAL ROAD SECTIONS	0100803_C-28.dwg

INDEX OF DRAWINGS

SHT NO.	DWG NO.	DESCRIPTION	CAD FILE NAME
52	C-29	3200 WEST STORM DRAIN LATERAL PROFILES	0100803_C-29.dwg
53	C-30	3200 WEST STRIPING PLAN	0100803_C-30.dwg
54	C-31	3200 WEST STRIPING PLAN	0100803_C-31.dwg
55	GC-1	CIVIL DETAILS - 1	0100803_DC-01.dwg
56	GC-2	CIVIL DETAILS - 2	0100803_DC-02.dwg
57	GC-3	CIVIL DETAILS - 3	0100803_DC-03.dwg
58	GC-4	CIVIL DETAILS - 4	0100803_DC-04.dwg
59	GC-5	CIVIL DETAILS - 5	0100803_DC-05.dwg
60	PA-1	TYPICAL AIR VALVE-MANWAY FLOOR PLAN AND ROOF PLAN	0100803_PA-01.dwg
61	PA-2	RIVERTON PUMP STATION AIR VALVE-MANWAY FLOOR PLAN AND ROOF PLAN	0100803_PA-02.dwg
62	PA-3	ROSE CREEK CROSSING	0100803_PA-03.dwg
63	PA-4	JVWTP BLOWW-OFF STRUCTURE	0100803_PA-04.dwg
MECHANICAL			
64	M-1	MECHANICAL EQUIPMENT SCHEDULES	0100803_M-01.dwg
65	M-2	JVWTP CONNECTION VAULT - PLAN	0100803_M-02.dwg
66	M-3	JVWTP CONNECTION VAULT - SECTIONS	0100803_M-03.dwg
67	M-4	JVWTP CONNECTION VAULT - SECTIONS	0100803_M-04.dwg
68	M-5	METER VAULT - PLAN	0100803_M-05.dwg
69	M-6	METER VAULT - SECTION	0100803_M-06.dwg
70	M-7	SWA AND JA-2 PIG LAUNCH STRUCTURES	0100803_M-07.dwg
71	M-8	13400 SOUTH MAINLINE VALVE AND INTERCONNECTION VAULT - PLAN	0100803_M-08.dwg
72	M-9	13400 SOUTH MAINLINE VALVE AND INTERCONNECTION VAULT - SECTION	0100803_M-09.dwg
73	M-10	13400 SOUTH MAINLINE VALVE AND INTERCONNECTION VAULT - SECTION	0100803_M-10.dwg
74	M-11	15000 SOUTH VAULT INSULATION PLAN	0100803_M-11.dwg
75	GM-1	GENERAL MECHANICAL DETAILS - 1	0100803_GM-01.dwg
76	GM-2	GENERAL MECHANICAL DETAILS - 2	0100803_GM-02.dwg
77	GM-3	GENERAL MECHANICAL DETAILS - 3	0100803_GM-03.dwg
78	GM-4	GENERAL MECHANICAL DETAILS - 4	0100803_GM-04.dwg
STRUCTURAL			
79	S-1	JVWTP INTERCONNECTION VAULT FLOOR AND ROOF PLAN	0100803_S-01.dwg
80	S-2	JVWTP INTERCONNECTION VAULT SECTIONS	0100803_S-02.dwg
81	S-3	JVWTP INTERCONNECTION VAULT SECTIONS	0100803_S-03.dwg
82	S-4	METER VAULT FLOOR AND ROOF PLAN	0100803_S-04.dwg
83	S-5	METER VAULT SECTIONS AND DETAILS	0100803_S-05.dwg
84	S-6	METER VAULT SECTIONS AND DETAILS	0100803_S-06.dwg
85	S-7	13400 SOUTH MAINLINE VALVE AND INTERCONNECTION VAULT STRUCTURAL PLAN	0100803_S-07.dwg
86	S-8	13400 SOUTH MAINLINE VALVE AND INTERCONNECTION VAULT STRUCTURAL SECTION	0100803_S-08.dwg
87	S-9	13400 SOUTH MAINLINE VALVE AND INTERCONNECTION VAULT STRUCTURAL SECTION	0100803_S-09.dwg
88	S-10	13400 SOUTH MAINLINE VALVE AND INTERCONNECTION VAULT - SECTION	0100803_S-10.dwg
89	GS-1	GENERAL STRUCTURAL NOTES	0100803_GS-01.dwg
90	GS-2	GENERAL STRUCTURAL DETAILS - 1	0100803_GS-02.dwg
91	GS-3	GENERAL STRUCTURAL DETAILS - 2	0100803_GS-03.dwg
92	GS-4	GENERAL STRUCTURAL DETAILS - 3	0100803_GS-04.dwg
93	GS-5	GENERAL STRUCTURAL DETAILS - 4	0100803_GS-05.dwg
94	GS-6	GENERAL STRUCTURAL DETAILS - 5	0100803_GS-06.dwg
95	GS-7	GENERAL STRUCTURAL DETAILS - 6	0100803_GS-06.DWG
96	GS-8	GENERAL STRUCTURAL DETAILS - 7	0100803_GS-06.DWG
ELECTRICAL			
97	E-1	ELECTRICAL LEGEND, SCHEDULE AND NOTES	0100803_E-01.dwg
98	E-2	JVWTP INTERCONNECTION AND METER VAULT ELECTRICAL SITE PLAN	0100803_E-02.dwg
99	E-3	JVWTP INTERCONNECTION VAULT ELECTRICAL PLAN	0100803_E-03.dwg
100	E-4	METER VAULT ELECTRICAL PLAN	0100803_E-04.dwg

INDEX OF DRAWINGS

SHT NO.	DWG NO.	DESCRIPTION	CAD FILE NAME
101	E-5	JVWTP INTERCONNECTION AND METER VAULT ONE LINE DIAGRAMS	0100803_E-05.dwg
102	E-6	PUMP ROOM PANEL SCHEDULE	0100803_E-06.dwg
103	E-7	JVWTP INTERCONNECTION AND METER VAULT ONE-LINE DIAGRAM	0100803_E-07.dwg
104	E-8	13400 SOUTH MAINLINE VALVE AND INTERCONNECTION VAULT ELECTRICAL PLAN	0100803_E-08.dwg
105	E-9	13400 SOUTH MAINLINE VALVE AND INTERCONNECTION VAULT ELECTRICAL PLAN	0100803_E-09.dwg
106	E-10	13400 SOUTH VALVE AND INTERCONNECTION VAULT ONE-LINE DIAGRAMS	0100803_E-10.dwg
107	E-11	13400 SOUTH MAINLINE VALVE AND INTERCONNECTION VAULT ONE-LINE DIAGRAM	0100803_E-11.dwg
108	E-12	CONTROL SCHEMATIC DETAILS	0100803_E-12.dwg
109	E-13	ELECTRICAL DETAILS - 1	0100803_E-13.dwg
110	E-14	ELECTRICAL DETAILS - 2	0100803_E-14.dwg
BLUFFDALE CITY STANDARD DRAWINGS			
RIVERTON CITY STANDARD DRAWINGS			

RECORD DRAWINGS

Revisions Drawn by S. Riggs Date November 2011

THESE RECORD DRAWINGS HAVE BEEN PREPARED, IN PART, ON THE BASIS OF INFORMATION COMPILED BY OTHERS. THEY ARE NOT INTENDED TO REPRESENT IN DETAIL THE EXACT LOCATION, TYPE OF COMPONENT NOR MANNER OF CONSTRUCTION. THE ENGINEER WILL NOT BE RESPONSIBLE FOR ANY ERRORS OR OMISSIONS WHICH HAVE BEEN INCORPORATED INTO THE RECORD DRAWINGS.

JORDAN VALLEY WATER CONSERVANCY DISTRICT

SOUTHWEST AQUEDUCT REACH 2 PROJECT

GENERAL

INDEX OF DRAWINGS

PROJECT NUMBER 010-08-03

DESIGN T. OLSEN

DRAWN B. ABEL

REVIEW CHECKED M. COLLINS

APPROVED J. LUETTINGER

DATE: FEBRUARY 2010

VERIFICATION SCALE

BAR IS ONE INCH ON ORIGINAL DRAWING

DRAWING NO. G-4

SHEET 4 OF 110


SECTION IDENTIFICATION

(1) SECTION CUT SHOWN ON DRAWING AS:




DRAWING NUMBER WHERE THE SECTION IS SHOWN (SEE NOTE)


(2) THIS SECTION IS IDENTIFIED AS:

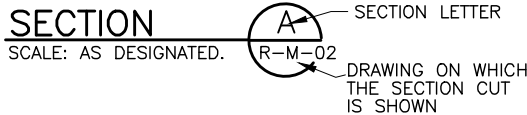

(1) DETAIL IDENTIFICATION SHOWN ON DRAWING AS:

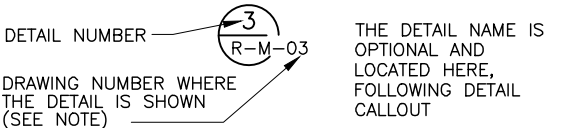


(2) THIS DETAIL IS IDENTIFIED AS:

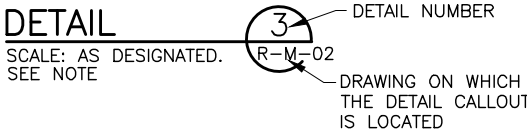

TYPICAL DETAIL IDENTIFICATION

DETAIL NAME

TYPICAL DETAIL NUMBER ON DRAWINGS WHERE DETAIL IS TAKEN AND SHOWN (SEE INDEX TO DRAWINGS FOR LOCATION OF GENERAL DRAWINGS)

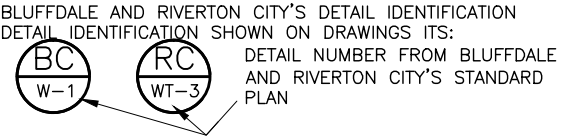

DRAWING IDENTIFICATION SYSTEM

LETTER	DISCIPLINE
G	GENERAL
C	CIVIL
S	STRUCTURAL
M	MECHANICAL
E	ELECTRICAL
PA	APPURTENANT STRUCTURES
PP	PLAN AND PROFILE
D	DETAILS
GC,GM,GS	GENERAL CIVIL, GENERAL MECHANICAL, GENERAL SRUCTURAL



NOTES:

- IF PLAN AND SECTION (OR DETAIL CALL-OUT AND DETAIL) ARE SHOWN ON SAME DRAWING, DRAWING NUMBER IS REPLACED BY A HORIZONTAL LINE.
- PREFIX LETTER INDICATES THE FOLLOWING: C-CIVIL, S-STRUCTURAL, M-MECHANICAL, E-ELECTRICAL.
- ELECTRICAL SYMBOLS SHOWN ON ELECTRICAL SHEETS FOR WELDING SYMBOLS USE AMERICAN WELDING SOCIETY STANDARD SYMBOLS. SEE AMERICAN INSTITUTE OF STEEL CONSTRUCTION MANUAL.
- IF SECTION AND/OR DETAILS ARE THE SAME SCALE AND ON THE SAME DRAWING, SEE TITLE BLOCK AT "SCALE:; THE SCALE TEXT AT CALLOUT SHALL BE OMITTED.

- SYMBOLS FOR STRUCTURES, PIPE, ETC. USED FOR IDENTIFICATION ARE SHOWN IN LEGENDS AND SHALL BE FOLLOWED THROUGHOUT THE PLANS WHENEVER APPLICABLE. NOT ALL OF THE VARIOUS COMPONENTS SHOWN IN THESE LEGENDS ARE NECESSARILY USED IN THE PROJECT.
- SCALE OF THE DRAWINGS OR DETAILS ARE SHOWN IN TITLE BLOCK OR DIRECTLY UNDER THE PLAN OR DETAIL. THE SIZE OF THE ORIGINAL PLOTTED DRAWINGS IS 22"x34". CARE SHOULD BE TAKEN TO REVIEW AND VERIFY THE SCALE BAR IN THE TITLE BLOCK AREA TO DETERMINE THE SCALE OF REDUCED REPRODUCTIONS.
- IT SHALL BE THE CONTRACTORS RESPONSIBILITY TO PERFORM CONSTRUCTION ACTIVITIES PER THE CONTRACT DOCUMENTS. ANY ADDITIONS, DELETIONS, OR MODIFICATIONS SHALL FIRST MEET WITH THE WRITTEN APPROVAL OF THE ENGINEER AND THE OWNER.
- THE CONTRACTOR SHALL KEEP ALL CONSTRUCTION ACTIVITIES WITHIN THE ESTABLISHED ROAD R/W, EASEMENTS AND DESIGNATED STAGING AREA. THIS SHALL INCLUDE BUT NOT BE LIMITED TO, VEHICLES AND EQUIPMENT, LIMITS OF TRENCH EXCAVATION, AND EXCAVATED MATERIAL AND BACKFILL STORAGE. IF THE CONTRACTOR REQUIRES ADDITIONAL CONSTRUCTION EASEMENTS, IT SHALL BE SOLELY THE CONTRACTOR'S RESPONSIBILITY TO OBTAIN SUCH EASEMENTS FROM INDIVIDUAL PROPERTY OWNERS.
- THE CONTRACTOR SHALL TAKE ALL PRECAUTIONARY MEASURES NECESSARY TO PROTECT EXISTING IMPROVEMENTS FROM DAMAGE WHICH ARE TO REMAIN IN PLACE. ALL SUCH IMPROVEMENTS OR STRUCTURES DAMAGED BY THE CONTRACTORS OPERATIONS SHALL BE REPAIRED OR RECONSTRUCTED TO ORIGINAL OR BETTER CONDITION TO THE SATISFACTION OF THE OWNER AT THE EXPENSE OF THE CONTRACTOR.
- CONTRACTOR IS SOLELY RESPONSIBLE FOR CONFORMANCE WITH LOCAL AND FEDERAL CODES GOVERNING SHORING AND BRACING OF EXCAVATIONS AND TRENCHES. CONTRACTOR IS RESPONSIBLE FOR THE SAFETY OF THE PUBLIC AND PROTECTION OF PERSONNEL AND WORKERS. TRENCH SUPPORTS AND DEWATERING SHALL BE RESPONSIBILITY OF THE CONTRACTOR.
- IF THE CONTRACTOR CHOOSES TO WORK ON THE PROJECT WHEN HOT MIX ASPHALT IS NOT AVAILABLE, THE CONTRACTOR SHALL OBTAIN APPROVAL FROM THE GOVERNING AGENCY PRIOR TO CONSTRUCTION. THE CONTRACTOR SHALL FURNISH AND INSTALL TEMPORARY ASPHALT SURFACING MATERIAL. WHEN PERMANENT ASPHALT BECOMES AVAILABLE, THE CONTRACTOR SHALL REMOVE THE TEMPORARY ASPHALT, FURNISH AND INSTALL THE PERMANENT ASPHALT AT NO ADDITIONAL COST TO THE OWNER.
- CONTRACTOR SHALL NOT DESTROY, REMOVE, OR DISTURB ANY EXISTING SURVEY MONUMENTS WITHOUT AUTHORIZATION OF CONTROLLING AGENCY. NO PAVEMENT CUTTING OR REMOVAL SHALL BEGIN UNTIL ALL SURVEY MARKERS OR MONUMENT POINTS THAT HAVE THE POTENTIAL OF BEING DISTURBED BY THE CONSTRUCTION OPERATIONS HAVE BEEN PROPERLY REFERENCED BY A REGISTERED LAND SURVEYOR. ALL SURVEY MONUMENTS OR POINTS DISTURBED BY THE CONTRACTOR SHALL BE ACCURATELY RESET BY A REGISTERED LAND SURVEYOR AFTER ALL RESTORATION AND RESURFACING HAS BEEN COMPLETED.
- CONTRACTOR SHALL SUBMIT TO THE ENGINEER FOR REVIEW A SEQUENTIAL PLAN DETAILING PROPOSED CONNECTION PROCEDURES IN ACCORDANCE WITH THE CONSTRUCTION SCHEDULE CONSTRAINTS DESCRIBED IN SECTION 01010 - SUMMARY OF WORK.
- CONTRACTOR TO PROVIDE AND DISTRIBUTE WRITTEN NOTICE OF CONSTRUCTION ACTIVITIES TO ALL RESIDENTS AND BUSINESSES LOCATED IN THE CONSTRUCTION AREA AT LEAST 48 HOURS PRIOR TO CONSTRUCTION. WRITTEN NOTICE SHALL BE APPROVED BY THE ENGINEER PRIOR TO DISTRIBUTION.
- CONTRACTOR SHALL PROVIDE AND UPDATE A CONSTRUCTION SCHEDULE IN ACCORDANCE WITH THE SPECIFICATIONS FOR WORKING IN THE PUBLIC RIGHT-OF-WAY PRIOR TO CONSTRUCTION.
- CONTRACTOR SHALL BE RESPONSIBLE FOR CORRECTING ANY SETTLEMENT OF BACKFILL, AND ANY DAMAGE OF UTILITIES RESULTING FROM SETTLEMENT.
- LAY PIPE TO DEPTH AND ALONG HORIZONTAL ALIGNMENT AS DEFINED IN THESE DRAWINGS. CONTRACTOR SHALL NOT DEVIATE FROM PROPOSED ALIGNMENT OR GRADE WITHOUT THE WRITTEN APPROVAL OF THE ENGINEER.
- WHERE ENGINEER DETERMINES MECHANICAL COMPACTION CANNOT BE ADEQUATELY PERFORMED CONTRACTOR SHALL BACKFILL TRENCH AREAS WHERE NEW WATERLINES CROSS UNDER EXISTING BURIED UTILITIES WITH FLOWABLE FILL (CONTROLLED LOW STRENGTH MATERIAL) IN ACCORDANCE WITH SPECIFICATIONS.
- CONTRACTOR SHALL SAW CUT ASPHALT, SIDEWALK, AND WHERE REQUIRED CURB AND GUTTER AT THE LIMITS OF ALL TRENCH EXCAVATION.
- SIZE OF FITTINGS SHOWN ON THE PLANS SHALL CORRESPOND TO ADJACENT STRAIGHT RUN OF PIPE. TYPE OF JOINT AND FITTING MATERIAL SHALL BE THE SAME AS SHOWN FOR ADJACENT STRAIGHT RUN OF PIPE.
- CONTRACTOR SHALL PROTECT ADJACENT PRESSURE PIPELINES AND PROVIDE TEMPORARY THRUST RESTRAINT AS NECESSARY DURING CONSTRUCTION. ALL NEW PRESSURE PIPE AND FITTINGS SHALL HAVE THRUST RESTRAINED JOINTS, THRUST BLOCKS, THRUST TIES OR OTHER APPROVED THRUST RESTRAINT.
- HORIZONTAL CONTROL IS DEFINED BY THE LOCAL PROJECT CONTROL SYSTEM. DRAWING G-2 SHOWS GROUND COORDINATES FOR SURVEY CONTROL MONUMENTS IN THE PROJECT AREA. ALL COORDINATES, BEARINGS, DISTANCES, AND STATIONS SHOWN ON THE DRAWINGS ARE GROUND.

GENERAL NOTES

- EXISTING UTILITIES SHOWN ON THE PLANS ARE BASED UPON A RECORD SEARCH OF LOCAL CONTROLLING AGENCIES AND ARE APPROXIMATELY LOCATED. EXISTING UTILITIES ARE SHOWN FOR THE CONVENIENCE OF THE CONTRACTOR ONLY. AT LEAST 2 WORKING DAYS PRIOR TO EXCAVATION, THE CONTRACTOR SHALL CONTACT "BLUE STAKES" AT 1 (800) 662-4111 FOR MARK OUT OF EXISTING UTILITIES. IT WILL BE THE CONTRACTOR'S SOLE RESPONSIBILITY TO DIRECTLY CONTACT ANY OTHER UTILITY COMPANIES THAT ARE NOT MEMBERS OF BLUE STAKES. NOTIFY ENGINEER IMMEDIATELY OF ANY UTILITIES IDENTIFIED THAT ARE NOT SHOWN ON THE DRAWINGS.
- CONTRACTOR SHALL VERIFY THE EXACT LOCATION, SIZE, TYPE, AND ELEVATION OF ALL UTILITIES PRIOR TO CONSTRUCTION BY POT HOLING A MINIMUM OF 400 FEET IN ADVANCE OF TRENCHING OPERATIONS TO CONFIRM CLEARANCE FROM THE PROPOSED PIPELINE. REPORT ANY CONFLICTS TO THE ENGINEER.
- EXCAVATION LIMITS SHOWN IN THE DETAILS ARE GRAPHICAL REPRESENTATIONS ONLY AND DO NOT REPRESENT ACTUAL EXCAVATION LIMITS OR SAFE TRENCH CONDITIONS NECESSARY TO COMPLETE THE WORK. THE CONTRACTOR IS SOLELY RESPONSIBLE FOR DETERMINING THE TRENCH LIMITS NEEDED FOR THE WORK AND CONFORMANCE WITH THE LOCAL, STATE, AND FEDERAL CODES GOVERNING SHORING, SHEETING, AND BRACING OF EXCAVATIONS AND TRENCHES, AND FOR PROTECTION AND SAFETY OF WORKERS AND OTHER CONSTRUCTION RELATED PERSONNEL.
- UNLESS OTHERWISE NOTED, ALL ELEVATIONS FOR NEW CONSTRUCTED PIPELINES ARE PIPE CENTERLINE ELEVATIONS. VPI ELEVATIONS ARE PROVIDED FOR VERTICAL CURVES. ELEVATIONS OF EXISTING UTILITIES ARE CALLED OUT TO INVERT ELEVATION FOR GRAVITY UTILITIES (I.E. STORM DRAINS, SEWER, ETC.) AND TOP OF PIPE FOR PRESSURE PIPELINES, DRY CONDUITS, AND ALL OTHER BURIED UTILITIES.
- ALL STATIONING AND DISTANCES SHOWN ON THE DRAWINGS ARE BASED ON HORIZONTAL MEASUREMENTS.
- THE SOUTHWEST AQUEDUCT SHALL BE TESTED TO THE TEST PRESSURES SHOWN ON DRAWING G-3. ALL PIPELINE MATERIALS AND APPURTENANCES SHALL BE DESIGNED TO WITHSTAND THE FULL TEST PRESSURES.
- THE LOCATIONS OF AIR VALVES, BLOWOFF ASSEMBLIES, AND OUTLETS ARE SHOWN IN THEIR APPROXIMATE LOCATION. THE EXACT LOCATION MAY BE ALTERED IN THE FIELD BY THE ENGINEER.
- CONTRACTOR SHALL ENSURE THAT OPERATION OF EXISTING IRRIGATION, SEWER, DRAINAGE, DOMESTIC WATER, AND OTHER UTILITY SYSTEMS ARE IN CONTINUOUS OPERATION DURING CONSTRUCTION. WHERE IT IS NECESSARY TO REMOVE AND REPLACE OR TO RELOCATE UTILITIES OR SERVICE LATERALS IN ORDER TO PROSECUTE THE WORK, THEY SHALL BE REMOVED, MAINTAINED, AND PERMANENTLY REPLACED BY THE CONTRACTOR, AT CONTRACTORS EXPENSE, AND TO THE SATISFACTION AND STANDARDS OF THE UTILITY OWNER.
- UTILITY SERVICE LATERALS ARE NOT SHOWN ON THESE PLANS. CONTRACTOR SHALL ANTICIPATE THAT THERE ARE NO LESS SERVICE LATERALS THAN THERE ARE HOMES WHERE PROJECT TRENCHES ARE LOCATED IN OR WITHIN 100 FEET OF A STREET BETWEEN A HOME AND THE UTILITY MAIN. IT IS THE CONTRACTOR'S RESPONSIBILITY TO PROTECT IN PLACE, OR REMOVE AND REPLACE TO THE SATISFACTION OF THE UTILITY OWNER, ALL UTILITY SERVICE LATERALS ENCOUNTERED DURING CONSTRUCTION. DURATION OF UTILITY SERVICE OUTAGES AND PUBLIC NOTIFICATION PROCEDURES SHALL CONFORM TO THE STANDARDS OF THE CONTROLLING AGENCY.
- THE PIPELINE CROSSES AND PARALLELS OVERHEAD ELECTRIC TRANSMISSION AND UNDERGROUND NATURAL GAS TRANSMISSION LINES. THE CONTRACTOR SHALL EXERCISE EXTREME CAUTION WHILE WORKING IN THE VICINITY OF THESE TRANSMISSION LINES.
- RELOCATIONS AND/OR REPLACEMENTS OF EXISTING UTILITIES SHALL BE COORDINATED BY THE CONTRACTOR WITH THE UTILITY OWNER. CONTRACTOR SHALL CONTACT, SCHEDULE, AND ESTABLISH UTILITY SHUT DOWN TIMES AND DETERMINE THE RELOCATION AND/OR REPLACEMENT REQUIREMENTS OF EXISTING UTILITIES PRIOR TO THE START OF ANY WORK AT NO COST TO THE DISTRICT.
- CONTRACTOR SHALL OBTAIN ALL NECESSARY PERMIT(S) AND COMPLY WITH ALL REQUIREMENTS OF GOVERNING AGENCIES. REFER TO SPECIFICATION SECTION 01450 - PERMITS.
- THE CONTRACTOR SHALL PREPARE AND SUBMIT TRAFFIC CONTROL PLANS FOR REVIEW AND APPROVAL PRIOR TO CONSTRUCTION AS REQUIRED BY BLUFFDALE CITY, AND RIVERTON CITY. CONFORM WITH ALL REQUIREMENTS OF THE GOVERNING AGENCIES INCLUDING, BUT NOT LIMITED TO, VMS NOTIFICATION BOARDS, LANE CLOSURES, PUBLIC NOTIFICATIONS, AND NOTIFICATIONS TO EMERGENCY SERVICES AND OTHER PUBLIC SERVICES THAT WILL BE IMPACTED BY THE PROJECT. REFER TO SECTION 01506, TRAFFIC CONTROL.
- GEOTECHNICAL BORING DATA IS PROVIDED APPROXIMATELY EVERY 1,000 LF ALONG PIPELINE ALIGNMENT. BORING LOCATIONS SHOWN ON PLANS ARE APPROXIMATE. REFER TO GEOTECHNICAL REPORT PREPARED BY GEOSTRATA, INC. DATED MARCH 3, 2009 FOR INFORMATION REGARDING SUBSURFACE CONDITIONS THAT MAY BE PRESENT ALONG ALIGNMENT.
- EXISTING PARALLEL SANITARY SEWER LINE SHOWN IN PROFILE FOR CONTRACTOR'S CONVENIENCE ONLY. SEWER PROFILE DOES NOT INCLUDE ALL MANHOLES AND IS NOT INTENDED TO BE A COMPLETE ILLUSTRATION OF THIS LINE. CONTRACTOR TO VERIFY ALL UTILITY LOCATION DATA IN FIELD PRIOR TO TRENCHING.
- CONTRACTOR SHALL SECURE ALL OPEN PIPE TRENCH WITHIN PUBLIC RIGHT-OF-WAYS AND RESIDENTIAL AREAS DURING ALL NON-WORKING HOURS WITH 6-FT HIGH TEMPORARY CHAIN LINK FENCING PANELS AND APPROPRIATE TRAFFIC CONTROL DEVICES. SECURITY FENCING MAY NOT BE REQUIRED IN OPEN UNIMPROVED RIGHT-OF-WAYS IF CONTRACTOR DEMONSTRATES THAT TRENCHES CAN BE CUT BACK TO PROVIDE SAFE ACCESS WITHOUT SHORING DEVICES IN ACCORDANCE WITH OSHA STANDARDS.
- CONTRACTOR SHALL INSTALL AQUEDUCT MARKING POSTS ON THE CENTERLINE OF AQUEDUCT AT THE BEGINNING AND END OF OPEN CORRIDORS AND AT A MINIMUM OF 500-FOOT INTERVALS, SEE SECTION 02570 FOR MARKING POST TYPE.
- CONTRACTORS ATTENTION IS DRAWN TO SPECIFIC REQUIREMENTS OF SECTION 01506 - TRAFFIC CONTROL AND SECTION 01550 - PUBLIC INFORMATION PROGRAM FOR REQUIREMENTS WHEN WORKING IN PUBLIC RIGHT-OF-WAYS ALONG 3200 WEST AND AT MAJOR STREET CROSSINGS.
- REFERENCE THE LATEST EDITION OF APWA STANDARD PLANS AND SPECIFICATIONS FOR ITEMS NOT INCLUDED IN THE BLUFFDALE AND RIVERTON CITY STANDARD PLANS
- THE OPEN ENDS OF THE PIPELINE UNDER CONSTRUCTION SHALL BE COVERED AND EFFECTIVELY SEALED AT THE END OF THE DAYS WORK.
- ALL MATERIALS WHICH MAY CONTACT DRINKING WATER, INCLUDING PIPES, GASKETS, LUBRICANTS AND O-RINGS, SHALL BE ANSI-CERTIFIED AS MEETING THE REQUIREMENTS OF NSF STANDARD 61, DRINKING WATER SYSTEM COMPONENTS - HEALTH EFFECTS. TO PERMIT FIELD VERIFICATION OF THIS CERTIFICATE, ALL SUCH COMPONENTS SHALL BE APPROPRIATELY STAMPED WITH THE NSF LOGO.

RECORD DRAWINGS

Revisions Drawn by S. Riggs Date November 2011

THESE RECORD DRAWINGS HAVE BEEN PREPARED, IN PART, ON THE BASIS OF INFORMATION COMPILED BY OTHERS. THEY ARE NOT INTENDED TO REPRESENT IN DETAIL THE EXACT LOCATION, TYPE OF COMPONENT NOR MANNER OF CONSTRUCTION. THE ENGINEER WILL NOT BE RESPONSIBLE FOR ANY ERRORS OR OMISSIONS WHICH HAVE BEEN INCORPORATED INTO THE RECORD DRAWINGS.

JORDAN VALLEY WATER CONSERVANCY DISTRICT

SOUTHWEST AQUEDUCT REACH 2 PROJECT

GENERAL

GENERAL NOTES AND SYMBOLS

PROJECT NUMBER 010-08-03

DESIGN T. OLSEN

REVIEW CHECKED M. COLLINS

VERIFY SCALE BAR IS ONE INCH ON ORIGINAL DRAWING

DATE: FEBRUARY 2010

DRAWING NO. G-5

SHEET 5 OF 110

NO.

DATE

REV. BY

DESCRIPTION



REVISIONS

©	AT	CONC	CONCRETE, CONCENTRIC	FEXT	FIRE EXTINGUISHER	LPT	LOW POINT	PVC	POLYVINYL CHLORIDE	UBC	UNIFORM BUILDING CODE
AASHTO	AMERICAN ASSOCIATION OF STATE HIGHWAY TRANSPORTATION OFFICIALS	COND	CONDENSER, CONDENSATE CONNECTION	FF	FLAT FACE, FAR FACE, FINISH FLOOR	LR	LONG RADIUS	PVI	POINT OF VERTICAL INTERSECTION	UD	UNDERDRAIN
AB	ANCHOR BOLT	CONN	CONNECTION	F F TO F	FACE TO FACE	LT	LIGHT, LEFT	PW	POTABLE WATER	UG	UNDERGROUND
ABBR	ABBREVIATION	CONST	CONSTRUCTION, CONSTRUCT	FG	FINISH GRADE, FLOW GLASS	LVL	LEVEL	POB	POINT OF BEGINNING	UH	UNIT HEATER
ABS	ACRYLONITRILE-BUTADIENE-STYRENE	CONT	CONTINUED, CONTINUOUS, CONTINUATION	FH	FIRE HYDRANT	LWL	LOW WATER LEVEL	POE	POINT OF ENDING	UL	UNDERWRITERS LABORATORIES
AC	ASPHALTIC CONCRETE OR ALTERNATING CURRENT OR ACTIVATED CARBON	COORD	COORDINATE	FLR	FLOOR	LWR	LOWER			ULDC	UTAH LAKE DISTRIBUTION CANAL
ACI	AMERICAN CONCRETE INSTITUTE	COTG	CLEAN-OUT TO GRADE	FL	FLOW LINE			R	RIGHT	UNO	UNLESS OTHERWISE NOTED
ACP	ASPHALTIC CONCRETE PAVEMENT	COP	COPPER	FLEX	FLEXIBLE	M	METER, MALE (PIPE THREAD)	RAD	RADIUS	USBR	U.S. BUREAU OF RECLAMATION
ADDL	ADDITIONAL	CPLG	COUPLING	FLG	FLANGE	MACH	MACHINE	RC	REINFORCED CONCRETE		
ADJ	ADJACENT OR ADJUSTABLE	CPVC	CHLORINATED POLYVINYL CHLORIDE	FND	FOUND	MAN	MAGNETIC	RCP	REINFORCED CONCRETE PIPE	V	VALVE, VENT, VOLT, VACUUM
AER	AERATION	CS	CAST STEEL OR CAUSTIC SODA	FNSH	FINISH	MAN	MANUAL	RD	RESERVOIR DRAIN OR ROAD	VAR	VARIES, OR VARIABLE
AFF	ABOVE FINISH FLOOR	CTRD	CENTERED	FO	FIBER OPTIC	MATL	MATERIAL	RDCR	REDUCER, REDUCING	VC	VERTICAL CURVE
AGGR	AGGREGATE	CTR	CENTER	FWR	FINISH WATER RESERVIOR	MAX	MAXIMUM	RECIRC	RECIRCULATION	VCP	VITRIFIED CLAY PIPE
AH	AIR HANDLER	CTSK	COUNTERSUNK			MB	MACHINE BOLT	RED	REDUCING	VERT	VERTICAL
AIR CONT	AIR CONDITIONING	CU FT	CUBIC FOOT	G	GAS	MCC	MOTOR CONTROL CENTER	REF	REFERENCE, REFER	VOL	VOLUME
AISC	AMERICAN INSTITUTE OF STEEL CONSTRUCTION	CU IN	CUBIC INCH	GA	GAGE, GAUGE	MECH	MECHANICAL, MECHANISM	REG	REGULATING, REGISTER	VTC	VENT THROUGH CEILING
		CU YD	CUBIC YARD	GAL	GALLON	MEMB	MEMBRANE	REINF	REINFORCE, REINFORCED	VTR	VENT THROUGH ROOF
		CULV	CULVERT	GALV	GALVANIZED	MET	METAL	REQD	REQUIRED	VSS	VOLATILE SUSPENDED SOLIDS
		CV	CHECK VALVE	GEN	GENERATOR	MFR	MANUFACTURER	REV	REVISION		
AL	ALUMINUM, ALUM	CW	COLD WATER	GFI	GROUND FAULT INTERRUPTER	MG	MILLION GALLONS	RF	ROOF, RAISED FACE	W	WEST, WASTE, WIDE FLANGE (BEAM)
ALTN	ALTERNATIVE, ALTERNATE	CWO	CHAIN WHEEL OPERATOR	GI	GALVANIZED IRON	MGD	MILLION GALLONS PER DAY	RND	ROUND	W/	WITH
ANOD	ANODIZED	CYL	CYLINDER	GIS	GEOGRAPHIC INFORMATION SYSTEM	MH	MANHOLE, MONORAIL HOIST	RPM	REVOLUTIONS PER MINUTE	W/O	WITHOUT
ANSI	AMERICAN NATIONAL STANDARDS INSTITUTE			GL	GLASS	MI	MALLEABLE IRON	RP	RADIUS POINT	WC	WATER COLUMN OR WATER CLOSET
APVD	APPROVED	d	PENNY	GLAZ	GLAZING	MID	MIDDLE	RST	REINFORCING STEEL, RESET	WCO	WALL CLEANOUT
APPROX	APPROXIMATE	DBA	DEFORMED ANCHOR	GLV	GLOBE VALVE	MIL	1/1,000 INCH	RT	REGULATING TANK, RADIOGRAPHIC, RIGHT	WD	WOOD
ARCH	ARCHITECTURAL	DBL	DOUBLE	GND	GROUND	MIN	MINIMUM OR MINUTE	RV	ROOF VENT	WH	WATER HEATER
ARV	AIR RELEASE VALVE	DC	DIRECT CURRENT	GPD	GALLONS PER DAY	MISC	MISCELLANEOUS	ROW	RIGHT OF WAY	WS	WATER STOP, WATER SURFACE
ASME	AMERICAN SOCIETY OF MECHANICAL ENGINEERS	DET	DETAIL	GPH	GALLONS PER HOUR	MJ	MECHANICAL JOINT	R/W	RIGHT OF WAY	WSP	WELDED STEEL PIPE
		DEG	DEGREE	GPM	GALLONS PER MINUTE	MLMC	MORTAR LINED MORTAR COATED	RW	RAW WATER	WSTP	WATER STOP
ASTM	AMERICAN SOCIETY FOR TESTING AND MATERIAL	DEM	DEMOLITION, DEMOLISH	GR	GRADE	MLPC	MORTAR LINED POLYURETHANE COATED			WT	WEIGHT
ASSY	ASSEMBLY	DI	DUCTILE IRON, DROP INLET	GR BRK	GRADE BREAK, GRADE CHANGE	MTL	METAL OR MATERIAL	S	SOUTH, SECOND	WWM	WELDED WIRE MESH
AUTO	AUTOMATIC	DIA	DIAMETER	GRTG	GRATING	MTG	MOUNTING	SA	SAMPLE, SAMPLE LINE		
AUX	AUXILIARY	DIAG	DIAGONAL	GV	GATE VALVE	MTR	MOTOR	SR	SUPPLY AIR REGISTER	XMTR	TRANSMITTER
AVAR	AIR VACUUM AND AIR RELEASE VALVE	DIAPH	DIAPHRAGM	GSP	GALVANIZED STEEL PIPE	MPH	MILES PER HOUR	SCFM	STANDARD CUBIC FEET PER MINUTE	XS	EXTRA STRONG
AWS	AMERICAN WELDING SOCIETY	DIFF	DIFFUSER	GYP	GYPSON BOARD	MWS	MAXIMUM WATER SURFACE	SCH	SCHEDULE		
AWWA	AMERICAN WATER WORKS ASSOCIATION	DIP	DUCTILE IRON PIPE					SD	STORM DRAIN		
		DISCH	DISCHARGE	H	HEIGHT	N	NORTH	SECT	SECTION		
BC	BEGIN CURVE, BOLT CIRCLE	DIR	DIRECTION	HAS	HEADED ANCHOR STUD	NAVD	NORTH AMERICAN VERTICAL DATUM	SHT	SHEET		
BF	BLIND FLANGE, BUTTERFLY VALVE	DIST	DISTANCE	HB	HOSE BIBB	NBS	NATIONAL BUREAU OF STANDARDS	SIM	SIMILAR		
BFP	BACK FLOW PREVENTER	DIV	DIVISION	HD	HUB DRAIN	NC	NORMALLY CLOSED	SLP	SLOPE		
BFV	BUTTERFLY VALVE	D-LOAD	LOADING CONDITION FOR RCP	HDPE	HIGH DENSITY POLYETHYLENE	NE	NORTHEAST	SP	SPACING, STATIC PRESSURE		
BHD	BULKHEAD	DMPR	DAMPER	HDR	HEADER	NEC	NATIONAL ELECTRIC CODE	SPEC	SPECIFIED, SPECIFICATION		
BHP	BRAKE HORSEPOWER	DN	DOWN, DECANT	HDW	HARDWARE	NEMA	NATIONAL ELECTRICAL MANUFACTURES ASSOCIATION	SPECS	SPECIFICATIONS		
BLDG	BUILDING	DOT	DEPARTMENT OF TRANSPORTATION	HEX	HEXAGONAL	NF	NEAR FACE	SPG	SPACING		
BLK	BLACK OR BLOCK	DP	DAMP PROOFING	HGR	HANGER	NFPA	NATIONAL FIRE PROTECTION ASSOCIATION	SPKR	SPEAKER		
BLKG	BLOCKING	DR	DOOR, DRAIN	HM	HOLLOW METAL	NIC	NOT IN CONTRACT	SPLY	SUPPLY		
BLT	BOLT	DS	DRENCH SHOWER & EYE WASH, DOWNSPOUT	HORIZ	HORIZONTAL	NO	NUMBER OR NORMALLY OPEN	SPRT	SUPPORT		
BM	BEAM, BENCH MARK	DWG	DRAWING	HP	HORSEPOWER, HIGH PRESSURE, HEAT PUMP	NOM	NOMINAL	SQ	SQUARE		
BO	BLOW-OFF ASSEMBLY, BLOW-OFF	DWL	DOWEL	H/P, HPT	HIGH POINT	NPT	NATIONAL PIPE THREAD	SQ FT	SQUARE FOOT		
BOT	BOTTOM			HR	HEATING RETURN, HOUR, HOSE RACK	NS	NEAR SIDE	SR	SUPPLY REGISTER		
BPS	BOOSTER PUMPING STATION			HS	HIGH STRENGTH	NTS	NOT TO SCALE	SS	SANITARY SEWER, SERVICE SINK		
BPV	BACK PRESSURE VALVE			HTG	HEATING	NW	NORTHWEST	SST	STAINLESS STEEL		
BRK	BRICK			HTR	HEATER	OC	ON CENTER, OVER-CROSSING	STA	STATION		
B & S	BELL & SPIGOT	E(UG)	ELECTRICAL (UNDERGROUND)	HV	HOSE VALVE	OD	OUTSIDE DIAMETER, OVERALL DIMENSION	STD	STANDARD		
BTWN	BETWEEN	E(OH)	ELECTRICAL (OVERHEAD POWER)	HVAC	HEATING, VENTILATING AND AIR CONDITIONING	OF	OUTSIDE FACE	STIFF	STIFFENER		
BTU	BRITISH THERMAL UNIT	E	EAST			OH	OVERHEAD	STL	STEEL		
BUR	BUILT-UP ROOFING	EA	EACH			OPER	OPERATOR, OPERATING	STRL	STRUCTURAL		
BVC	BEGIN VERTICAL CURVE	EB	EXPANSION BOLT			OPNG	OPENING	SWA	SOUTHWEST AQUEDUCT		
BW	BACK WASH, FILTER BACKWASH	EC	END CURVE			OPP	OPPOSITE	SYM	SYMBOL		
		ECC	ECCENTRIC			ORIG	ORIGINAL	SYMM	SYMMETRICAL		
		EF	EACH FACE, EXHAUST FAN			O TO O	OUT TO OUT	SYS	SYSTEM		
		EFF	EFFLUENT			OVHD	OVERHEAD				
C	CENTIGRADE OR CELSIUS	EG	EXISTING GRADE	ICFM	INLET CUBIC FEET PER MINUTE	OZ	OUNCE	T	THICKNESS, TOP, TOILET		
CAB	CABINET	EL	ELEVATION, ELBOW	ID	INSIDE DIAMETER	PV	PAVEMENT	T&B	TOP AND BOTTOM		
CAP	CAPACITY	ELEV	ELEVATION	IF	INSIDE FACE	PC	PORTLAND CEMENT, POINT OF CURVE OR PRIMARY CLARIFIER	T&G	TONGUE AND GROOVE		
CARV	COMBINATION AIR RELEASE VALVE	ELEC	ELECTRICAL, ELECTRONIC	IN	INCH	PCC	PORTLAND CEMENT CONCRETE	TAN	TANGENT		
CB	CATCH BASIN	EMB	EMBEDMENT	IN LB	INCH-POUND	PCF	POUNDS PER CUBIC FOOT	TBM	TEMPORARY BENCH MARK		
CC	CENTER TO CENTER	EMER	EMERGENCY	INFL	INFLUENT	PG	PRESSURE GAUGE	TBC	TOP OF CATCH BASIN		
CCP	CONCRETE CYLINDER PIPE	ENCL	ENCLOSURE	INSUL	INSULATING	PE	PLAIN END, POLYELECTROLYTE POLYMER, POLYETHYLENE	TC	TOP OF CURB, TOP OF CONCRETE		
CD	CEILING DIFFUSER CHEMICAL DRAIN AND VENT	ENG	ENGINE	IE	INVERT ELEVATION	pH	HYDROGEN ION CONCENTRATION	TDH	TOTAL DYNAMIC HEAD		
		ENGR	ENGINEER	INVT	INVERT	PI	PLANT INFLUENT, POINT OF INTERSECTION	TECH	TECHNICAL		
CER	CERAMIC	EP	EDGE OF PAVEMENT	IPS	IRON PIPE SIZE	PJF	PREMOLDED JOINT FILLER	TEL	TELEPHONE		
CFH	CUBIC FEET PER HOUR	EQ	EQUAL	IRR	IRRIGATION	PL	PLATE, PROPERTY LINE, PLACE	TEMP	TEMPERATURE, TEMPORARY		
CFM	CUBIC FEET PER MINUTE	EQL SP	EQUALLY SPACED	JA2	JORDAN AQUEDUCT REACH - 2	PLYWD	PLYWOOD	THK	THICK		
CFS	CUBIC FEET PER SECOND	EQUIP	EQUIPMENT	JT	JOINT	PM	PUMP, PROPELLER METER, POST MARKER	THR'D	THREADED		
CG	CHLORINE GAS	ETC	ETCETERA	JVWTP	JORDAN VALLEY WATER TREATMENT PLANT	PI	POINT OF BEGINNING	TK	TANK		
CHBD	CHALKBOARD	EVAP	EVAPORATOR	JVWCD	JORDAN VALLEY WATER CONSERVANCY DISTRICT	PT	POINT OF TANGENT	T.O.	TOP OF		
CHEM	CHEMICAL	EVC	END VERTICAL CURVE			PJF	PREMOLDED JOINT FILLER	TOG	TOP OF GRADE		
CHG	CHANGE	EW	EACH WAY, EYE WASH			PP	PLATE, PROPERTY LINE, OR PLACE	TP	TELEPHONE POLE, TURNING POINT		
CHKD PL	CHECKERED PLATE	EXH	EXHAUST			PPD	POTASSIUM PERMANGANATE	TYP	TYPICAL		
CI	CAST IRON	EXP ANR	EXPANSION BOLT, ANCHOR	K	KELVIN, KILO OR THOUSAND POUNDS	PPH	POUNDS PER DAY				
CIP	CAST IRON PIPE	EXP JT	EXPANSION JOINT	KG	KILOGRAM	PPM	POUNDS PER HOUR				
CISP	CAST IRON SOIL PIPE	EXIST	EXISTING	KV	KILOVOLT	PR	PARTS PER MILLION				
CJ	CONSTRUCTION JOINT	EXT	EXTERIOR, EXTENSION, EXTERNAL	KW	KILOWATT	PRC	POINT OF REVERSE CURVE				
CJP	COMPLETE JOINT PENETRATION			KWH	KILOWATT HOUR	PREFAB	PREFABRICATED				
CL	CHLORINATOR, CHAIN LINK, CLEARANCE, CENTERLINE OR CHLORINE					PRI	PRIMARY				
CLR	CLEAR			L	LEFT OR LITER	PRV	PRESSURE REGULATING/REDUCING VALVE				
CLSM	CONTROLLED LOW STRENGTH MATERIAL	F	FAHRENHEIT, FACE	LAB	LABORATORY	PS	PRESSURE SWITCH, PUMP STATION				
CLST	CEMENT LINED STEEL PIPE	FAB	FABRICATION, FABRICATE, OR FABRICATED	LAV	LAVATORY	PSF	POUNDS PER SQUARE FOOT				
CM	CENTIMETER	FB	FLAT BAR	LB	POUND	PSI	POUNDS PER SQUARE INCH				
CML & C	CEMENT MORTAR LINED AND COATED	FC	FLEXIBLE COUPLING	LC	LENGTH OF CURVE	PSIG	POUNDS PER SQUARE INCH GAUGE				
CMP	CORRUGATED METAL PIPE	FCA	FLANGE COUPLING ADAPTER	LF	LINEAR FEET	PT	POINT OF TANGENT, PRESSURE TREATED				
CMU	CONCRETE MASONRY UNIT	FCO	FLOOR CLEANOUT	LG	LENGTH OR LONG	PTDF	PRESSURE TREATED DOUGLAS FIR				
CO	CLEANOUT	FD	FLOOR DRAIN	LH	LEFT HAND						
COL	COLUMN	FDN	FOUNDATION	LL	LIVE LOAD						
COMM	COMMUNICATION	FDR	FEEDER	LLV	LONG LEG VERTICAL						
COMB	COMBINED			LOL	LENGTH OF LINE						

RECORD DRAWINGS

Revisions Drawn by S. Riggs Date November 2011

THESE RECORD DRAWINGS HAVE BEEN PREPARED, IN PART, ON THE BASIS OF INFORMATION COMPILED BY OTHERS. THEY ARE NOT INTENDED TO REPRESENT IN DETAIL THE EXACT LOCATION, TYPE OF COMPONENT NOR MANNER OF CONSTRUCTION. THE ENGINEER WILL NOT BE RESPONSIBLE FOR ANY ERRORS OR OMISSIONS WHICH HAVE BEEN INCORPORATED INTO THE RECORD DRAWINGS.

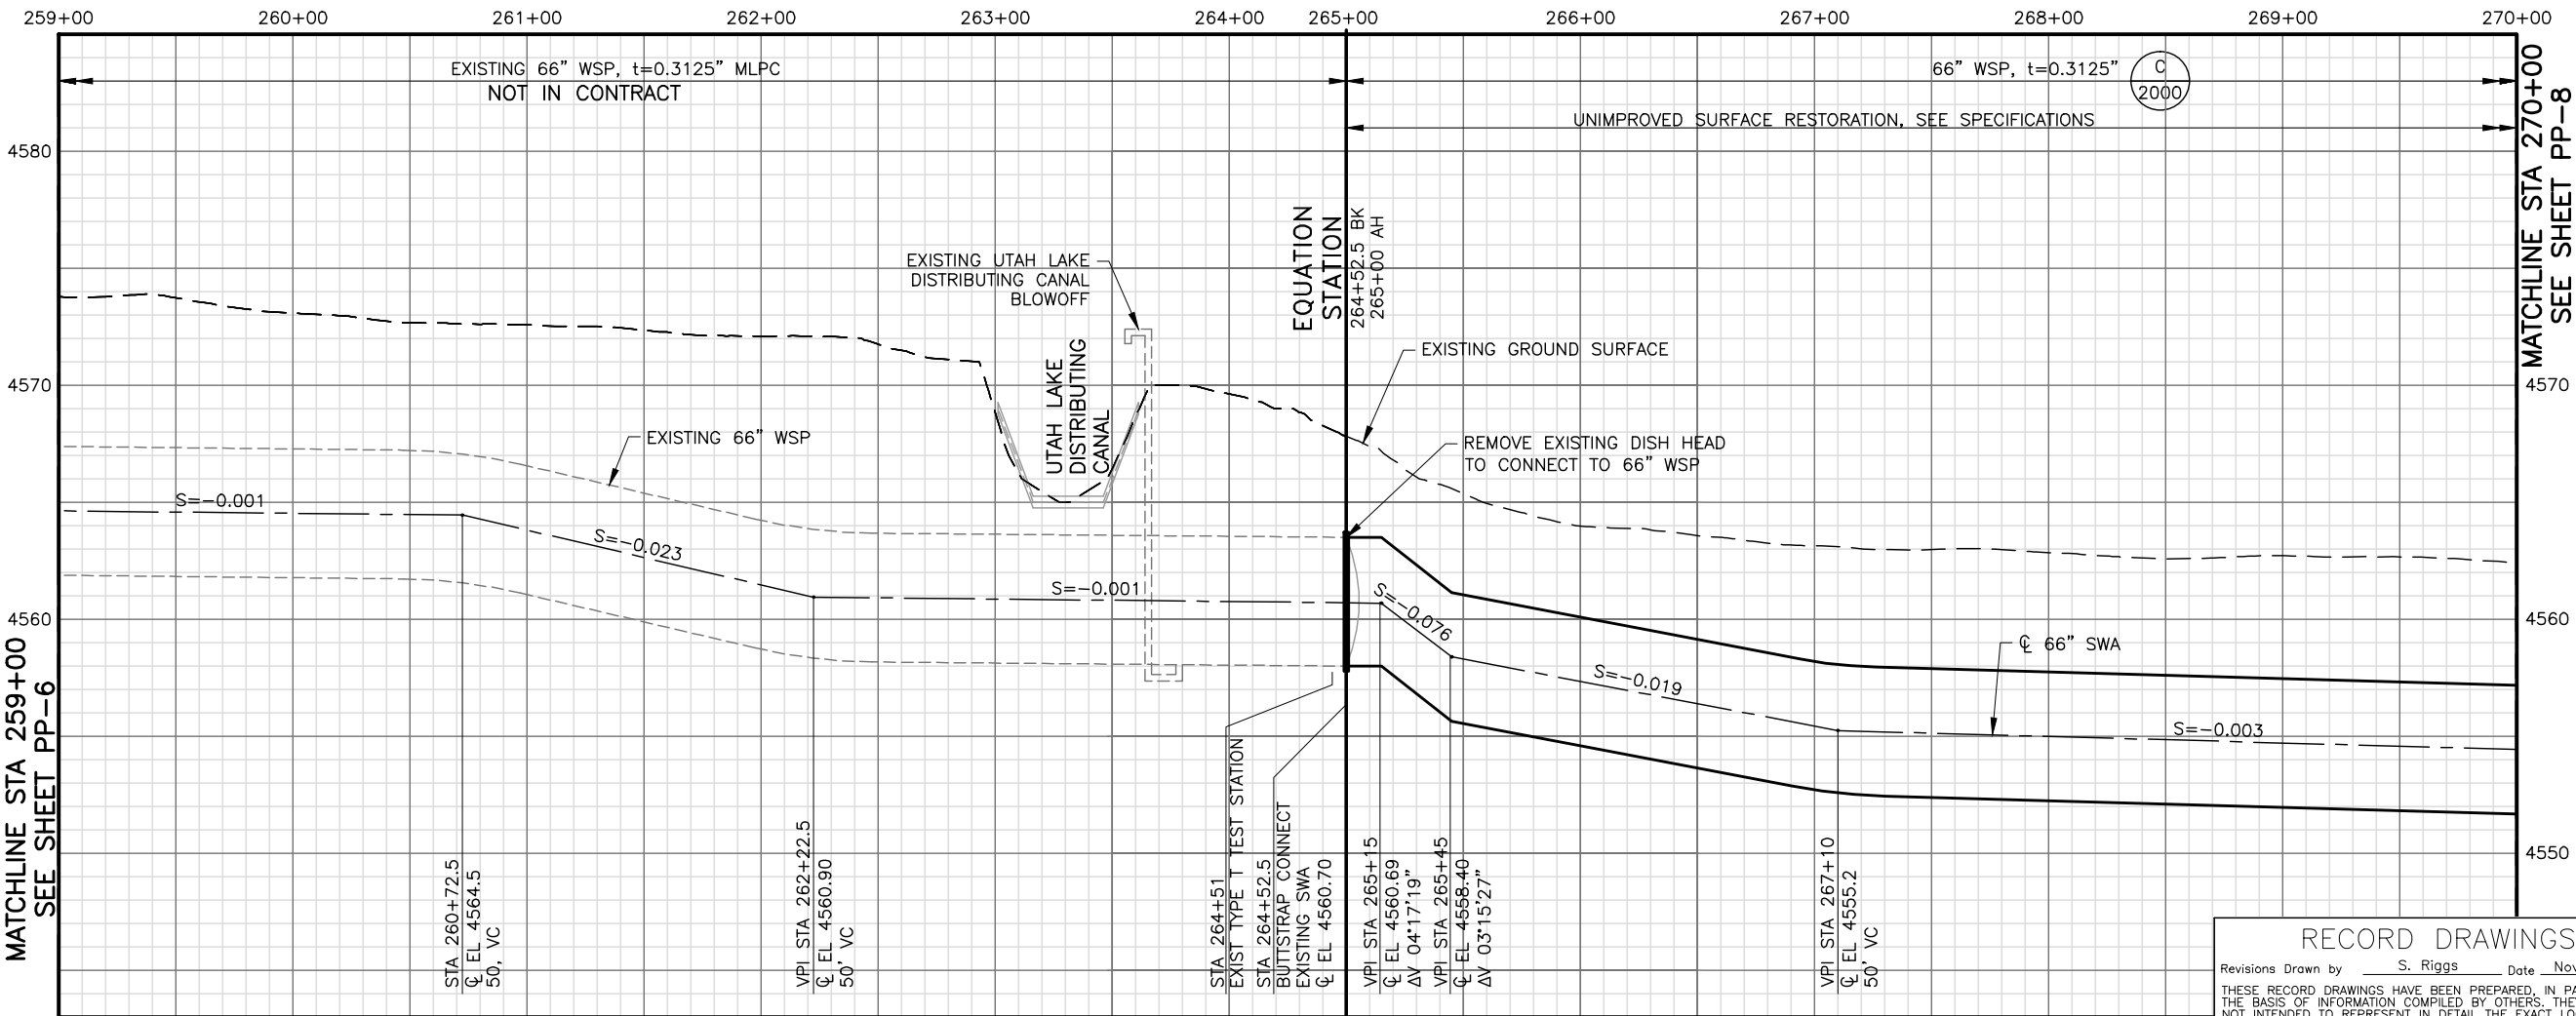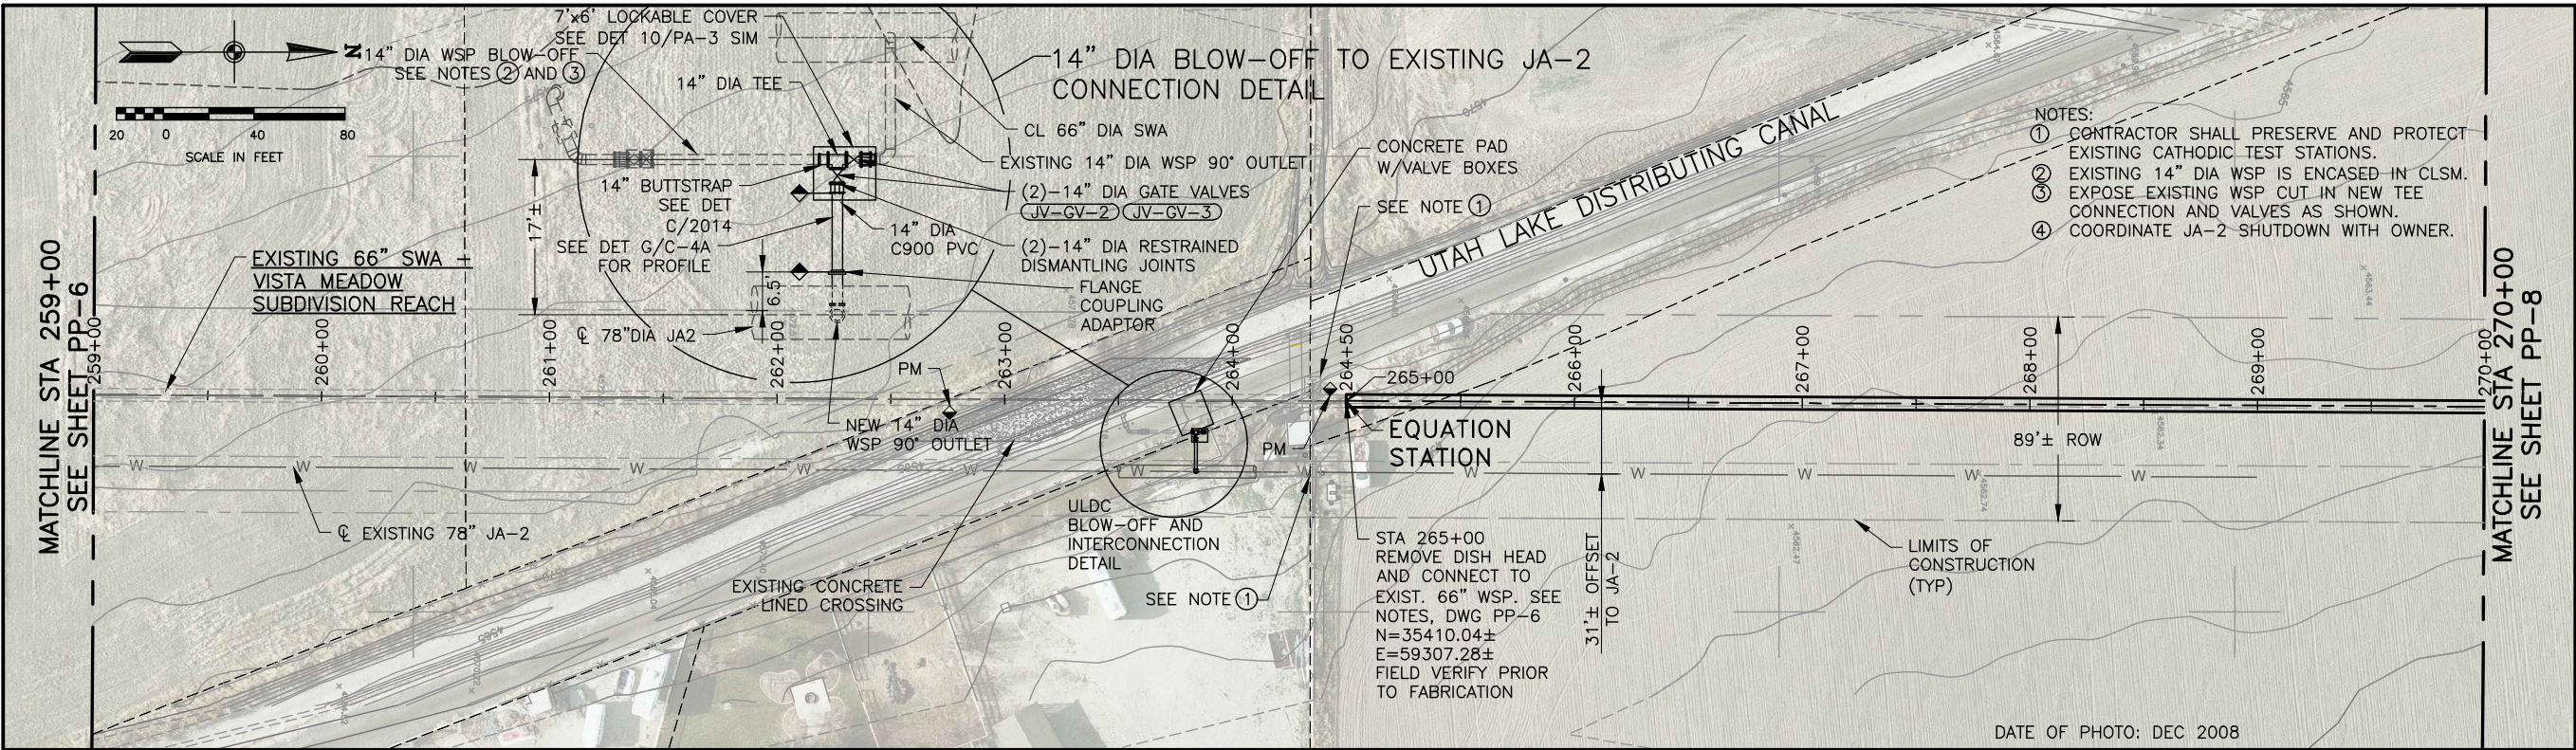

Bowen
Collins
& Associates, Inc.
Consulting Engineers

NO.

DATE

REV. BY

DESCRIPTION

REVISIONS

JORDAN VALLEY WATER CONSERVANCY DISTRICT

SOUTHWEST AQUEDUCT REACH 2 PROJECT

DESIGN
DESIGN T. OLSEN

REVIEW
CHECKED M. COLLINS

VERIFY SCALE
BAR IS ONE INCH ON
ORIGINAL DRAWING

CIVIL

PLAN AND PROFILE - 7
STA 259+00 TO STA 270+00



PROJECT
NUMBER 010-08-03



DATE: FEBRUARY 2010

DRAWING NO.
PP-7



SHEET 14 OF 110

P:\Jordan Valley WCD\Southwest Aqueduct Reach 2\2.0 - Design Phase\2.10 Drawings\Record Drawings\sh\t\R0100803_PP07.dwg Nov30,2011 - 4:41pm

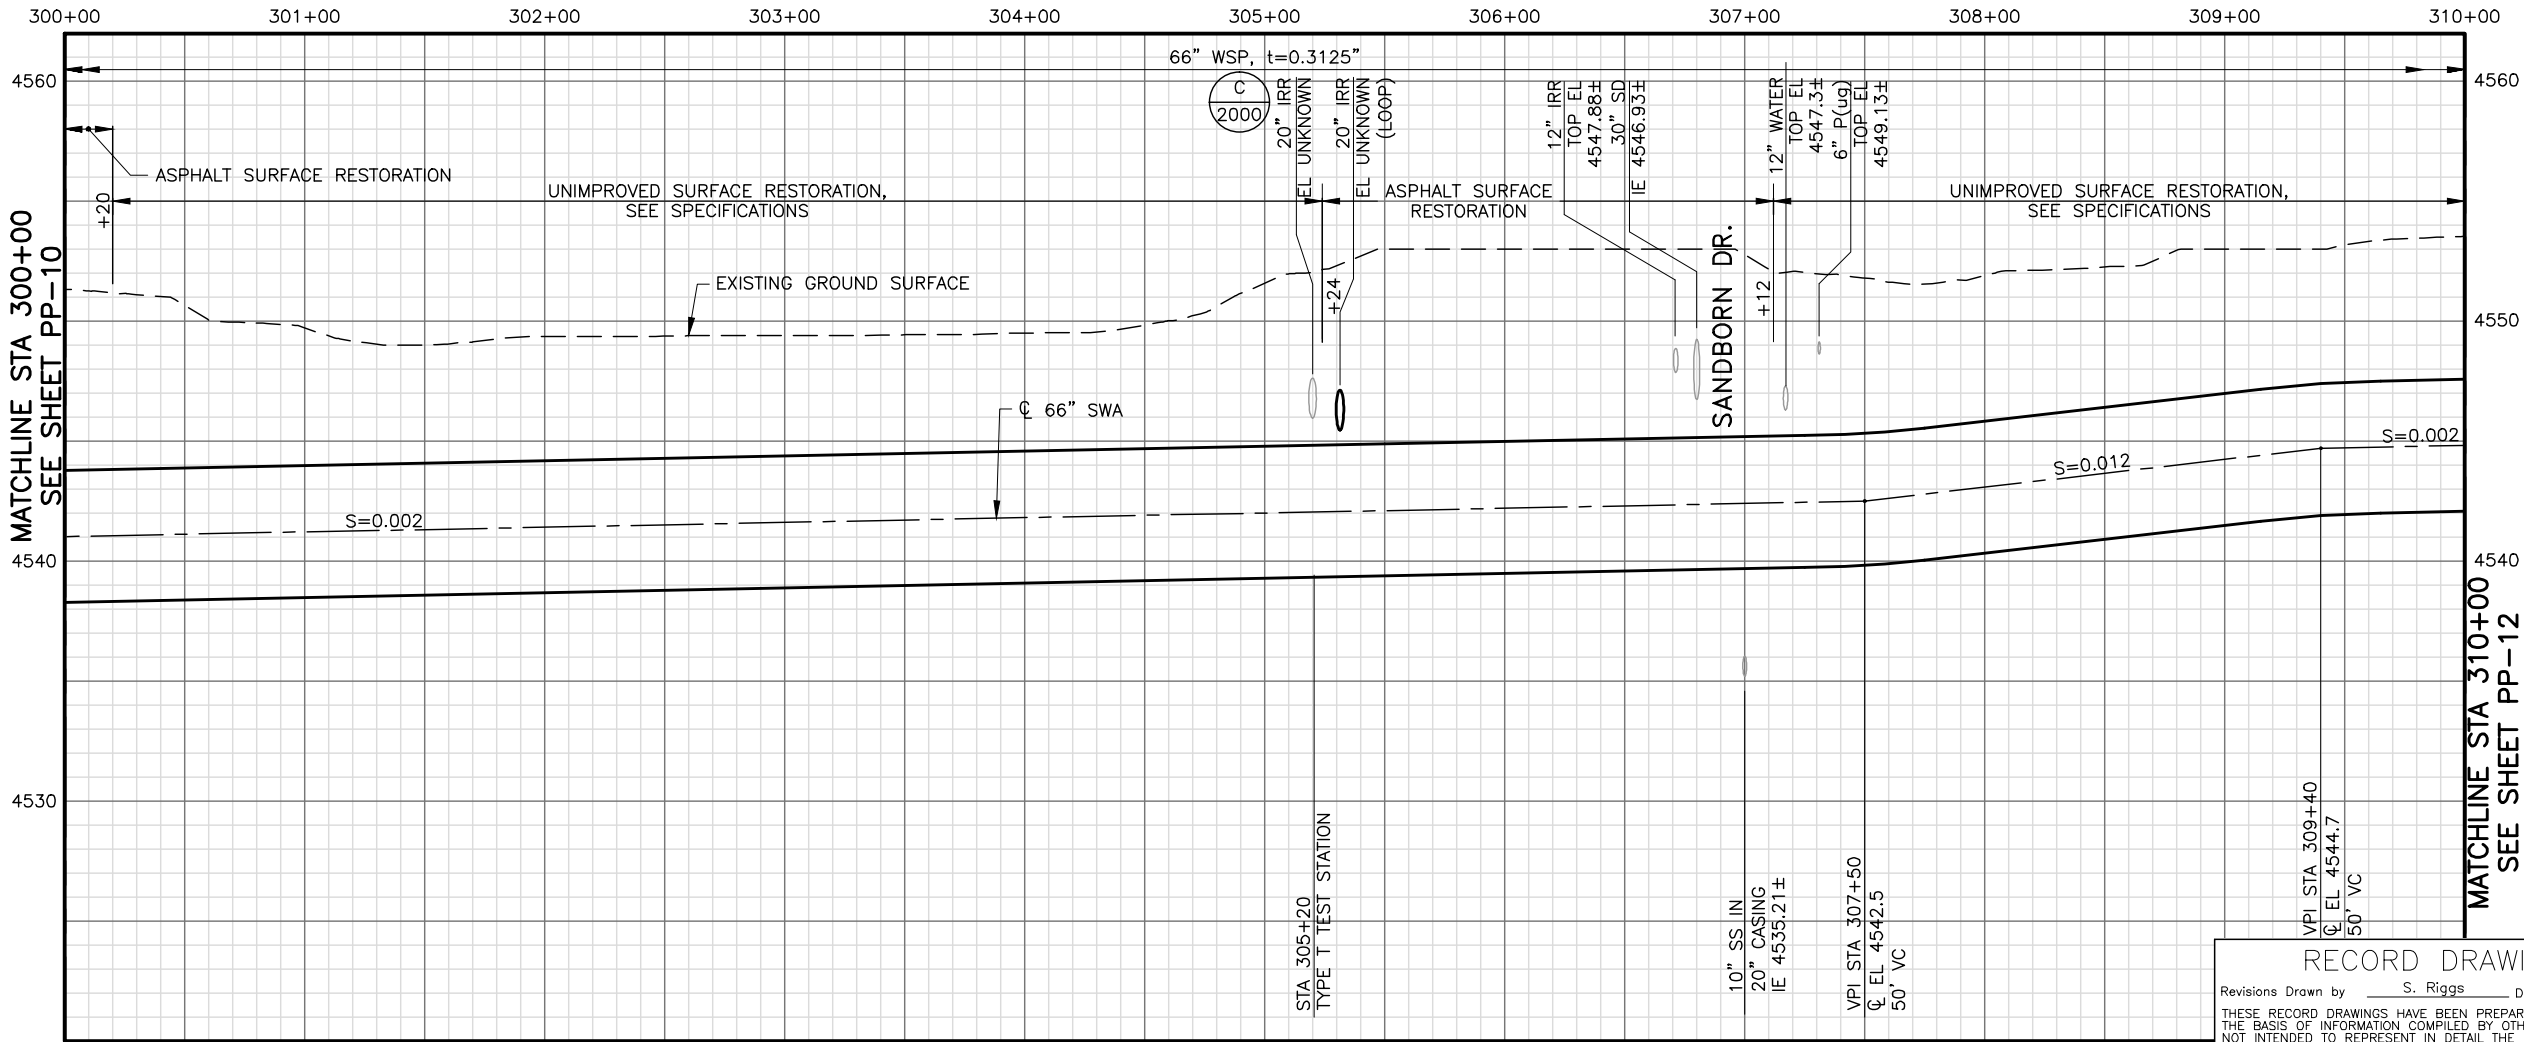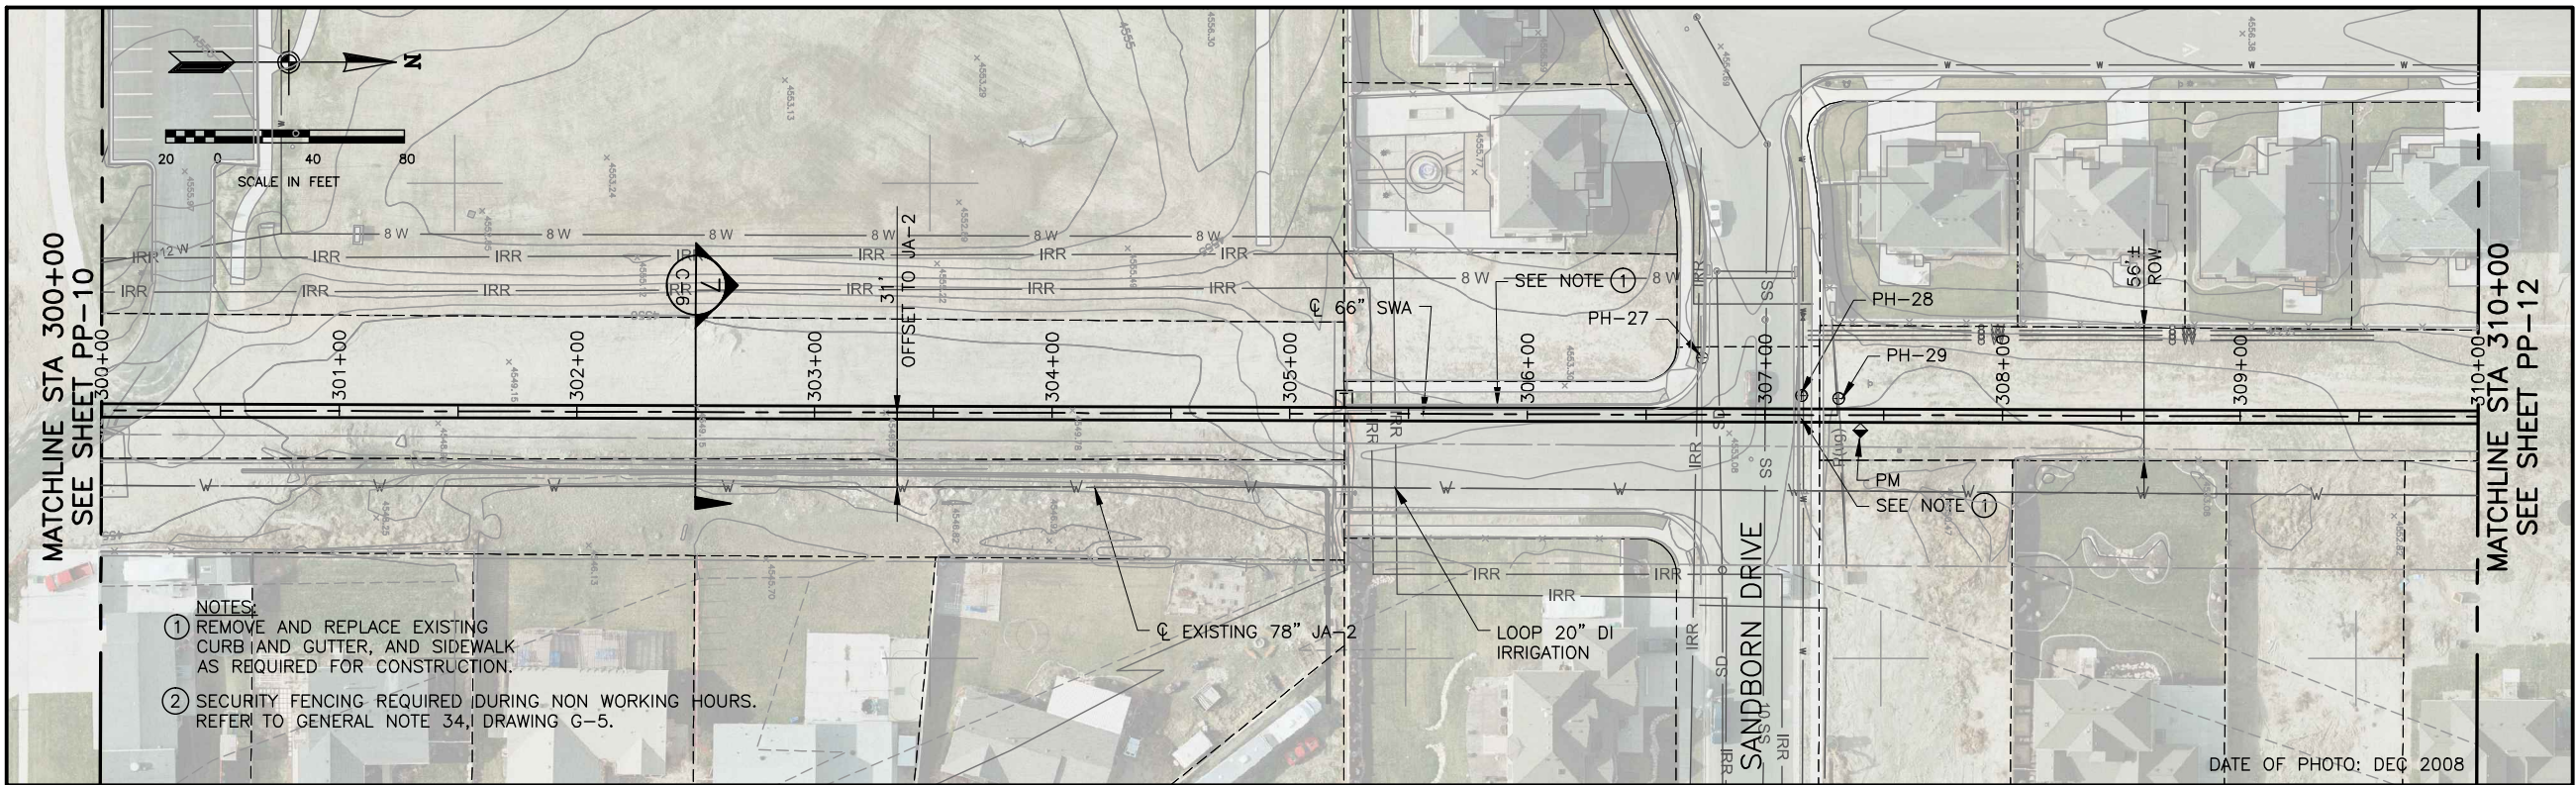

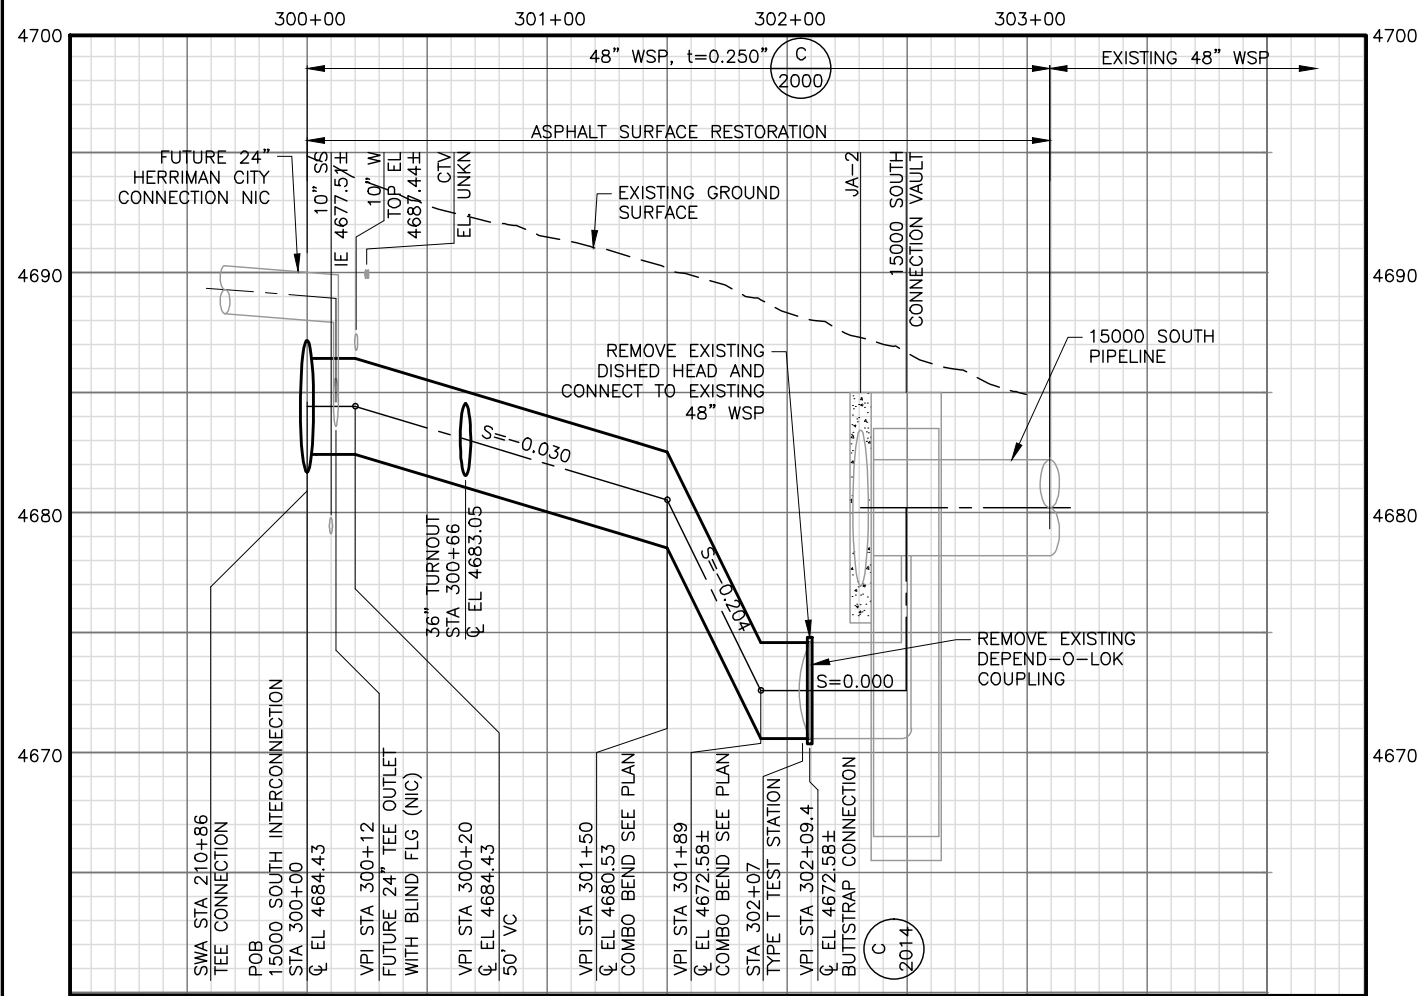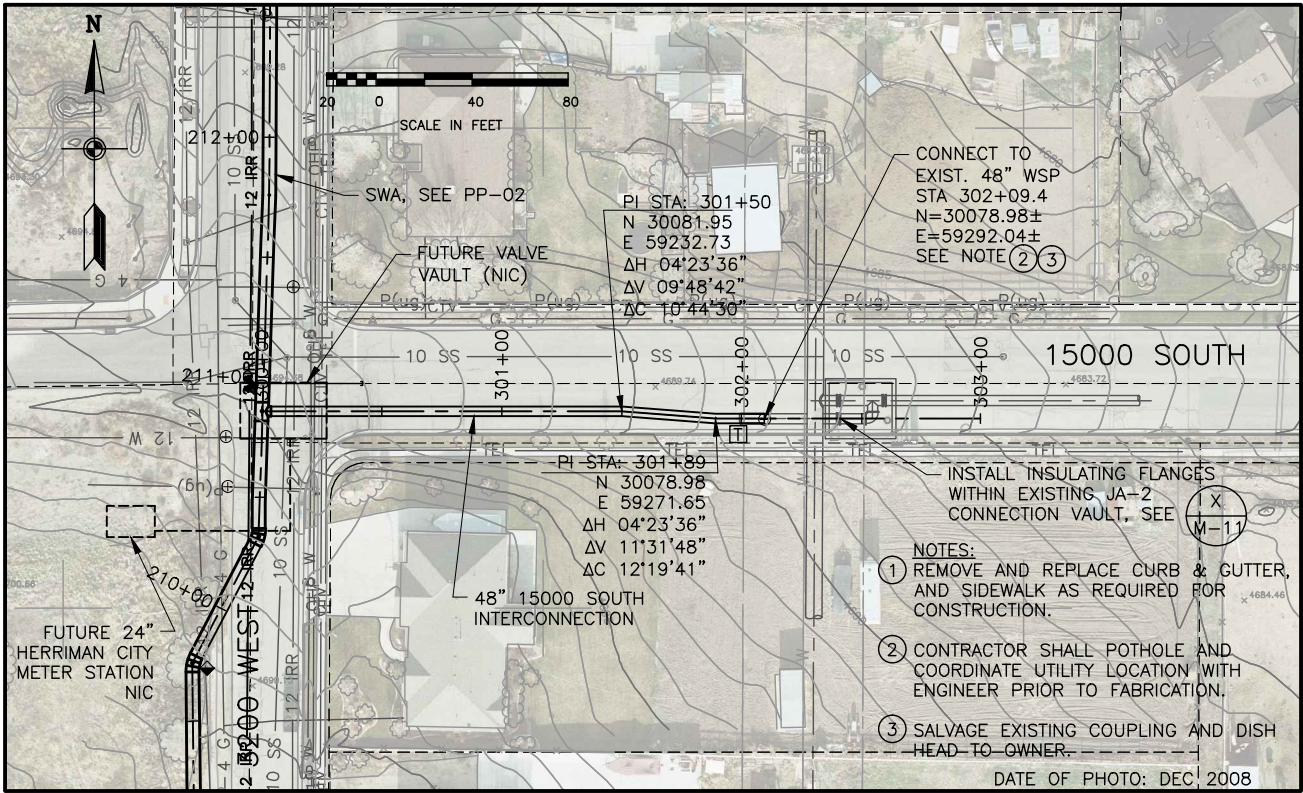

15000 SOUTH INTERCONNECTION

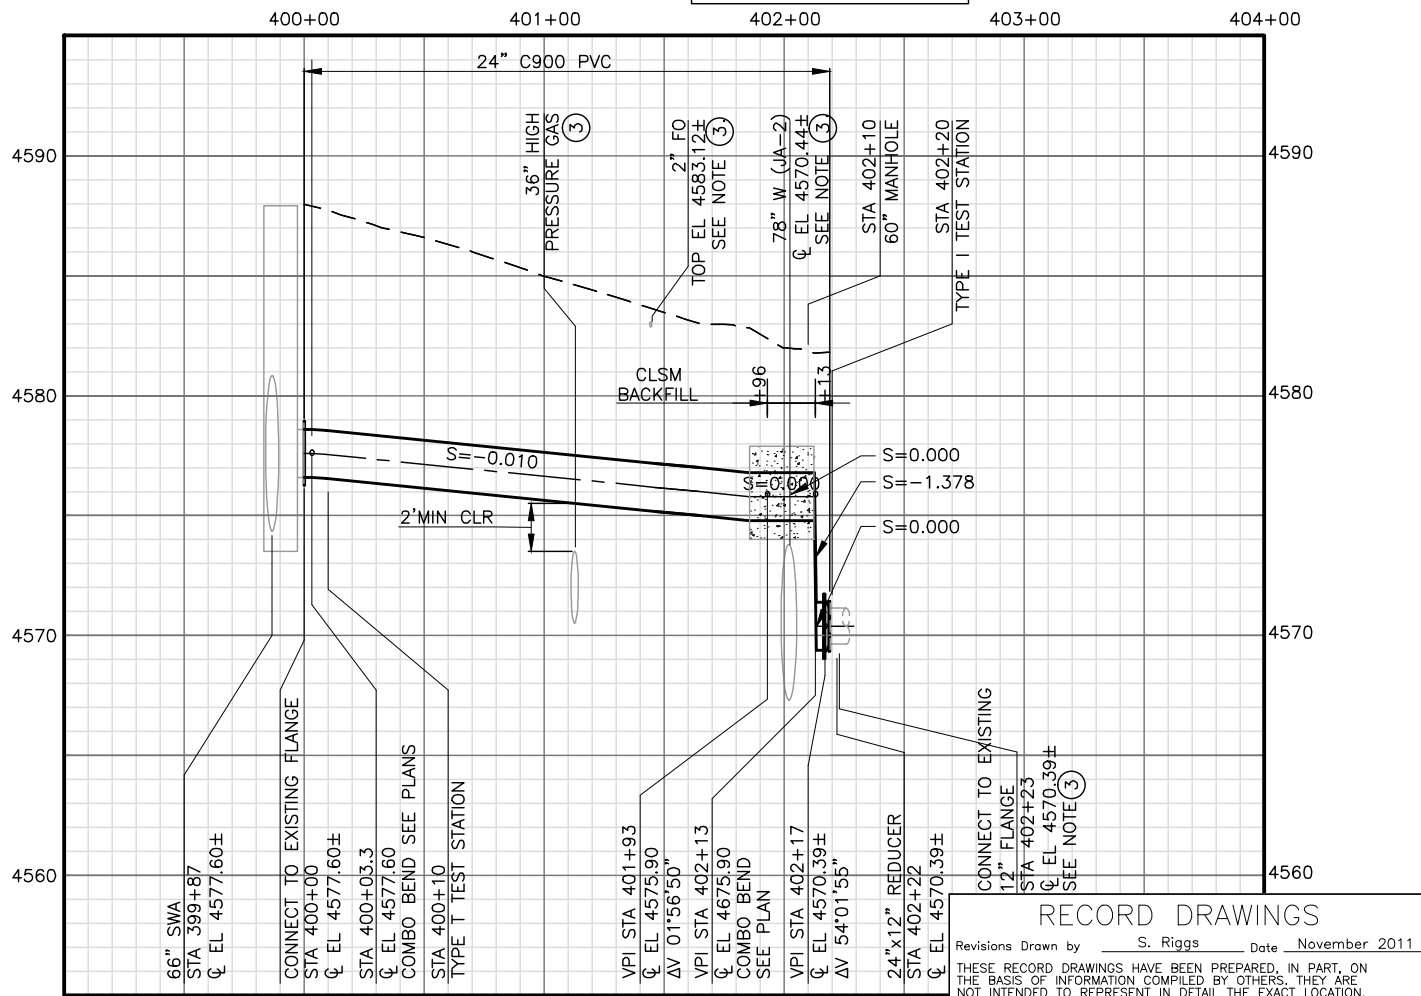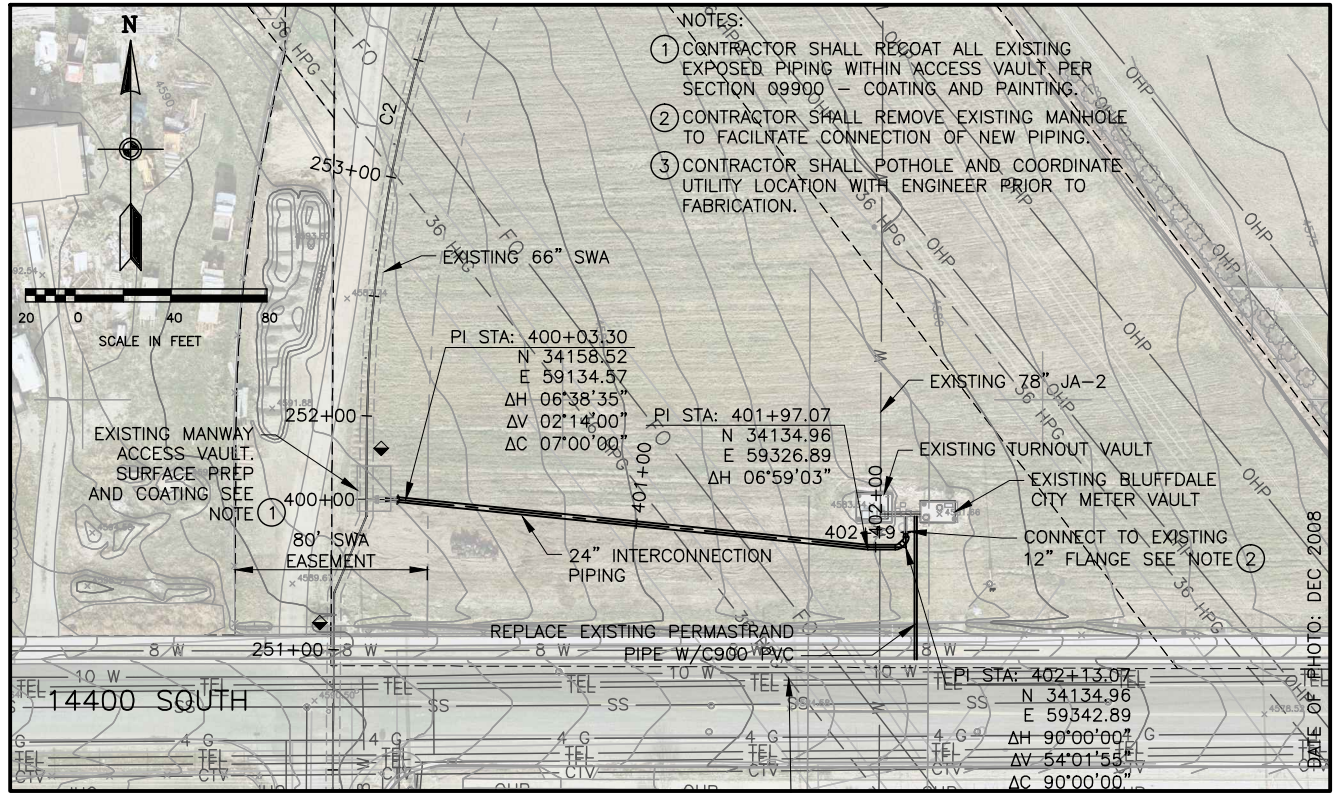

14400 SOUTH INTERCONNECTION

RECORD DRAWINGS

Revisions Drawn by S. Riggs Date November 2011

THESE RECORD DRAWINGS HAVE BEEN PREPARED, IN PART, ON
THE BASIS OF INFORMATION COMPILED BY OTHERS. THEY ARE
NOT INTENDED TO REPRESENT IN DETAIL THE EXACT LOCATION,
TYPE OF COMPONENT NOR MANNER OF CONSTRUCTION. THE ENGINEER
WILL NOT BE RESPONSIBLE FOR ANY ERRORS OR OMISSIONS WHICH
HAVE BEEN INCORPORATED INTO THE RECORD DRAWINGS.

Bowen Collins & Associates, Inc.
Consulting Engineers

NO.	DATE	REV. BY	DESCRIPTION

JORDAN VALLEY WATER CONSERVANCY DISTRICT

SOUTHWEST AQUEDUCT REACH 2 PROJECT

CIVIL

15000 SOUTH, AND 14400 SOUTH INTERCONNECTION PLAN AND PROFILE


STA 300+00 TO STA 302+09.4
STA 400+00 TO STA 402+23

DATE: FEBRUARY 2010 PROJECT NUMBER 010-08-03

DESIGN	REVIEW	VERIFY SCALE
DESIGN T. OLSEN	CHECKED M. COLLINS	BAR IS ONE INCH ON ORIGINAL DRAWING
DRAWN R.D./R.G.	APPROVED J. LUETTINGER	

DRAWING NO. **PP-13**

SHEET 20 OF 110

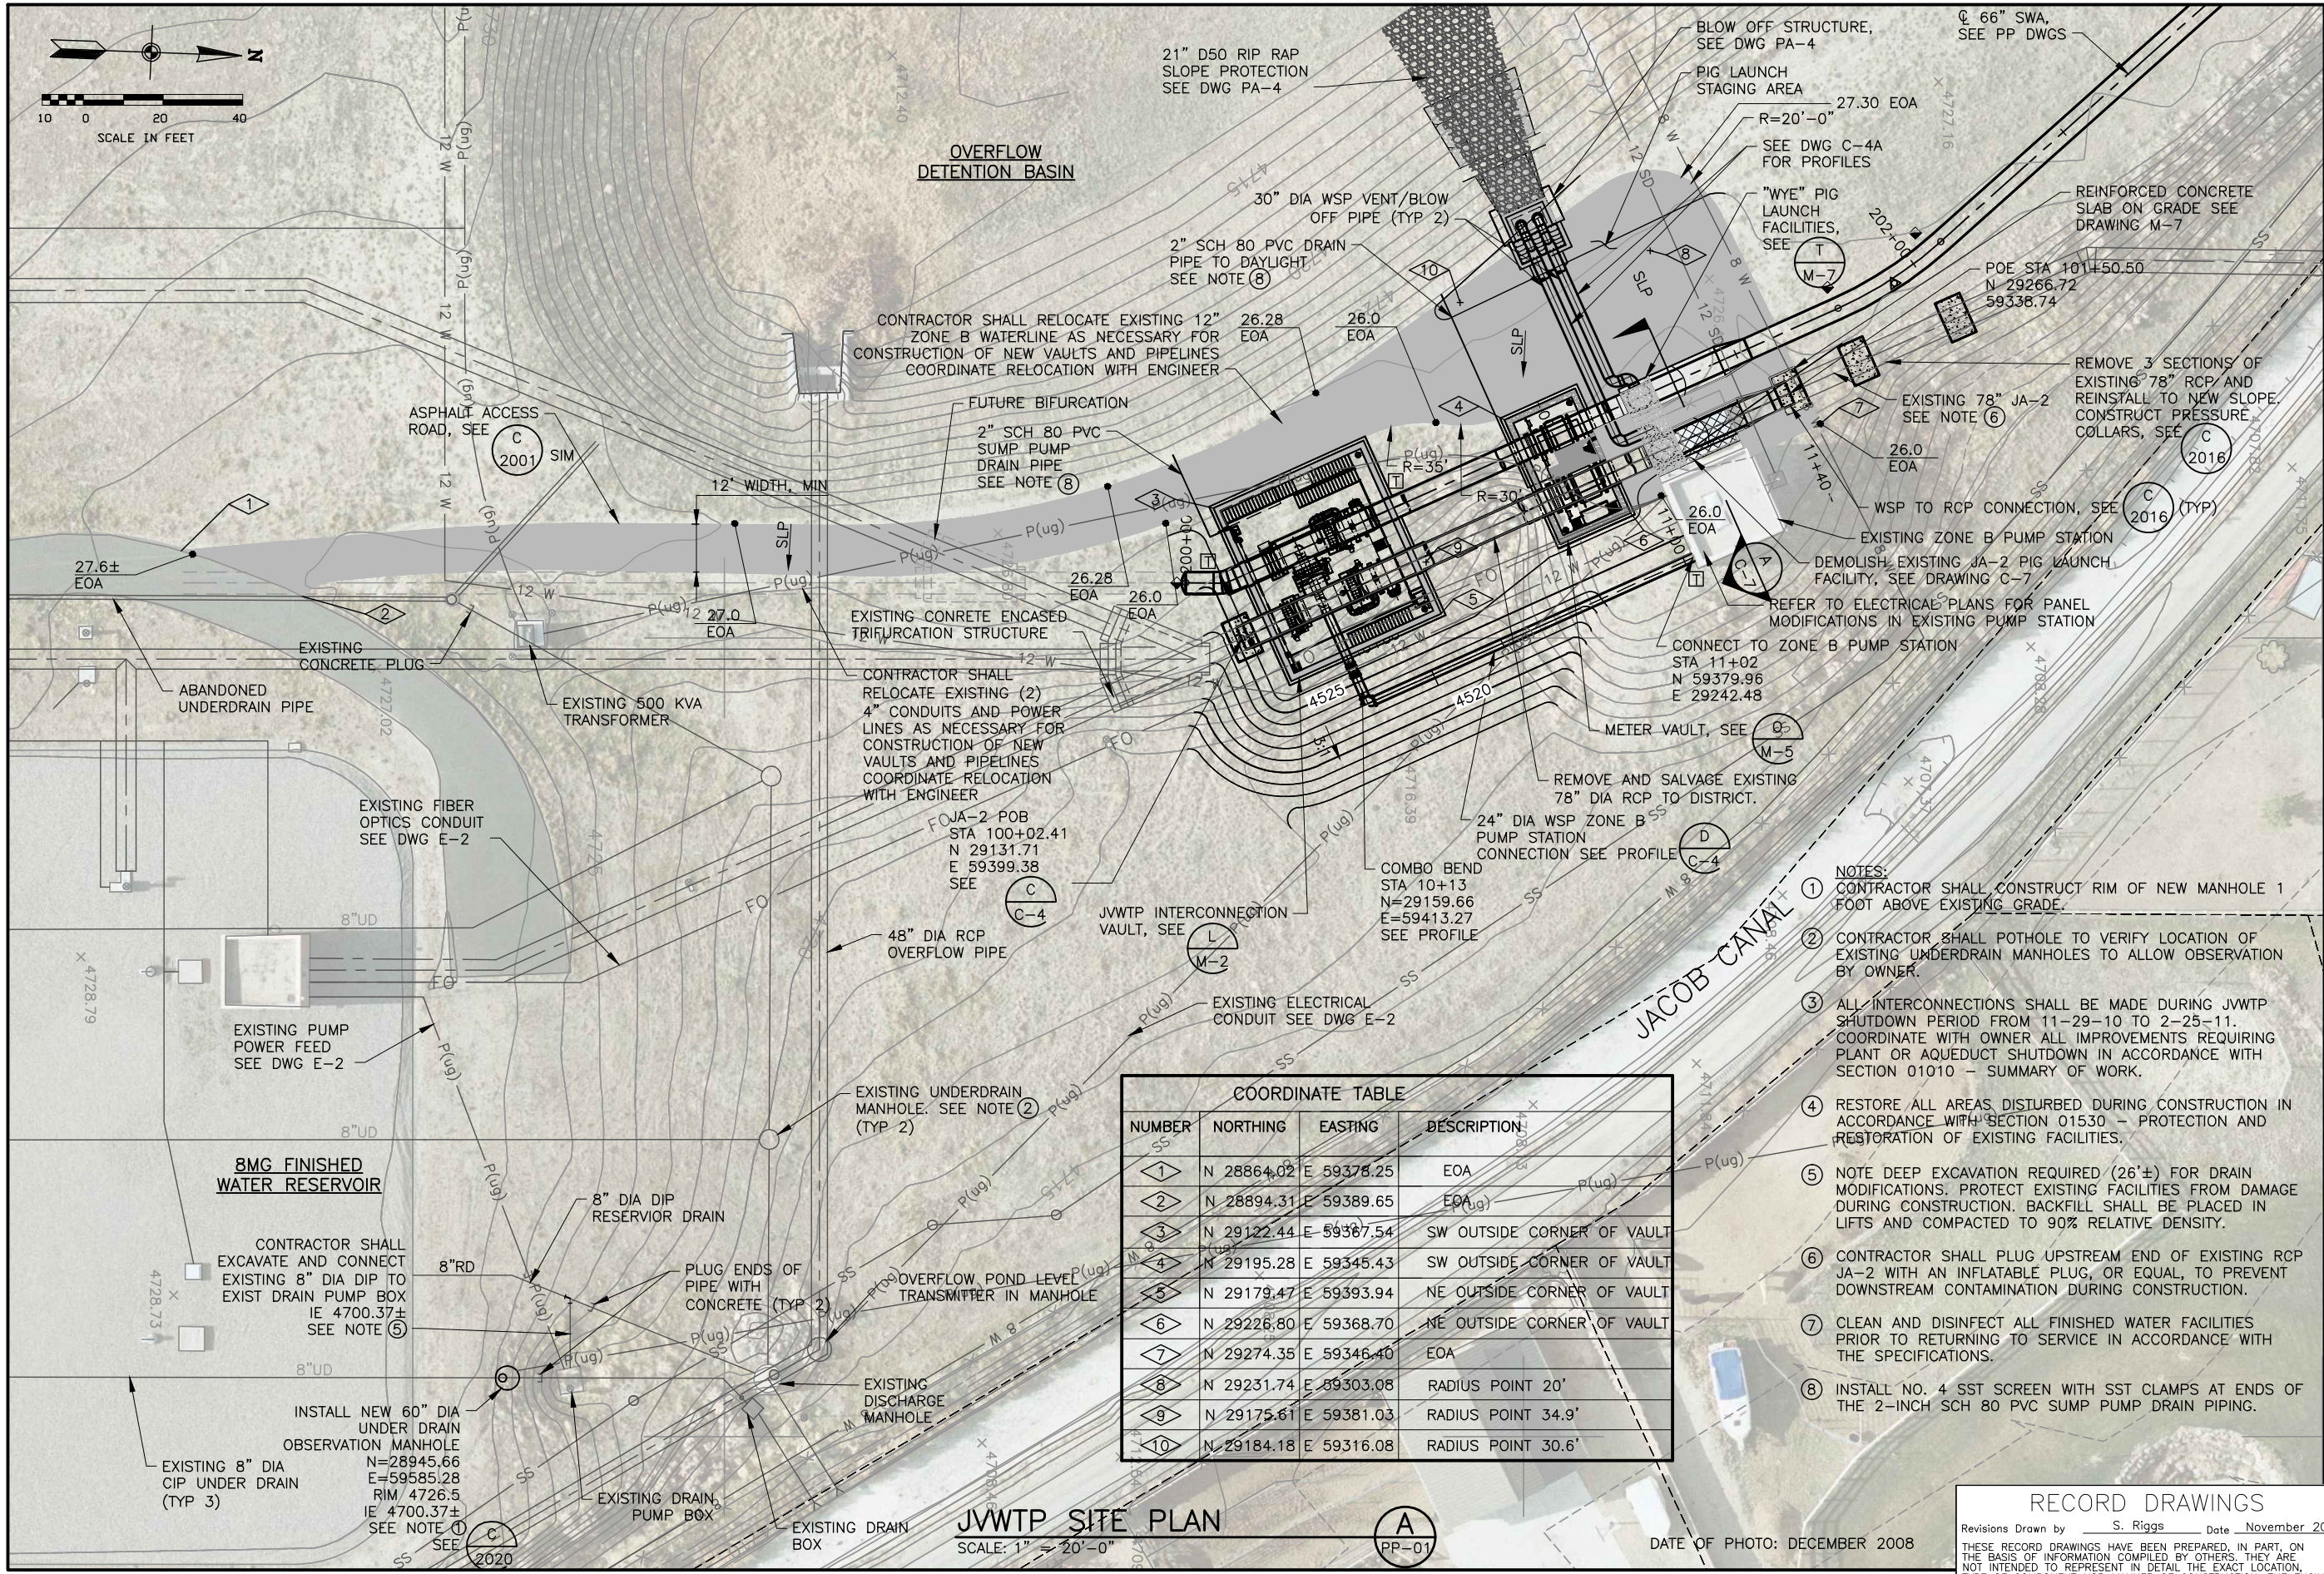

COORDINATE TABLE			
NUMBER	NORTHING	EASTING	DESCRIPTION
1	N 28864.02	E 59378.25	EOA
2	N 28894.31	E 59389.65	EOA
3	N 29122.44	E 59387.54	SW OUTSIDE CORNER OF VAULT
4	N 29195.28	E 59345.43	SW OUTSIDE CORNER OF VAULT
5	N 29179.47	E 59393.94	NE OUTSIDE CORNER OF VAULT
6	N 29226.80	E 59368.70	NE OUTSIDE CORNER OF VAULT
7	N 29274.35	E 59346.40	EOA
8	N 29231.74	E 59303.08	RADIUS POINT 20'
9	N 29175.61	E 59381.03	RADIUS POINT 34.9'
10	N 29184.18	E 59316.08	RADIUS POINT 30.6'

- NOTES:
- CONTRACTOR SHALL CONSTRUCT RIM OF NEW MANHOLE 1 FOOT ABOVE EXISTING GRADE.
 - CONTRACTOR SHALL POTHOLE TO VERIFY LOCATION OF EXISTING UNDERDRAIN MANHOLES TO ALLOW OBSERVATION BY OWNER.
 - ALL INTERCONNECTIONS SHALL BE MADE DURING JWTP SHUTDOWN PERIOD FROM 11-29-10 TO 2-25-11. COORDINATE WITH OWNER ALL IMPROVEMENTS REQUIRING PLANT OR AQUEDUCT SHUTDOWN IN ACCORDANCE WITH SECTION 01010 - SUMMARY OF WORK.
 - RESTORE ALL AREAS DISTURBED DURING CONSTRUCTION IN ACCORDANCE WITH SECTION 01530 - PROTECTION AND RESTORATION OF EXISTING FACILITIES.
 - NOTE DEEP EXCAVATION REQUIRED (26'±) FOR DRAIN MODIFICATIONS. PROTECT EXISTING FACILITIES FROM DAMAGE DURING CONSTRUCTION. BACKFILL SHALL BE PLACED IN LIFTS AND COMPACTED TO 90% RELATIVE DENSITY.
 - CONTRACTOR SHALL PLUG UPSTREAM END OF EXISTING RCP JA-2 WITH AN INFLATABLE PLUG, OR EQUAL, TO PREVENT DOWNSTREAM CONTAMINATION DURING CONSTRUCTION.
 - CLEAN AND DISINFECT ALL FINISHED WATER FACILITIES PRIOR TO RETURNING TO SERVICE IN ACCORDANCE WITH THE SPECIFICATIONS.
 - INSTALL NO. 4 SST SCREEN WITH SST CLAMPS AT ENDS OF THE 2-INCH SCH 80 PVC SUMP PUMP DRAIN PIPING.

JWTP SITE PLAN

SCALE: 1" = 20'-0"

A
PP-01

DATE OF PHOTO: DECEMBER 2008

RECORD DRAWINGS

Revisions Drawn by S. Riggs Date November 2011

THESE RECORD DRAWINGS HAVE BEEN PREPARED, IN PART, ON THE BASIS OF INFORMATION COMPILED BY OTHERS. THEY ARE NOT INTENDED TO REPRESENT IN DETAIL THE EXACT LOCATION, TYPE OF COMPONENT NOR MANNER OF CONSTRUCTION. THE ENGINEER WILL NOT BE RESPONSIBLE FOR ANY ERRORS OR OMISSIONS WHICH HAVE BEEN INCORPORATED INTO THE RECORD DRAWINGS.

NO.	DATE	REV. BY	DESCRIPTION

JORDAN VALLEY WATER CONSERVANCY DISTRICT

SOUTHWEST AQUEDUCT REACH 2 PROJECT

DESIGN T. OLSEN
DRAWN R.D./R.G.

REVIEW CHECKED M. COLLINS
APPROVED J. LUETTINGER

VERIFY SCALE
BAR IS ONE INCH ON ORIGINAL DRAWING


CIVIL


ENLARGED CIVIL PLAN
JWTP SITE


DATE: FEBRUARY 2010 PROJECT NUMBER 010-08-03

DRAWING NO. C-1


SHEET 22 OF 110

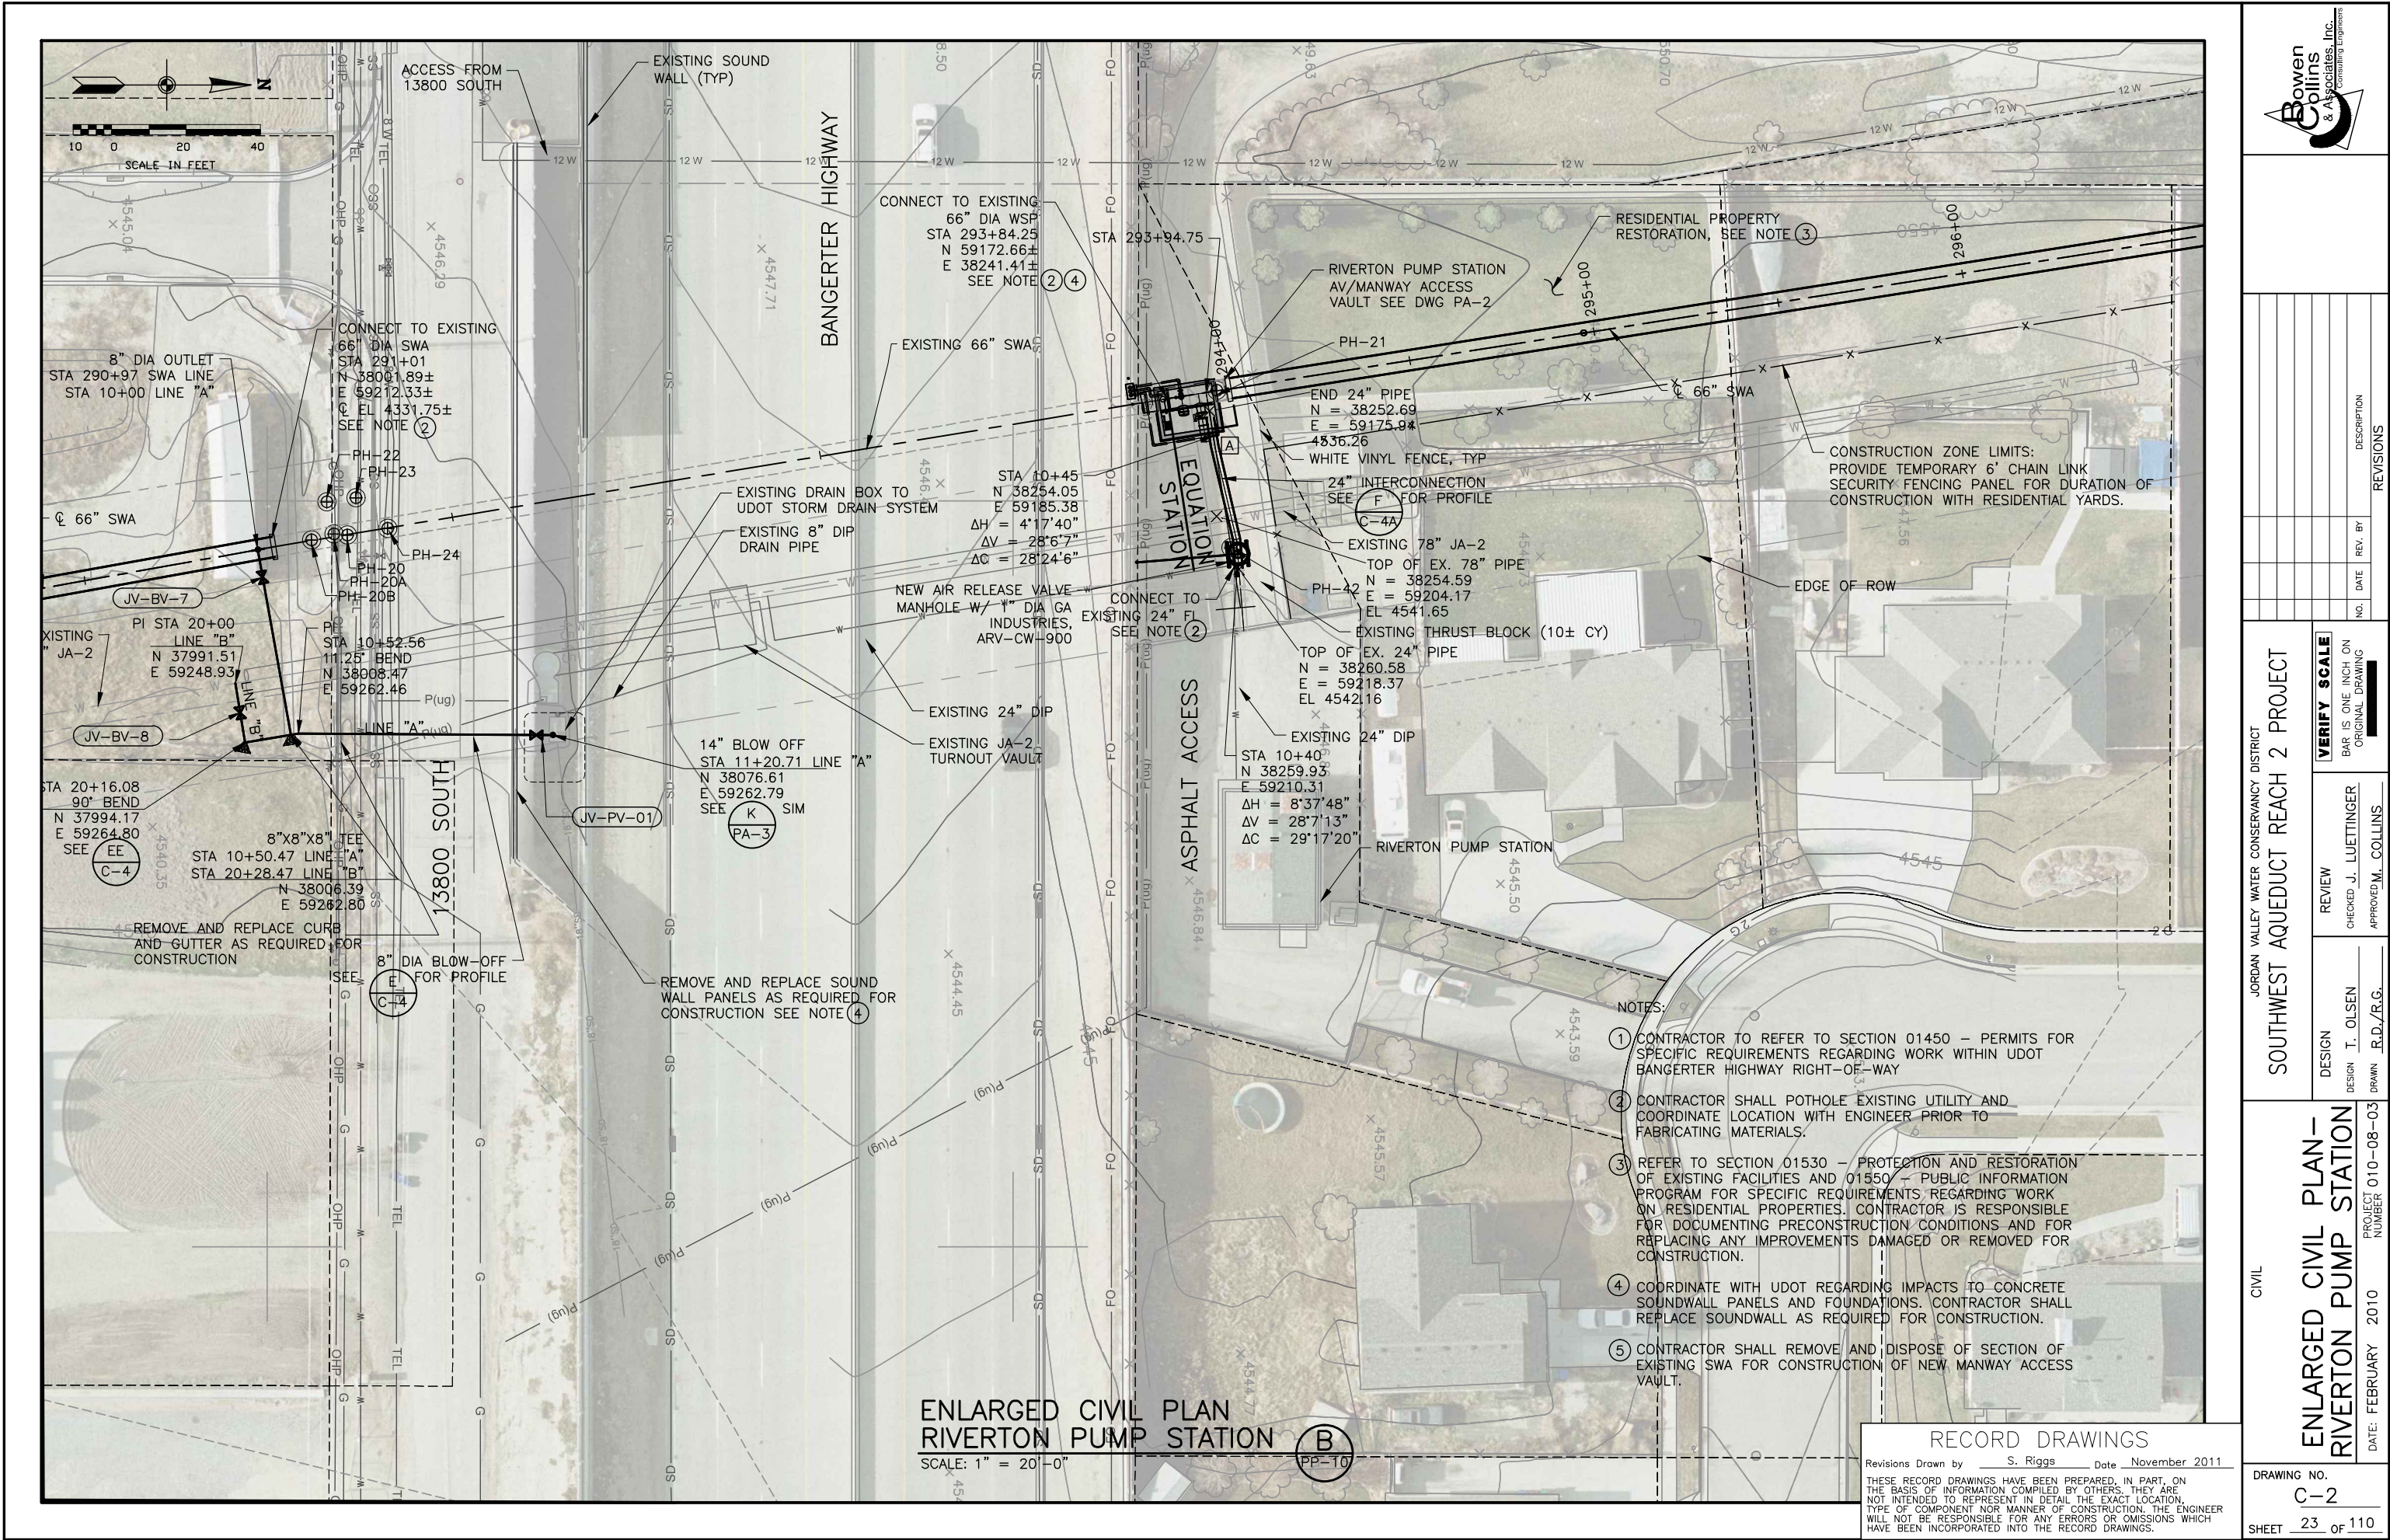

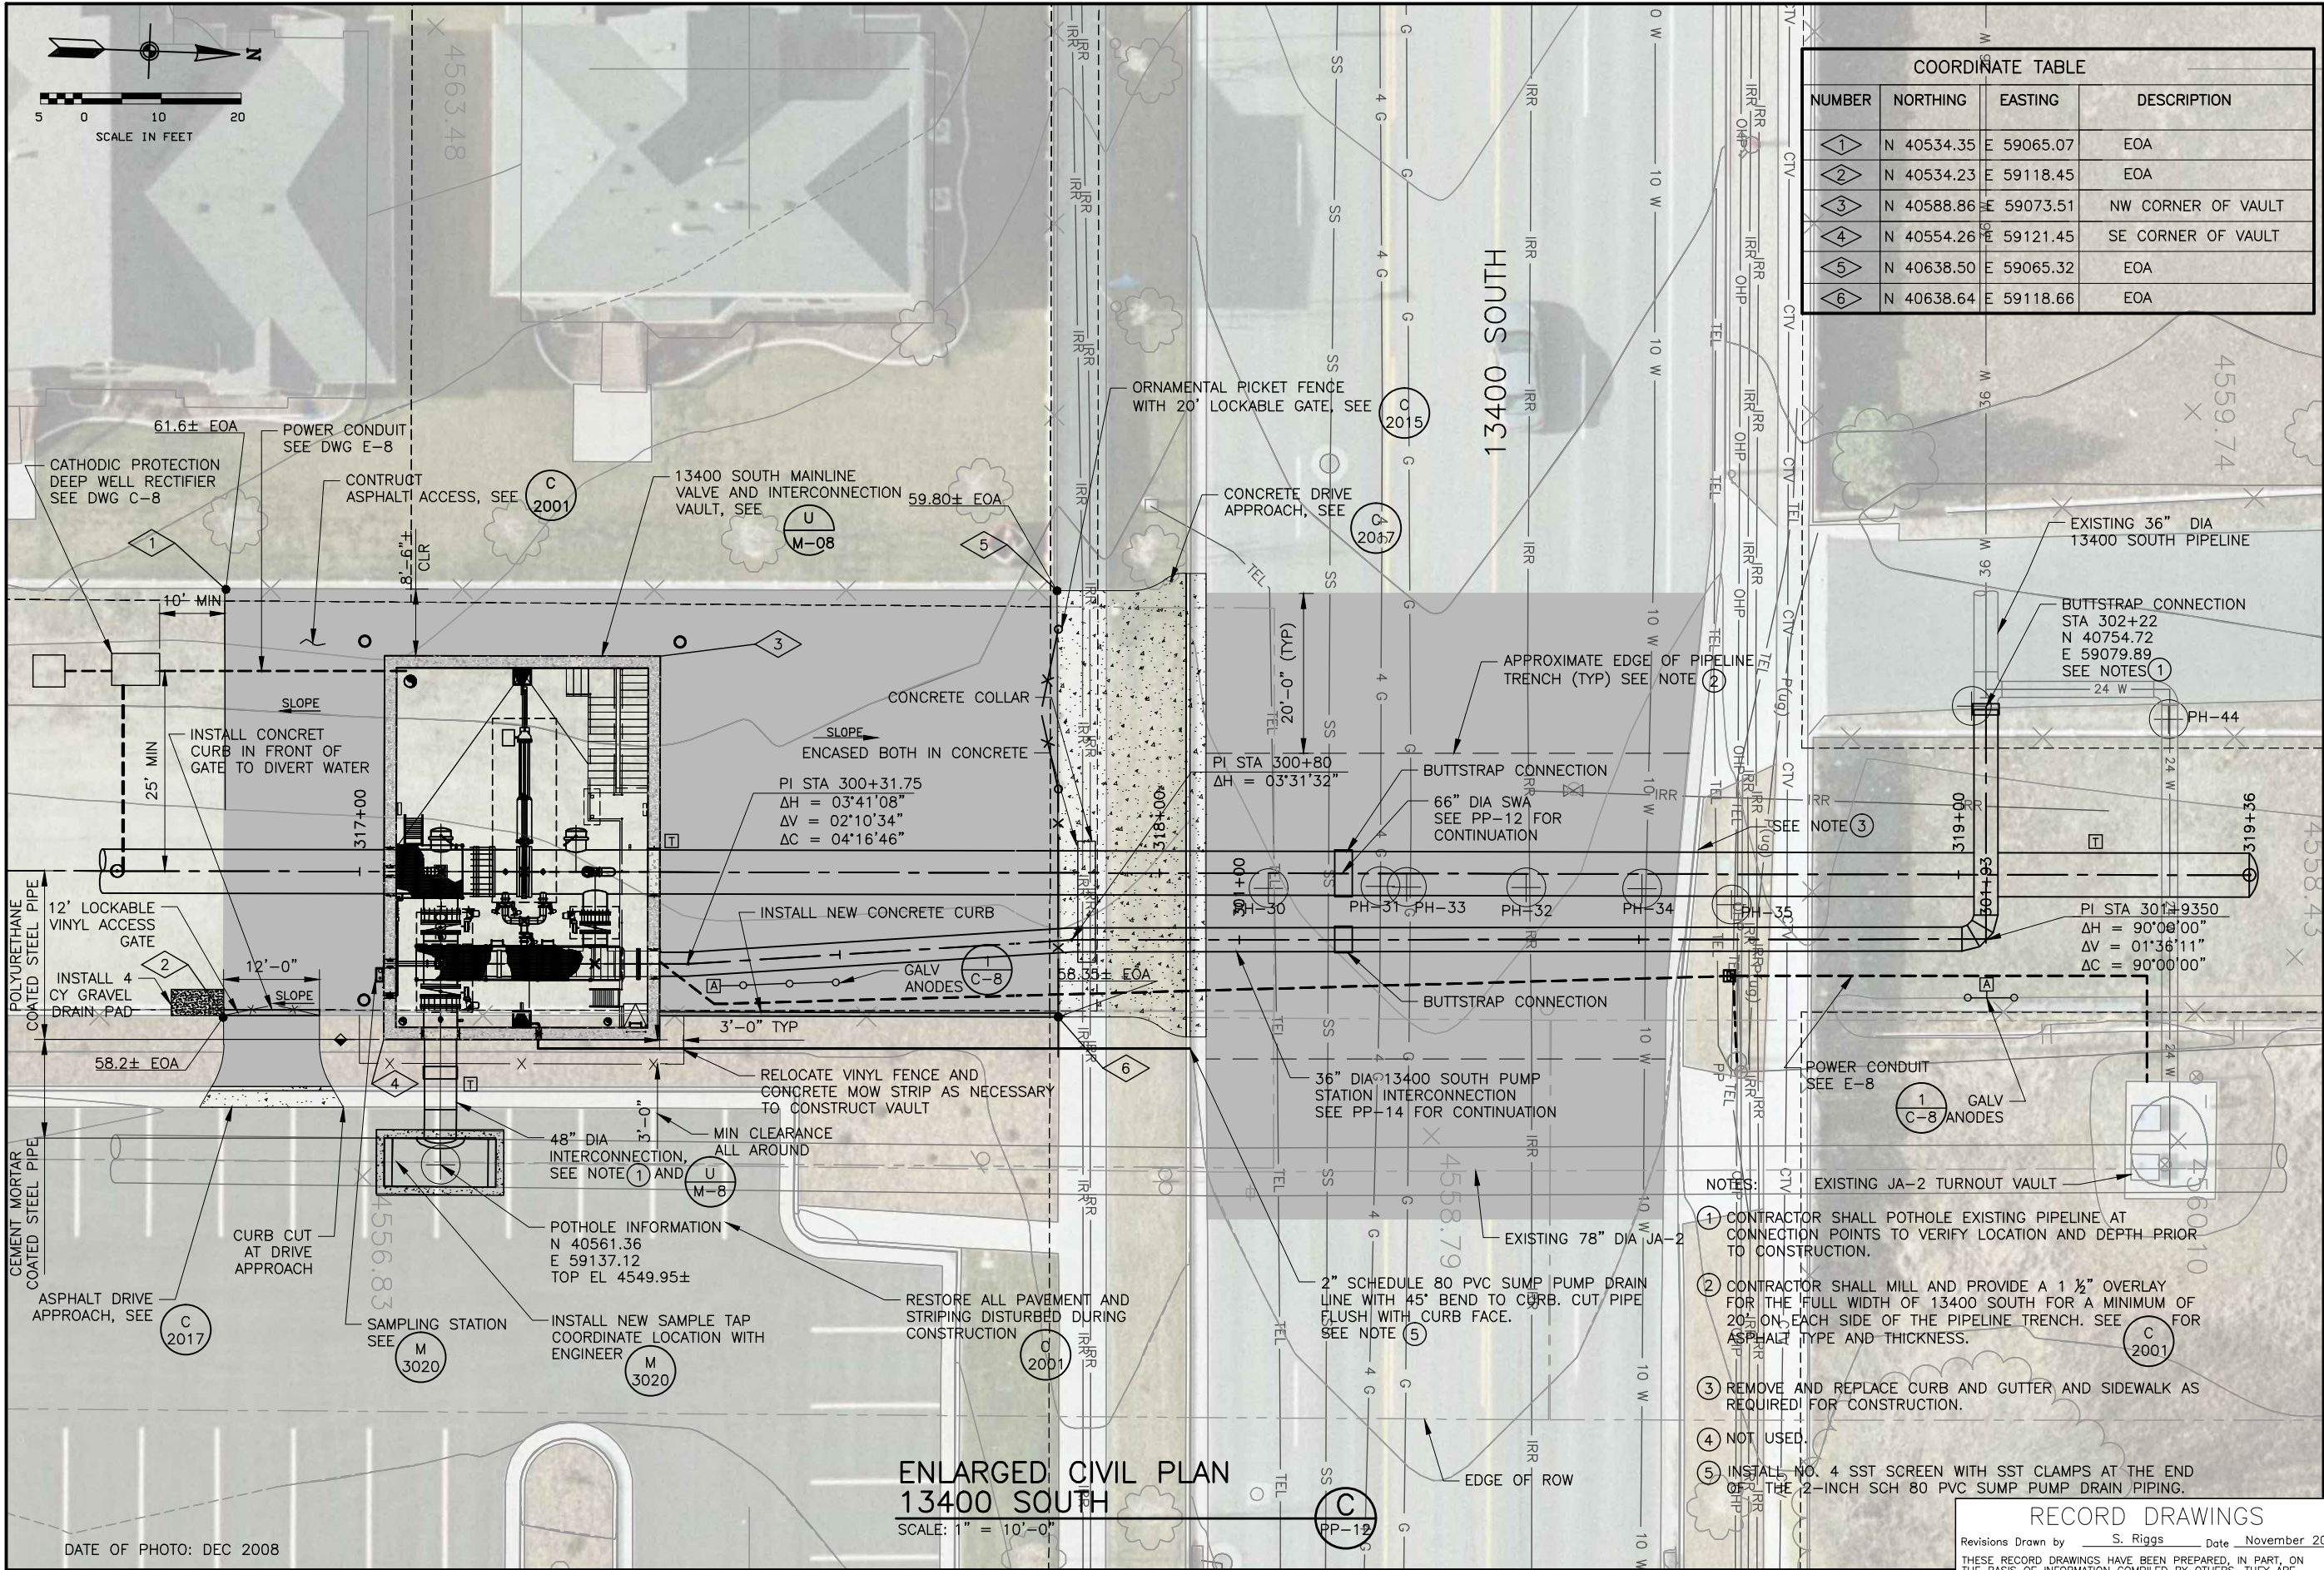


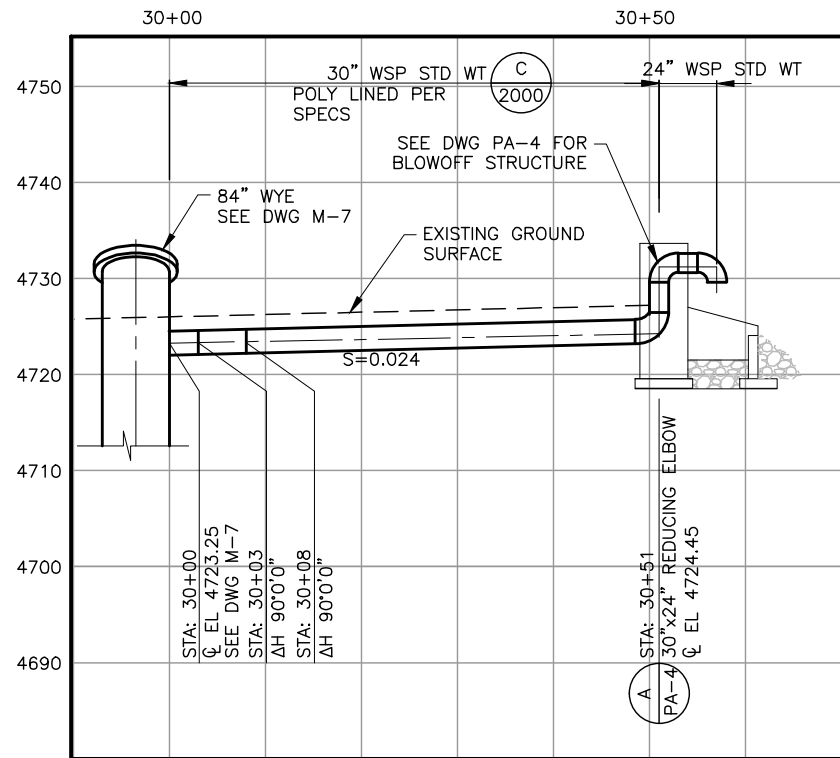


SWA AIR VENT/ BLOWOFF PROFILE **G**
SCALE: 1"=10'

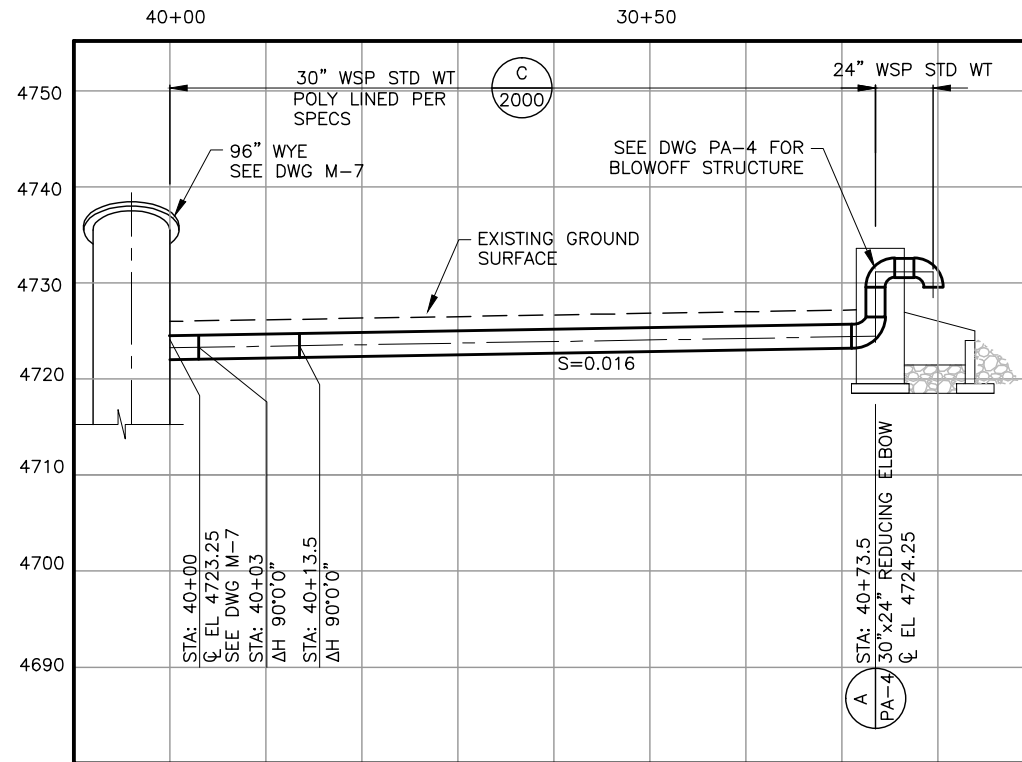

JA-2 AIR VENT/BLOWOFF PROFILE **H**
SCALE: 1"=10'

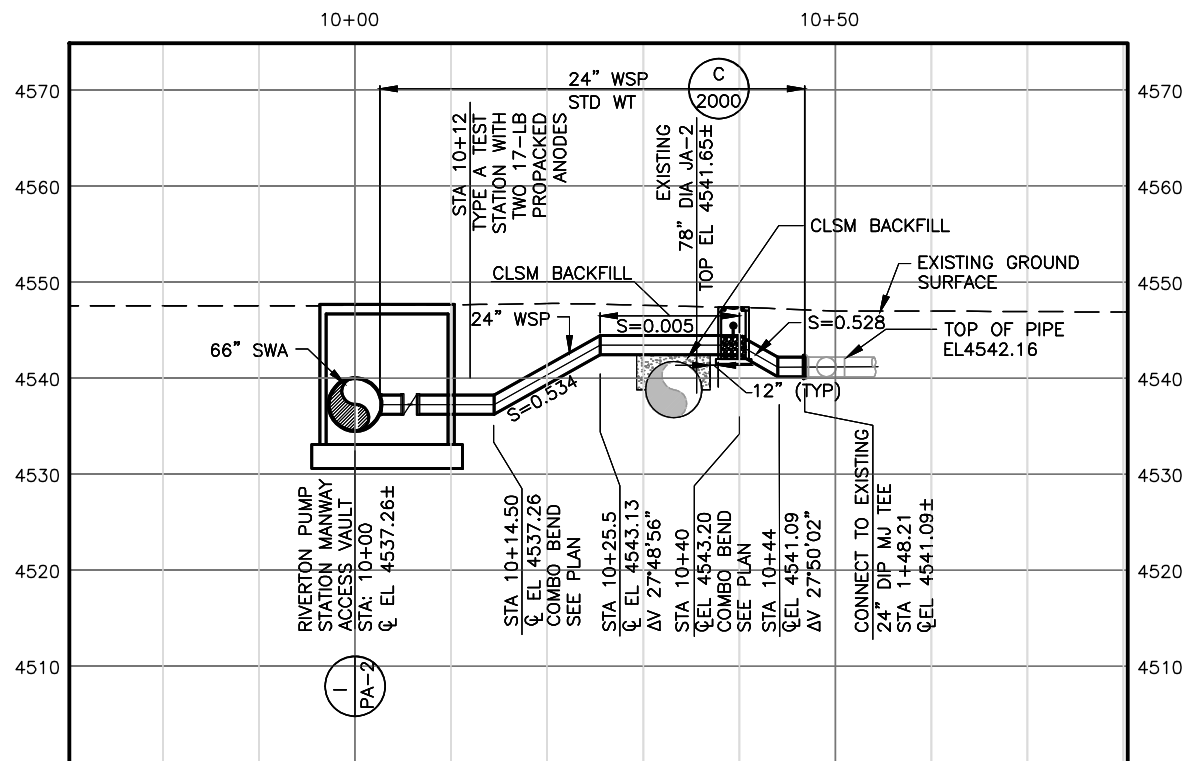

RIVERTON PUMP STATION INTERCONNECT PROFILE **F**
SCALE: 1"=10'

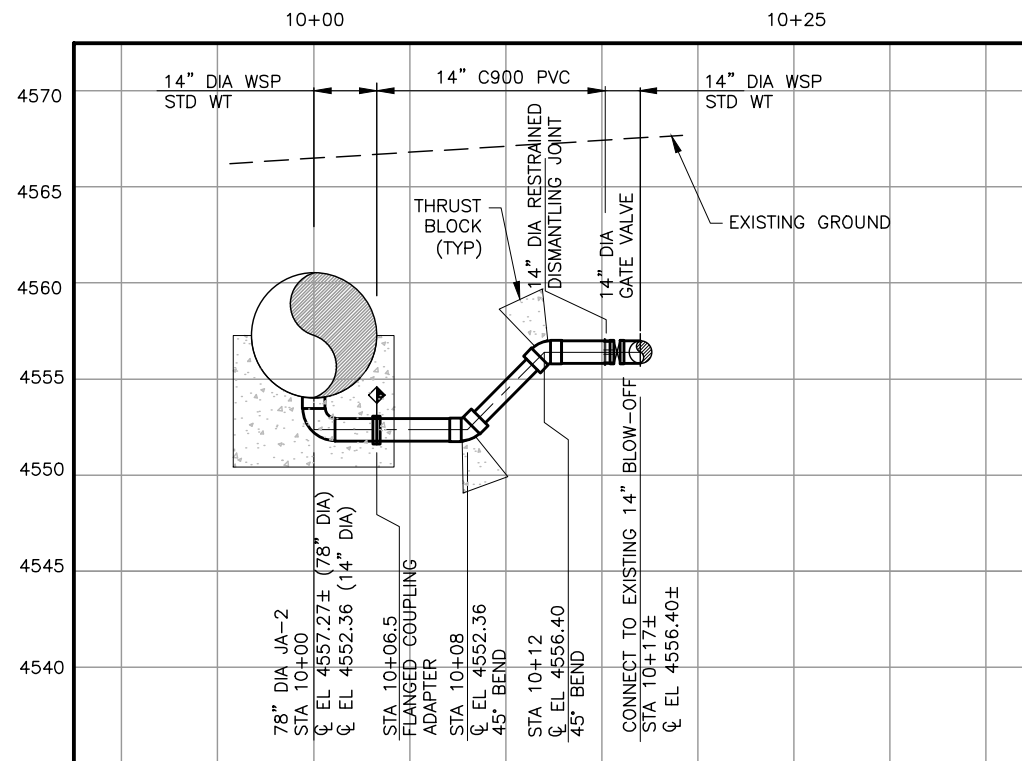

ULDC BLOWOFF PROFILE **G**
SCALE: 1"=5'

RECORD DRAWINGS

Revisions Drawn by S. Riggs Date November 2011

THESE RECORD DRAWINGS HAVE BEEN PREPARED, IN PART, ON THE BASIS OF INFORMATION COMPILED BY OTHERS. THEY ARE NOT INTENDED TO REPRESENT IN DETAIL THE EXACT LOCATION, TYPE OF COMPONENT NOR MANNER OF CONSTRUCTION. THE ENGINEER WILL NOT BE RESPONSIBLE FOR ANY ERRORS OR OMISSIONS WHICH HAVE BEEN INCORPORATED INTO THE RECORD DRAWINGS.

Bowen Collins & Associates, Inc.
Consulting Engineers

REVISIONS			
NO.	DATE	REV. BY	DESCRIPTION

JORDAN VALLEY WATER CONSERVANCY DISTRICT

SOUTHWEST AQUEDUCT REACH 2 PROJECT

DESIGN	REVIEW	VERIFY SCALE
T. OLSEN	CHECKED M. COLLINS	BAR IS ONE INCH ON ORIGINAL DRAWING
R.D./R.G.	APPROVED J. LUETTINGER	

CIVIL



PROFILES - 2

DATE: FEBRUARY 2010



PROJECT NUMBER 010-08-03

DRAWING NO. **C-4A**

SHEET **26** OF **110**

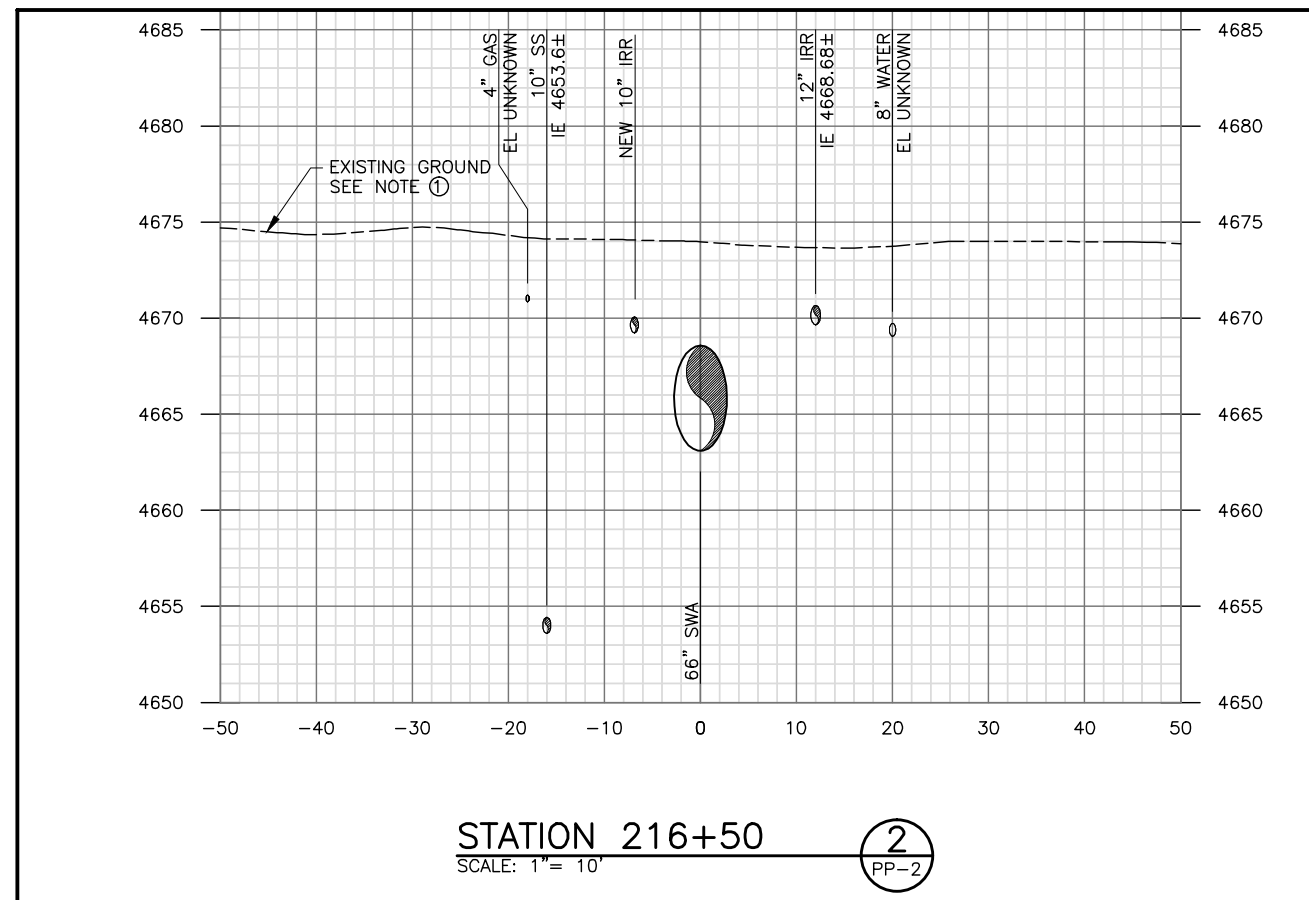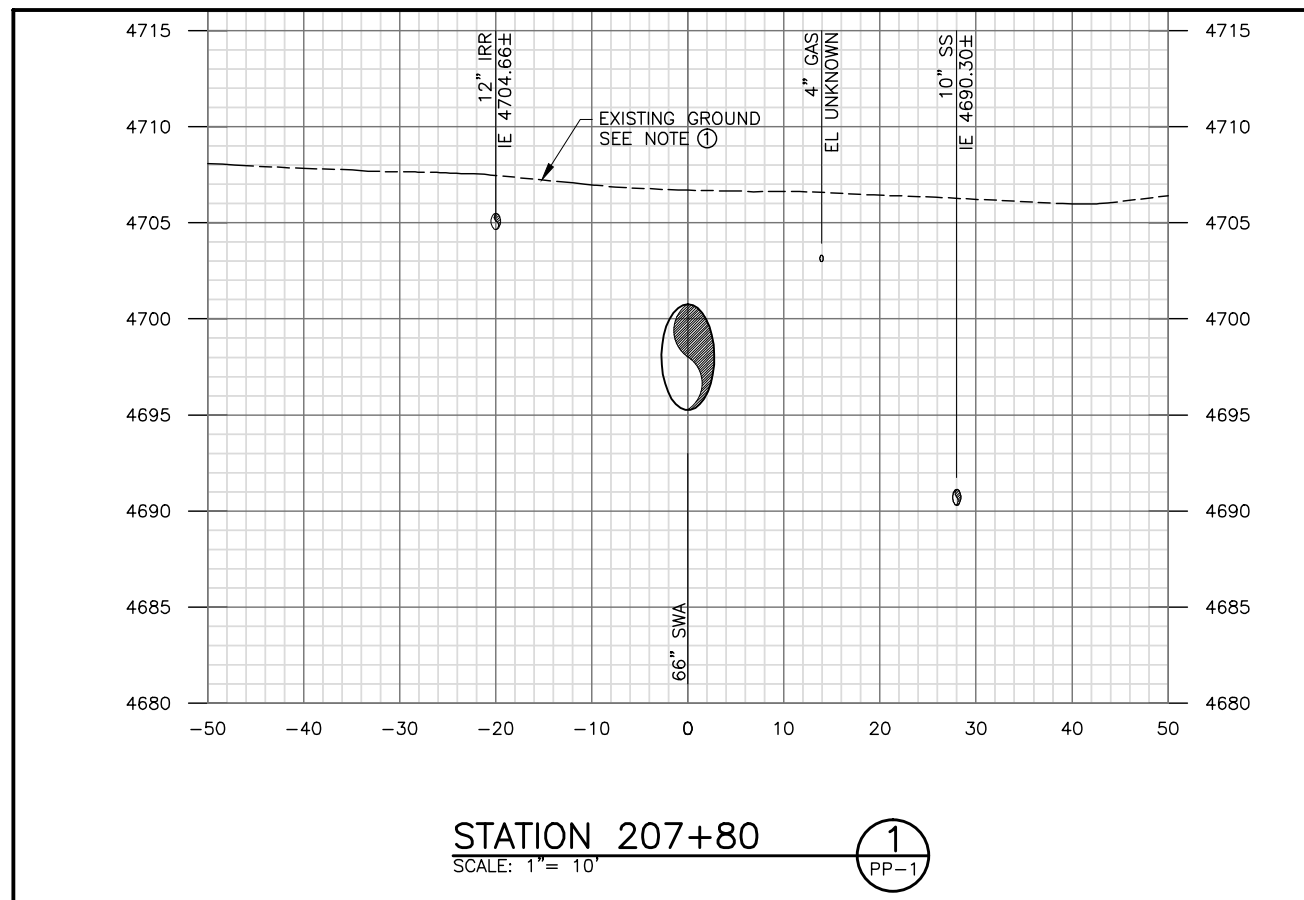





NOTES:
① CROSS SECTION PROVIDED TO ILLUSTRATE APPROXIMATE LOCATION OF UTILITIES ADJACENT TO SWA IN 3200 WEST. EXISTING SURFACE IS SHOWN. REFER TO SCHEDULE C 3200 WEST ROAD IMPROVEMENTS FOR DESIGN GRADE OF NEW ASPHALT SURFACE.

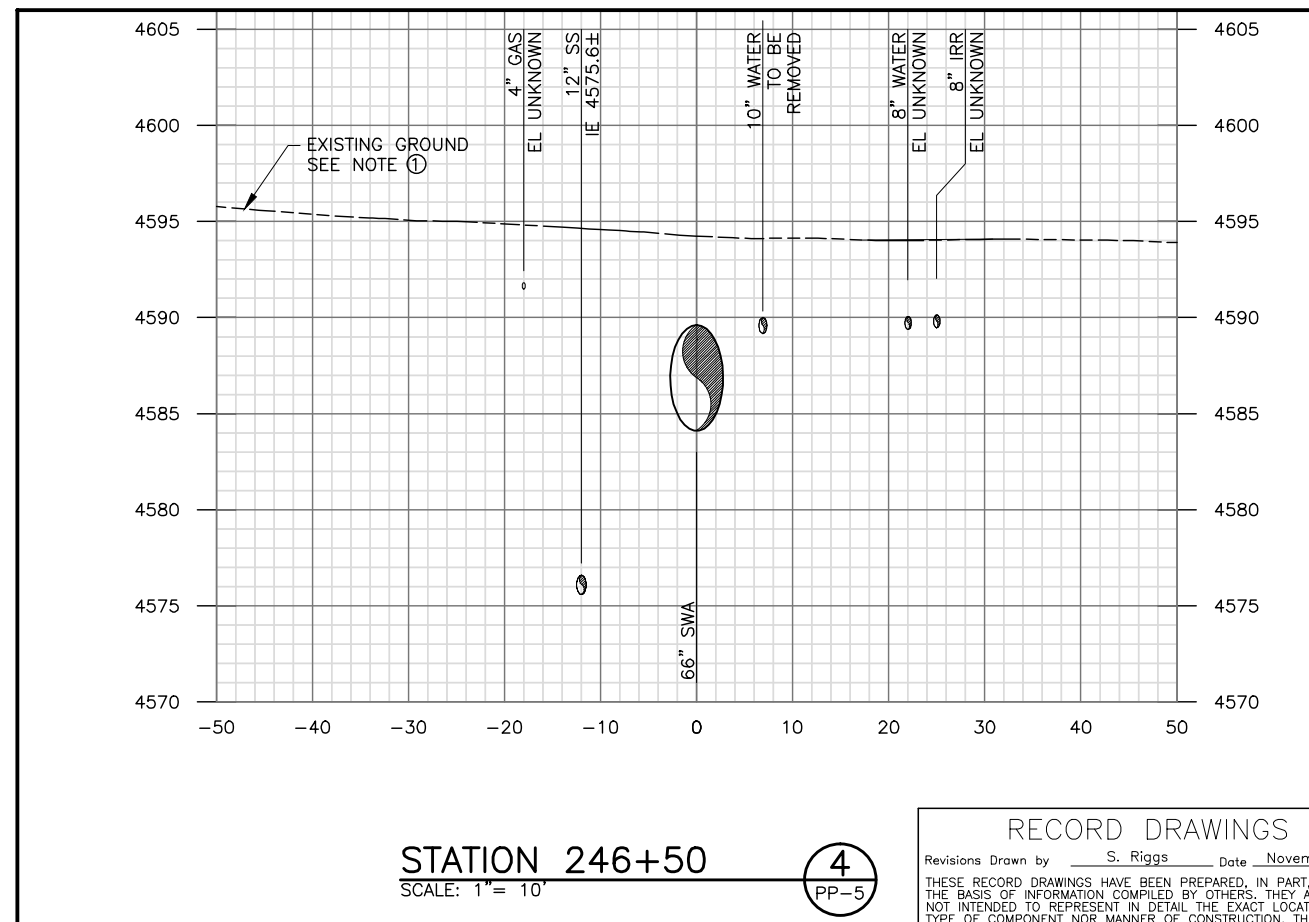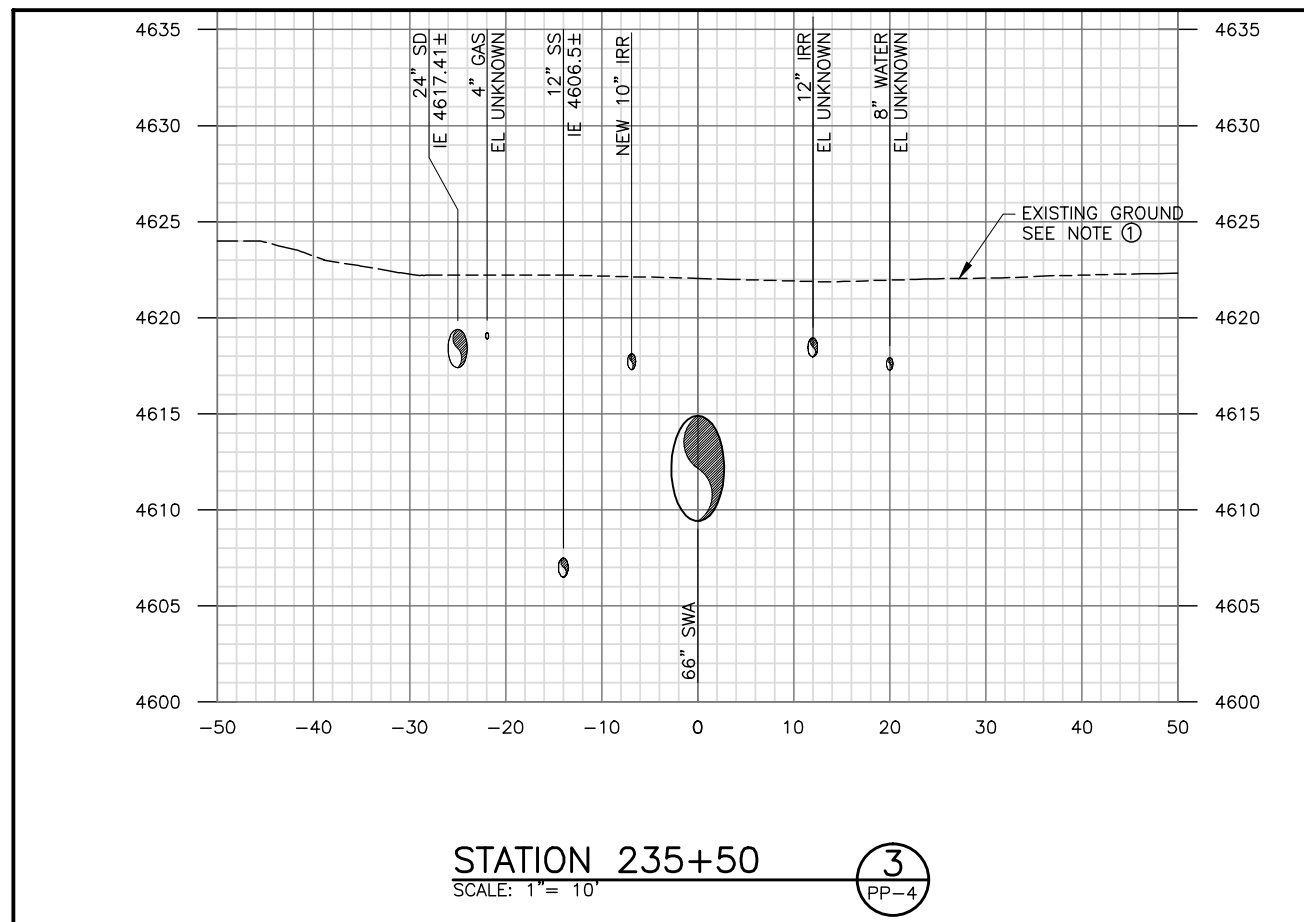


RECORD DRAWINGS

Revisions Drawn by S. Riggs Date November 2011

THESE RECORD DRAWINGS HAVE BEEN PREPARED, IN PART, ON THE BASIS OF INFORMATION COMPILED BY OTHERS. THEY ARE NOT INTENDED TO REPRESENT IN DETAIL THE EXACT LOCATION, TYPE OF COMPONENT NOR MANNER OF CONSTRUCTION. THE ENGINEER WILL NOT BE RESPONSIBLE FOR ANY ERRORS OR OMISSIONS WHICH HAVE BEEN INCORPORATED INTO THE RECORD DRAWINGS.

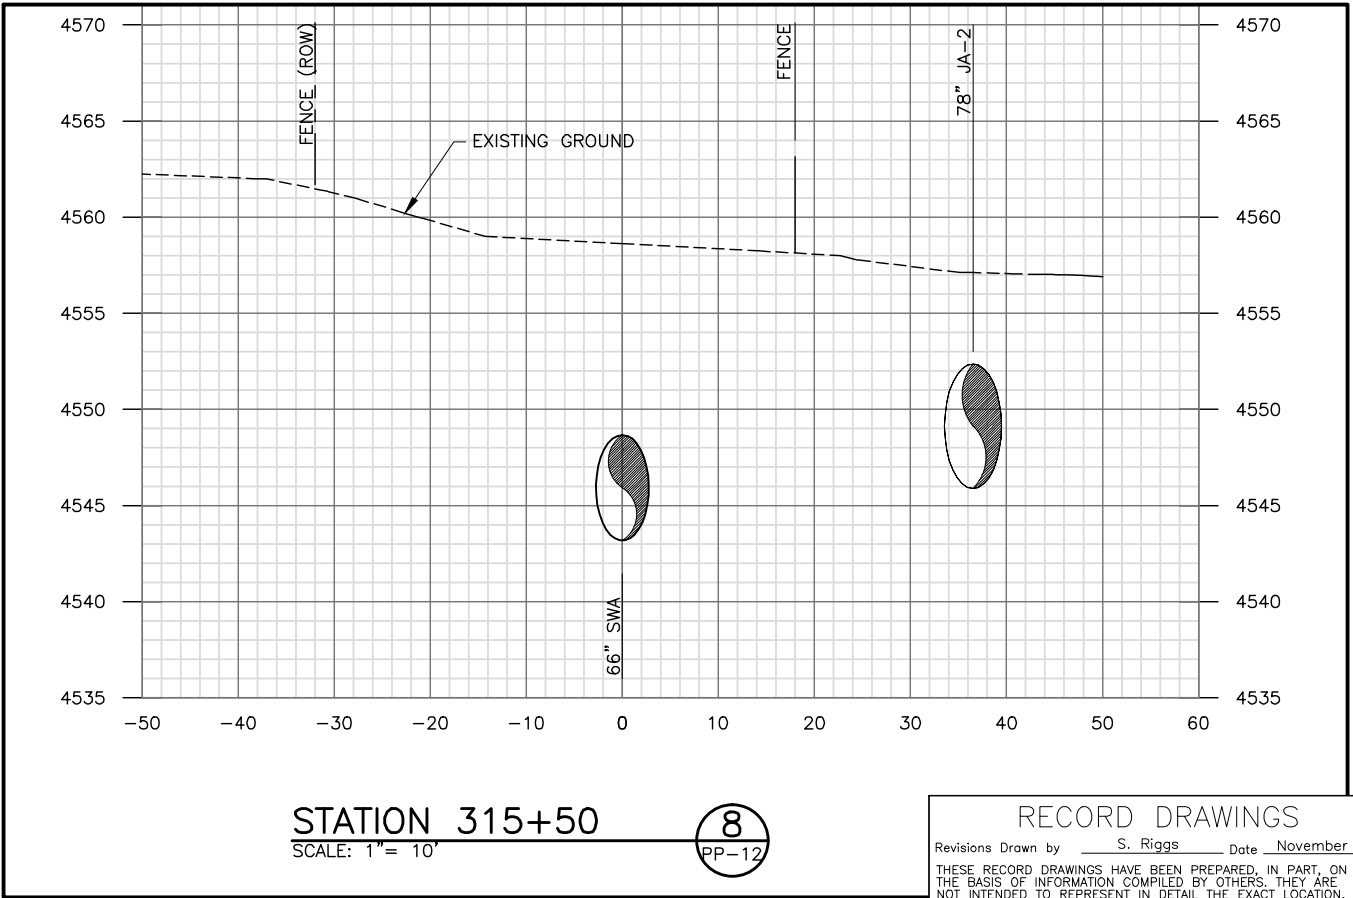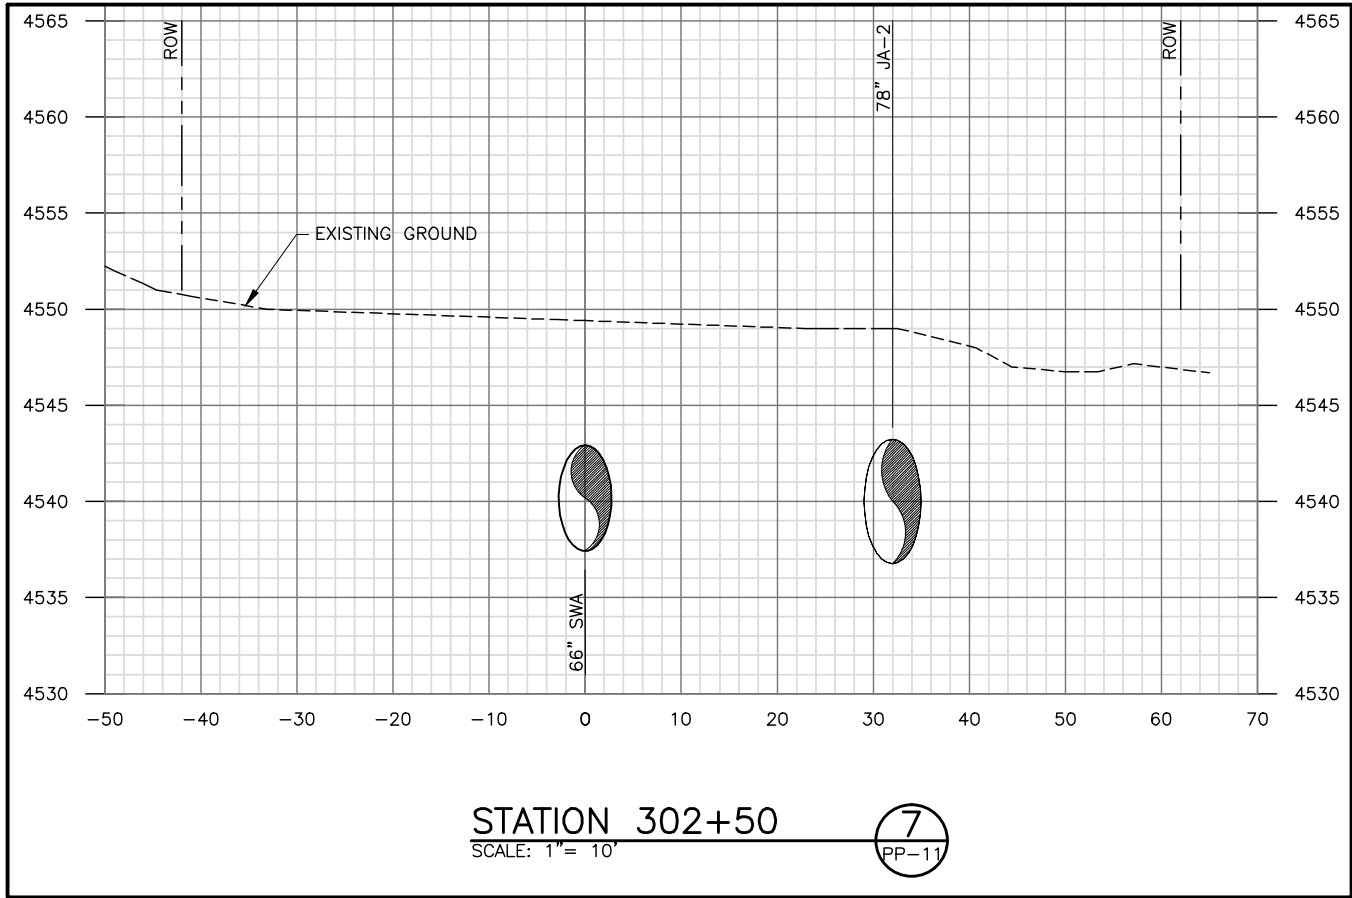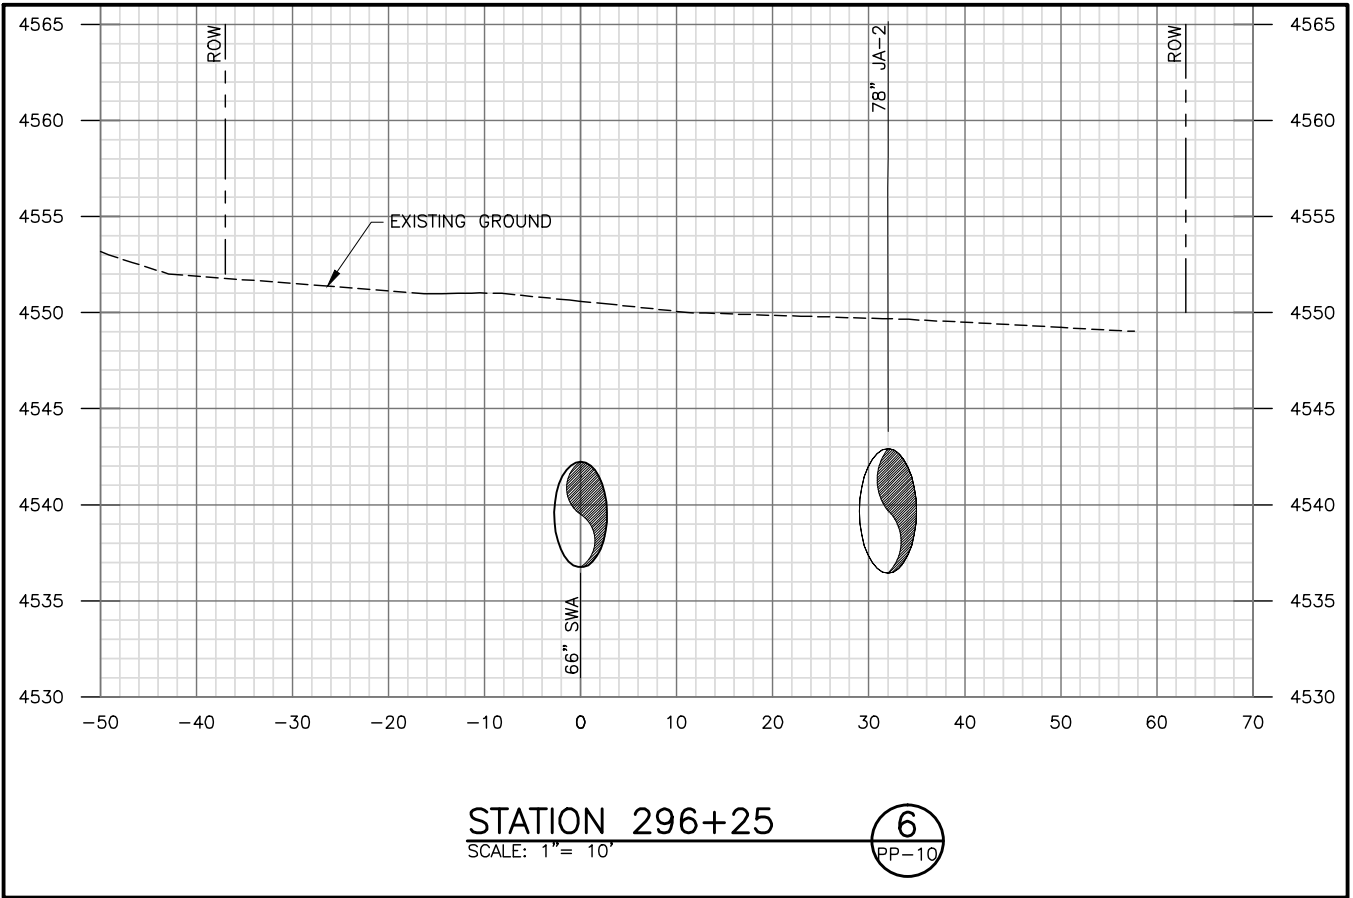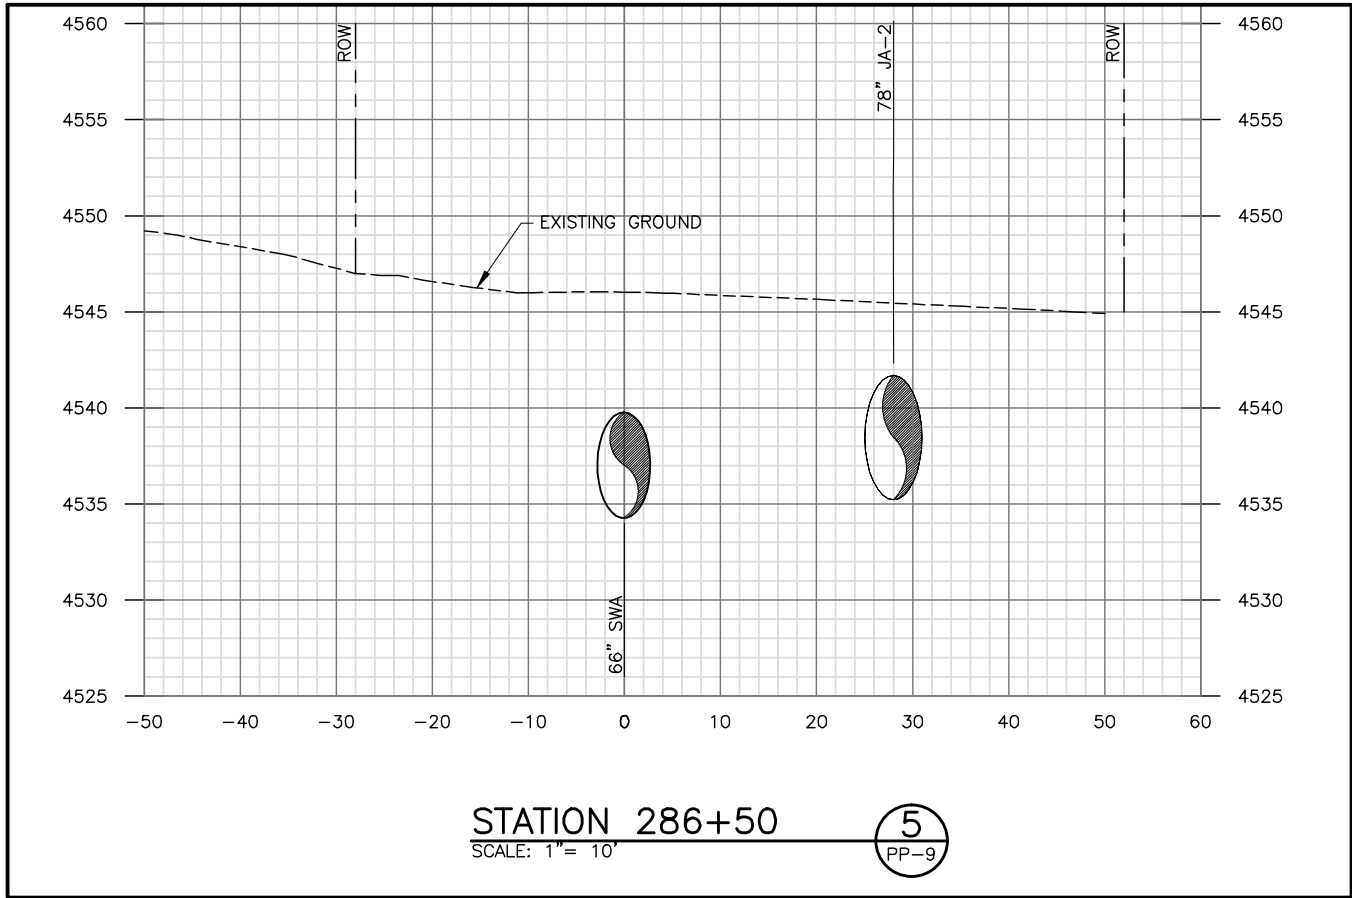

RECORD DRAWINGS
Revisions Drawn by S. Riggs Date November 2011
THESE RECORD DRAWINGS HAVE BEEN PREPARED, IN PART, ON THE BASIS OF INFORMATION COMPILED BY OTHERS. THEY ARE NOT INTENDED TO REPRESENT IN DETAIL THE EXACT LOCATION, TYPE OF COMPONENT NOR MANNER OF CONSTRUCTION. THE ENGINEER WILL NOT BE RESPONSIBLE FOR ANY ERRORS OR OMISSIONS WHICH HAVE BEEN INCORPORATED INTO THE RECORD DRAWINGS.

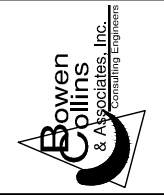

Bowen Collins & Associates, Inc.
Consulting Engineers

REVISIONS			
NO.	DATE	REV. BY	DESCRIPTION

JORDAN VALLEY WATER CONSERVANCY DISTRICT
SOUTHWEST AQUEDUCT REACH 2 PROJECT

CROSS SECTIONS - 2

CIVIL

DATE: FEBRUARY 2010 PROJECT NUMBER 010-08-03

DESIGN	REVIEW
T. OLSEN	M. COLLINS
R.D./R.G.	J. LUETTINGER

DRAWING NO. **C-6**


SHEET **28** OF **110**

NO.	DATE	REV. BY	DESCRIPTION


VERIFY SCALE
BAR IS ONE INCH ON ORIGINAL DRAWING

REVIEW
CHECKED M. COLLINS
APPROVED J. LUETTINGER


DESIGN
DESIGN T. OLSEN
DRAWN B. ABEL

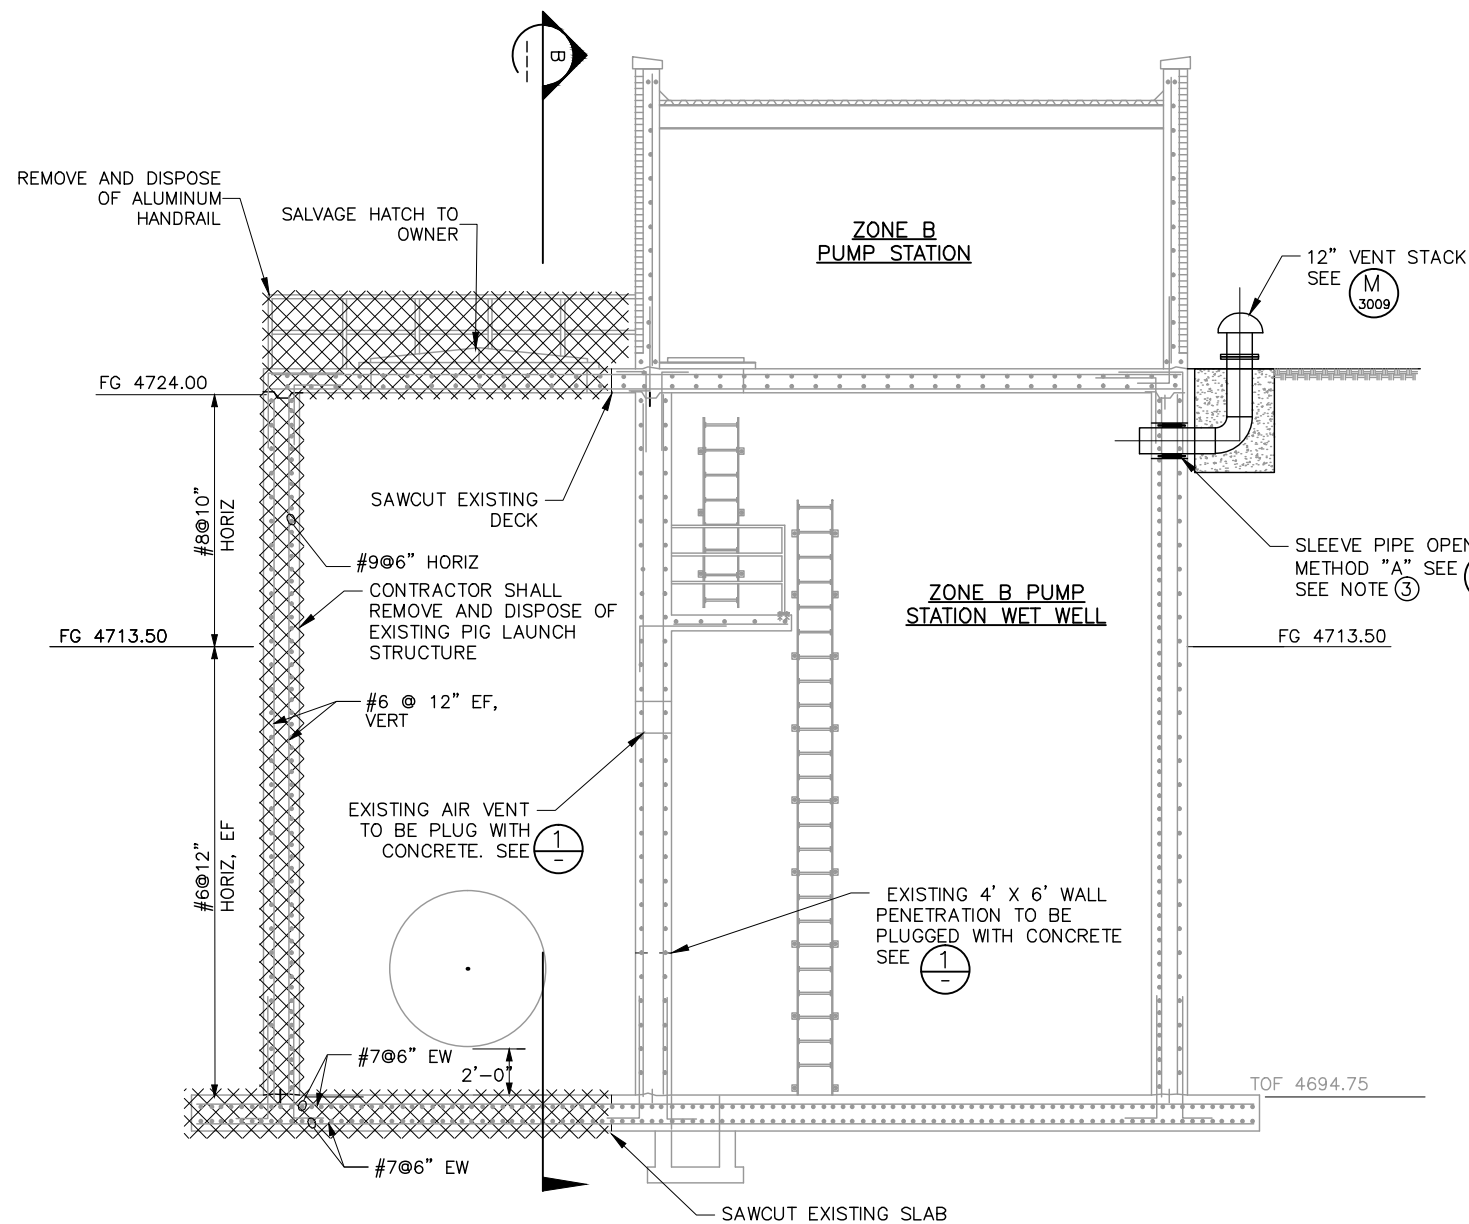


SECTION A
1/4" = 1'-0"
C-1

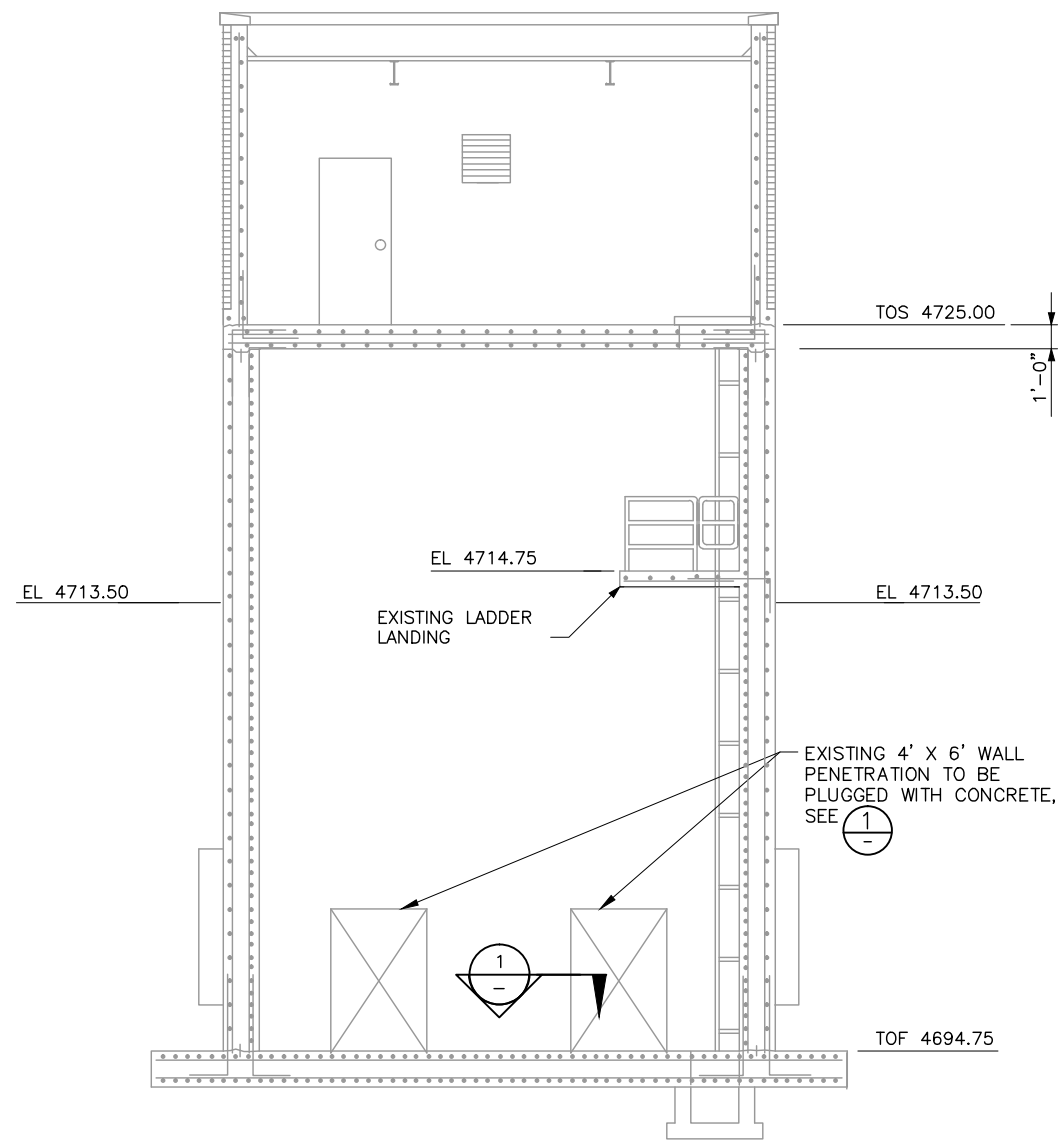

SECTION B
1/4" = 1'-0"

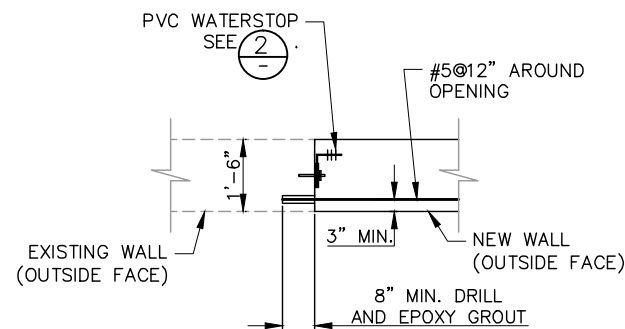

DETAIL 1
1/2" = 1'-0"
-

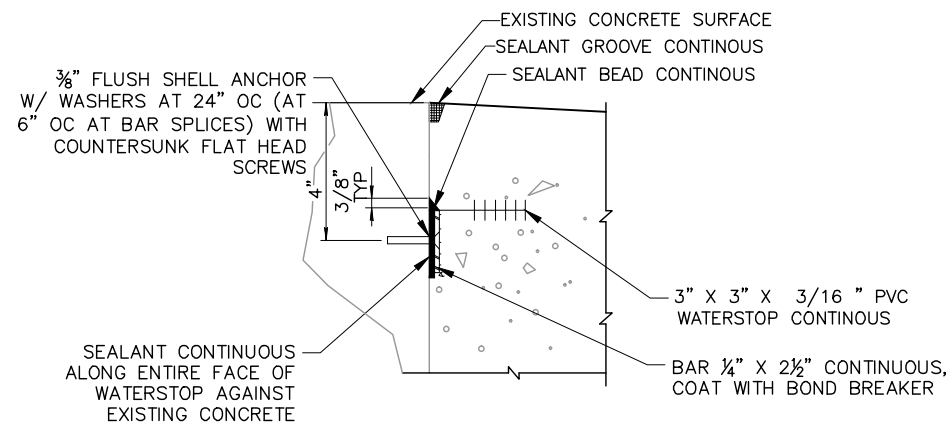

WATERSTOP AT EXISTING SURFACE 2
NO SCALE
-

NOTE:


- ELEVATIONS ON DRAWINGS REFERENCE NGVD29 VERTICAL DATUM
- CONTRACTOR SHALL DISINFECT WETWELL AFTER CONSTRUCTION IN ACCORDANCE WITH SECTION 02643.
- CONTRACTOR SHALL CORE DRILL AND CONNECT NEW 12" AIR VENT TO EXISTING ZONE B PUMP STATION. COORDINATE FINAL LOCATION OF AIR VENT WITH ENGINEER IN THE FIELD.

RECORD DRAWINGS

Revisions Drawn by S. Riggs Date November 2011
THESE RECORD DRAWINGS HAVE BEEN PREPARED, IN PART, ON THE BASIS OF INFORMATION COMPILED BY OTHERS. THEY ARE NOT INTENDED TO REPRESENT IN DETAIL THE EXACT LOCATION, TYPE OF COMPONENT NOR MANNER OF CONSTRUCTION. THE ENGINEER WILL NOT BE RESPONSIBLE FOR ANY ERRORS OR OMISSIONS WHICH HAVE BEEN INCORPORATED INTO THE RECORD DRAWINGS.




TYPE T TEST STATION 1
--

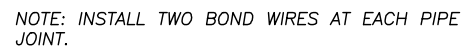

FLANGED JOINT BOND (5)



TYPE F TEST STATION 2

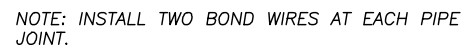

DEPEND-O-LOCK
JOINT BOND

NTS

6
--



1. TEST STATION TO BE ALUMINUM BODY AND LID WITH
THREADED CONNECTION FOR CONDUIT.
2. QUANTITY OF TERMINALS AND WIRING CONNECTIONS VARIES,
SEE APPLICABLE TEST STATION DETAILS FOR TYPE OF TEST
STATION
3. ALL MOUNTING HARDWARE TO BE TYPE 304 STAINLESS STEEL
4. PROVIDE WIRE LOOP AT BASE OF POST MOUNTED TEST
STATION TO MINIMIZE SETTLEMENT STRESSES ON WIRE

POST MOUNTED, STEEL POST



1. MAKE WIRE CONNECTION TO PIPE AT FIELD JOINT WHERE HOLDBACK OCCURS ON PIPELINE COATING.
2. MAINTAIN SEPARATION BETWEEN MULTIPLE TEST WIRE CONNECTIONS OF ONE PIPE DIA OR 24", WHICHEVER IS LESS.
3. COPPER SLEEVE REQUIRED FOR #2 AWG JOINT BONDS OR FOR #12 AWG OR SMALLER TEST WIRES.
4. WELDER AND CARTRIDGE SIZE VARIES ACCORDING TO PIPE SIZE AND PIPE MATERIAL, CONSULT WELDER MANUFACTURER FOR RECOMMENDED WELDER AND CARTRIDGE
5. COAT COMPLETED CONNECTIONS AS SHOWN AND SPECIFIED.
6. PIPELINE JOINT COATING NOT SHOWN FOR CLARITY.

STEEL AND DUCTILE IRON
PIPE WIRE CONNECTION

NTS

7
--

TEST STATIONS:

1. FOR TEST STATION LOCATIONS SEE PIPELINE PLAN AND PROFILE SHEETS.
2. TEST STATIONS SHALL BE POST MOUNTED TEST STATIONS WITH STEEL POST AND CONCRETE ENCASEMENT UNLESS OTHERWISE INDICATED.
3. TEST WIRE CONNECTIONS TO FOREIGN PIPELINES SHALL BE PERFORMED BY THE CONTRACTOR, UNLESS OWNER OF FOREIGN PIPELINE REQUIRES OTHERWISE.
4. ALL TEST LEADS LOCATED BENEATH PAVEMENT OR FUTURE ROADS SHALL BE PLACED IN PVC COATED RIGID CONDUIT FROM CL OF PIPE TO TEST STATION. INSTALL CONDUIT PERPENDICULAR TO PIPE.

ELECTRICAL CONTINUITY:

1. ALL BURIED AND VAULT JOINTS SHALL BE BONDED FOR ELECTRICAL CONTINUITY, EXCEPT WELDED OR INSULATED JOINTS.
2. PROVIDE TWO BONDS ON EACH JOINT UNLESS SHOWN OTHERWISE.
3. FLEXIBLE COUPLINGS, FLANGE COUPLING ADAPTERS, AND DEPEND-O-LOCK JOINTS SHALL BE BONDED AS SHOWN ON DETAILS. IF A SPECIFIC JOINT IS NOT SHOWN, PROVIDE BOND AS SHOWN FOR A SIMILAR JOINT STYLE SHOWN.



**Bowen
Collins
& Associates, Inc.**
Consulting Engineers

[illegible]

JORDAN VALLEY WATER CONSERVANCY DISTRICT
SOUTHWEST AQUEDUCT REACH 2 PROJECT

VERIFY SCALE
BAR IS ONE INCH ON
ORIGINAL DRAWING

REVIEW
CHECKED J. LUETTINGER

DESIGN
DESIGN T. OLSEN

CIVIL	
CATHODIC PROTECTION DETAILS	
FEBRUARY 2010	PROJECT NUMBER 010-08-03



DRAWING NO. C-8


SHEET 30 OF 110

RECORD DRAWINGS

Revisions Drawn by S. Riggs Date November 2011

THESE RECORD DRAWINGS HAVE BEEN PREPARED, IN PART, ON THE BASIS OF INFORMATION COMPILED BY OTHERS. THEY ARE NOT INTENDED TO REPRESENT IN DETAIL THE EXACT LOCATION, TYPE OF COMPONENT NOR MANNER OF CONSTRUCTION. THE ENGINEER WILL NOT BE RESPONSIBLE FOR ANY ERRORS OR OMISSIONS WHICH HAVE BEEN INCORPORATED INTO THE RECORD DRAWINGS.

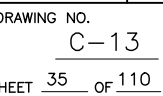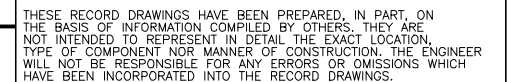

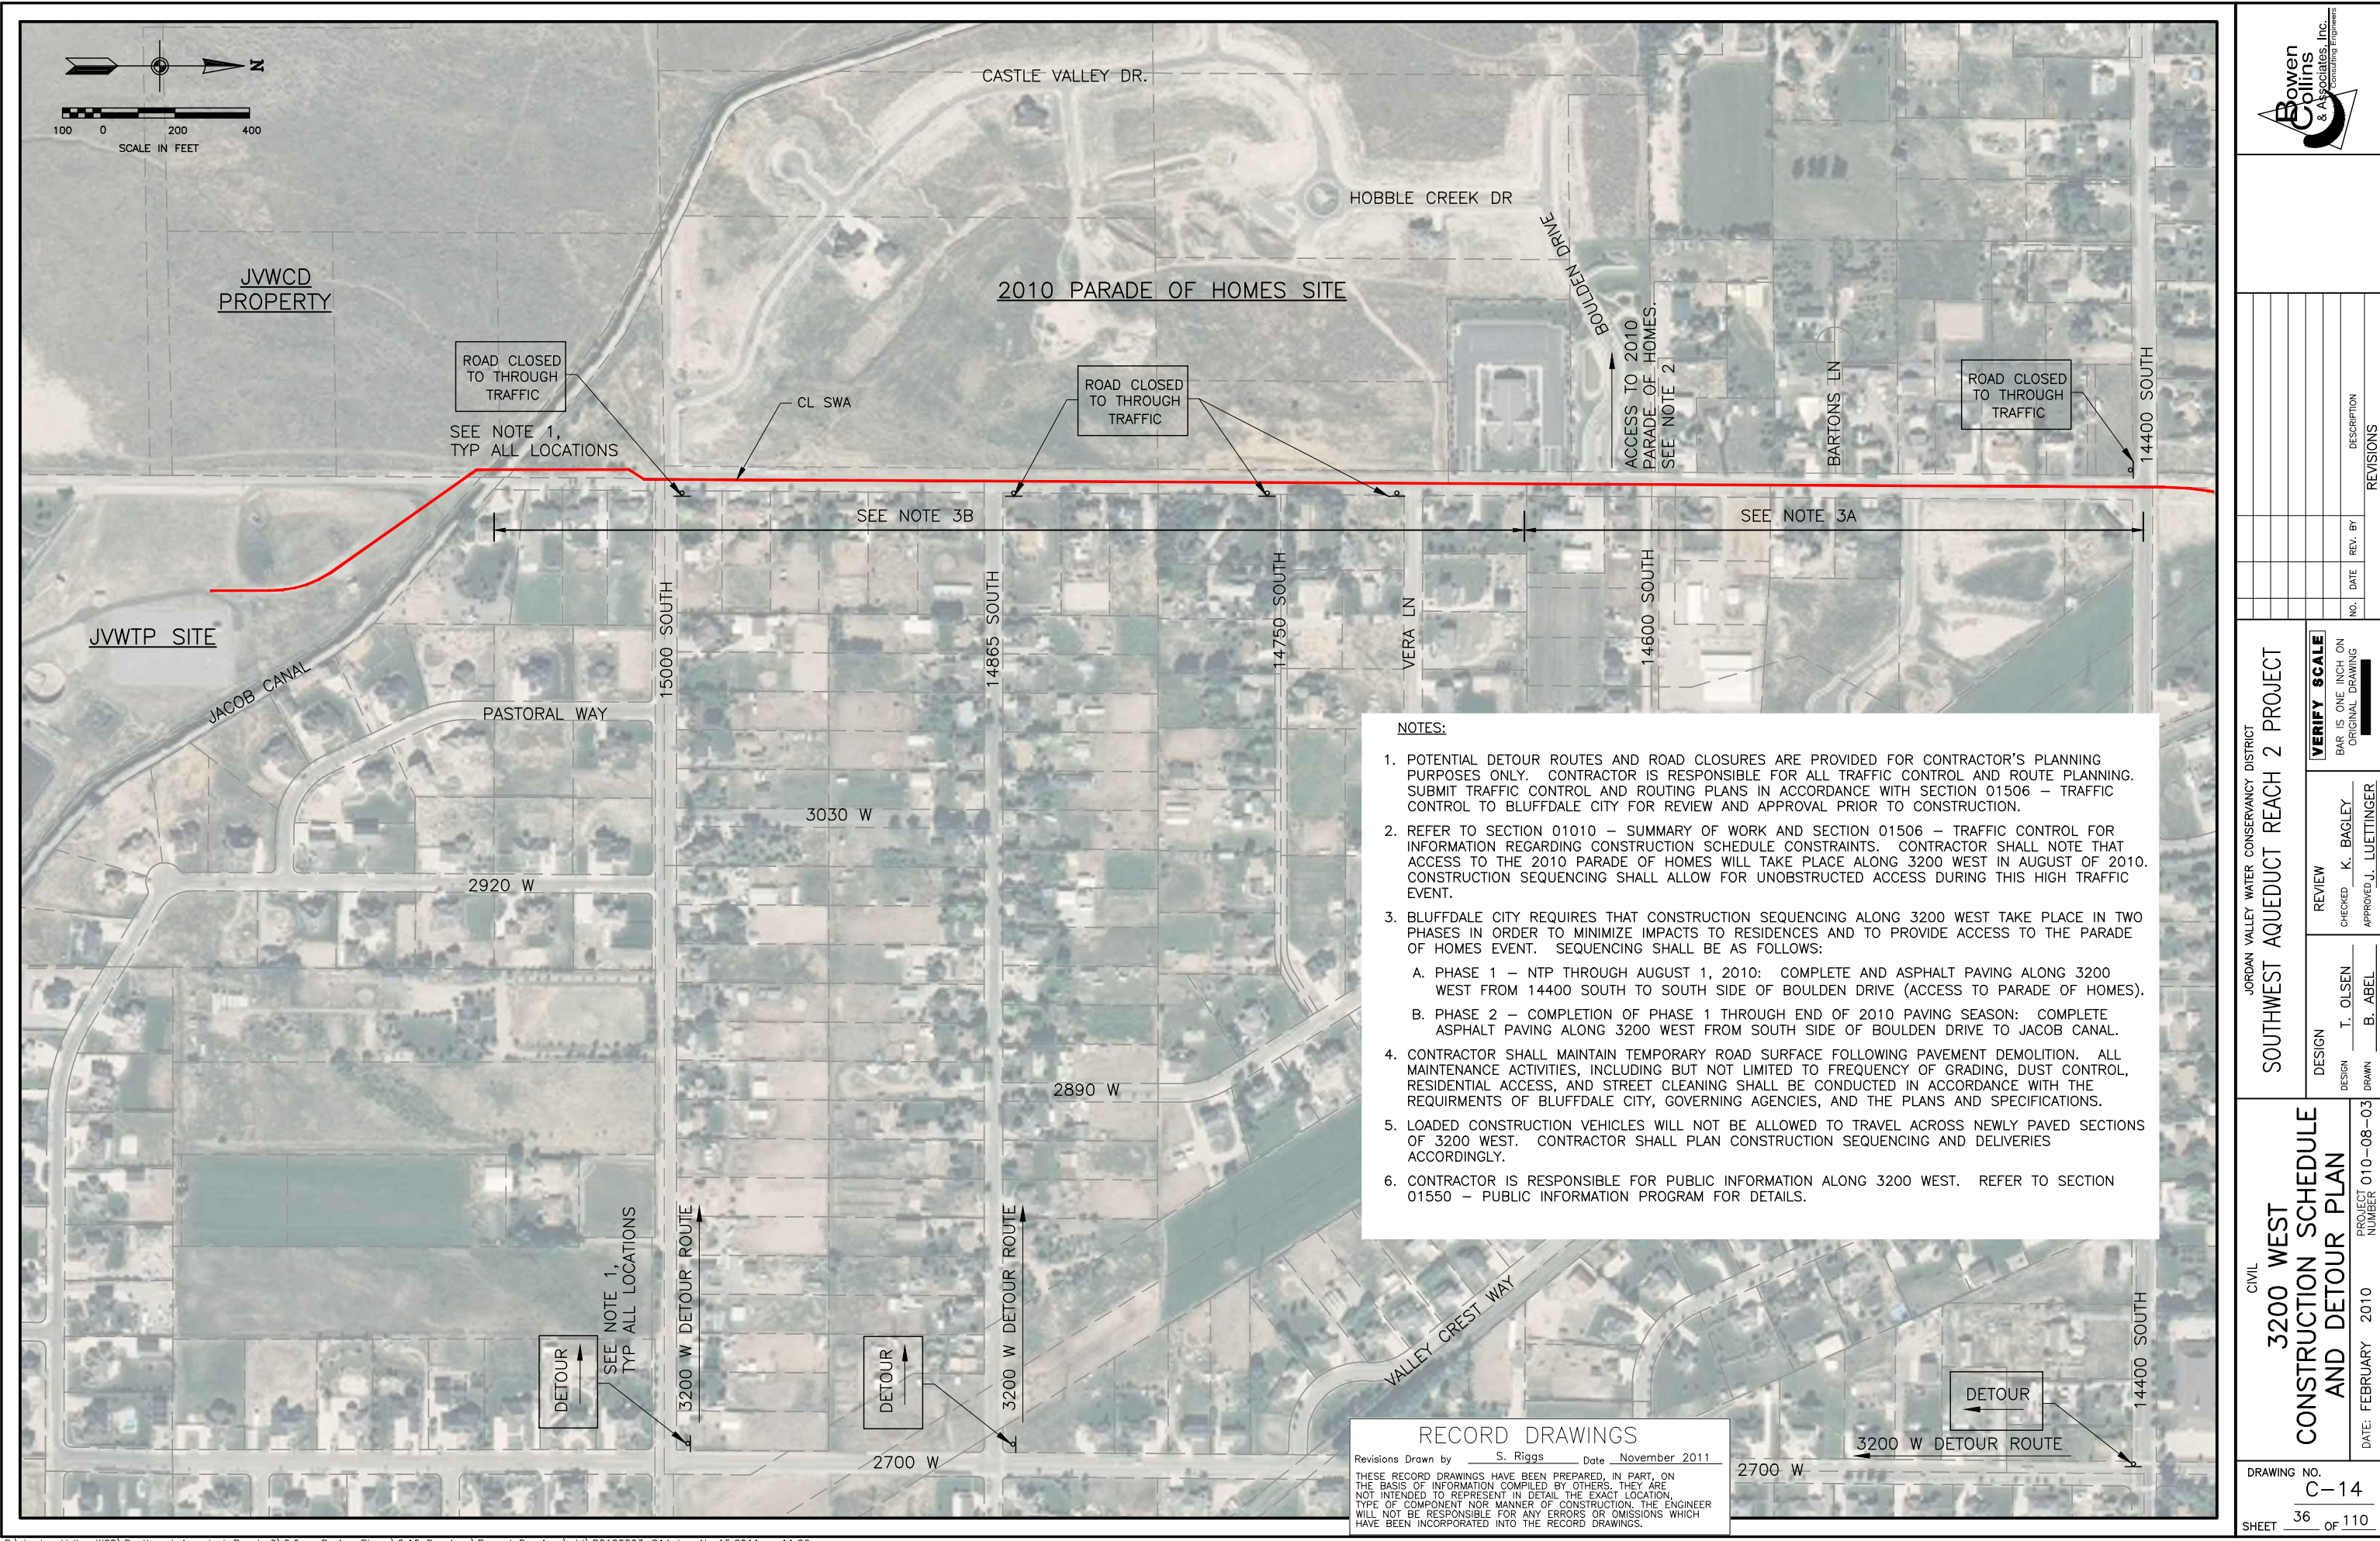

- NOTES:**
- POTENTIAL DETOUR ROUTES AND ROAD CLOSURES ARE PROVIDED FOR CONTRACTOR'S PLANNING PURPOSES ONLY. CONTRACTOR IS RESPONSIBLE FOR ALL TRAFFIC CONTROL AND ROUTE PLANNING. SUBMIT TRAFFIC CONTROL AND ROUTING PLANS IN ACCORDANCE WITH SECTION 01506 – TRAFFIC CONTROL TO BLUFFDALE CITY FOR REVIEW AND APPROVAL PRIOR TO CONSTRUCTION.
 - REFER TO SECTION 01010 – SUMMARY OF WORK AND SECTION 01506 – TRAFFIC CONTROL FOR INFORMATION REGARDING CONSTRUCTION SCHEDULE CONSTRAINTS. CONTRACTOR SHALL NOTE THAT ACCESS TO THE 2010 PARADE OF HOMES WILL TAKE PLACE ALONG 3200 WEST IN AUGUST OF 2010. CONSTRUCTION SEQUENCING SHALL ALLOW FOR UNOBSTRUCTED ACCESS DURING THIS HIGH TRAFFIC EVENT.
 - BLUFFDALE CITY REQUIRES THAT CONSTRUCTION SEQUENCING ALONG 3200 WEST TAKE PLACE IN TWO PHASES IN ORDER TO MINIMIZE IMPACTS TO RESIDENCES AND TO PROVIDE ACCESS TO THE PARADE OF HOMES EVENT. SEQUENCING SHALL BE AS FOLLOWS:
 - PHASE 1 – NTP THROUGH AUGUST 1, 2010: COMPLETE AND ASPHALT PAVING ALONG 3200 WEST FROM 14400 SOUTH TO SOUTH SIDE OF BOULDEN DRIVE (ACCESS TO PARADE OF HOMES).
 - PHASE 2 – COMPLETION OF PHASE 1 THROUGH END OF 2010 PAVING SEASON: COMPLETE ASPHALT PAVING ALONG 3200 WEST FROM SOUTH SIDE OF BOULDEN DRIVE TO JACOB CANAL.
 - CONTRACTOR SHALL MAINTAIN TEMPORARY ROAD SURFACE FOLLOWING PAVEMENT DEMOLITION. ALL MAINTENANCE ACTIVITIES, INCLUDING BUT NOT LIMITED TO FREQUENCY OF GRADING, DUST CONTROL, RESIDENTIAL ACCESS, AND STREET CLEANING SHALL BE CONDUCTED IN ACCORDANCE WITH THE REQUIREMENTS OF BLUFFDALE CITY, GOVERNING AGENCIES, AND THE PLANS AND SPECIFICATIONS.
 - LOADED CONSTRUCTION VEHICLES WILL NOT BE ALLOWED TO TRAVEL ACROSS NEWLY PAVED SECTIONS OF 3200 WEST. CONTRACTOR SHALL PLAN CONSTRUCTION SEQUENCING AND DELIVERIES ACCORDINGLY.
 - CONTRACTOR IS RESPONSIBLE FOR PUBLIC INFORMATION ALONG 3200 WEST. REFER TO SECTION 01550 – PUBLIC INFORMATION PROGRAM FOR DETAILS.

RECORD DRAWINGS

Revisions Drawn by S. Riggs Date November 2011

THESE RECORD DRAWINGS HAVE BEEN PREPARED, IN PART, ON THE BASIS OF INFORMATION COMPILED BY OTHERS. THEY ARE NOT INTENDED TO REPRESENT IN DETAIL THE EXACT LOCATION, TYPE OF COMPONENT NOR MANNER OF CONSTRUCTION. THE ENGINEER WILL NOT BE RESPONSIBLE FOR ANY ERRORS OR OMISSIONS WHICH HAVE BEEN INCORPORATED INTO THE RECORD DRAWINGS.



Bowen Collins & Associates, Inc.
Consulting Engineers

NO.	DATE	REV. BY	DESCRIPTION	REVISIONS

JORDAN VALLEY WATER CONSERVANCY DISTRICT

SOUTHWEST AQUEDUCT REACH 2 PROJECT

VERIFY SCALE
BAR IS ONE INCH ON ORIGINAL DRAWING

DESIGN	REVIEW
DESIGN: T. OLSEN	CHECKED: K. BAGLEY
DRAWN: B. ABEL	APPROVED: J. LUETTINGER

CIVIL

3200 WEST

CONSTRUCTION SCHEDULE AND DETOUR PLAN


DATE: FEBRUARY 2010 PROJECT NUMBER 010-08-03

DRAWING NO. **C-14**

SHEET **36** OF **110**

1. COORDINATE ALL CONSTRUCTION ACTIVITIES IMPACTING PRIVATE RESIDENCES WITH PROPERTY OWNERS IN ACCORDANCE WITH SECTION 01550 – PUBLIC INFORMATION PROGRAM.
2. PERFORM SITE CONDITION SURVEY, INCLUDING PRECONSTRUCTION PHOTOGRAPHIC AND VIDEO DOCUMENTATION OF ALL PRIVATE IMPROVEMENTS, PRIOR TO CONSTRUCTION IN ACCORDANCE WITH SECTION 01335 – SITE CONDITIONS SURVEY. SUBMIT TO ENGINEER FOR REVIEW AND APPROVAL.
3. CONTRACTOR SHALL MAINTAIN A NEAT CONSTRUCTION AREA WITHIN PRIVATE PROPERTIES. CLEAN UP AND ORGANIZE SITE AND REMOVE POTENTIALLY DANGEROUS ITEMS FROM PRIVATE PROPERTIES DAILY FOLLOWING CONSTRUCTION.
4. CONTRACTOR IS RESPONSIBLE FOR RESTORING ALL PRIVATE IMPROVEMENTS THAT ARE REMOVED OR DAMAGED DURING CONSTRUCTION TO EQUAL OR BETTER CONDITION. NOT ALL MINOR RESIDENTIAL IMPROVEMENTS ARE SHOWN ON THE PLANS.
5. RESTORE ALL IMPACTED RESIDENTIAL LAWNS WITH HIGH QUALITY SOD FOLLOWING CONSTRUCTION AND RE-GRADING OF YARDS. PROVIDE 4-INCHES MINIMUM TOP SOIL BENEATH ALL NEWLY SODDED AREAS.
6. UNLESS OTHERWISE NOTED ON PLANS, PROVIDE HIGH QUALITY SOD IN NEW PARKSTRIP BETWEEN SIDEWALK AND TBC.
7. AN ALLOWANCE HAS BEEN PROVIDED IN THE BID SCHEDULE FOR SPRINKLER SYSTEM IMPROVEMENTS ON EACH PRIVATE PROPERTY. CONTRACTOR SHALL PROVIDE A QUALIFIED SPRINKLER SYSTEM INSTALLER TO COORDINATE REMOVAL AND REPLACEMENT OF SPRINKLER SYSTEMS WITH EACH PROPERTY OWNER AS REQUIRED FOR CONSTRUCTION.

8. TEMPORARILY CAP SPRINKLER LINES IN ZONES IMPACTED BY CONSTRUCTION TO ALLOW IRRIGATION OF UNIMPACTED AREAS OF PROPERTY DURING CONSTRUCTION. REPLACE SPRINKLER SYSTEMS TO EQUAL OR BETTER CONDITION FOLLOWING CONSTRUCTION.
9. CONTRACTOR SHALL PROVIDE NEW SPRINKLER SYSTEMS WITHIN NEW 6-FOOT WIDE GRASS PARKSTRIP WHERE REQUIRED. CONTRACTOR'S SPRINKLER SYSTEM INSTALLER SHALL COORDINATE EXPANSION OF EXISTING RESIDENTIAL SPRINKLER SYSTEMS TO ACCOMMODATE ALL NEWLY SODDED PARKSTRIP AREAS. SPRINKLER CONTRACTOR SHALL ALSO PLACE (2) SLEEVES UNDER CONCRETE SIDEWALK FOR CONNECTION TO PROPERTY OWNERS IRRIGATION SYSTEMS.
10. NEATLY SAW CUT RESIDENTIAL DRIVEWAYS TO NEAREST CONSTRUCTION JOINT WHERE COMPLETE REMOVAL OF DRIVEWAY IS NOT REQUIRED. REPLACE DRIVEWAYS AND APPROACHES TO EQUAL OR BETTER CONDITION IN ACCORDANCE WITH BLUFFDALE CITY STANDARDS.
11. CONTRACTOR IS NOT RESPONSIBLE FOR REPLACEMENT OF TREES AND PLANTERS THAT ARE LOCATED WITHIN THE AREAS PROVIDED FOR THE NEW PARKSTRIP AND SIDEWALK. BLUFFDALE CITY WILL ADDRESS THIS ITEMS UNDER SEPARATE AGREEMENTS FOR THESE IMPROVEMENTS THAT ARE TO BE PERMANENTLY REMOVED.
12. CONTRACTOR'S PUBLIC INFORMATION MANAGER TO PROVIDE MINIMUM 14 DAYS NOTICE PRIOR TO REMOVAL OF TREES, LANDSCAPING AND OTHER IMPROVEMENTS TO ALLOW TIME FOR SALVAGE BY PRIVATE PROPERTY OWNER IF DESIRED. ITEMS WHICH ARE NOT SALVAGED BY OWNER SHALL BE REMOVED AND DISPOSED OF BY CONTRACTOR AS REQUIRED FOR CONSTRUCTION.

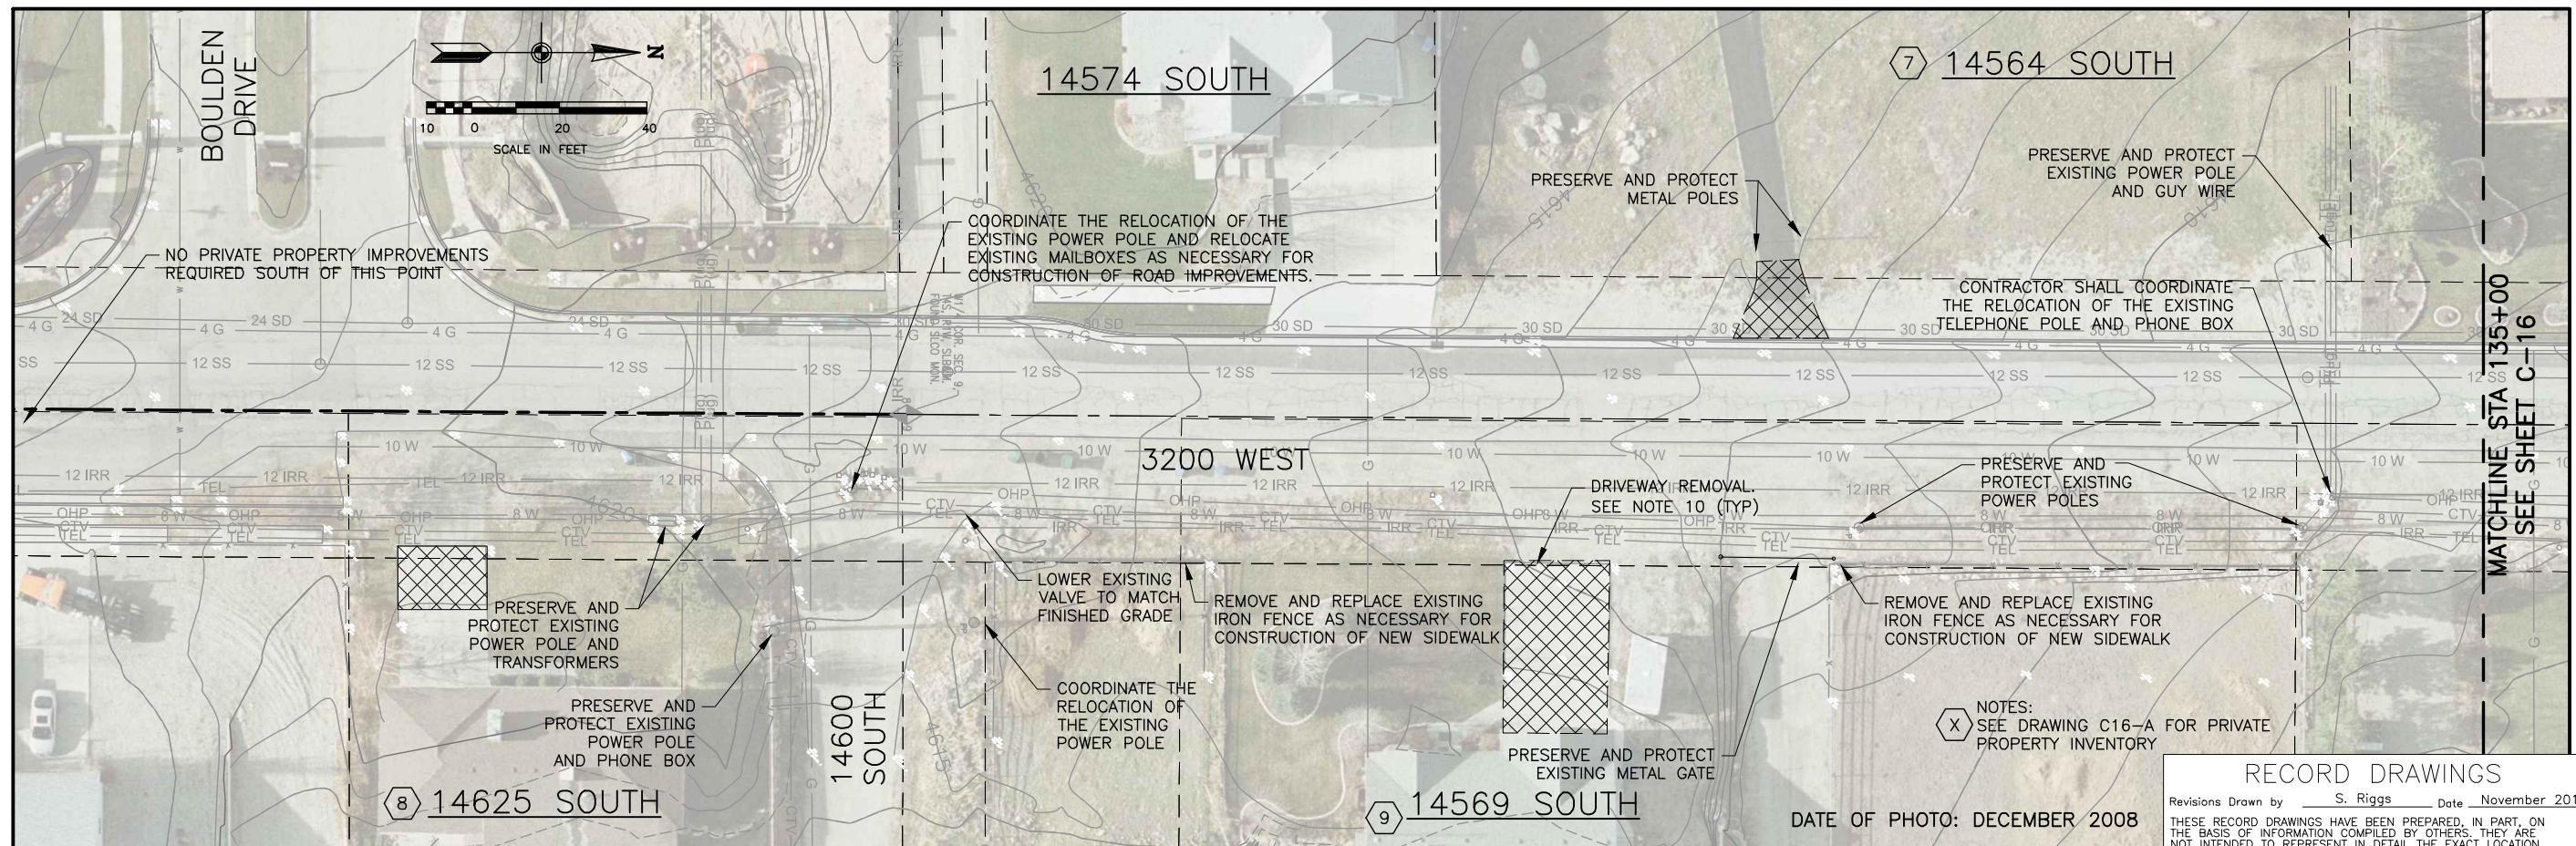

REVISIONS					
NO.	DATE	REV. BY	DESCRIPTION		

SOUTHWEST AQUEDUCT REACH 2 PROJECT

BAR IS ONE INCH ON
ORIGINAL DRAWING

REVIEW

CHECKED K. BAGLEY



APPROVED J. LUETTINGER

IGN	<u>T. OLSEN</u>
OWN	<u>B. ABEL</u>

3200 WEST
PRIVATE IMPROVEMENTS
AND DEMOLITION PLAN-1

NUMBER	DATE	DESCRIPTION	AMOUNT
100	1/1/20	Initial deposit	100.00
101	1/15/20	Withdrawal	25.00
102	2/1/20	Deposit	50.00
103	2/15/20	Withdrawal	10.00
104	3/1/20	Deposit	75.00
105	3/15/20	Withdrawal	30.00
106	4/1/20	Deposit	120.00
107	4/15/20	Withdrawal	40.00
108	5/1/20	Deposit	90.00
109	5/15/20	Withdrawal	15.00
110	6/1/20	Deposit	110.00
111	6/15/20	Withdrawal	20.00
112	7/1/20	Deposit	130.00
113	7/15/20	Withdrawal	35.00
114	8/1/20	Deposit	150.00
115	8/15/20	Withdrawal	45.00
116	9/1/20	Deposit	170.00
117	9/15/20	Withdrawal	50.00
118	10/1/20	Deposit	190.00
119	10/15/20	Withdrawal	55.00
120	11/1/20	Deposit	210.00
121	11/15/20	Withdrawal	60.00
122	12/1/20	Deposit	230.00
123	12/15/20	Withdrawal	65.00
124	1/1/21	Deposit	250.00
125	1/15/21	Withdrawal	70.00
126	2/1/21	Deposit	270.00
127	2/15/21	Withdrawal	75.00
128	3/1/21	Deposit	290.00
129	3/15/21	Withdrawal	80.00
130	4/1/21	Deposit	310.00
131	4/15/21	Withdrawal	85.00
132	5/1/21	Deposit	330.00
133	5/15/21	Withdrawal	90.00
134	6/1/21	Deposit	350.00
135	6/15/21	Withdrawal	95.00
136	7/1/21	Deposit	370.00
137	7/15/21	Withdrawal	100.00
138	8/1/21	Deposit	390.00
139	8/15/21	Withdrawal	105.00
140	9/1/21	Deposit	410.00
141	9/15/21	Withdrawal	110.00
142	10/1/21	Deposit	430.00
143	10/15/21	Withdrawal	115.00
144	11/1/21	Deposit	450.00
145	11/15/21	Withdrawal	120.00
146	12/1/21	Deposit	470.00
147	12/15/21	Withdrawal	125.00
148	1/1/22	Deposit	490.00
149	1/15/22	Withdrawal	130.00
150	2/1/22	Deposit	510.00
151	2/15/22	Withdrawal	135.00
152	3/1/22	Deposit	530.00
153	3/15/22	Withdrawal	140.00
154	4/1/22	Deposit	550.00
155	4/15/22	Withdrawal	145.00
156	5/1/22	Deposit	570.00
157	5/15/22	Withdrawal	150.00
158	6/1/22	Deposit	590.00
159	6/15/22	Withdrawal	155.00
160	7/1/22	Deposit	610.00
161	7/15/22	Withdrawal	160.00
162	8/1/22	Deposit	630.00
163	8/15/22	Withdrawal	165.00
164	9/1/22	Deposit	650.00
165	9/15/22	Withdrawal	170.00
166	10/1/22	Deposit	670.00
167	10/15/22	Withdrawal	175.00
168	11/1/22	Deposit	690.00
169	11/15/22	Withdrawal	180.00
170	12/1/22	Deposit	710.00
171	12/15/22	Withdrawal	185.00
172	1/1/23	Deposit	730.00
173	1/15/23	Withdrawal	190.00
174	2/1/23	Deposit	750.00
175	2/15/23	Withdrawal	195.00
176	3/1/23	Deposit	770.00
177	3/15/23	Withdrawal	200.00
178	4/1/23	Deposit	790.00
179	4/15/23	Withdrawal	205.00
180	5/1/23	Deposit	810.00
181	5/15/23	Withdrawal	210.00
182	6/1/23	Deposit	830.00
183	6/15/23	Withdrawal	215.00
184			

DRAWING NO. C-15
SHEET 37 OF 110

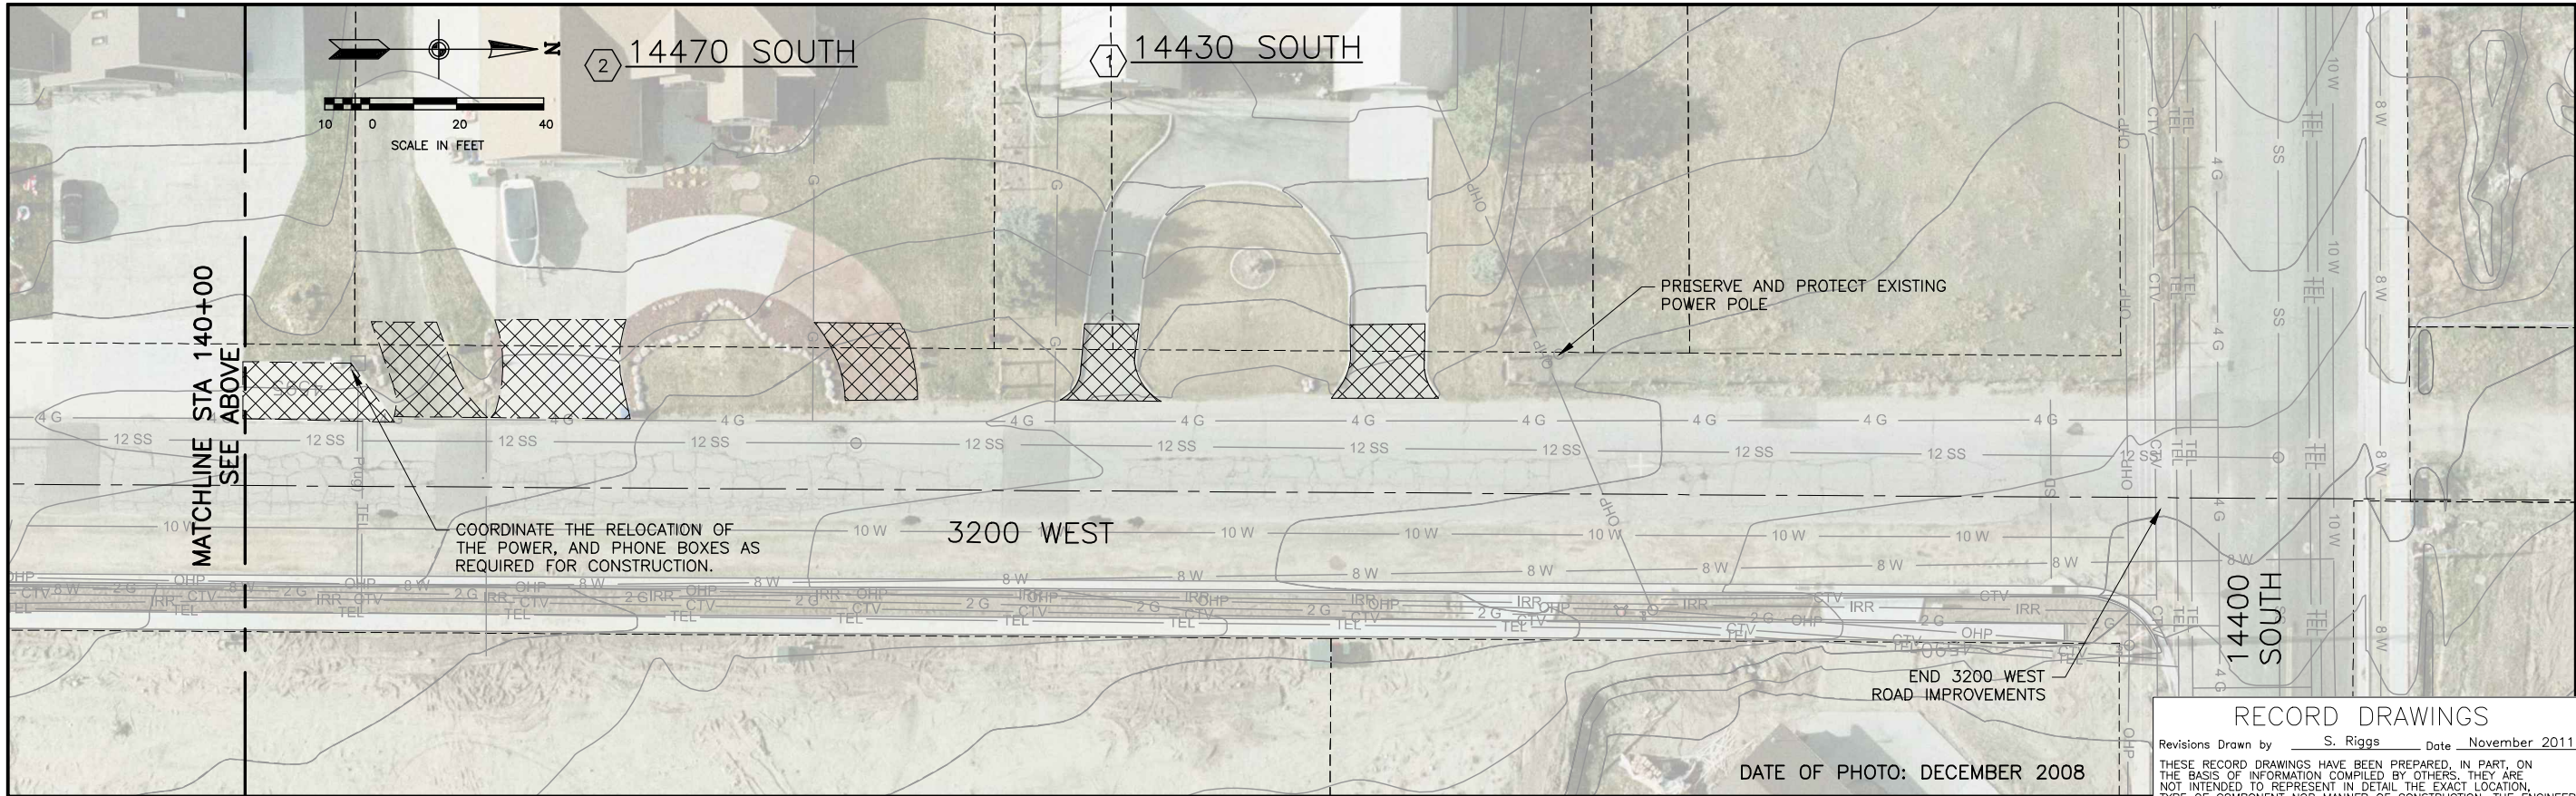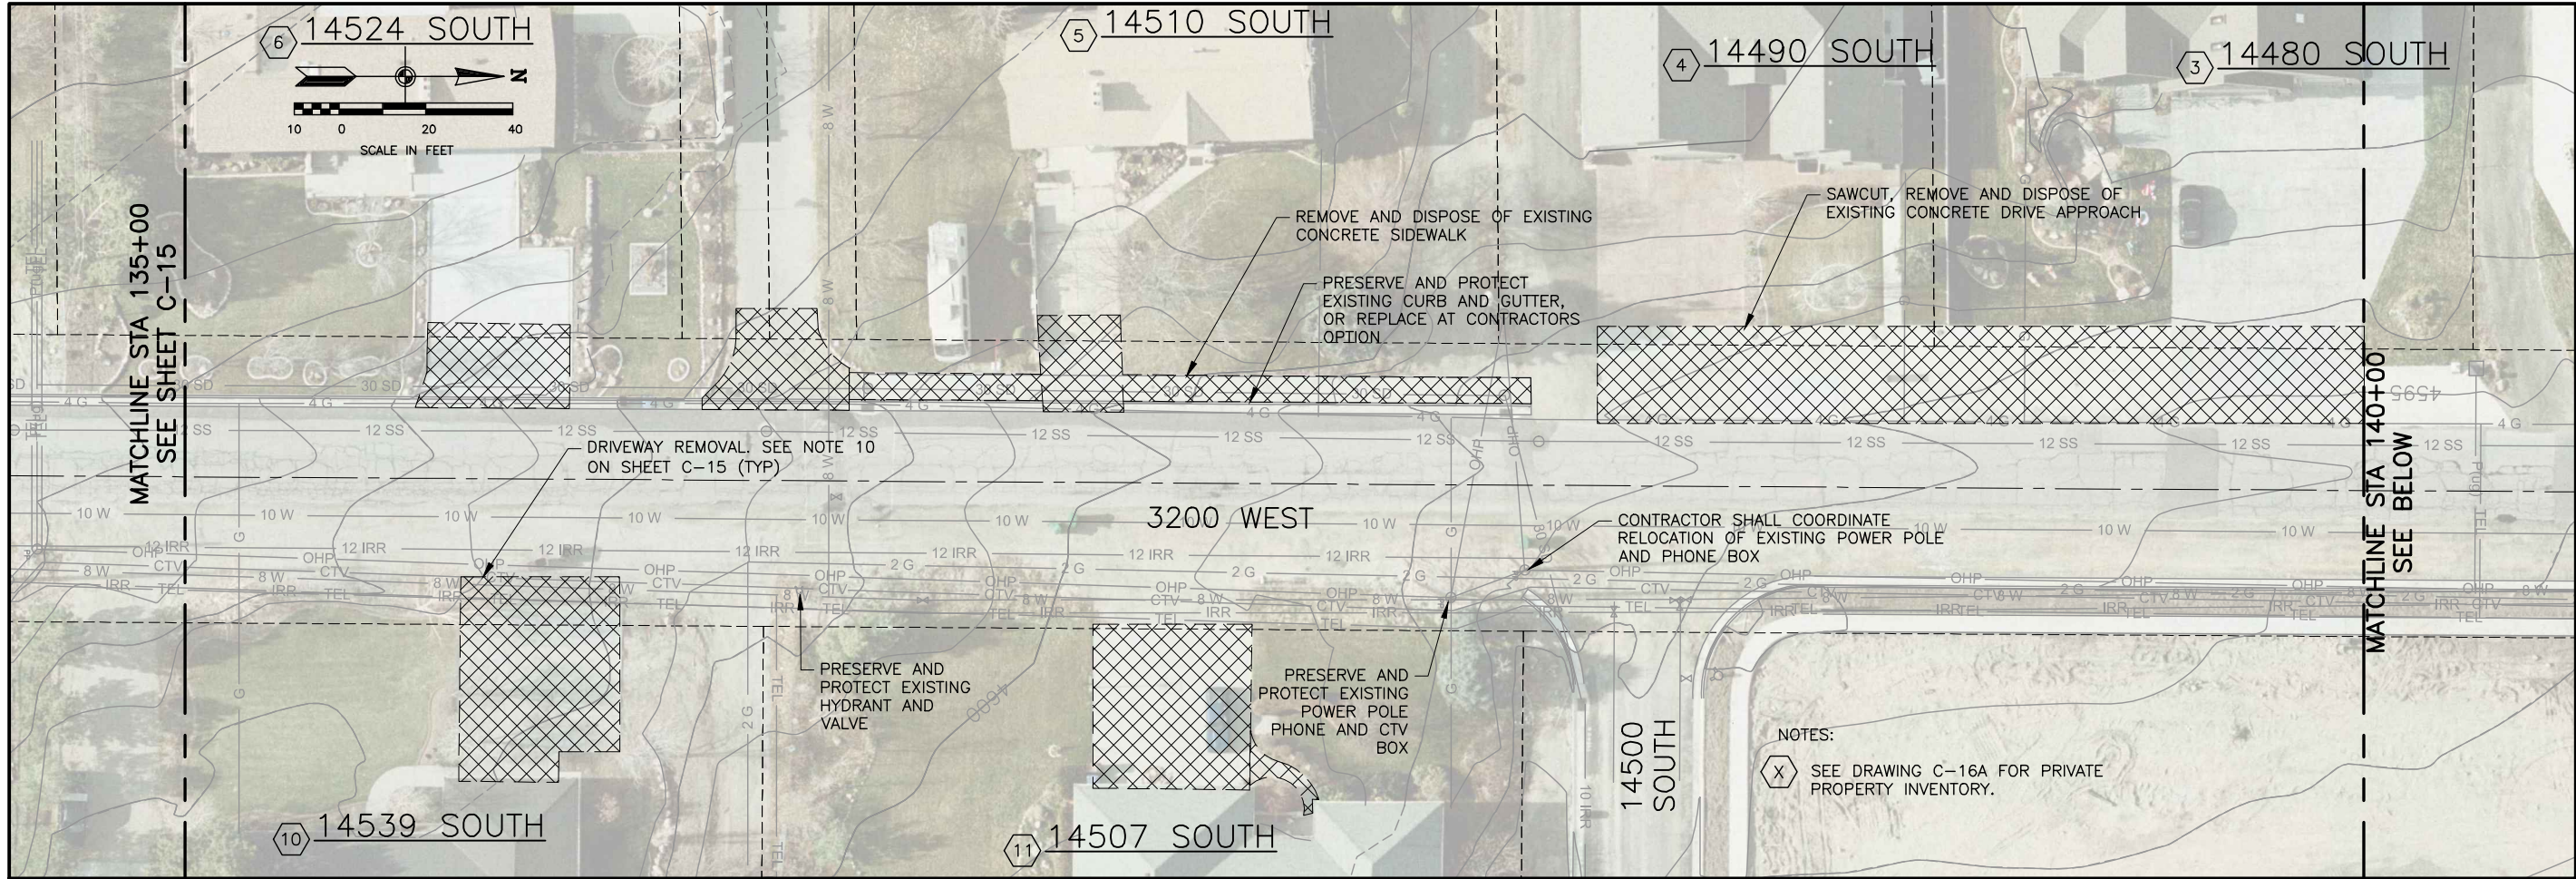


RECORD DRAWINGS

Revisions Drawn by S. Riggs Date November 2011



THESE RECORD DRAWINGS HAVE BEEN PREPARED, IN PART, ON THE BASIS OF INFORMATION COMPILED BY OTHERS. THEY ARE NOT INTENDED TO REPRESENT IN DETAIL THE EXACT LOCATION, TYPE OF COMPONENT NOR MANNER OF CONSTRUCTION. THE ENGINEER WILL NOT BE RESPONSIBLE FOR ANY ERRORS OR OMISSIONS WHICH HAVE BEEN INCORPORATED INTO THE RECORD DRAWINGS.

DRAWING NO.	C-16	
	SHEET	38 OF 110
DATE: FEBRUARY 2010		PROJECT NUMBER 010-08-03
3200 WEST PRIVATE IMPROVEMENTS AND DEMOLITION PLAN-2		
DESIGN T. OLSEN		REVIEW K. BAGLEY
DRAWN B. ABEL		APPROVED J. LUETTINGER
JORDAN VALLEY WATER CONSERVANCY DISTRICT		SOUTHWEST AQUEDUCT REACH 2 PROJECT
		VERIFY SCALE BAR IS ONE INCH ON ORIGINAL DRAWING
		NO. DATE REV. BY DESCRIPTION
		REVISIONS

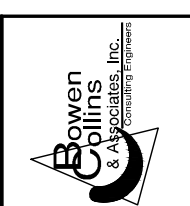

SCHEDULE OF PRIVATE IMPROVEMENTS, LOTS 1 THROUGH 6						
LOT NO.	ADDRESS	ITEM	REPLACE OR DISPOSE (1, 2)	NOTES		
1	14430 SOUTH	IRRIGATION BOX	REPLACE	REPLACE SPRINKLER BOX AS NOTED IN THE GENERAL NOTES FOR RESIDENTAIL IMPROVEMENTS ON DWG. C-15.		
		CONCRETE CURBING	REPLACE	2 LOCATIONS ALONG DRIVEWAY. SAWCUT, REMOVE AND DISPOSE OF EXISTING CURBING. RECONSTRUCT NEW CURBING ADJACENT TO DRIVEWAYS AS SHOWN ON DWG. C-25.		
		WIRE FENCE	REPLACE	NORTH SIDE OF PROPERTY. NEW FENCE SHALL BE INSTALLED PRIOR TO REMOVAL OF EXISTING FENCE AND CONSTRUCTION OF SIDEWALK AND CURB & GUTTER.		
		RAILROAD TIE & WIRE FENCE	REPLACE	SOUTH SIDE OF PROPERTY. REMOVE AND REPLACE EXISTING FENCE AS REQUIRED FOR CONSTRUCTION. COORDINATE WITH PROPERTY OWNER PRIOR TO REMOVAL		
		LANDSCAPING/SPRINKLERS	REPLACE	REPLACE LANDSCAPING/SPRINKLERS AS NOTED IN THE GENERAL NOTES FOR RESIDENTAIL IMPROVEMENTS ON DWG. C-15.		
		WATER METER	REPLACE	RELOCATE WATER WATER AS REQUIRED FOR CONSTRUCTION. RAISE METER TO MATCH FINAL GRADE.		
		MAILBOX	REPLACE	RELOCATE EXISTING MAILBOX AS NECESSARY FOR CONSTRUCTION. LARGE ROCKS AROUND EXISTING MAILBOX WILL NEED TO BE REPLACED AFTER RELOCATION.		
2	14470 SOUTH	ROCK PLANTER	DISPOSE	REMOVE AND DISPOSE OF EXISTING ROCK PLANTERS ADJACENT TO DRIVEWAY AS REQUIRED FOR CONSTRUCTION. COORDINATE WITH PROPERTY OWNER PRIOR TO REMOVAL		
		LANDSCAPING/SPRINKLERS	REPLACE	REPLACE LANDSCAPING/SPRINKLER AS NOTED IN THE GENERAL NOTES FOR RESIDENTAIL IMPROVEMENTS ON DWG. C-15.		
		MAILBOX	REPLACE	RELOCATE EXISTING MAILBOX AS NECESSARY FOR CONSTRUCTION.		
		WATER METER	REPLACE	RELOCATE WATER METER AS REQUIRED FOR CONSTRUCTION. RAISE METER TO MATCH FINAL GRADE.		
3	14480 SOUTH	MAILBOX	REPLACE	RELOCATE EXISTING MAILBOX AS NECESSARY FOR CONSTRUCTION.		
		WATER METER	REPLACE	RELOCATE WATER METER AS REQUIRED FOR CONSTRUCTION. RAISE METER TO MATCH FINAL GRADE.		
		CONCRETE APRON	REPLACE	SAWCUT, REMOVE AND DISPOSE OF EXISTING CONCRETE APRON. REPLACE CONCRETE APRON WITH SOD.		
4	14490 SOUTH	MAILBOX	REPLACE	RELOCATE EXISTING MAILBOX AS NECESSARY FOR CONSTRUCTION.		
		CONCRETE APRON	DISPOSE	SAWCUT, REMOVE AND DISPOSE OF EXISTING CONCRETE APRON. REPLACE CONCRETE APRON WITH SOD.		
		WATER METER	REPLACE	RELOCATE WATER METER AS REQUIRED FOR CONSTRUCTION. RAISE METER TO MATCH FINAL GRADE.		
5	14510 SOUTH	BLOCK WALL	DISPOSE	REMOVE AND DISPOSE OF EXISTING BLOCK WALL. COORDINATE WITH PROPERTY OWNER PRIOR TO REMOVAL.		
		LARGE ROCKS	DISPOSE	REMOVE AND DISPOSE OF LARGE ROCKS AS REQUIRED FOR CONSTRUCTION.		
		TREE	DISPOSE	REMOVE AND DISPOSE OF TREE AS REQUIRED FOR CONSTRUCTION.		
		BUSHES	DISPOSE	REMOVE AND DISPOSE OF BUSHES AS REQUIRED FOR CONSTRUCTION.		
		BRICK FENCE	REPLACE	SOUTH SIDE OF DRIVEWAY. REMOVE AND REPLACE EXISTING FENCE AS REQUIRED FOR CONSTRUCTION. COORDINATE WITH PROPERTY OWNER PRIOR TO REMOVAL		
		CONCRETE SIDEWALK	REPLACE	REMOVE AND DISPOSE OF EXISTING CONCRETE SIDEWALK AS REQUIRED FOR CONSTRUCTION.		
		LANDSCAPING/SPRINKLERS	REPLACE	REPLACE LANDSCAPING/SPRINKLERS AS NOTED IN THE GENERAL NOTES FOR RESIDENTAIL IMPROVEMENTS ON DWG. C-15.		
		MAILBOX	REPLACE	RELOCATE EXISTING MAILBOX AS NECESSARY FOR CONSTRUCTION.		
		TREE	DISPOSE	REMOVE AND DISPOSE OF TREE AS REQUIRED FOR CONSTRUCTION.		
		IRRIGATION BOX	REPLACE	REPLACE IRRIGATION BOX AS NOTED IN THE GENERAL NOTES FOR RESIDENTAIL IMPROVEMENTS ON DWG. C-15.		
		ROCK LANDSCAPING	DISPOSE	2 LOCATIONS. REMOVE AND DISPOSE OF EXISTING ROCK LANDSCAPING. COORDINATE WITH PROPERTY OWNERS PRIOR TO REMOVAL.		
		MAILBOX	REPLACE	RELOCATE EXISTING MAILBOX AS NECESSARY FOR CONSTRUCTION.		
		6	14524 SOUTH	LANDSCAPING PLANTERS	DISPOSE	7 LOCATIONS. REMOVE AND DISPOSE OF EXISTING LANDSCAPING PLANTERS. COORDINATE WITH PROPERTY OWNERS PRIOR TO REMOVAL
				CONCRETE CURBING	REPLACE	SAWCUT, REMOVE AND DISPOSE OF EXISTING CURBING. RECONSTRUCT NEW CURBING AS ADJACENT TO DRIVEWAYS AS SHOWN ON DWG. C-24.
				LANDSCAPING/SPRINKLERS	REPLACE	REPLACE LANDSCAPING/SPRINKLERS AS NOTED IN THE GENERAL NOTES FOR RESIDENTAIL IMPROVEMENTS ON DWG. C-15.
				ROCK WALL	REPLACE	REMOVE AND REPLACE EXISTING ROCK WALL ADJACENT TO CONCRETE DRIVEWAY AS REQUIRED FOR CONSTRUCTION. SEE DETAIL C/2023 FOR ROCK WALL.
MAILBOX	REPLACE			RELOCATE EXISTING MAILBOX AS NECESSARY FOR CONSTRUCTION.		
FENCE	REPLACE	SOUTH SIDE OF PROPERTY. REMOVE AND REPLACE EXISTING FENCE AS REQUIRED FOR CONSTRUCTION. COORDINATE WITH PROPERTY OWNER PRIOR TO REMOVAL.				

SCHEDULE OF PRIVATE IMPROVEMENTS, LOTS 7 THROUGH 11				
LOT NO.	ADDRESS	ITEM	REPLACE OR DISPOSE (1, 2)	NOTES
7	14564 SOUTH	LANDSCAPING/SPRINKLERS	REPLACE	REPLACE LANDSCAPING/SPRINKLERS AS NOTED IN THE GENERAL NOTES FOR RESIDENTAIL IMPROVEMENTS ON DWG. C-15.
		TREE	DISPOSE	REMOVE AND DISPOSE OF TREE AS REQUIRED FOR CONSTRUCTION.
8	14625 SOUTH	TREES AND LARGE ROCKS	DISPOSE	REMOVE AND DISPOSE OF TREES AND LARGE ROCKS AS REQUIRED FOR CONSTRUCTION. COORDINATE WITH PROPERTY OWNER PRIOR TO REMOVAL.
		VINYL FENCE	REPLACE	SOUTH SIDE OF PROPERTY. REMOVE AND REPLACE EXISTING FENCE AS REQUIRED FOR CONSTRUCTION. COORDINATE WITH PROPERTY OWNER PRIOR TO REMOVAL
		ROCK WALL	REPLACE	SOUTH AND NORTH SIDE OF PROPERTY. REMOVE AND REPLACE EXISTING ROCK WALL ADJACENT TO CONCRETE DRIVEWAY AS REQUIRED FOR CONSTRUCTION. SEE DETAIL C/2023 FOR ROCK WALL.
		WATER METER	REPLACE	RELOCATE WATER METER AS REQUIRED FOR CONSTRUCTION. RAISE METER TO MATCH FINAL GRADE.
		LANDSCAPING/SPRINKLERS	REPLACE	REPLACE LANDSCAPING/SPRINKLERS AS NOTED IN THE GENERAL NOTES FOR RESIDENTAIL IMPROVEMENTS ON DWG. C-15.
		SHRUBS	DISPOSE	REMOVE AND DISPOSE OF EXISTING SHRUBS AS REQUIRED FOR CONSTRUCTION.
		PINE TREE	DISPOSE	REMOVE AND DISPOSE OF EXISTING TREE AS REQUIRED FOR CONSTRUCTION.
9	14569 SOUTH	IRON PIPE FENCE	REPLACE	SOUTH SIDE OF PROPERTY. REMOVE AND REPLACE EXISTING FENCE AS REQUIRED FOR CONSTRUCTION. COORDINATE WITH PROPERTY OWNER PRIOR TO REMOVAL
		LANDSCAPING/SPRINKLERS	REPLACE	REPLACE LANDSCAPING/SPRINKLERS AS NOTED IN THE GENERAL NOTES FOR RESIDENTAIL IMPROVEMENTS ON DWG. C-15.
		MAILBOXES	REPLACE	2 LOCATIONS. RELOCATE EXISTING MAILBOX AS NECESSARY FOR CONSTRUCTION.
10	14539 SOUTH	BLOCK WALL	DISPOSE	REMOVE AND DISPOSE OF EXISTING BLOCK WALL. COORDINATE WITH PROPERTY OWNER PRIOR TO REMOVAL.
		METAL PIPE GATE	PROTECT	PRESERVE AND PROTECT EXISTING METAL GATE.
		IRON PIPE FENCE	REPLACE	SOUTH SIDE OF PROPERTY. REMOVE AND REPLACE EXISTING FENCE AS REQUIRED FOR CONSTRUCTION. COORDINATE WITH PROPERTY OWNER PRIOR TO REMOVAL
		PINE TREE	DISPOSE	REMOVE AND DISPOSE OF EXISTING TREE AS REQUIRED FOR CONSTRUCTION.
		IRRIGATION BOX	REPLACE	REPLACE IRRIGATION BOX AS NOTED IN THE GENERAL NOTES FOR RESIDENTAIL IMPROVEMENTS ON DWG. C-15.
		LANDSCAPING/SPRINKLERS	REPLACE	REPLACE LANDSCAPING/SPRINKLERS AS NOTED IN THE GENERAL NOTES FOR RESIDENTAIL IMPROVEMENTS ON DWG. C-15.
		TREES	DISPOSE	2 LOCATIONS. REMOVE AND DISPOSE OF EXISTING TREE AS REQUIRED FOR CONSTRUCTION.
11	14507 SOUTH	CONCRETE CURBING	DISPOSE	REMOVE AND DISPOSE OF EXISTING CONCRETE LANDSCAPE CURBING AS REQUIRED FOR CONSTRUCTION.
		ROCK WALL	REPLACE	FRONT OF PROPERTY. REMOVE AND REPLACE EXISTING ROCK WALL AS REQUIRED FOR CONSTRUCTION. SEE DETAIL C/2023 FOR ROCK WALL.
		MAILBOX	REPLACE	RELOCATE EXISTING MAILBOX AS NECESSARY FOR CONSTRUCTION.
		IRON PIPE FENCE	REPLACE	SOUTH SIDE OF PROPERTY. REMOVE AND REPLACE EXISTING FENCE AS REQUIRED FOR CONSTRUCTION. COORDINATE WITH PROPERTY OWNER PRIOR TO REMOVAL
		PINE TREES	DISPOSE	SOUTH SIDE OF PROPERTY. REMOVE AND DISPOSE OF TREES AS REQUIRED FOR CONSTRUCTION.
11	14507 SOUTH	LANDSCAPING/SPRINKLERS	REPLACE	REPLACE LANDSCAPING/SPRINKLERS AS NOTED IN THE GENERAL NOTES FOR RESIDENTAIL IMPROVEMENTS ON DWG. C-15.
		MAILBOXES	REPLACE	RELOCATE EXISTING MAILBOX AS NECESSARY FOR CONSTRUCTION.
		PINE TREES	DISPOSE	NORTH SIDE OF PROPERTY. REMOVE AND DISPOSE OF TREES AS REQUIRED FOR CONSTRUCTION.
NOTES:				
1. PROPERTY OWNER HAS BEEN GIVEN THE OPTIONS TO SALVAGE ITEMS NOTED FOR DISPOSAL PRIOR TO CONSTRUCTION OF THE PROJECT. CONTRACTOR SHALL COORDINATE WITH PROPERTY OWNER PRIOR TO REMOVAL OF ANY ITEM. CONTRACTOR SHALL DISPOSE OF ALL ITEMS LISTED IN ACCORDANCE WITH STATE REGULATIONS.				
2. ITEMS NOTED TO REPLACE SHALL BE REMOVED AS REQUIRED FOR CONSTRUCTION OF IMPROVEMENTS AND SHALL BE REPLACED TO EXISTING OR BETTER CONDITIONS. COORDINATE WITH PRIVATE PROPERTY OWNER PRIOR TO CONSTRUCTION.				
3. REFERENCE GENERAL NOTES FOR RESIDENTAIL IMPROVEMENT ON DWG. C-15 FOR CONSTRUCTION ON PRIVATE PROPERTIES.				

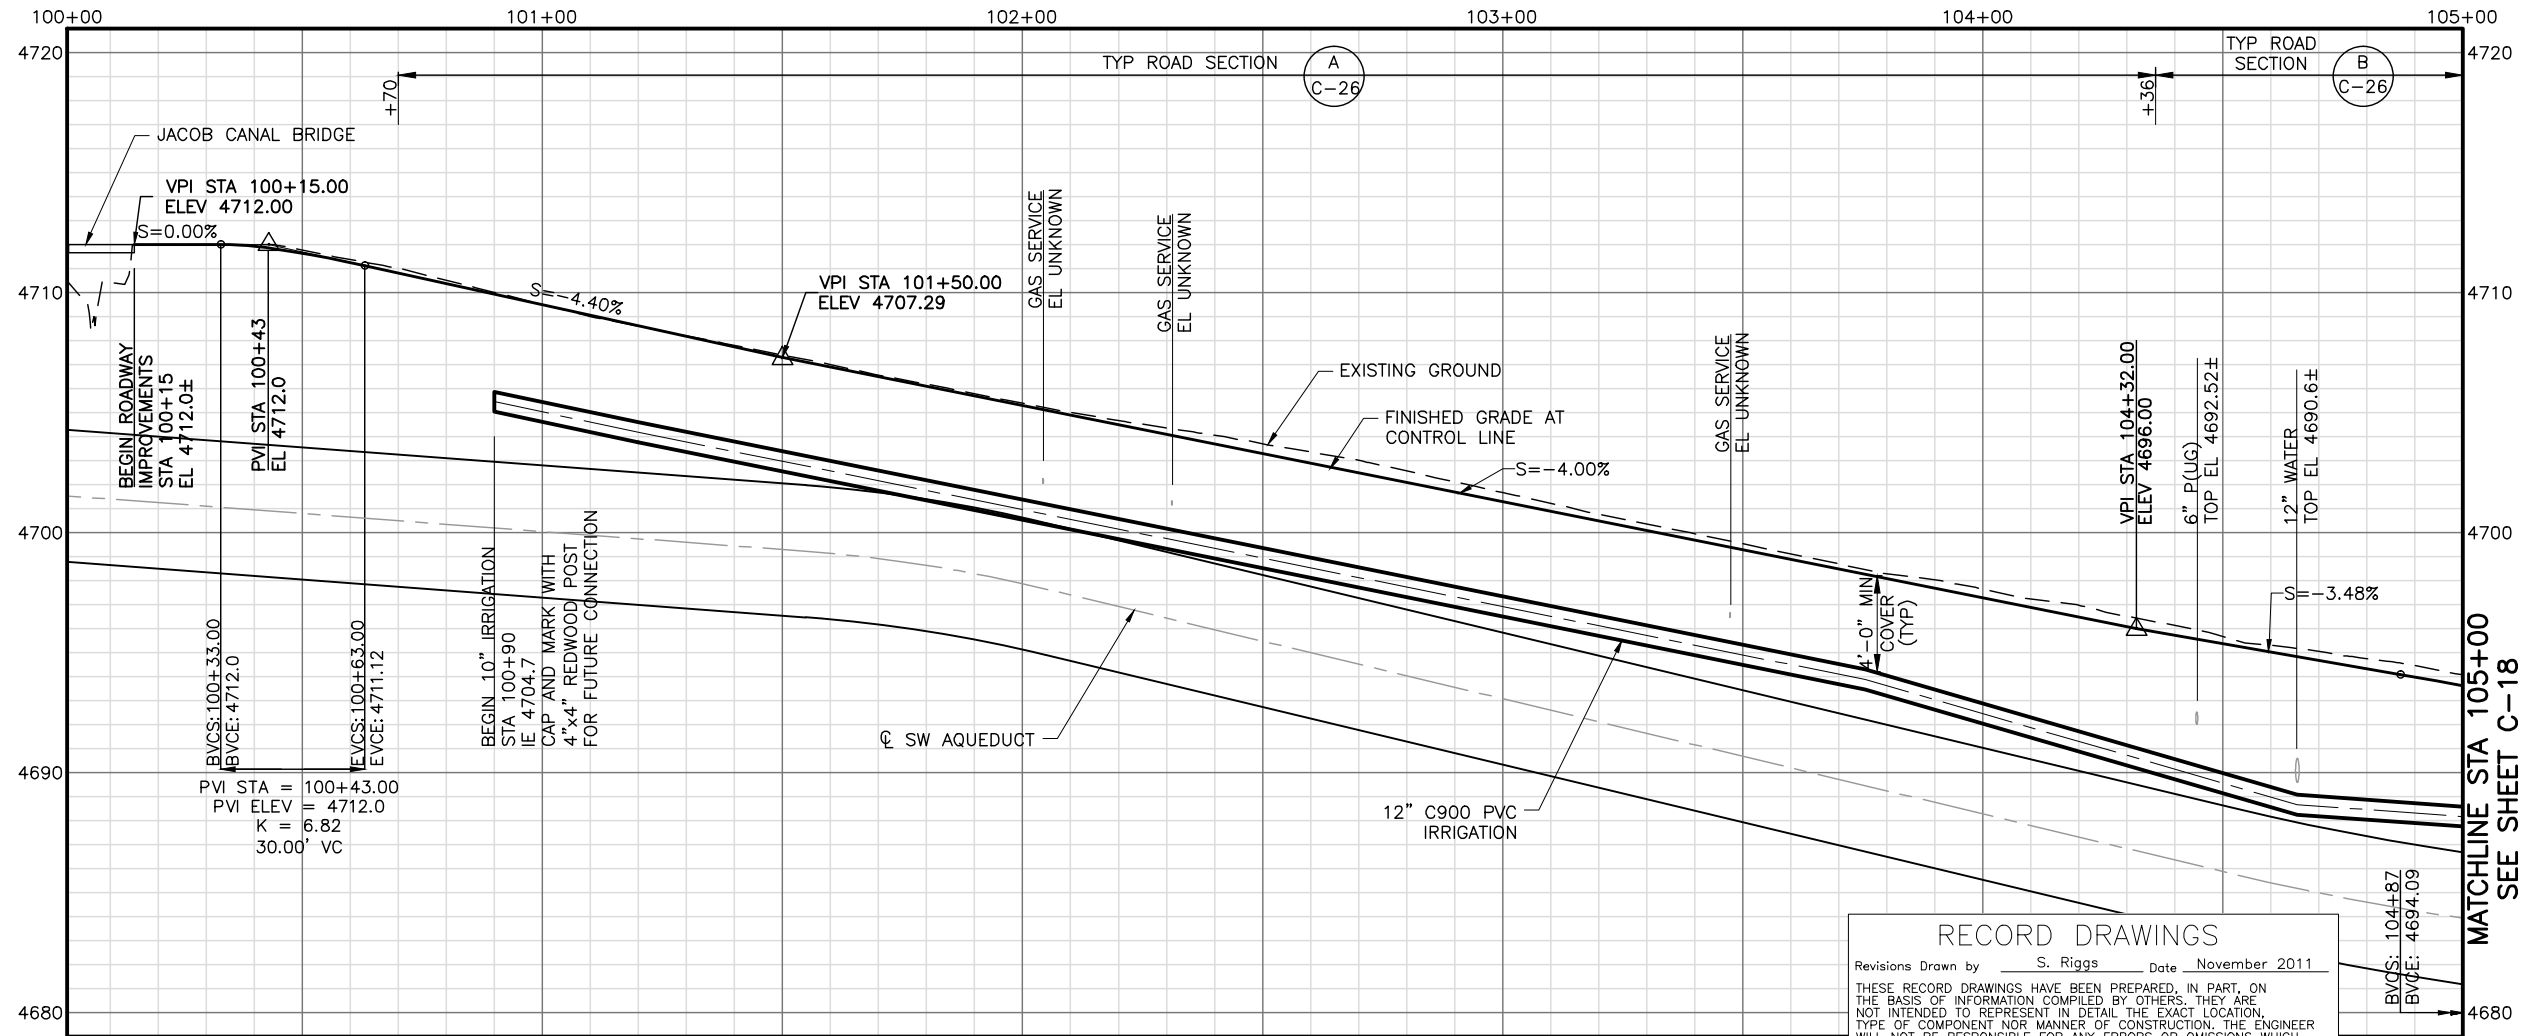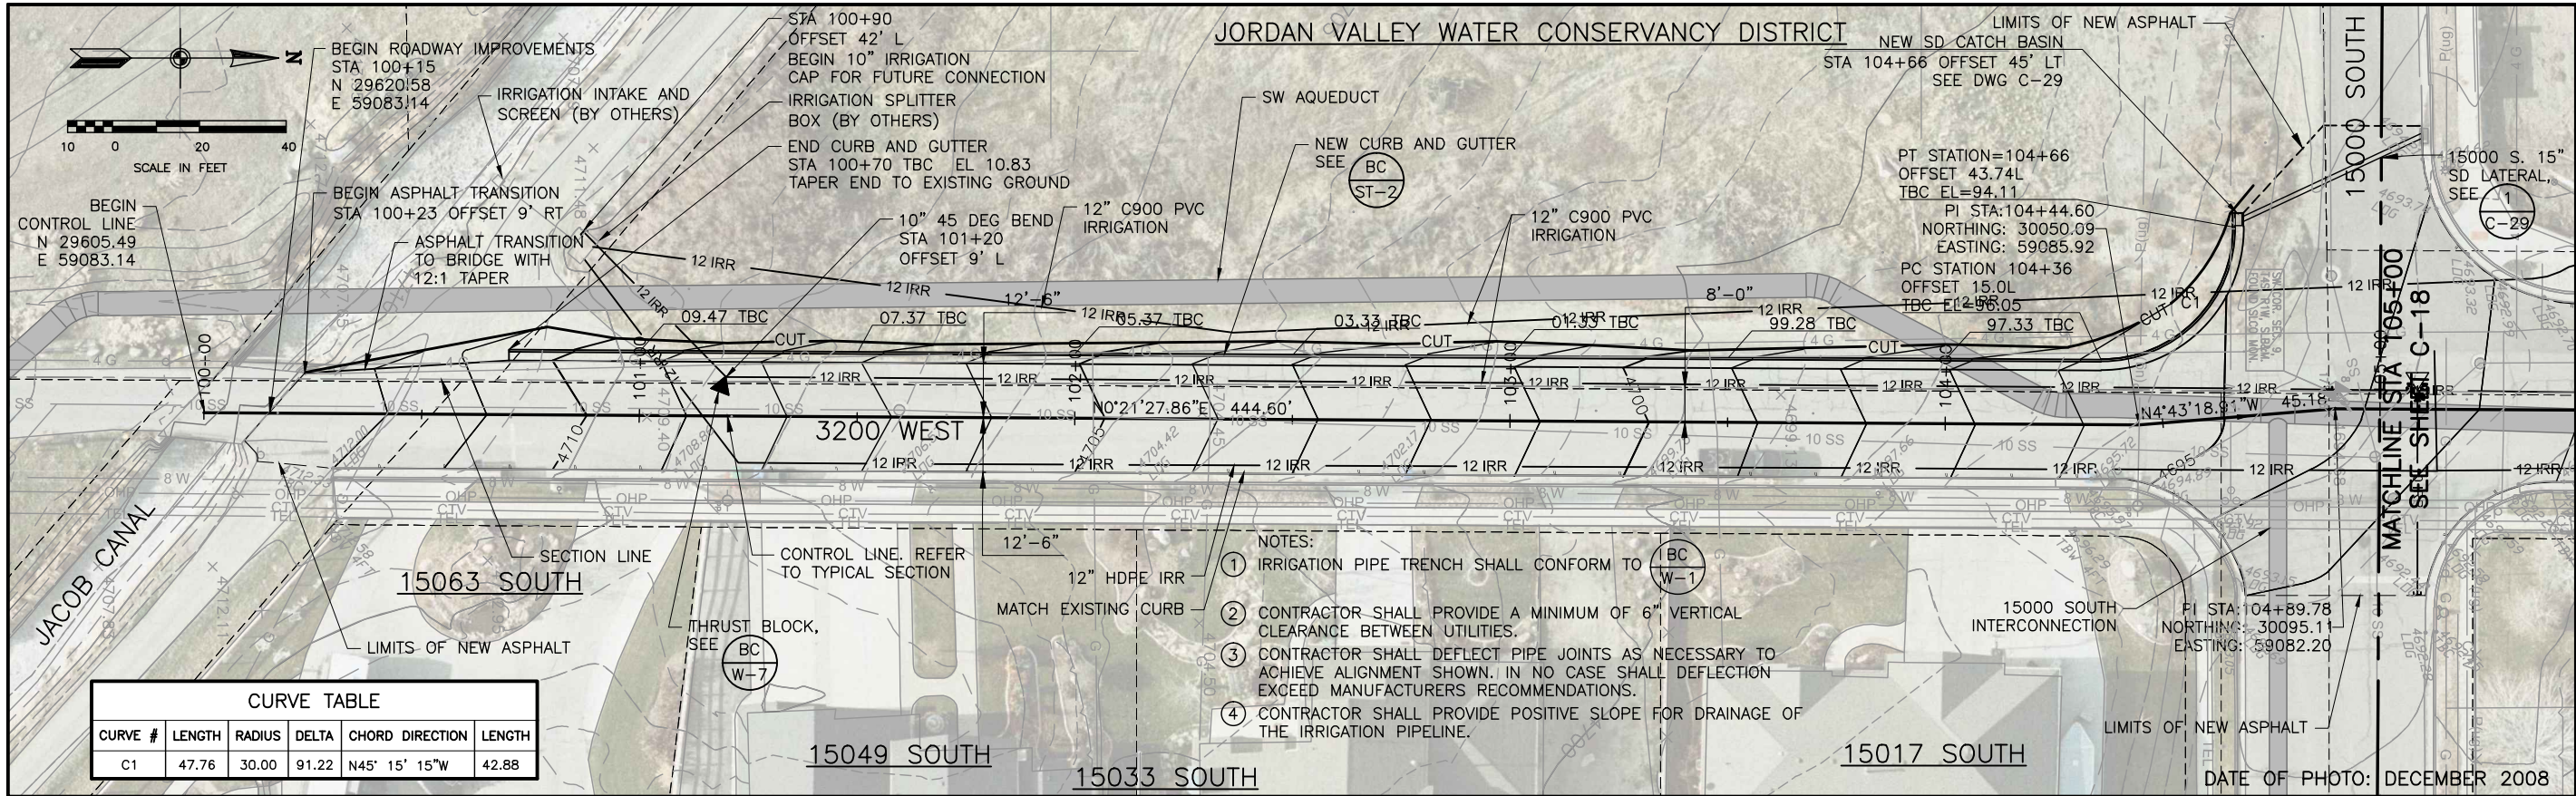

JORDAN VALLEY WATER CONSERVANCY DISTRICT

SOUTHWEST AQUEDUCT REACH 2 PROJECT

PLAN AND PROFILE - 1
STA 100+00 TO STA 105+00

DATE: FEBRUARY 2010 PROJECT NUMBER 010-08-03

DRAWING NO. C-17


SHEET 40 OF 110



DESIGN T. OLSEN
CHECKED K. BAGLEY
APPROVED J. LUETTINGER

REVIEW

VERIFY SCALE
BAR IS ONE INCH ON ORIGINAL DRAWING

NO. DATE REV. BY DESCRIPTION REVISIONS

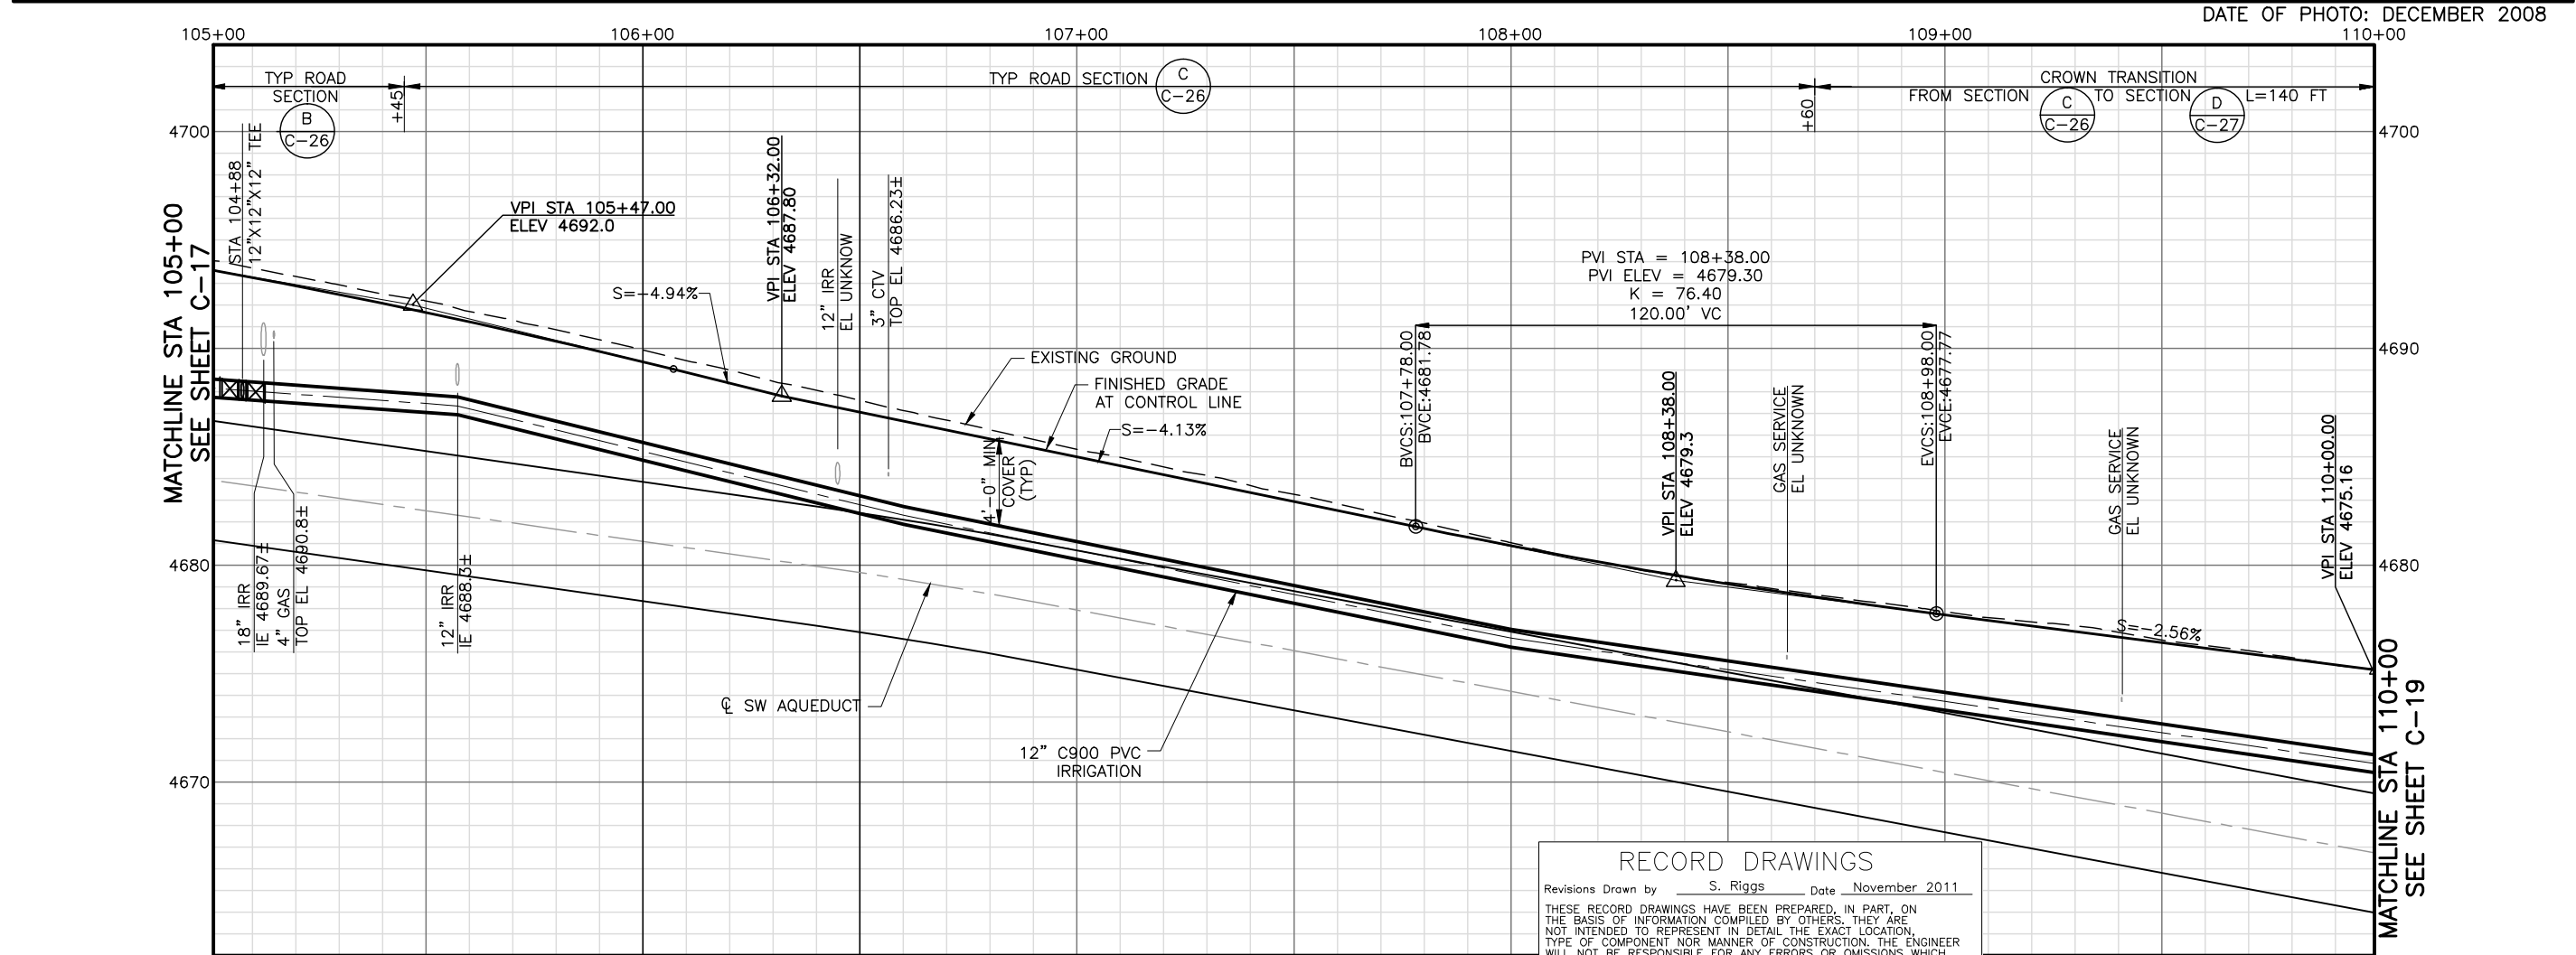

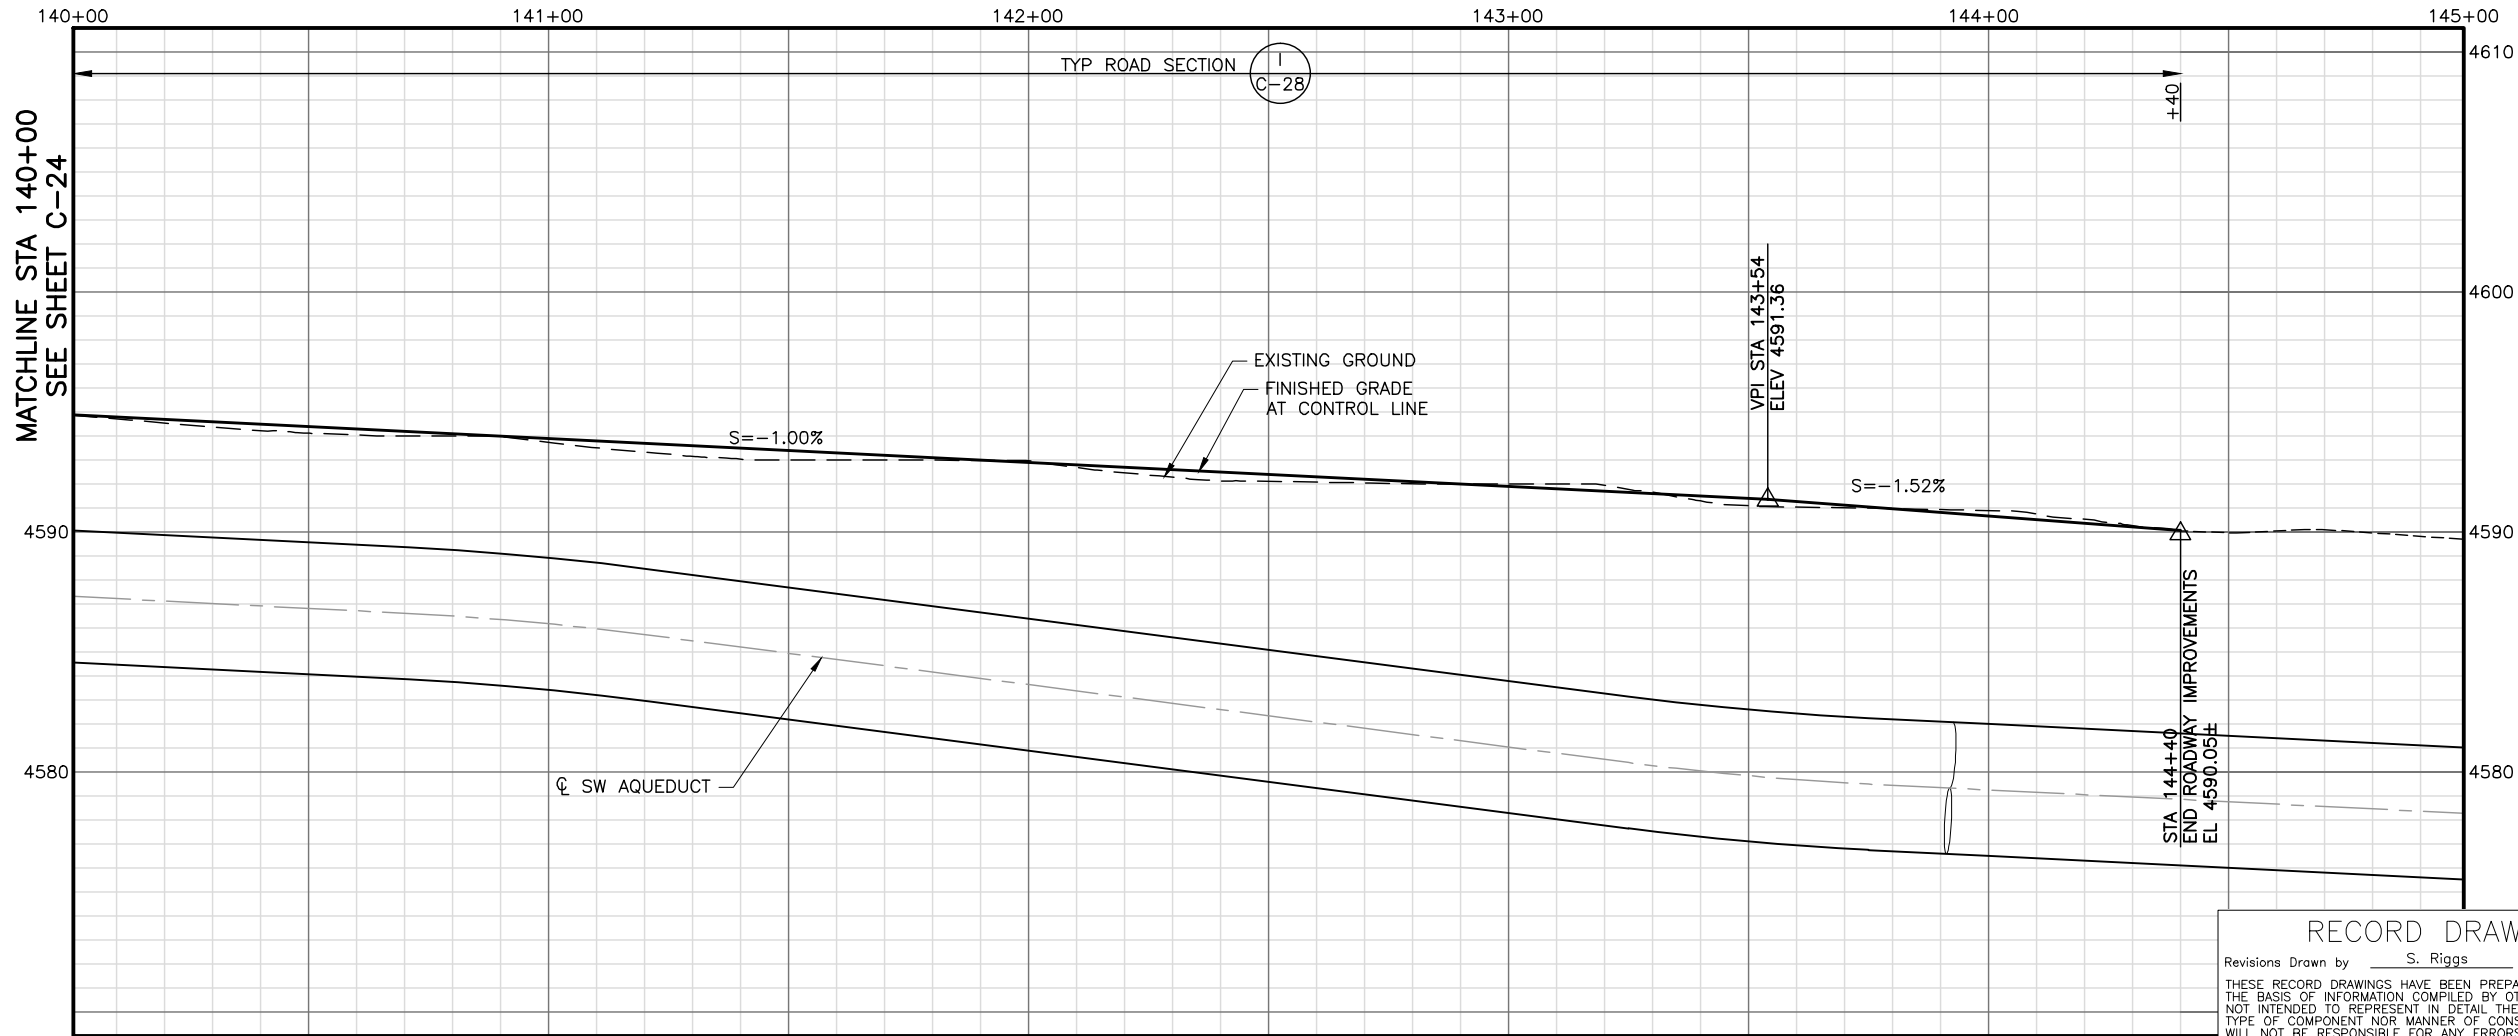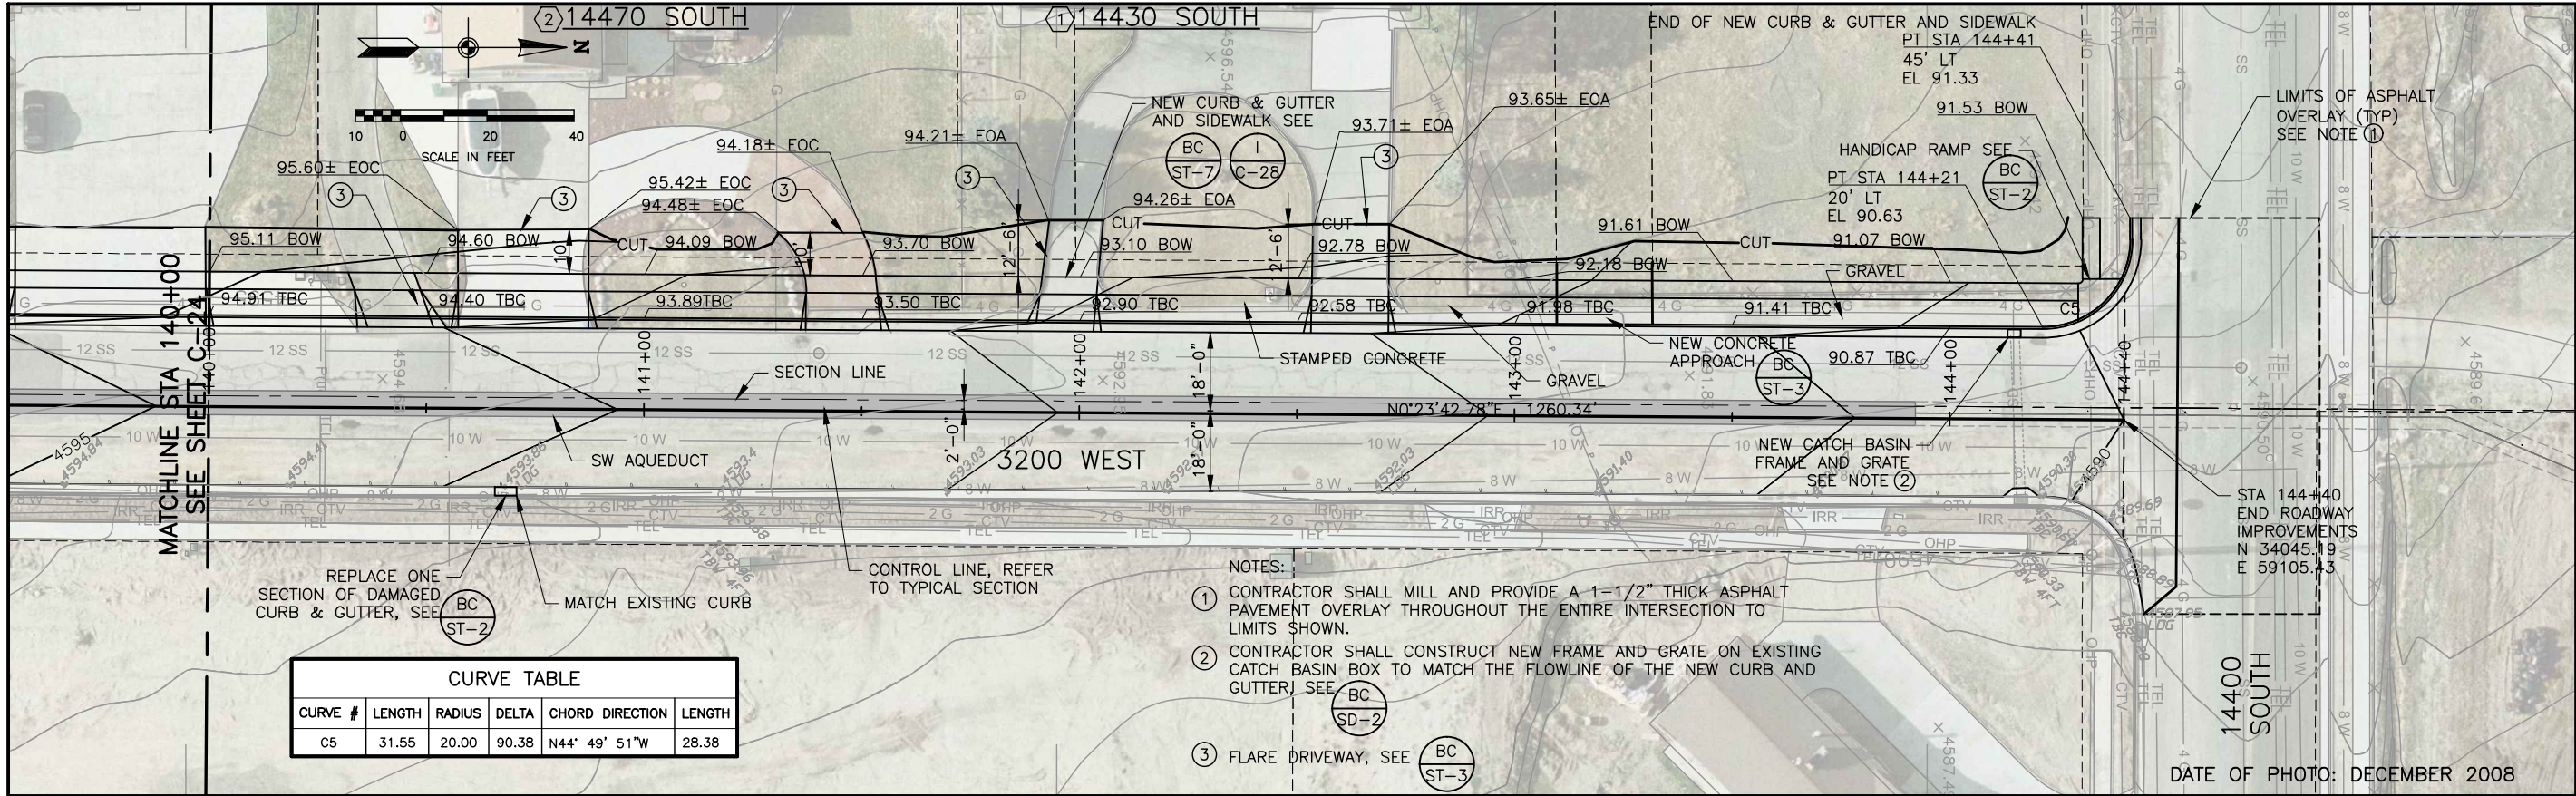

Bowen Collins & Associates, Inc.
Consulting Engineers

JORDAN VALLEY WATER CONSERVANCY DISTRICT

SOUTHWEST AQUEDUCT REACH 2 PROJECT

PLAN AND PROFILE - 9
STA 140+00 TO STA 144+40

CIVIL




DATE: FEBRUARY 2010 PROJECT NUMBER 010-08-03

DESIGN T. OLSEN
CHECKED K. BAGLEY
APPROVED J. LUETTINGER

REVIEW SCALE
BAR IS ONE INCH ON ORIGINAL DRAWING

NO. DATE REV. BY DESCRIPTION REVISIONS

DRAWING NO. C-25
SHEET 48 OF 110

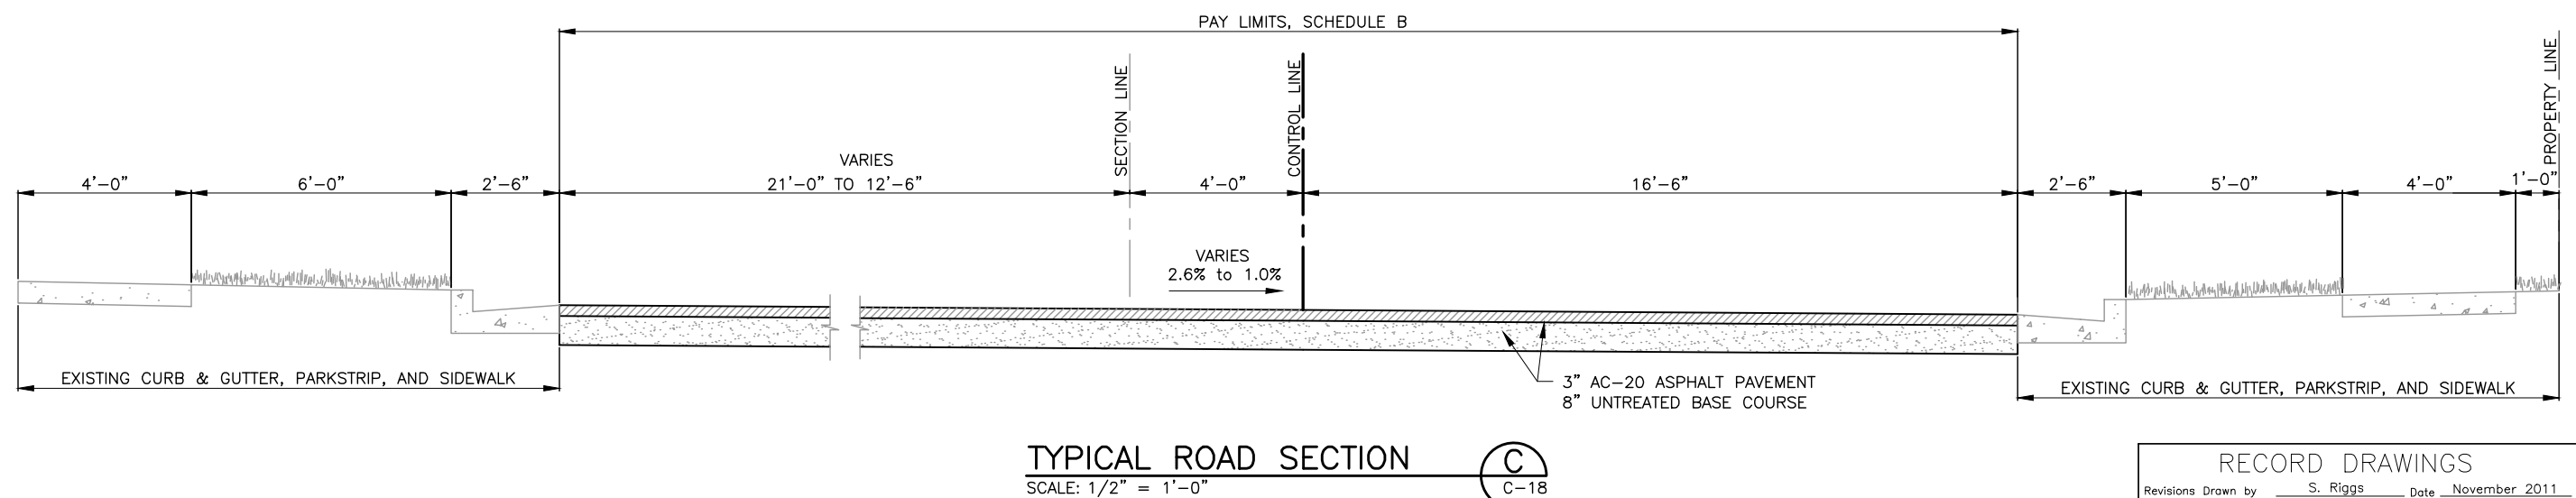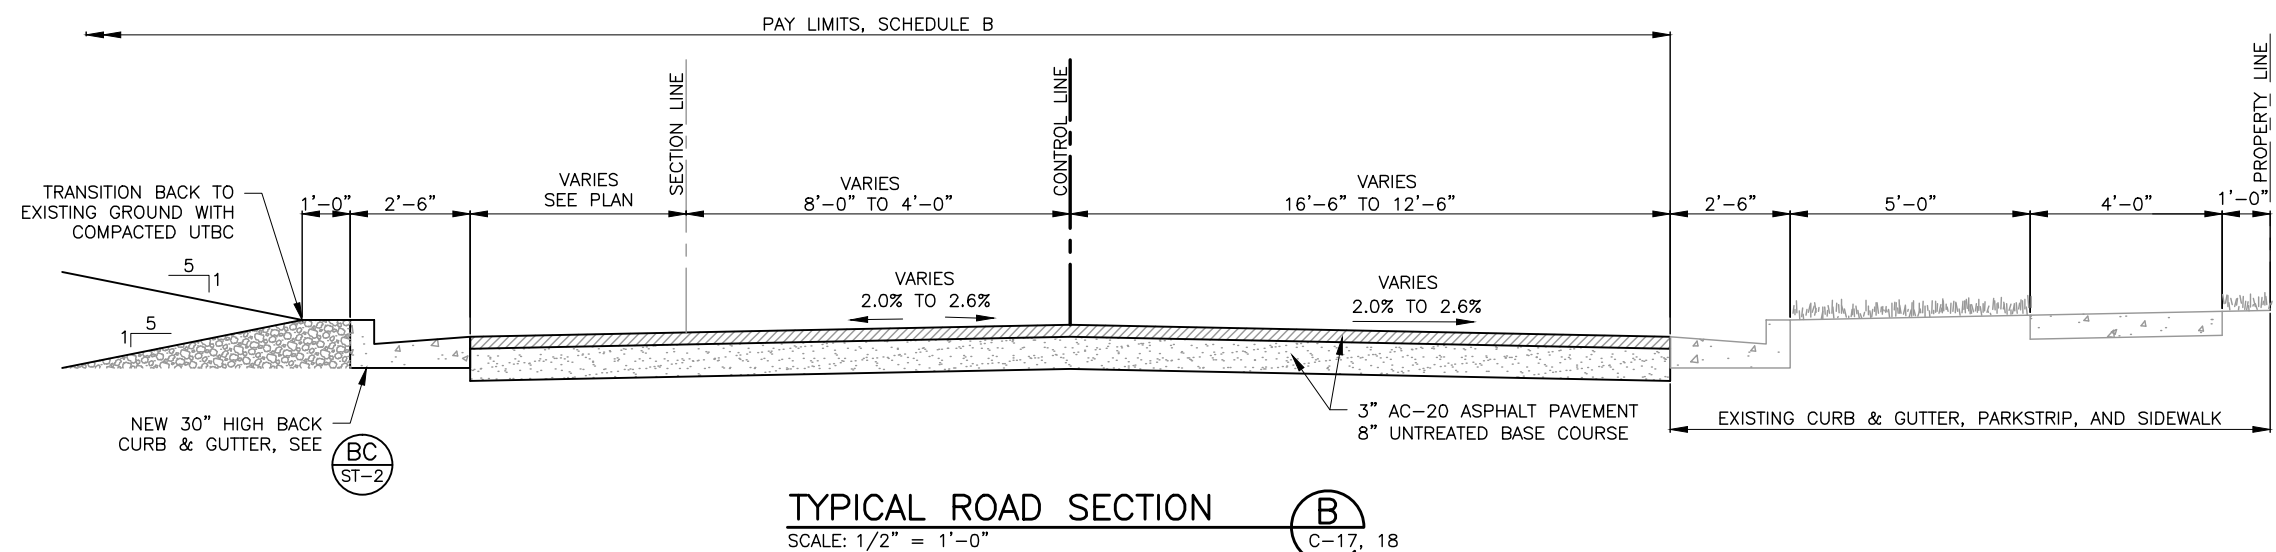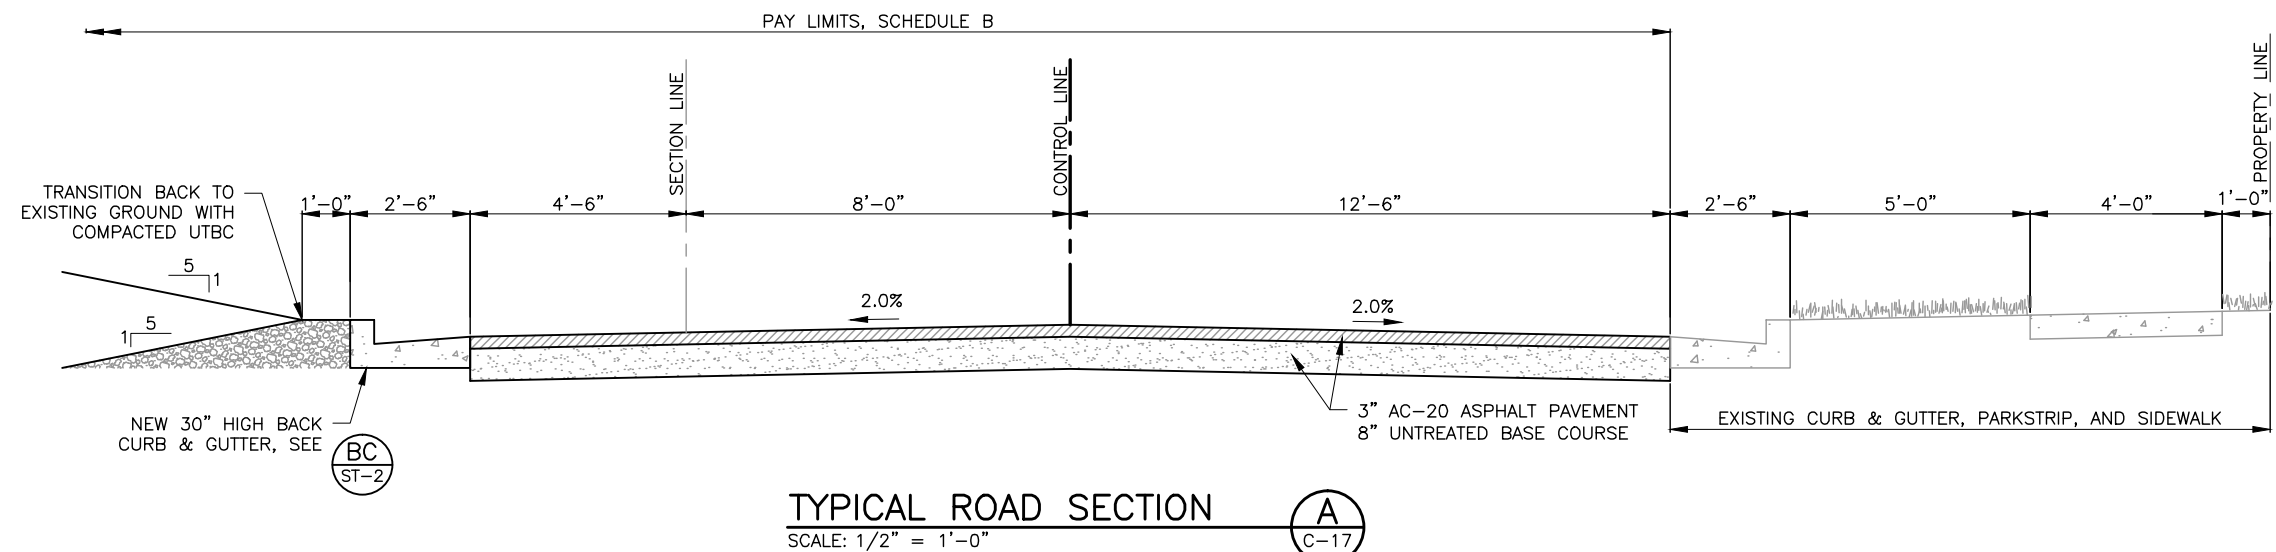

RECORD DRAWINGS

Revisions Drawn by S. Riggs Date November 2011

THESE RECORD DRAWINGS HAVE BEEN PREPARED, IN PART, ON THE BASIS OF INFORMATION COMPILED BY OTHERS. THEY ARE NOT INTENDED TO REPRESENT IN DETAIL THE EXACT LOCATION, TYPE OF COMPONENT NOR MANNER OF CONSTRUCTION. THE ENGINEER WILL NOT BE RESPONSIBLE FOR ANY ERRORS OR OMISSIONS WHICH HAVE BEEN INCORPORATED INTO THE RECORD DRAWINGS.



**Bowen
Collins
& Associates, Inc.**
Consulting Engineers

[illegible]

SOUTHWEST AQUEDUCT REACH 2 PROJECT

SOUTHWEST AQUEDUCT REACH 2 PROJECT

VERIFY SCALE
BAR IS ONE INCH ON
ORIGINAL DRAWING

REVIEW
CHECKED K. BAGLEY
APPROVED J. LUETTINGER


DESIGN T. OLSEN
DRAWN R. D. / B. A.

TYPICAL ROAD SECTIONS


TYPICAL ROAD SECTIONS	
DATE: FEBRUARY	2010
PROJECT NUMBER 010-08-03	

DRAWING NO.


SHEET 49 OF 110

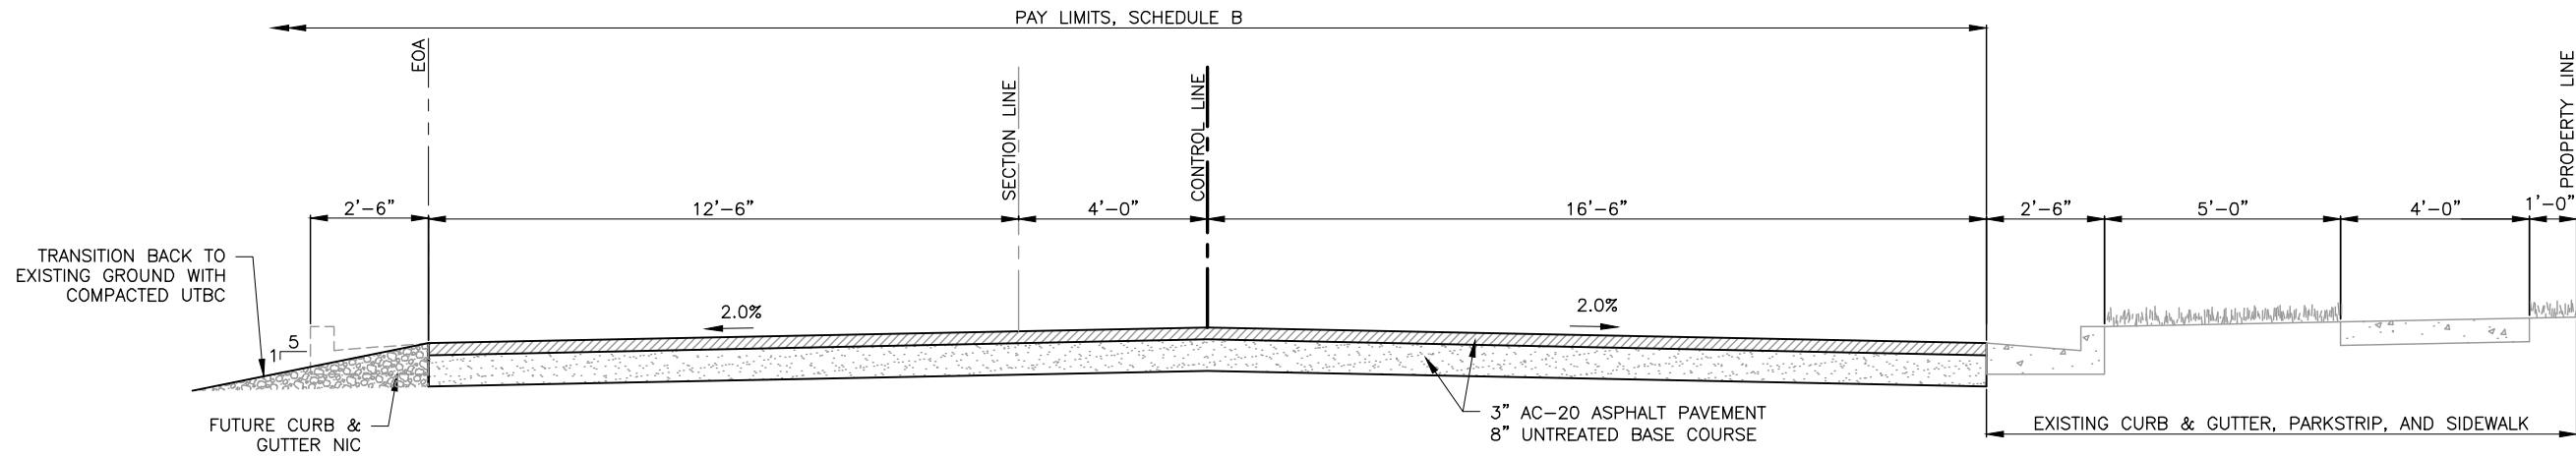

TYPICAL ROAD SECTION **D**
SCALE: 1/2" = 1'-0"
C-19, 20, 21
STA 110+00 TO STA 124+90
DESIGN SPEED 35 MPH

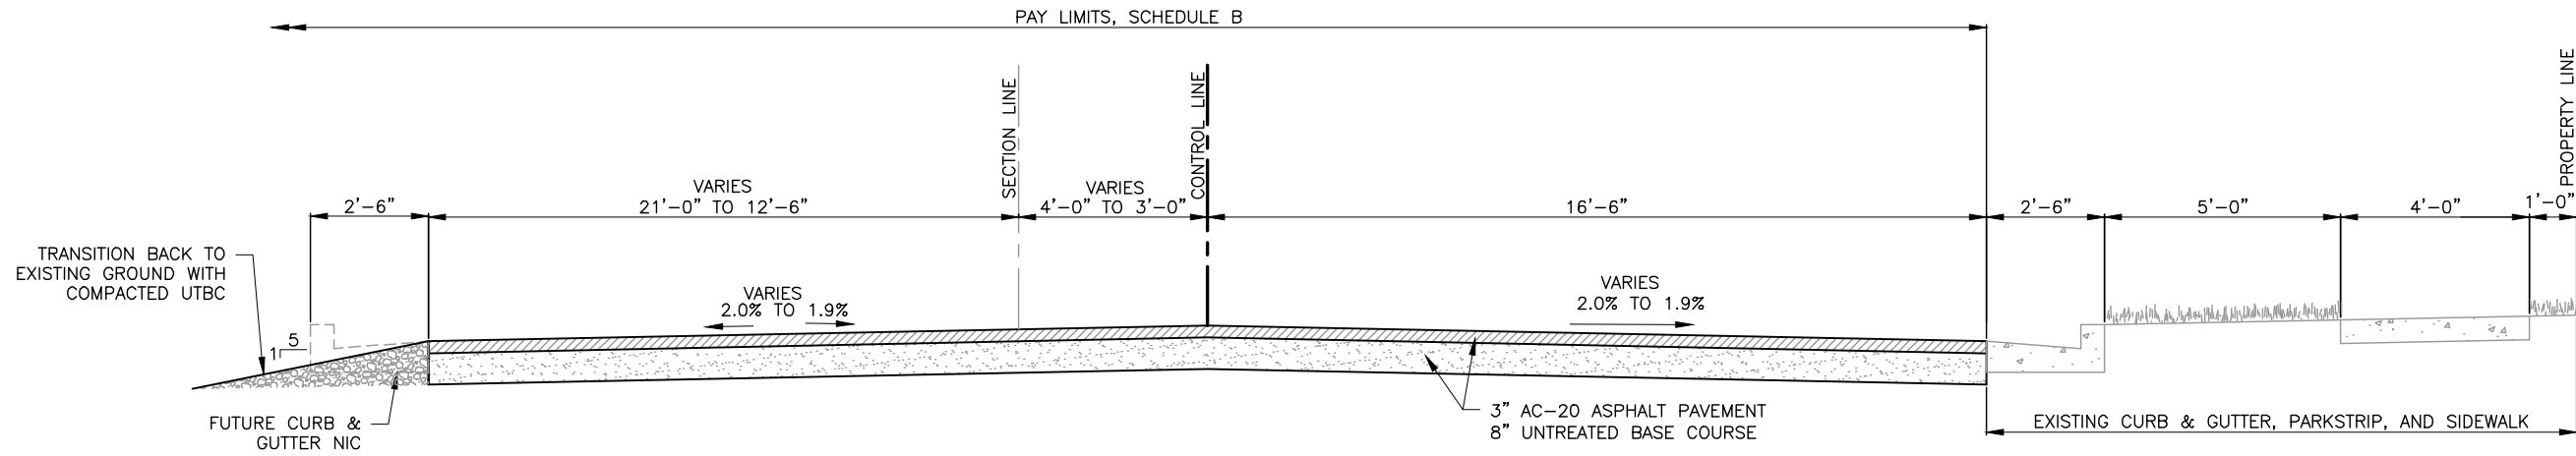

TYPICAL ROAD SECTION **E**
SCALE: 1/2" = 1'-0"
C-21, 22
STA 124+90 TO STA 126+10
DESIGN SPEED 35 MPH

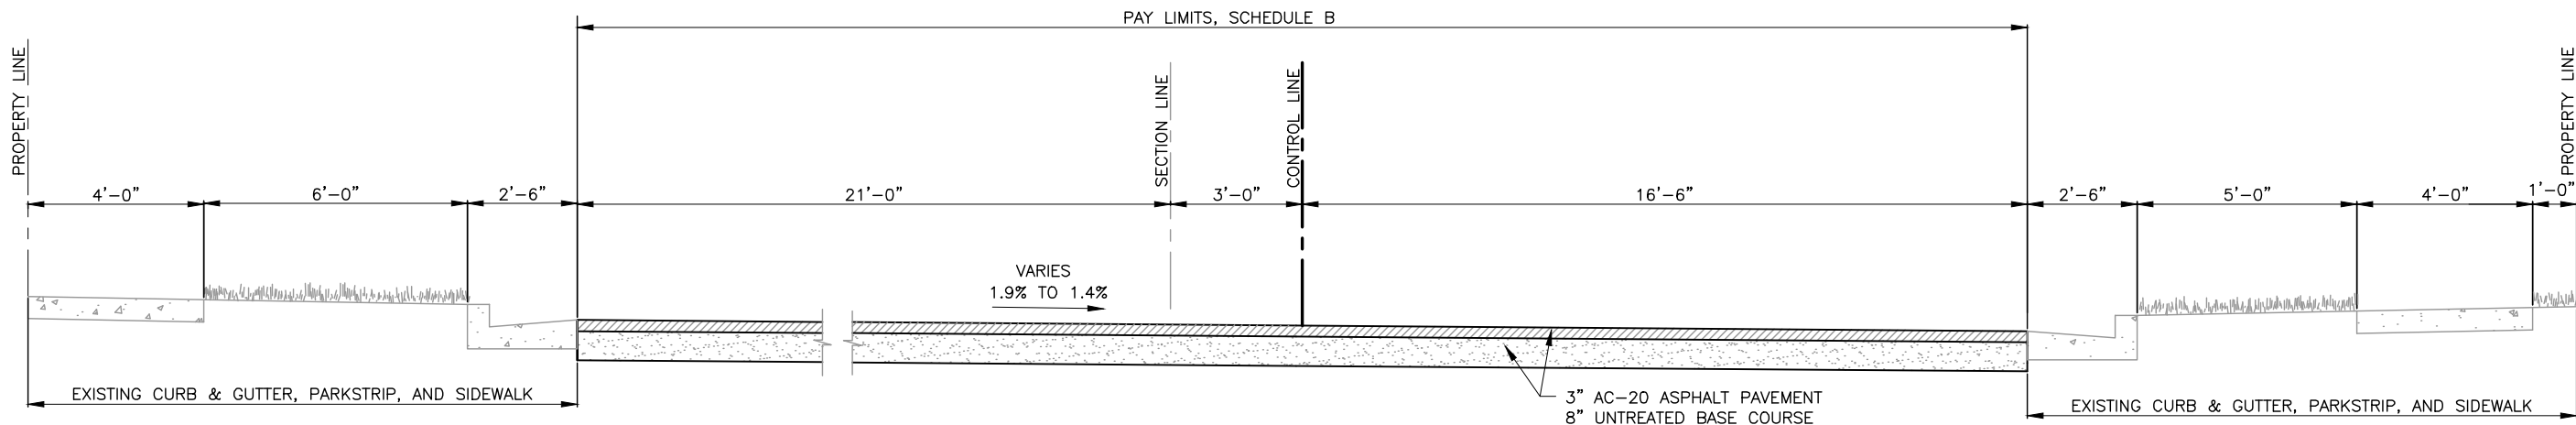

TYPICAL ROAD SECTION **F**
SCALE: 1/2" = 1'-0"
C-22
STA 126+10 TO STA 129+37
DESIGN SPEED 35 MPH

RECORD DRAWINGS

Revisions Drawn by S. Riggs Date November 2011

THESE RECORD DRAWINGS HAVE BEEN PREPARED, IN PART, ON THE BASIS OF INFORMATION COMPILED BY OTHERS. THEY ARE NOT INTENDED TO REPRESENT IN DETAIL THE EXACT LOCATION, TYPE OF COMPONENT NOR MANNER OF CONSTRUCTION. THE ENGINEER WILL NOT BE RESPONSIBLE FOR ANY ERRORS OR OMISSIONS WHICH HAVE BEEN INCORPORATED INTO THE RECORD DRAWINGS.

DESIGN

DESIGN T. OLSEN

DRAWN R. DARGER

REVIEW

CHECKED K. BAGLEY

APPROVED J. LUETTINGER

VERIFY SCALE

BAR IS ONE INCH ON ORIGINAL DRAWING

NO.

DATE

REV. BY

DESCRIPTION

REVISIONS

JORDAN VALLEY WATER CONSERVANCY DISTRICT

SOUTHWEST AQUEDUCT REACH 2 PROJECT

CIVIL






TYPICAL ROAD SECTIONS

PROJECT NUMBER 010-08-03

DATE: FEBRUARY 2010

DRAWING NO. C-27

SHEET 50 OF 110

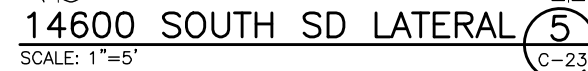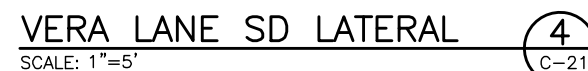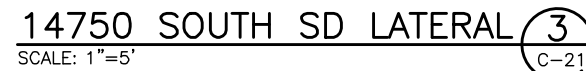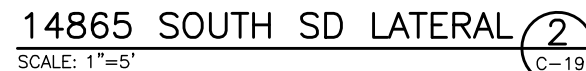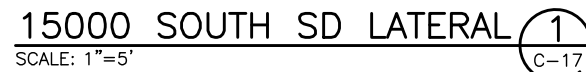

**Bowen
Collins
& Associates, Inc.**
Consulting Engineers

[illegible]

SOUTHWEST AQUEDUCT REACH 2 PROJECT



DESIGN	REVIEW
DESIGN T. OLSEN	CHECKED K. BAGLEY
DRAWN R. DARGER	APPROVED J. LUETTINGER

CIVIL

3200 WEST STORM DRAIN LATERAL PROFILES

DATE: FEBRUARY 2010 PROJECT NUMBER 010-08-03

DRAWING NO. C-29
SHEET 52 OF 110



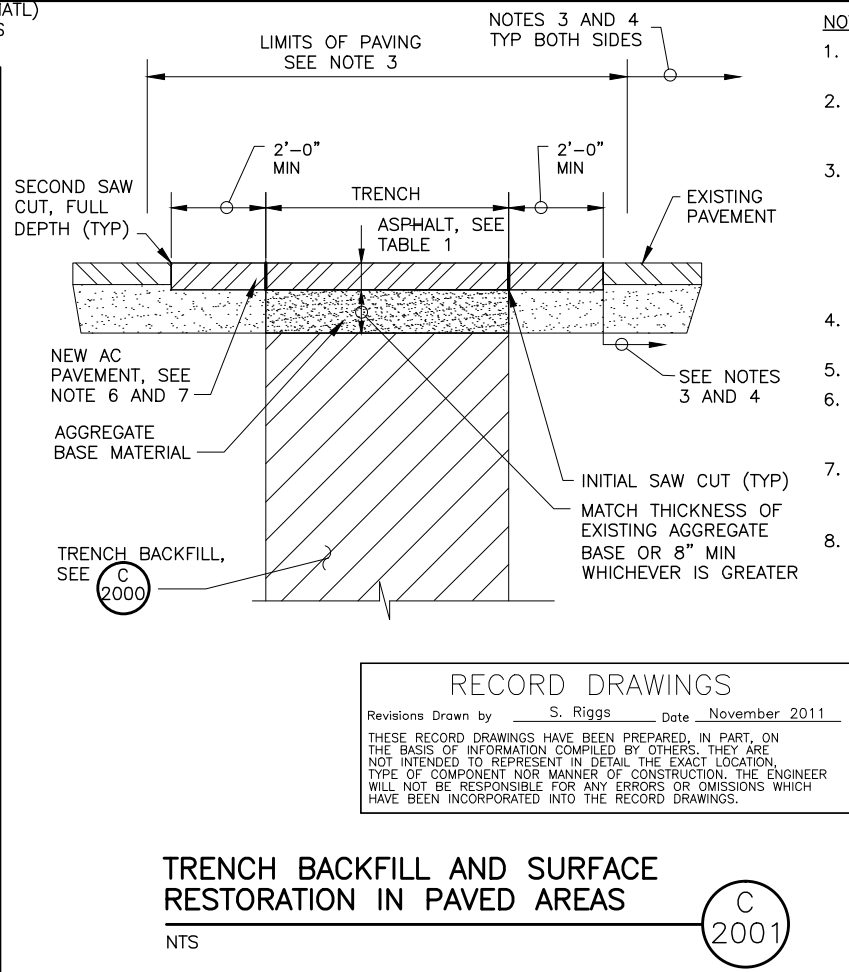
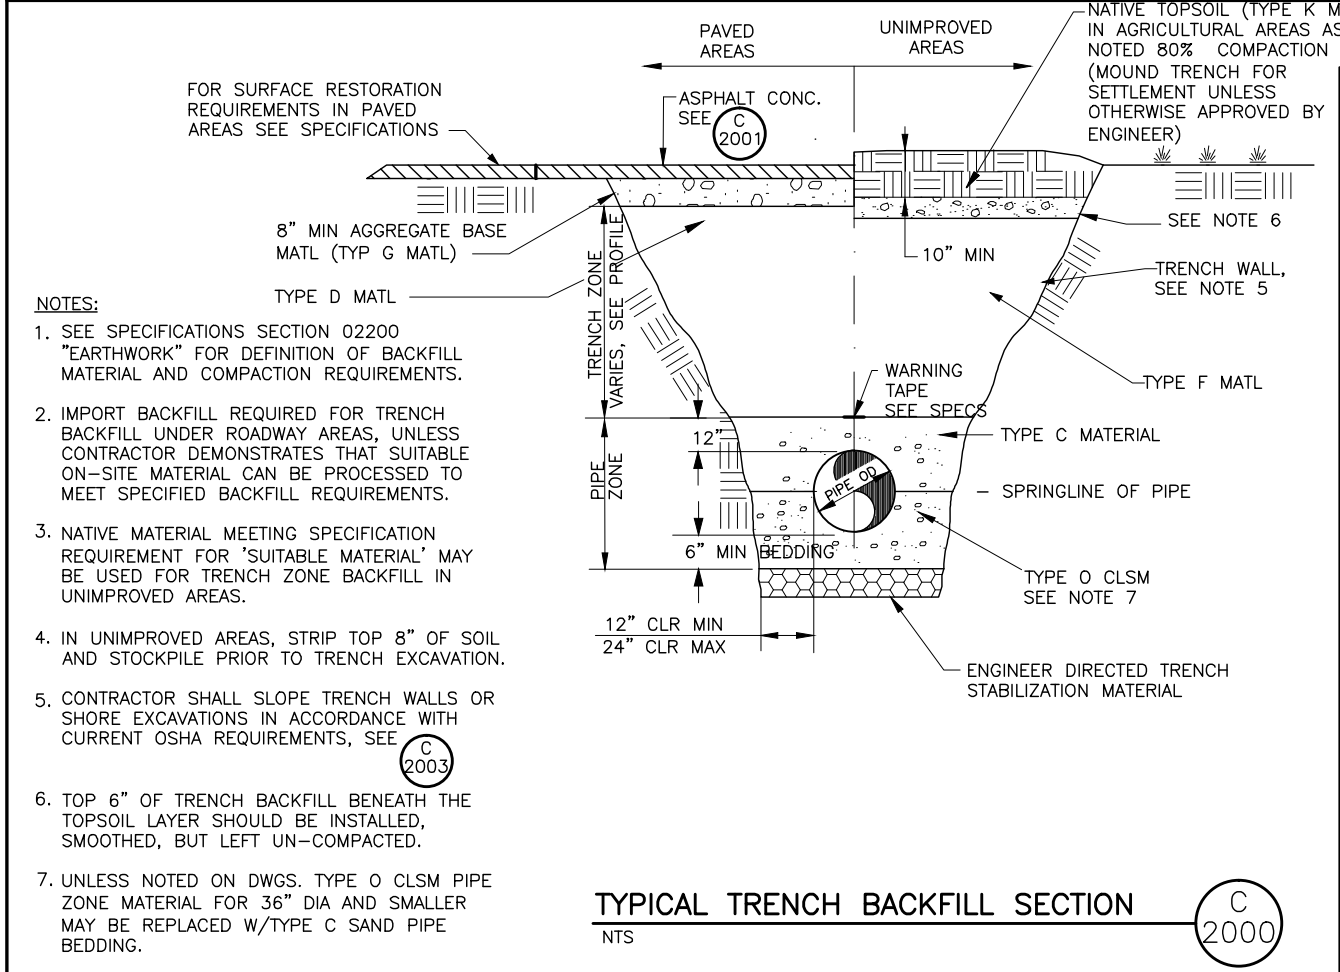


NOTES:

- REFER TO SECTION 01506 TRAFFIC CONTROL FOR LANE CLOSURE, DETOUR, AND TRAFFIC CONTROL REQUIREMENTS
- CONTRACTOR SHALL PERMANENTLY REPLACE ALL PAVEMENT SURFACES, STRIPING, AND TRAFFIC CONTROLS IN ACCORDANCE WITH CITY STANDARDS PRIOR TO REMOVING DETOURS.
- REMOVE ADDITIONAL PAVEMENT TO A PAINTED LANE STRIPE, A LIP OF GUTTER, A CURB, AN EXISTING PAVEMENT PATCH, OR AN EDGE OF THE PAVEMENT IF SUCH A FEATURE IS WITHIN FIVE FEET OF THE SECOND SAW CUT. IN NO CASE SHALL ASPHALT SEAM BE PLACED IN WHEEL PATH. IF MORE THAN 50% OF THE PERMANENT SURFACING OF A TRAVELED LANE IS IMPACTED BY THE EXCAVATION, THE ENTIRE LANE WIDTH SHALL BE SAW CUT, REMOVED, AND REPLACED.
- ALL CONTRACTOR DAMAGED PAVEMENT OUTSIDE OF THE LIMITS SHOWN SHALL BE REMOVED AND REPLACED AT CONTRACTORS EXPENSE.
- NOT USED.
- HOT ASPHALTIC CONCRETE PAVEMENT SHALL BE PLACED IN TWO LIFTS. A TACK COAT SHALL BE PLACED BETWEEN LIFTS AND ALONG ALL VERTICAL SURFACES OF EXISTING PAVEMENT.
- ASPHALT MIX DESIGN SHALL MEET LATEST VERSION OF CITY CONSTRUCTION SPECIFICATIONS (SEE TABLE). MIX DESIGN MUST BE SUBMITTED AND APPROVED BY CITY PRIOR TO PLACEMENT.
- AMBIENT TEMPERATURE MUST BE 45° F AND RISING IN ORDER TO PLACE ASPHALT. ASPHALT PLACEMENT BETWEEN OCTOBER 1ST AND APRIL 1ST MUST HAVE CITY ENGINEERS APPROVAL.

TABLE 1

LOCATION	PAVEMENT THICKNESS	ASPHALT TYPE
JVWTP	3"	AC-20-DM-3/4
3200 WEST	3"	AC-20-DM-3/4
15000 SOUTH	4"	AC-20-DM-3/4
14400 SOUTH	4"	AC-20-DM-3/4
13800 SOUTH	4"	AC-20-DM-3/4
13680 SOUTH	4"	AC-20-DM-3/4
SANDBORN AVE.	4"	AC-20-DM-3/4
13400 SOUTH	6"	AC-20-DM-3/4N

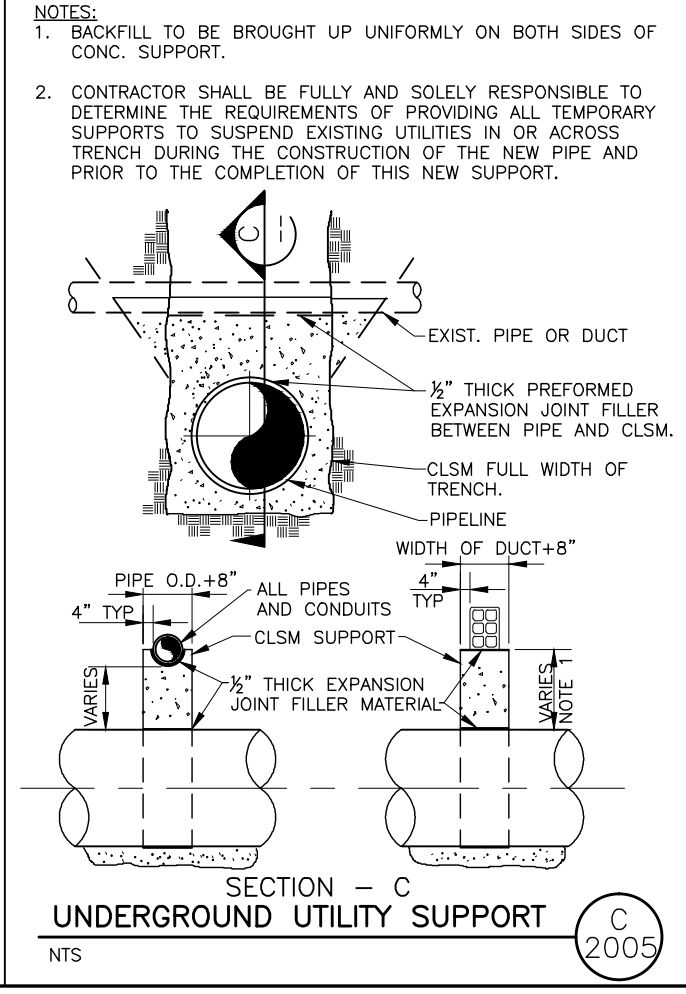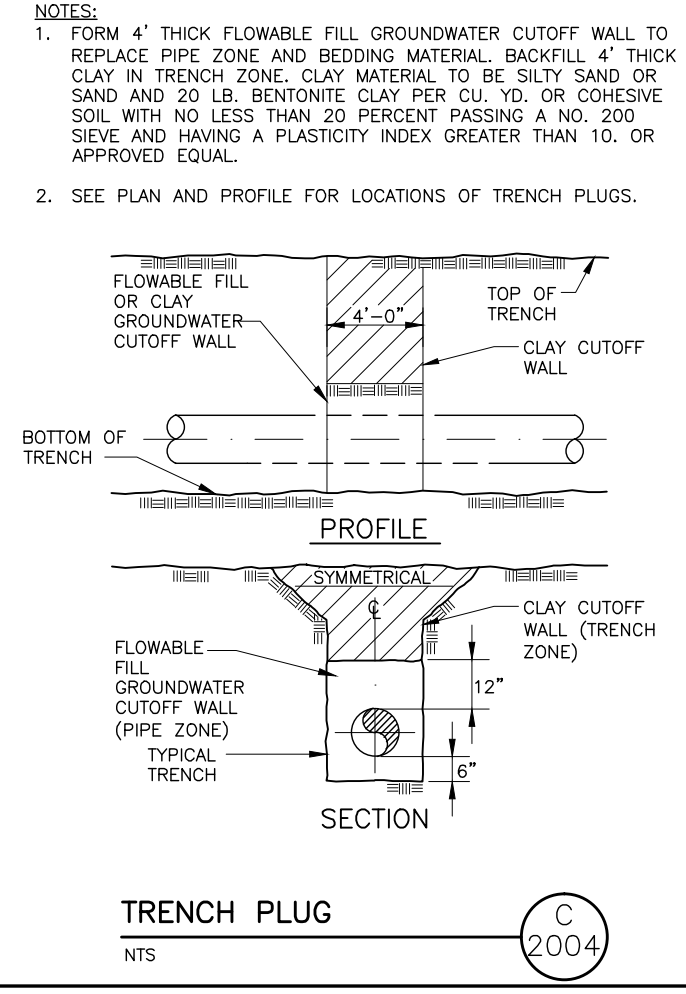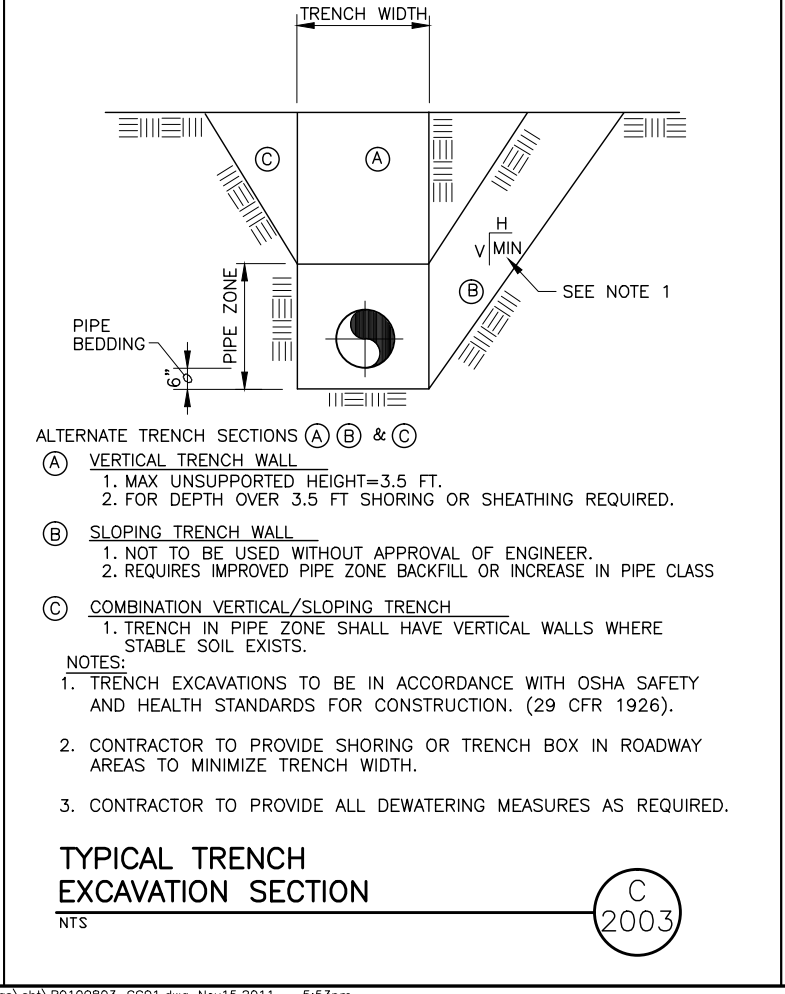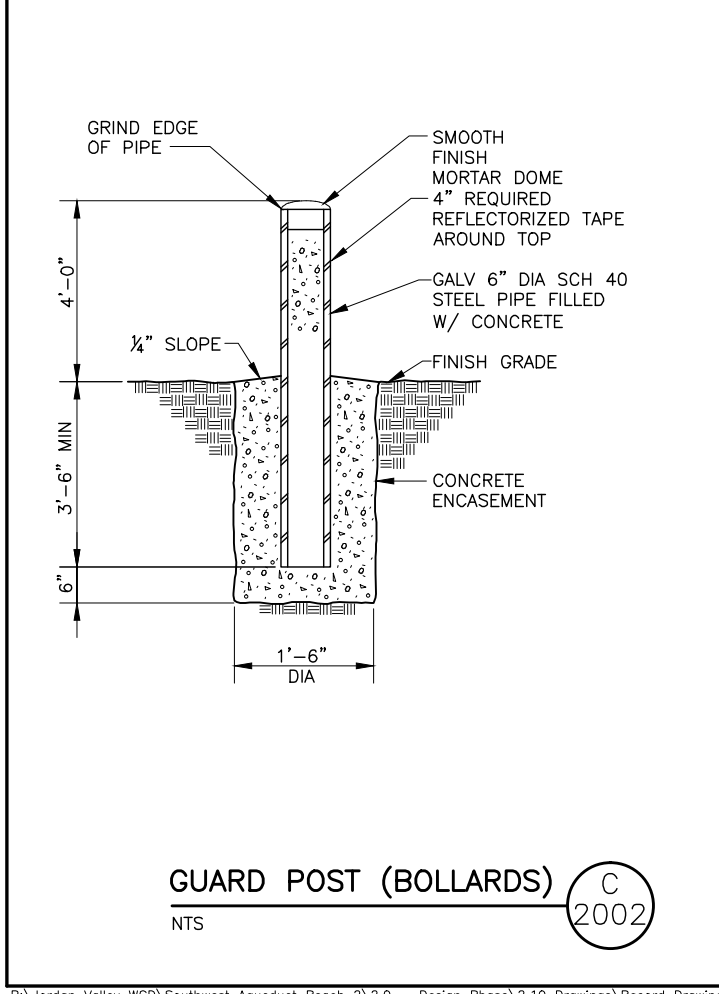

Revisions

NO.	DATE	REV. BY	DESCRIPTION

VERIFY SCALE
BAR IS ONE INCH ON ORIGINAL DRAWING

DESIGN
DESIGN T. OLSEN
DRAW B. ABEL

REVIEW
CHECKED M. COLLINS
APPROVED J. LUETTINGER

CIVIL

SOUTHWEST AQUEDUCT REACH 2 PROJECT


CIVIL DETAILS - 1

DRAWING NO. GC-1

DATE: FEBRUARY 2010

PROJECT 010-08-03


SHEET 55 OF 110

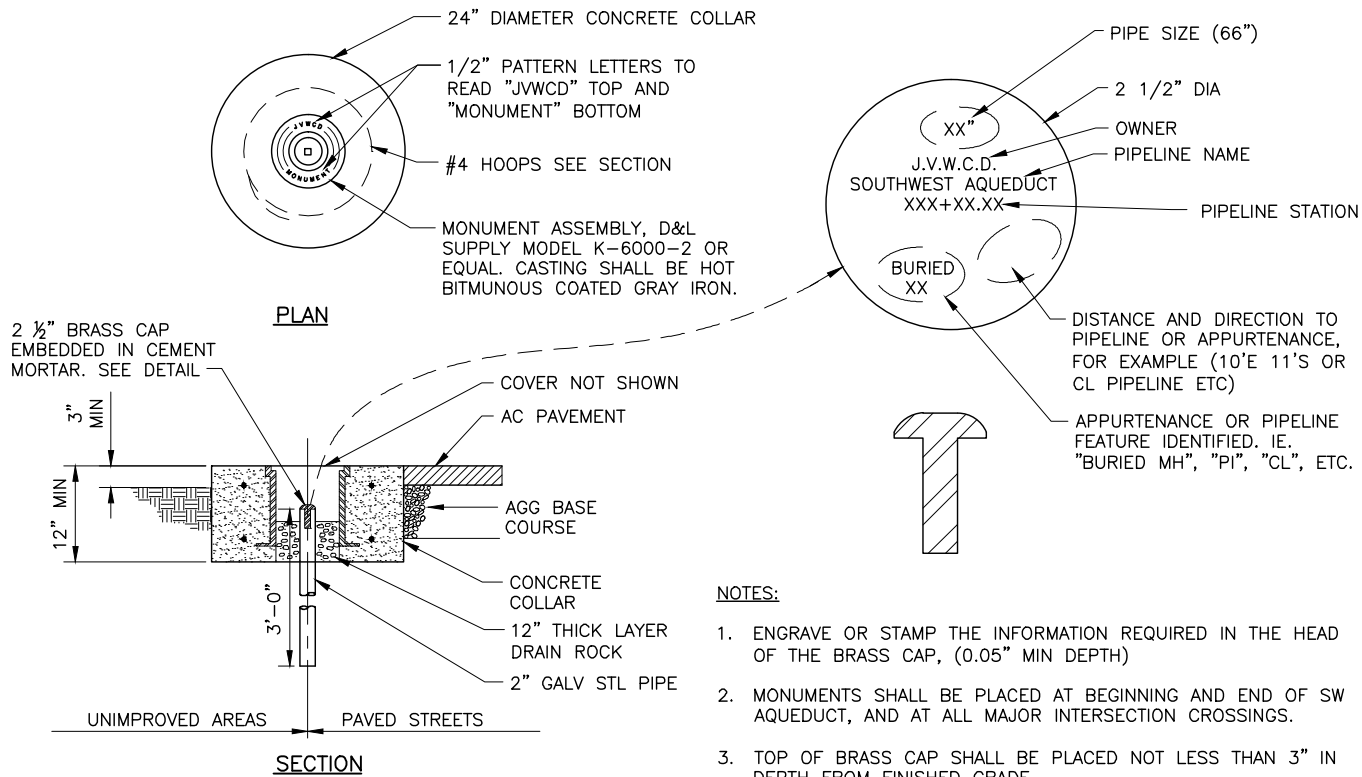

PIPELINE MARKERS

NTS

C
2006

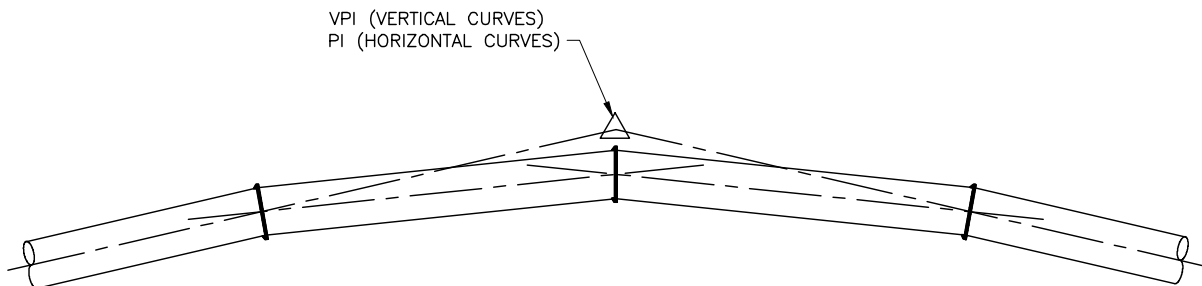


NOTES:

1. ALL HORIZONTAL AND VERTICAL CURVES ARE CIRCULAR.
2. HORIZONTAL AND VERTICAL CURVES SHALL BE MADE USING BEVELED JOINTS AND/OR DEFLECTED JOINTS. DO NOT USE COMBINED BEVELED AND DEFLECTED JOINTS.
3. THE MAXIMUM BEVEL ANGLE FOR BEVELED PIPE ENDS SHALL BE 5 DEGREES. SEE SPECIFICATIONS FOR MAXIMUM (NON-BEVELED) JOINT DEFLECTIONS.
4. ALL BEVEL OR DEFLECTION ANGLES SHALL BE EQUALLY DIVIDED THROUGHOUT THE CURVE.
5. FOR COMBINATION VERTICAL AND HORIZONTAL CURVES THE REQUIREMENTS FOR BOTH CONDITIONS SHALL BE COMBINED.
6. REFER TO PLAN AND PROFILE DRAWINGS FOR VERTICAL AND HORIZONTAL CURVE LOCATIONS.
7. 50' PIPE LENGTHS WERE ASSUMED TO DEVELOP VERTICAL CURVE DATA SHOWN ON PLANS. COORDINATE WITH ENGINEER IF DIFFERENT.

PIPELINE CURVES

NTS

C
2007

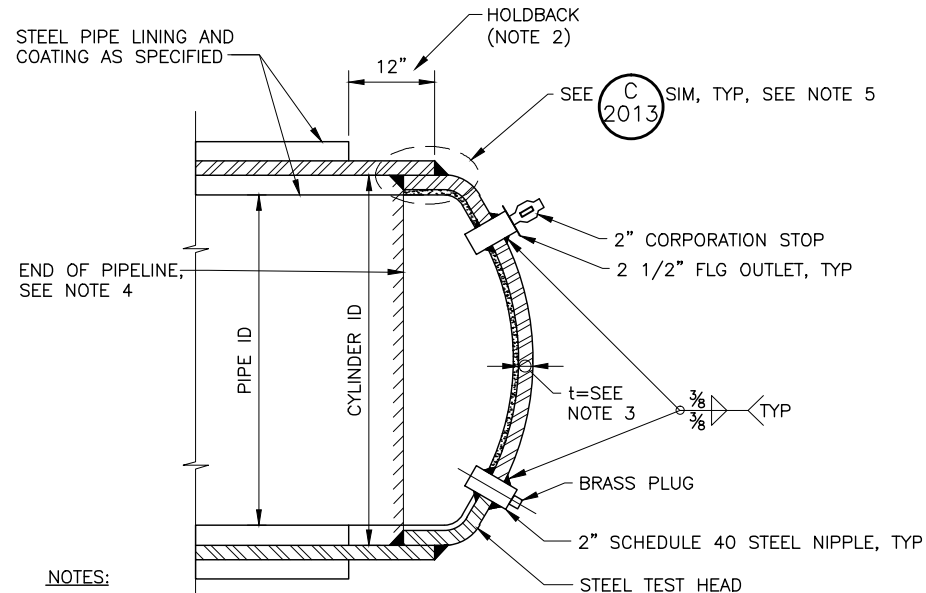


NOTES:

1. COAT TEMPORARY TEST HEAD AND PLAIN END WITH 3 MILS MIN RUST INHIBITING PRIMER. LINE AND COAT IN ACCORDANCE WITH SECTION 09910 WHERE PERMANENT END CAP IS SHOWN ON PLANS.
2. MINIMUM 8" HOLDBACK REQUIRED AFTER TEST HEAD IS CUT OFF.
3. WALL THICKNESS SHALL BE THE SAME AS THE ADJOINING PIPE.
4. SEE DRAWING FOR STATION AND LOCATION OF PIPELINE ENDS.
5. BUTT STRAP CONNECTION, OR FULL PENETRATION BUTT WELDS MAY BE SUBSTITUTED FOR LAP JOINT SHOWN.

DISH HEAD END CAP

NTS

C
2008

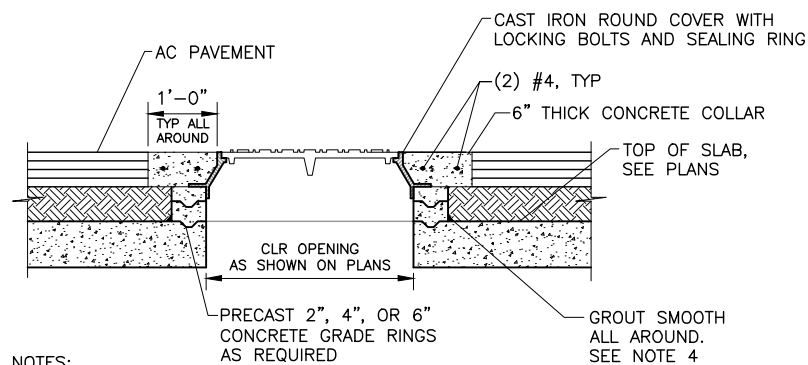

NOTES:

1. SET MANHOLE COVER AND CONCRETE COLLAR 1/4" BELOW GRADE IN PAVED AREAS AND FLUSH WITH FINISH GRADE ELSEWHERE.
2. MANHOLE TO INCLUDE "JVWCD" NAME CAST INTO COVER.
3. PROVIDE MANHOLE WARNING BARRIER LABELED: "DANGER, CONFINED SPACE PERMIT REQUIRED FOR ENTRY"
4. ECOBASE II WATERPROOFING MEMBRANE PRODUCT OR EQUAL ON TOP EXTERIOR OF BURIED WALLS AND TOP OF CONCRETE STRUCTURE. APPLY MEMBRANE AROUND SIDES OF MANHOLE GRADE RINGS TO CREATE A WATERTIGHT SEAL TO TOP OF STRUCTURE.

MANHOLE COVER AND GRADE RINGS

NTS

C
2009

RECORD DRAWINGS

Revisions Drawn by S. Riggs Date November 2011

THESE RECORD DRAWINGS HAVE BEEN PREPARED, IN PART, ON THE BASIS OF INFORMATION COMPILED BY OTHERS. THEY ARE NOT INTENDED TO REPRESENT IN DETAIL THE EXACT LOCATION, TYPE OF COMPONENT NOR MANNER OF CONSTRUCTION. THE ENGINEER WILL NOT BE RESPONSIBLE FOR ANY ERRORS OR OMISSIONS WHICH HAVE BEEN INCORPORATED INTO THE RECORD DRAWINGS.




REVISIONS			
NO.	DATE	REV. BY	DESCRIPTION

JORDAN VALLEY WATER CONSERVANCY DISTRICT SOUTHWEST AQUEDUCT REACH 2 PROJECT			
DESIGN	REVIEW	CHECKED	APPROVED
T. OLSEN	M. COLLINS	J. LUTTINGER	
B. ABEL			

CIVIL CIVIL DETAILS - 2			
DATE: FEBRUARY 2010	PROJECT NUMBER: 010-08-03		

DRAWING NO.
GC-2
SHEET 56 OF 110

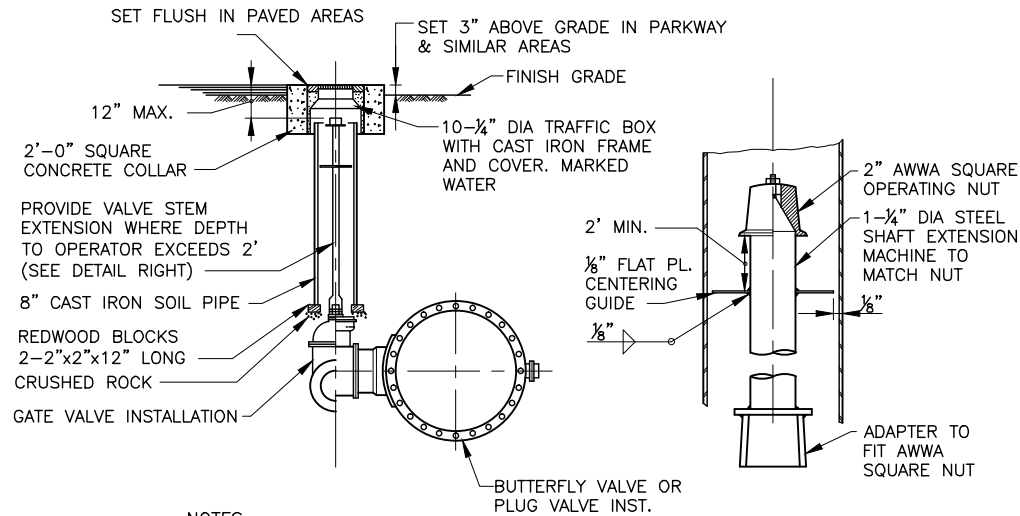


NOTES:

1. PROVIDE PROTECTIVE COATING TO EXTERIOR SURFACE OF VALVE BODY IN ACCORDANCE WITH SPECS.
2. FOR LUBRICATED PLUG VALVE, EXTEND LUBRICATION LINE TO GRADE PER MANUFACTURES INSTRUCTIONS.
3. LOCK VALVE EXTENSION TO NUT.
4. COAT INTERIOR AND EXTERIOR OF CAST IRON SOIL PIPE AS SPECIFIED.

BURIED VALVE INSTALLATION

NTS

C
2010

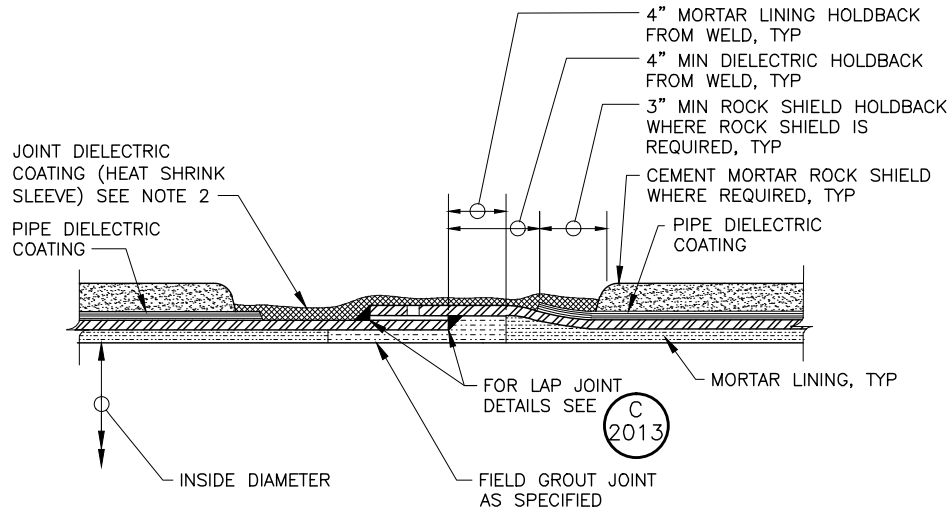


NOTES:

1. CONTRACTOR SHALL CONDUCT AN AIR/SOAP SOLUTION LEAK TEST AT 40 PSI AIR PRESSURE IN ADDITION TO DYE PENETRANT OR MAGNETIC PARTICLE TESTING PERFORMED BY THE ENGINEER. IF LEAKS ARE DETECTED, THE CONTRACTOR SHALL REPAIR AND RETEST THE WELDS UNTIL THERE ARE NO DEFECTS. PLUG TAPS WITH THREADED OR WELDED PLUG AT COMPLETION OF TEST AND COAT AND LINE AS SHOWN OR SPECIFIED. TAP HOLES MAY BE ON INSIDE OR OUTSIDE OF JOINT.
2. AFTER INSTALLATION OF JOINT DIELECTRIC COATING, A HOLIDAY TEST SHALL BE COMPLETED AS SPECIFIED BY NACE CERTIFIED SPECIALIST.

MORTAR LINED AND MORTAR COATED STEEL PIPE JOINT

NTS

C
2011

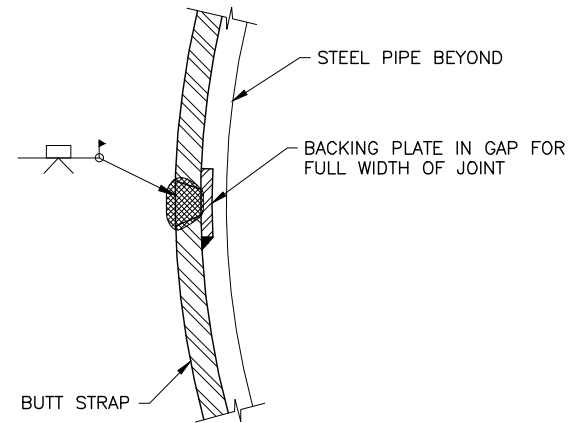


NOTES:

1. LININGS AND COATINGS ARE NOT SHOWN FOR CLARITY.
2. BEVEL ENDS OF BACKING PLATE AT BUTT STRAP PRIOR TO WELDING OR BACK GOUGE AT CONTACT WITH ADJACENT CYLINDER PRIOR TO COMPLETING INSIDE FILLET WELD.

BUTT STRAP SPLICE

NTS

C
2012

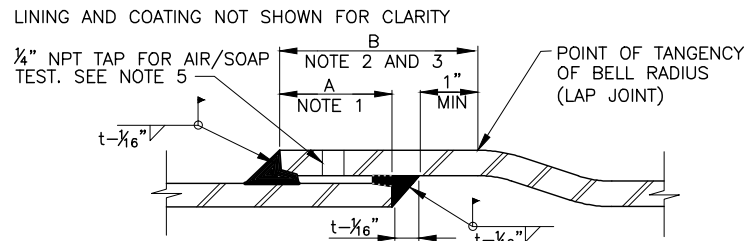


NOTES:

1. DIMENSION "A" CORRESPONDS TO THE COMPLETED JOINT OVERLAP AFTER WELDING. DIMENSION "A" SHALL BE THE GREATER OF 3" OR 5t, MINIMUM FOR STANDARD JOINTS. FOR SPECIAL TEMPURATURE CONTROL JOINTS, THE DIMENSION "A" JOINT OVERLAP SHALL BE INCREASED BY 3 INCHES AS FURTHER DISCUSSED IN NOTE 3.
2. FOR STANDARD JOINTS THE MINIMUM DIMENSION "B" SHALL BE AS REQUIRED TO PROVIDE THE MINIMUM OVERLAP DIMENSION "A" AND MAINTAIN THE INDICATED HOLDBACK FOR THE WELD.
3. FOR SPECIAL TEMPURATURE CONTROL JOINTS, THE MINIMUM DIMENSION "B" SHALL BE INCREASED BY AT LEAST 3 INCHES. AT THE TIME OF INSTALLATION AND PROIR TO WELDING, THE SPIGOT SHALL BE INSERTED INTO THE LENGTHENED BELL TO PROVIDE "A" +3 INCHES MINIMUM JOINT OVERLAP. SEE SPECIFICATIONS SECTION 02570 FOR SPECIAL TEMPERATURE CONTROL JOINT WELDING REQUIREMENTS.
4. FILLET WELDS FOR BELL AND SPIGOT LAP JOINTS SHOWN. FILLET WELDS ON OTHER JOINTS SIMILAR.
5. CONTRACTOR SHALL CONDUCT AN AIR/SOAP SOLUTION LEAK TEST AT 40 PSI AIR PRESSURE IN ADDITION TO DYE PENETRANT OR MAGNETIC PARTICLE TESTING PERFORMED BY THE ENGINEER. IF LEAKS ARE DETECTED, REPAIR AND RETEST THE WELDS UNTIL THERE ARE NO DEFECTS. PLUG HOLES WITH THREADED OR WELDED PLUG AT COMPLETION OF TEST AND COAT AS SHOWN. TAP HOLES MAY BE ON INSIDE OR OUTSIDE OF JOINT.
6. THE JOINTS SHALL BE FABRICATED AND INSTALLED TO BE WITHIN THE TOLERANCES INDICATED. THE TOLERANCE REQUIREMENTS SHALL APPLY TO BOTH WELDS AND TO BOTH STRAIGHT AND DEFLECTED JOINTS.
7. LAP JOINTS SHALL BE SINGLE LAP, UNLESS NOTED OTHERWISE. SINGLE LAP JOINTS SHALL BE INSIDE OR OUTSIDE AT CONTRACTORS OPTION. REFER TO SECTION 02570 FOR SPECIAL REQUIREMENTS.

LAP JOINT WELD

NTS

C
2013

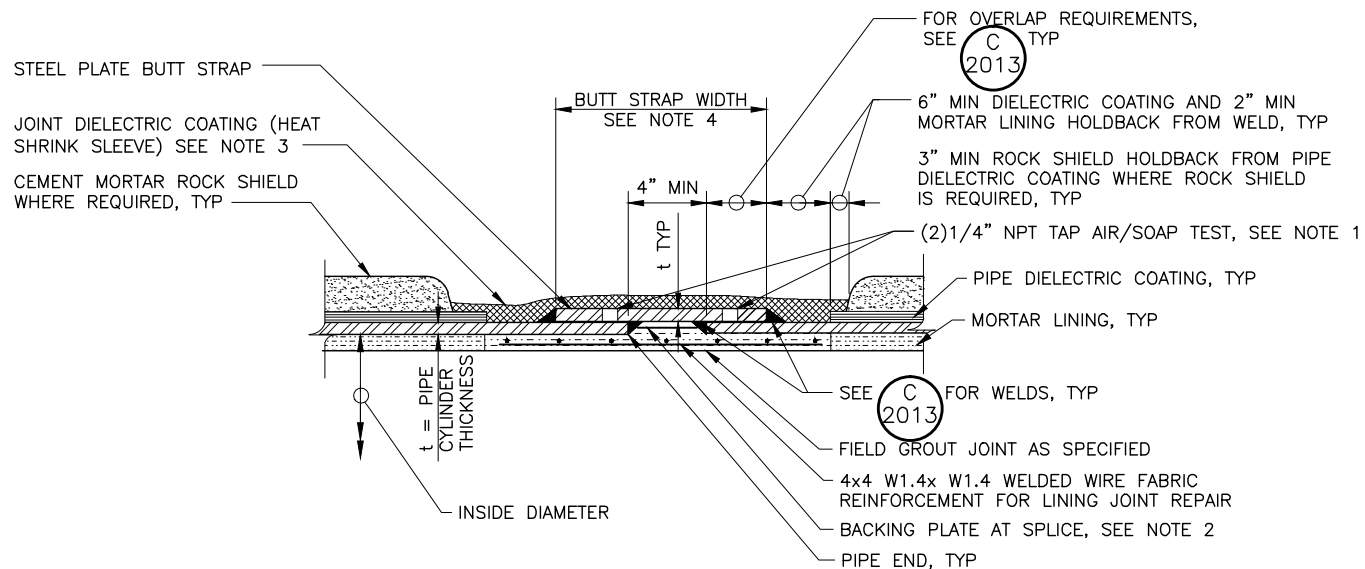

NOTES:

1. CONTRACTOR SHALL CONDUCT AN AIR/SOAP SOLUTION LEAK TEST AT 40 PSI AIR PRESSURE IN ADDITION TO DYE PENETRANT OR MAGNETIC PARTICLE TESTING PERFORMED BY THE ENGINEER. IF LEAKS ARE DETECTED, THE CONTRACTOR SHALL REPAIR AND RETEST THE WELDS UNTIL THERE ARE NO DEFECTS. PLUG TAPS WITH THREADED OR WELDED PLUG AT COMPLETION OF TEST AND COAT AND LINE AS SHOWN OR SPECIFIED. TAP HOLES MAY BE ON INSIDE OR OUTSIDE OF JOINT.
2. FOR FIELD WELDING OF INDIVIDUAL BUTT STRAP PIECES TO EACH OTHER USING BUTT WELDS, SEE C 2012
3. AFTER INSTALLATION OF JOINT DIELECTRIC COATING, A HOLIDAY TEST SHALL BE COMPLETED AS SPECIFIED BY NACE CERTIFIED SPECIALIST.
4. UNLESS OTHERWISE NOTED, BUTT STRAP WIDTH SHALL CONFORM TO THE LIMITATIONS SHOWN FOR PIPE END SEPARATION AND STEEL OVERLAP REQUIREMENTS.

BUTT-STRAP JOINT


NTS

C
2014

RECORD DRAWINGS

Revisions Drawn by S. Riggs Date November 2011

THESE RECORD DRAWINGS HAVE BEEN PREPARED, IN PART, ON THE BASIS OF INFORMATION COMPILED BY OTHERS. THEY ARE NOT INTENDED TO REPRESENT IN DETAIL THE EXACT LOCATION, TYPE OF COMPONENT NOR MANNER OF CONSTRUCTION. THE ENGINEER WILL NOT BE RESPONSIBLE FOR ANY ERRORS OR OMISSIONS WHICH HAVE BEEN INCORPORATED INTO THE RECORD DRAWINGS.

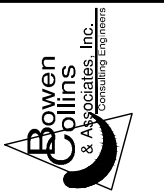

JORDAN VALLEY WATER CONSERVANCY DISTRICT
SOUTHWEST AQUEDUCT REACH 2 PROJECT

CIVIL
CIVIL DETAILS - 3

DRAWING NO. GC-3

SHEET 57 OF 110

VERIFY SCALE
BAR IS ONE INCH ON ORIGINAL DRAWING

REVIEW
CHECKED M. COLLINS
APPROVED J. LUETTINGER

DESIGN
DESIGN T. OLSEN
DRAWN B. ABEL

DATE: FEBRUARY 2010 PROJECT NUMBER 010-08-03


REVISIONS

DESCRIPTION


REV. BY

DATE


NO.

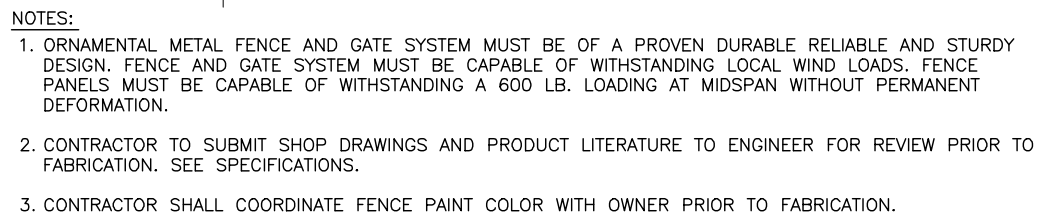

NTS

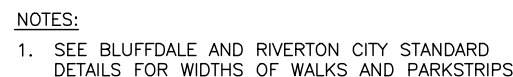


NTS

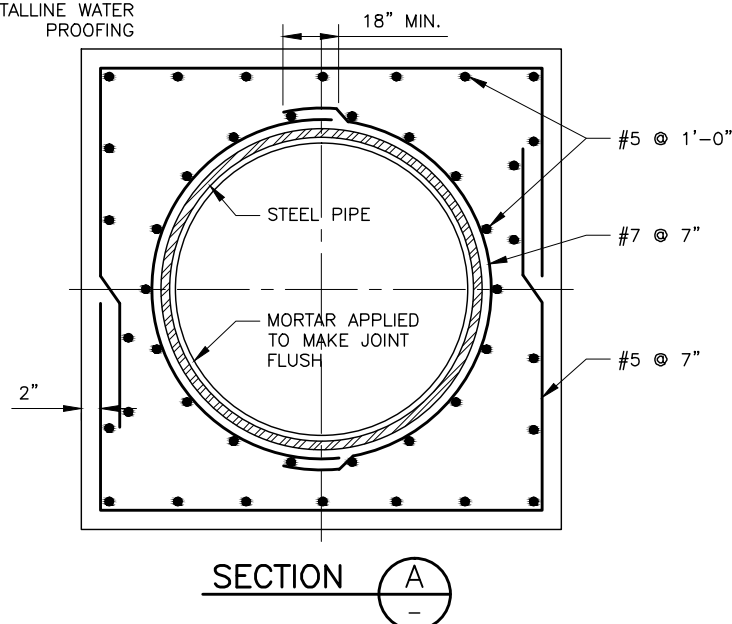

NTS



1. CONTRACTOR MAY SUBMIT ALTERNATIVE DESIGNS FOR APPROVAL.
2. TAPER BETWEEN DIAMETER AT JOINT AND NEW STEEL PIPE DIAMETER AT 7-1/2 DEGREE ANGLE.
3. TEMPORARY STRUTS AND CROSS BRACING SHALL REMAIN IN PLACE TO HOLD STEEL PIPE ROUND AND IN PLACE DURING CONCRETE ENCASEMENT AND WELDING OF JOINTS.
4. CONCRETE PIPE SHALL BE CUT FLUSH USING DIAMOND SAW OR OTHER METHOD TO ENSURE A SMOOTH EVEN CUT. STEEL PIPE SHALL BE BUTTED UP TO THE SAWCUT JOINT.
5. THE MINIMUM STEEL CYLINDER THICKNESS FOR CLOSURE SECTIONS SHALL CONFORM TO THAT GIVEN IN SPECIFICATIONS OF THE ADJACENT PIPE.
6. TRANSITIONS FROM CONCRETE PIPE TO LARGER DIAMETER STEEL PIPE SHALL BE SIMILAR. TRANSITION SHALL NOT TAKE PLACE AT THE JOINT, BUT SHALL BE FABRICATED AS A NEW STEEL PIPE REDUCER LOCATED IMMEDIATELY ADJACENT TO THE CONNECTION.
7. POLYURETHANE COAT CONCRETE ENCASED PIPE AND END OF PIPE TO PREVENT ELECTRICAL CONTACT WITH RCP OR CONCRETE REINFORCEMENT. BUTT WSP CYLINDER AGAINST EXISTING RCP.
8. TROWEL GROUT FINISHED JOINT GAP WITH CRYSTALLINE WATER PROOFING MIXED WITH GROUT.

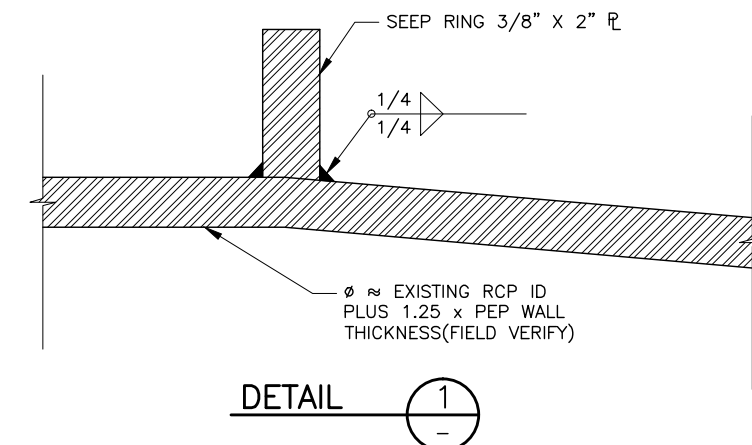


1. WHERE NEW CONCRETE COLLAR IS CONSTRUCTED ADJACENT TO TRIFURCATION STRUCTURE, DOWEL AND EPOXY #5 REINFORCED INTO EXISTING CONCRETE.

1. EXPANSION JOINTS OF 1/2" PREMOLDED JOINT FILLER SHALL BE PLACED 1/4" BELOW FINISHED SURFACE OF CONCRETE.
2. DEPTH OF CONTROL JOINTS SHALL BE APPROXIMATELY ONE QUARTER OF CONCRETE SLAB THICKNESS, BUT NOT LESS THAN 1".
3. ALL EXPOSED SURFACES OF CURB SHALL BE GIVEN A MORTAR BRUSH COAT CONSISTING OF ONE PART PORTLAND CEMENT, ONE PART SAND AND THEN TROWELED SMOOTH.

Revisions Drawn by S. Riggs Date November 2011

THESE RECORD DRAWINGS HAVE BEEN PREPARED, IN PART, ON THE BASIS OF INFORMATION COMPILED BY OTHERS. THEY ARE NOT INTENDED TO REPRESENT IN DETAIL THE EXACT LOCATION, TYPE OF COMPONENT NOR MANNER OF CONSTRUCTION. THE ENGINEER WILL NOT BE RESPONSIBLE FOR ANY ERRORS OR OMISSIONS WHICH HAVE BEEN INCORPORATED INTO THE RECORD DRAWINGS.

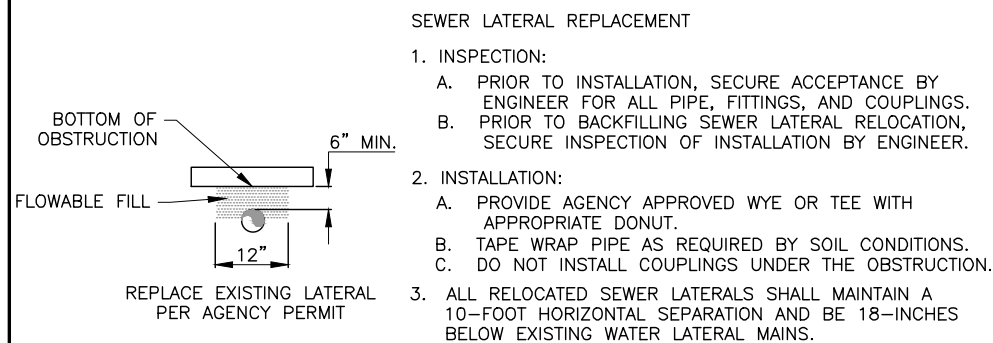

NTS


©
2019



1. MANHOLE BASE AND ALL SECTIONS SHALL BE PRECAST TO CONFORM TO ASTM C478.


NTS

©
2021

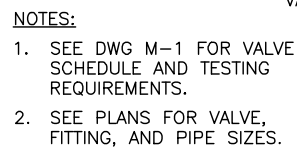

NTS

©
2022

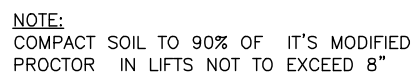

NTS

© 202

WALL THICKNESS (T)	
SMH DIA	T (INCHES)
4'	5"
5'	6"
6'	7"




1. INVERTS D1, D2 AND D3 SHALL MATCH THOSE SHOWN IN PLANS.
2. IF MANHOLE IS TO BE POURED IN PLACE, FOLLOW SAME PATTERN AS SHOWN EXCEPT USE 10" MIN WALL THICKNESS.
3. SET MANHOLE FRAME AND COVER TO 1/8" BELOW FINISH GRADE AFTER FINAL STREET GRADING IS COMPLETE.
4. CONE AND WALL SECTIONS TO CONFORM TO ASTM C-478
5. PLUG OUTLET OF DOWNSTREAM MANHOLE UNTIL CONSTRUCTION IS COMPLETE.
6. PIPES D1, D2 AND D3 SHALL BE CONNECTED TO MANHOLE USING PRESS-SEAL 545 PSX CONNECTORS.
7. SET MANHOLE ON FIRM, STABLE, DRY BASE. ENSURE GROUNDWATER IS REMOVED TO A MIN. DEPTH OF 12" BELOW THE BOTTOM OF EXCAVATION.
8. IF NATIVE SOILS AT BOTTOM OF EXCAVATION AREA ARE SOFT, DISTURBED OR OTHERWISE UNSUITABLE, OVEREXCAVATE TO A DEPTH OF 12" AND BACKFILL WITH STABILIZATION GRAVEL.

NTS

©
2020

Revisions Drawn by S. Riggs Date November 2011

THESE RECORD DRAWINGS HAVE BEEN PREPARED, IN PART, ON THE BASIS OF INFORMATION COMPILED BY OTHERS. THEY ARE NOT INTENDED TO REPRESENT IN DETAIL THE EXACT LOCATION, TYPE OF COMPONENT NOR MANNER OF CONSTRUCTION. THE ENGINEER WILL NOT BE RESPONSIBLE FOR ANY ERRORS OR OMISSIONS WHICH HAVE BEEN INCORPORATED INTO THE RECORD DRAWINGS.

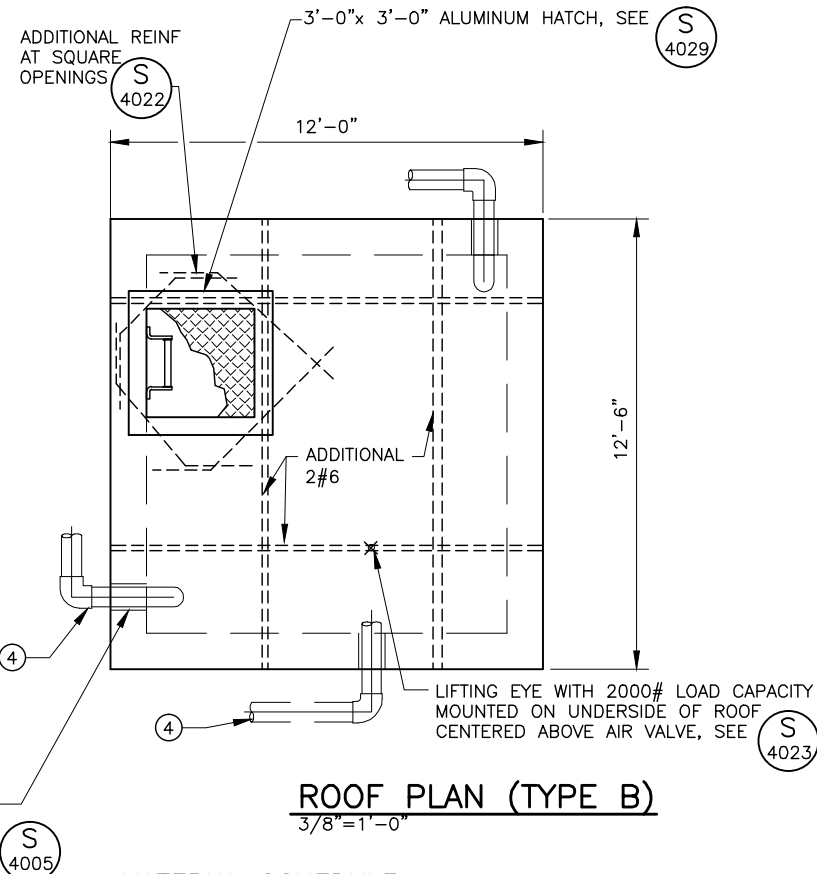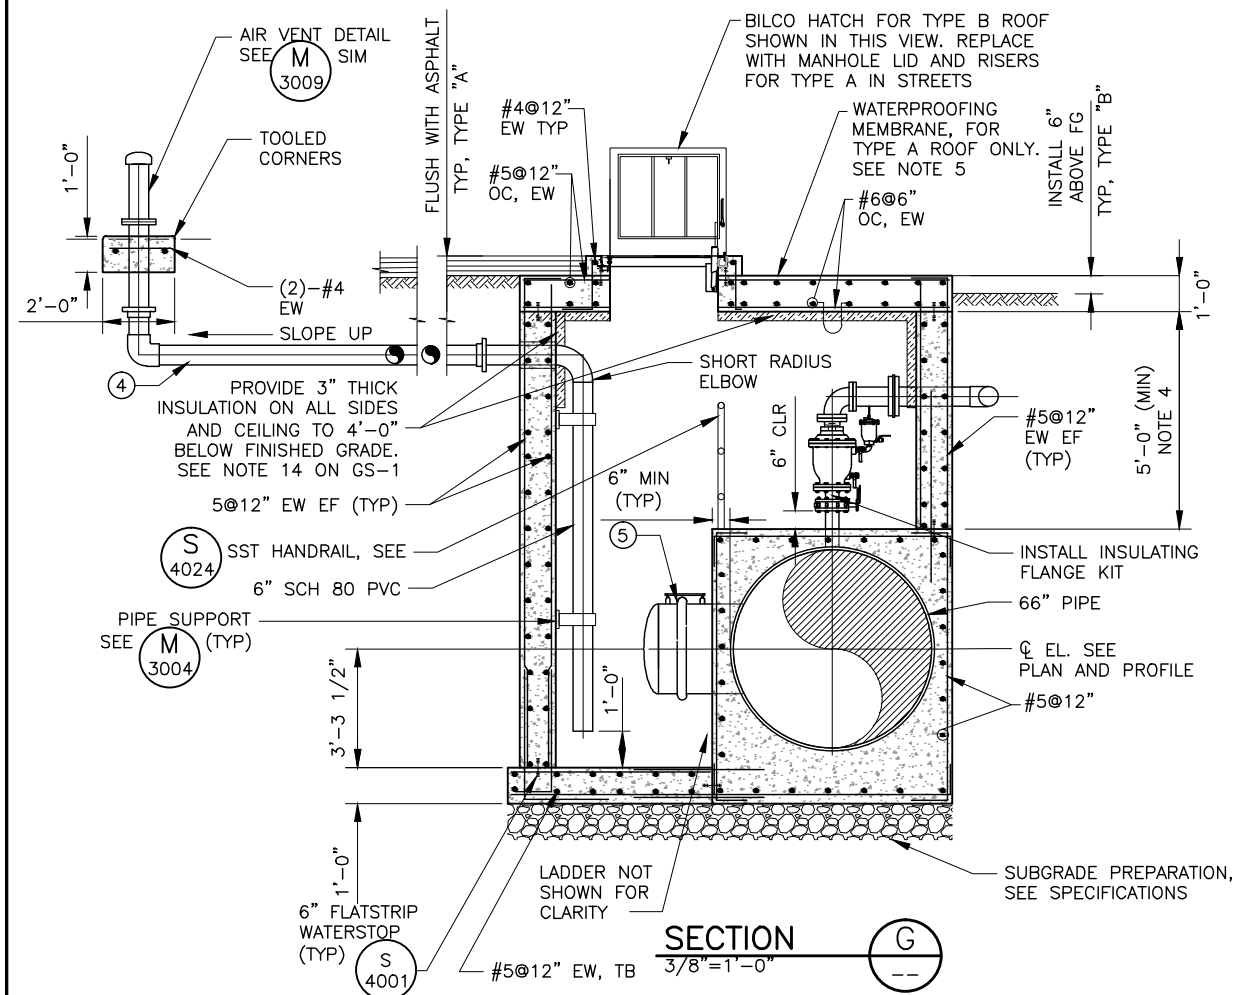
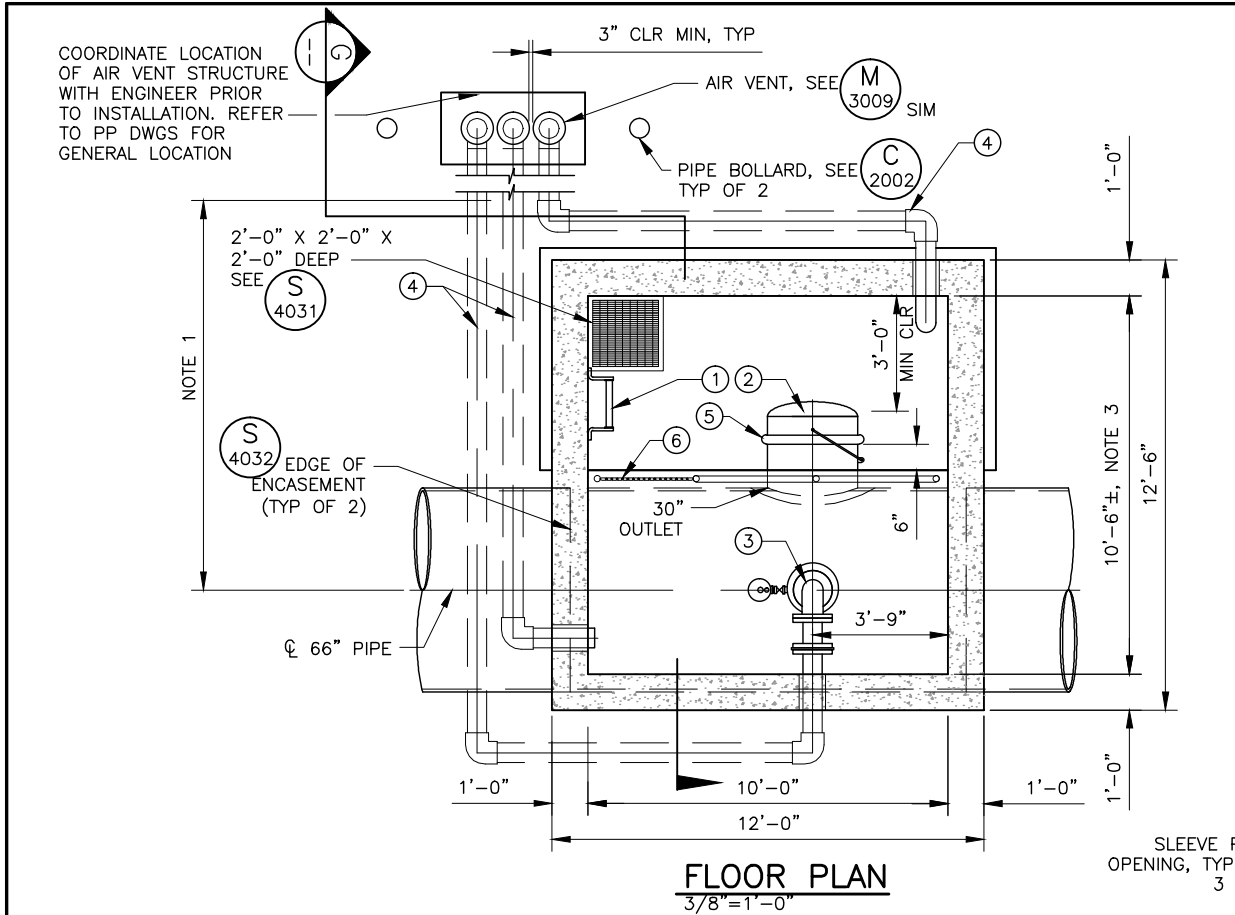


MATERIAL SCHEDULE

- SST LADDER (TYP) WITH SAFETY CLIMB DEVICE CENTERED IN OPENING, SEE S 4026
- 30" HINGED ACCESS MANWAY, SEE M 3013
- 6" COMBINATION AIR VALVE WITH INTEGRAL LOW PROFILE BUTTERFLY ISOLATION. SEE MECHANICAL SCHEDULE AND M 3001
- 6" SCH 80 PVC VENT PIPE.
- 30" RESTRAINED GROOVED END COUPLING.
- SAFETY CHAIN, SEE S 4036

NOTES:





- LENGTH AND CONFIGURATION FOR PIPING PER DETAILS SHOWN ON PP DWGS. CONTRACTOR TO PROVIDE PIPING AND FITTINGS AS REQUIRED TO INSTALL VENT PIPING BEHIND SIDEWALK AS SHOWN ON PLANS.
- PROVIDE CONFINED SPACE ENTRY WARNING BARRIER AT MANHOLE ENTRANCE. BARRIER LABEL SHALL READ "DANGER, CONFINED SPACE PERMIT REQUIRED FOR ENTRY"
- PROVIDE 3'-0" MINIMUM CLEARANCE BEYOND EDGE OF ACCESS MANWAY. ADJUST WIDTH OF VAULT IF NECESSARY BASED UPON FIELD LOCATION OF 66" PIPE.
- NOTIFY ENGINEER IMMEDIATELY IF DIMENSIONAL CONFLICT ARISES BETWEEN VAULT AND CONTRACTOR SUPPLIED CARV. ADJUSTMENT WILL BE MADE DURING SHOP DRAWING REVIEW IF NECESSARY.
- APPLY ECOBASE II WATERPROOFING MEMBRANE PRODUCTS OR EQUAL ON EXTERIOR OF BURIED WALLS AND TOP OF CONCRETE STRUCTURE. APPLY MEMBRANE AROUND SIDES OF VAULT AND AROUND MANHOLE GRADE RINGS AND COVERS TO CREATE A WATERTIGHT SEAL TO TOP OF STRUCTURE.
- THE AIR VALVE MANWAY IS CLASSIFIED AS A HIGHLY-CORROSIVE ENVIRONMENT. ALL METAL FABRICATIONS AND HARDWARE SHALL CONFORM TO THE REQUIREMENTS OF SECTION 05500 - MISCELLANEOUS METALS. ALL PROTECTIVE COATINGS SHALL CONFORM TO THE REQUIREMENTS OF SECTION 09900 - COATING AND PAINTING.
- ALL MISCELLANEOUS METAL FABRICATIONS AND HARDWARE SHALL BE STAINLESS STEEL.
- ALL FLANGE HARDWARE, INCLUDING BOLTS, NUTS, AND WASHERS, SHALL BE CARBON STEEL, ASTM A307 GRADE A AND COATED IN ACCORDANCE WITH SECTION 09900 - PAINTING.
- SEE DWG M-1 FOR AIR VALVE SCHEDULE

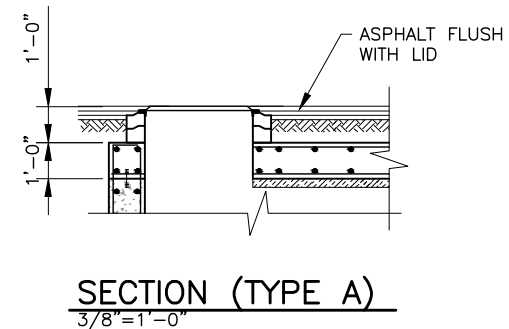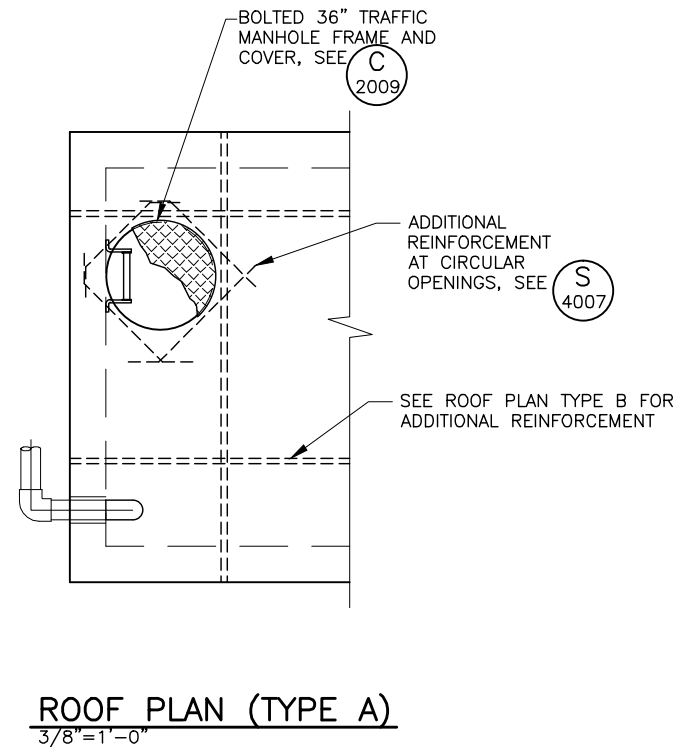

RECORD DRAWINGS


Revisions Drawn by S. Riggs Date November 2011

THESE RECORD DRAWINGS HAVE BEEN PREPARED, IN PART, ON THE BASIS OF INFORMATION COMPILED BY OTHERS. THEY ARE NOT INTENDED TO REPRESENT IN DETAIL THE EXACT LOCATION, TYPE OF COMPONENT NOR MANNER OF CONSTRUCTION. THE ENGINEER WILL NOT BE RESPONSIBLE FOR ANY ERRORS OR OMISSIONS WHICH HAVE BEEN INCORPORATED INTO THE RECORD DRAWINGS.

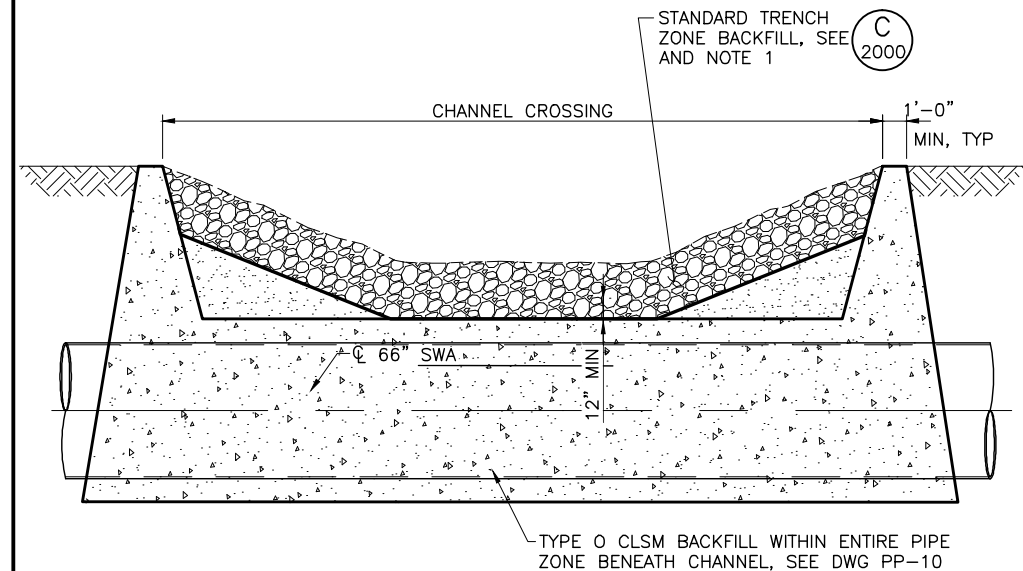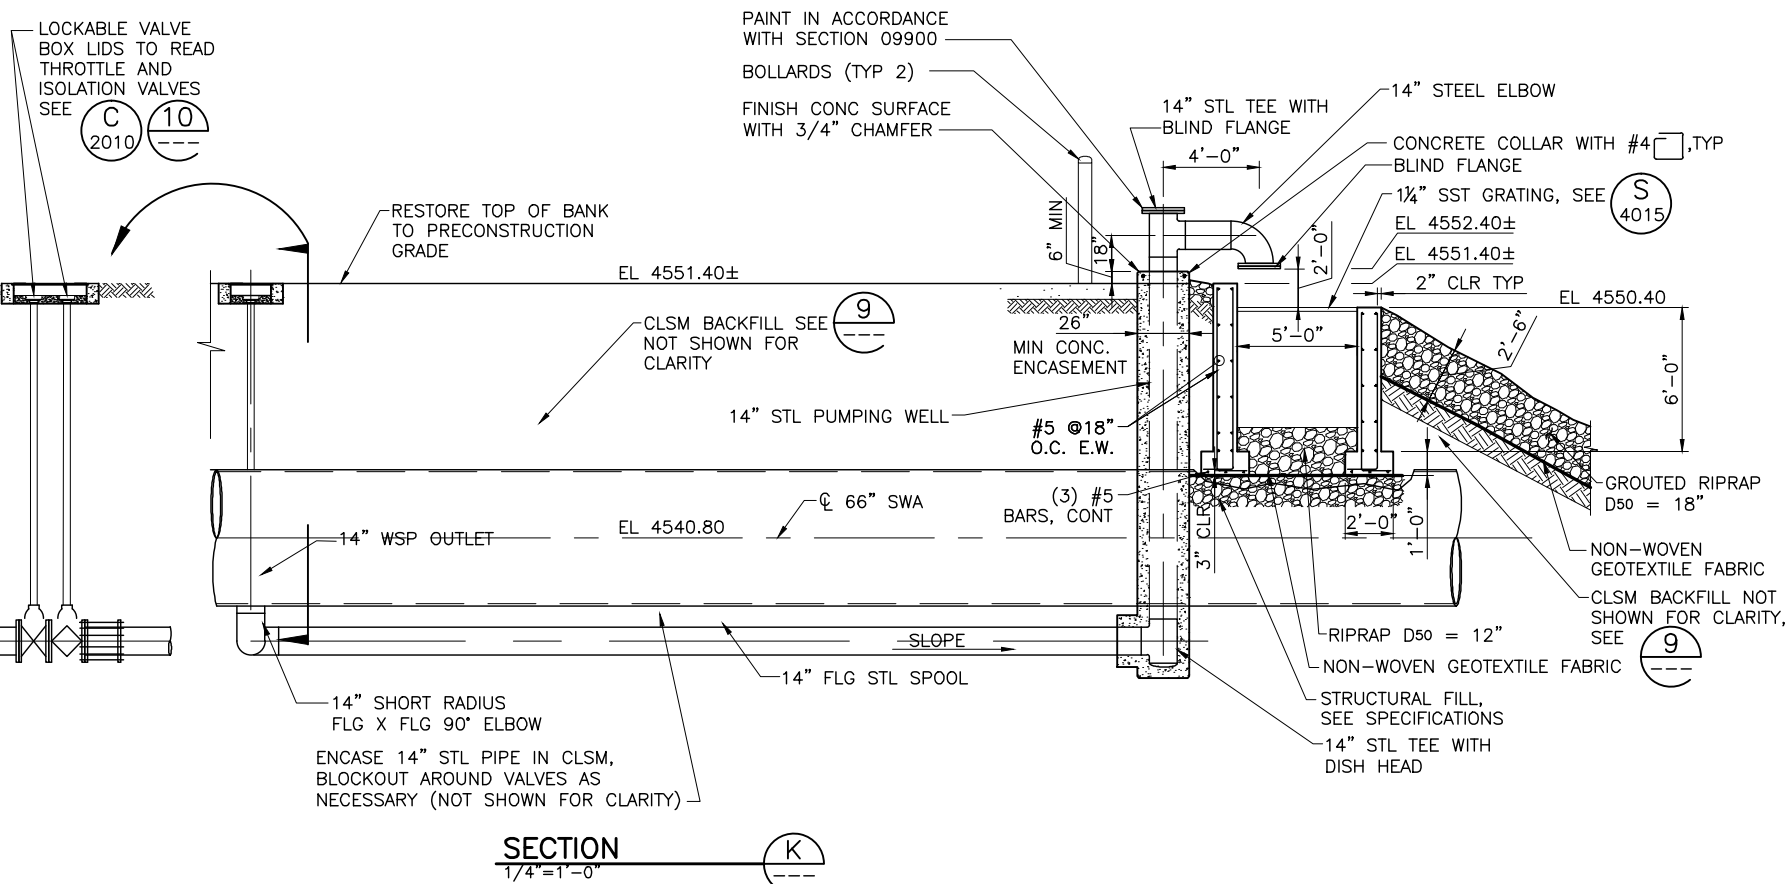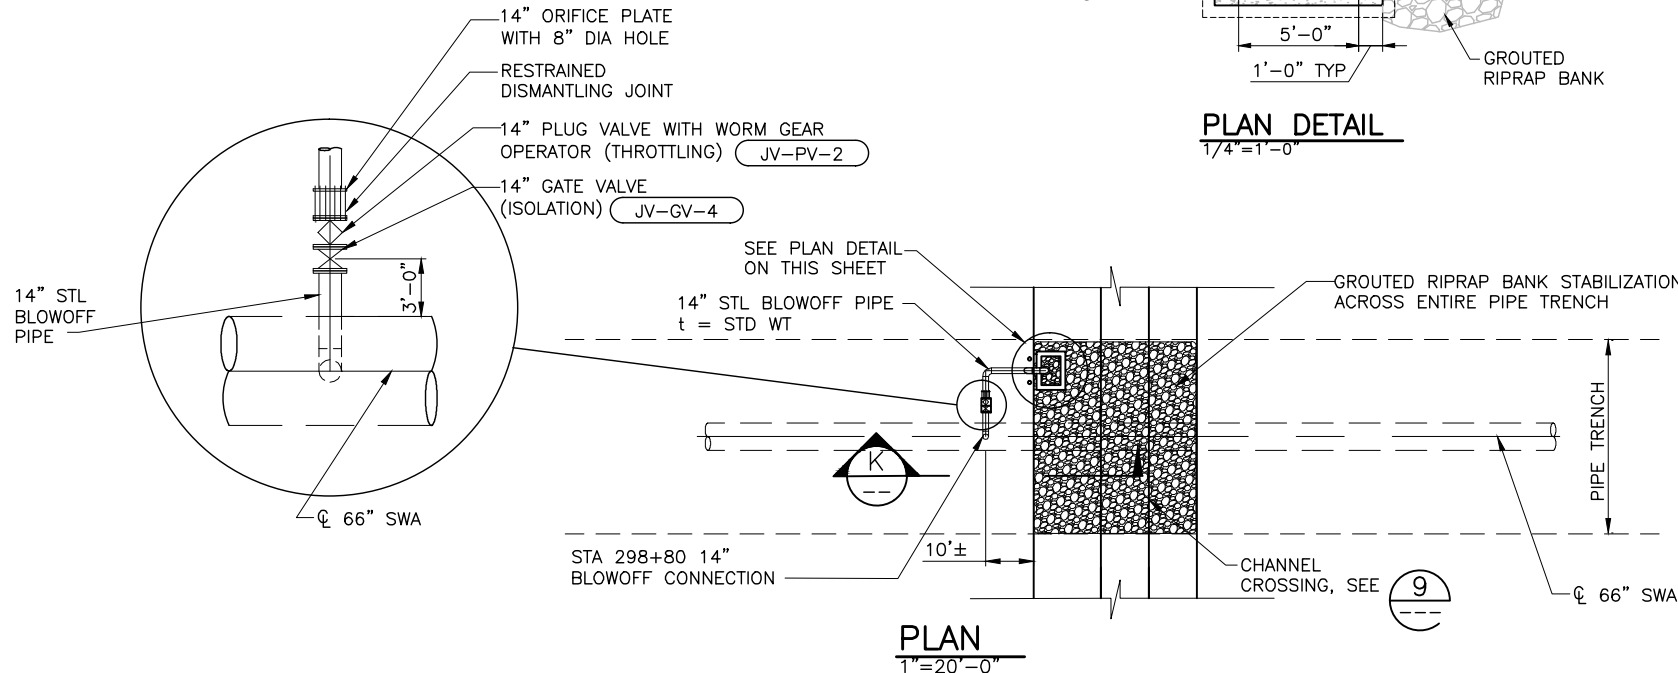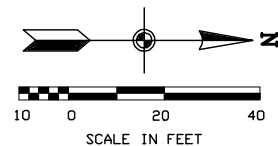

NOTES:
1. STRUCTURAL BACKFILL SHALL BE COMPACTED TO 96% OF MAXIMUM DENSITY (ASTM D1557) WITHIN ALL AREAS OF CHANNEL EMBANKMENT DISTURBED BY CONSTRUCTION.

CHANNEL CROSSING 9
1/4"=1'-0"

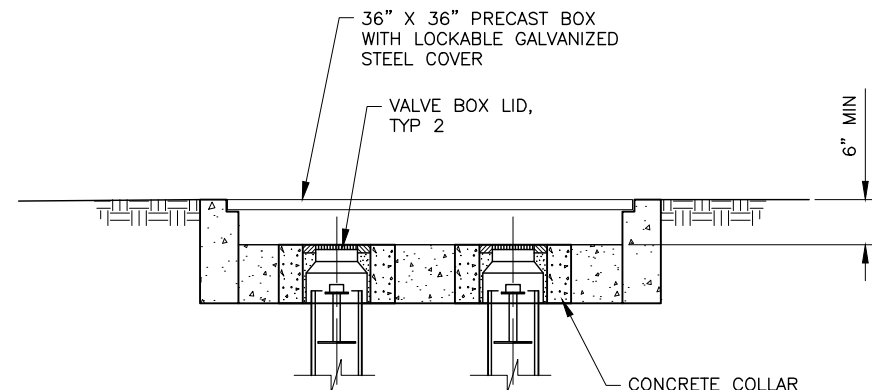

LOCKABLE VALVE BOX 10
NTS

RECORD DRAWINGS

Revisions Drawn by S. Riggs Date November 2011
THESE RECORD DRAWINGS HAVE BEEN PREPARED, IN PART, ON THE BASIS OF INFORMATION COMPILED BY OTHERS. THEY ARE NOT INTENDED TO REPRESENT IN DETAIL THE EXACT LOCATION, TYPE OF COMPONENT NOR MANNER OF CONSTRUCTION. THE ENGINEER WILL NOT BE RESPONSIBLE FOR ANY ERRORS OR OMISSIONS WHICH HAVE BEEN INCORPORATED INTO THE RECORD DRAWINGS.




JORDAN VALLEY WATER CONSERVANCY DISTRICT
SOUTHWEST AQUEDUCT REACH 2 PROJECT

CIVIL
ROSE CREEK
CROSSING

DRAWING NO.
PA-3
SHEET 62 OF 110

NO.	DATE	REV. BY	DESCRIPTION
1			REVISIONS
2			
3			
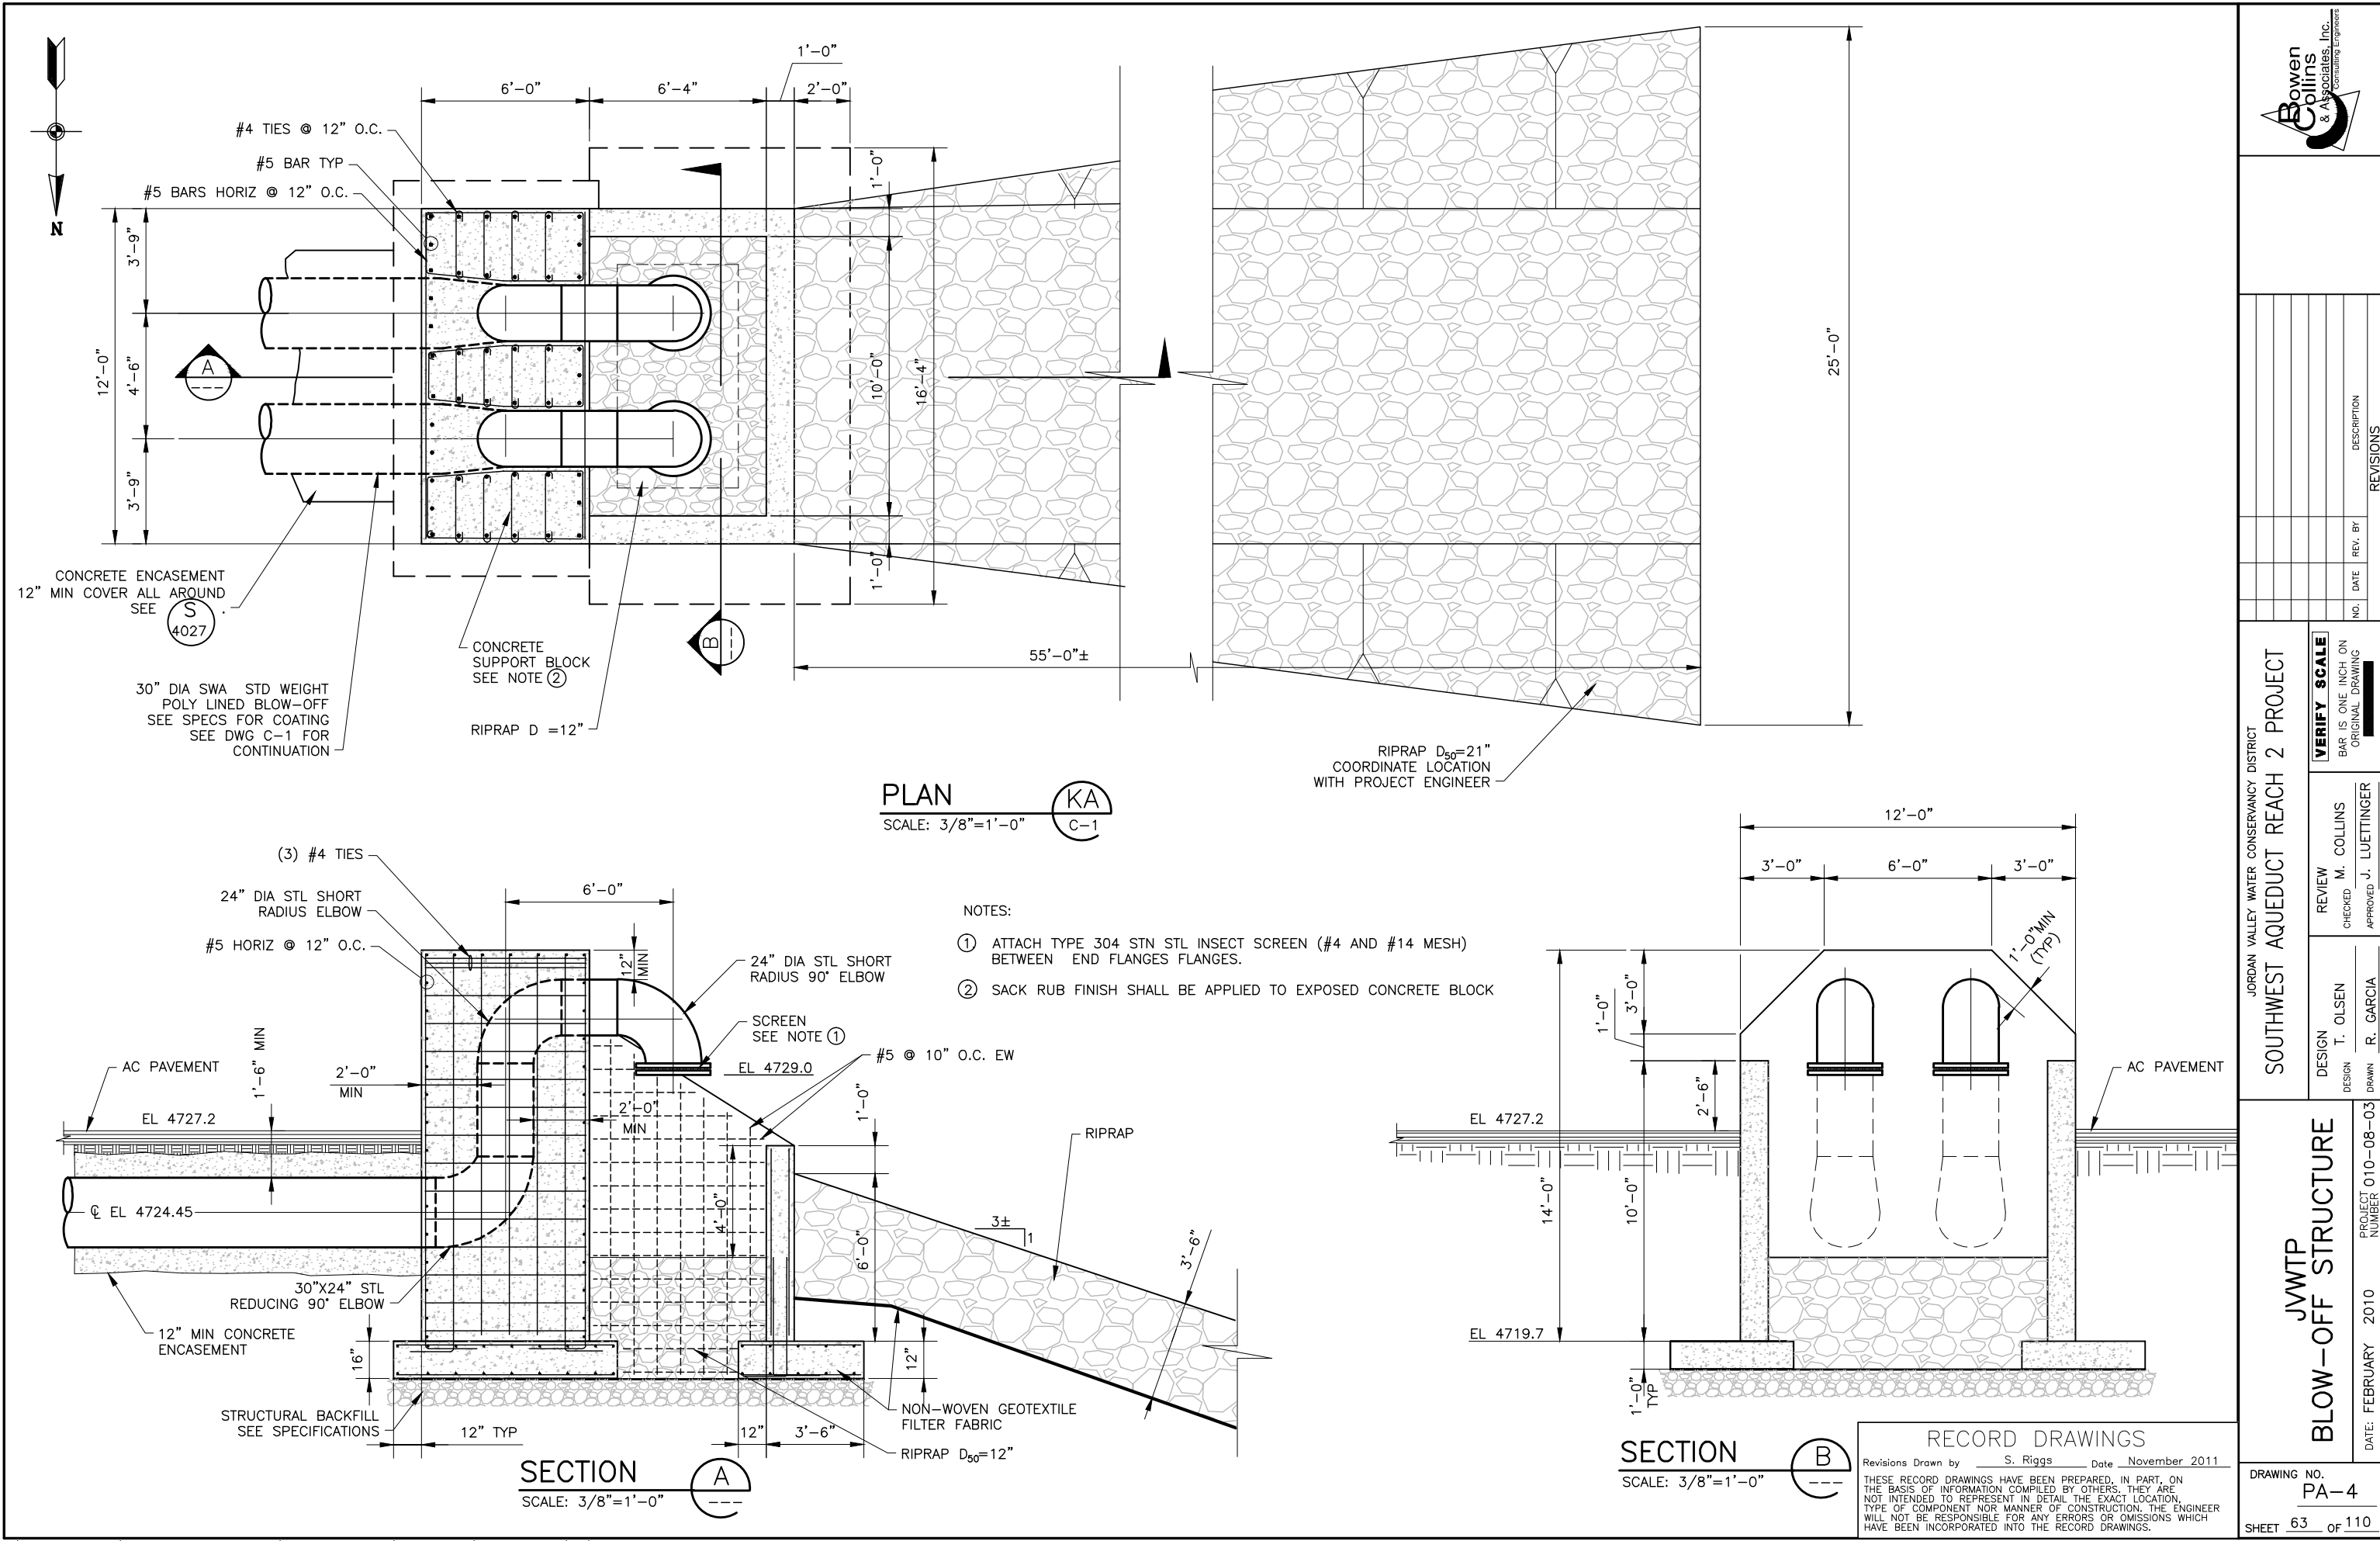

NO.

DATE

REV. BY

DESCRIPTION

REVISIONS

JORDAN VALLEY WATER CONSERVANCY DISTRICT

SOUTHWEST AQUEDUCT REACH 2 PROJECT

VERIFY SCALE

BAR IS ONE INCH ON ORIGINAL DRAWING

REVIEW

CHECKED

DESIGN

DESIGN

APPROVED

SCALE

BAR IS ONE INCH ON ORIGINAL DRAWING

DESIGN

DESIGN

APPROVED

JWTP

BLOW-OFF STRUCTURE

PROJECT NUMBER

DATE

2010

010-08-03

DRAWING NO.

PA-4

SHEET

63

OF

110

MECHANICAL EQUIPMENT SCHEDULE	

AIR VALVE SCHEDULE	
1	1" 150#
2	1" 150#
3	1" 150#
STATION	DRAWING NUMBER	VALVE NUMBER	ELEVATION	WORKING PRESSURE	TEST PRESSURE	AIR VALVE TYPE AND SIZE		APCO MODEL NO. (OR EQUAL)	AIR VALVE VENT PIPE DIAMETER	REMARKS
						CARV	ARV			
JVWTP INTERCONNECTION VAULT	M-2	JV-AV-01	4707.00	10	150		2"	NA	NA	GA INDUSTRIES, ARV- CW-900, NO EQUALS
JVWTP INTERCONNECTION VAULT	M-2	JV-AV-02	4707.00	10	150		2"	NA	NA	GA INDUSTRIES, ARV- CW-900, NO EQUALS
217+63	PP-2	JV-AV-03	4668.00	30	150	6"		1100A	6"	
233+90	PP-4	JV-AV-04	4620.00	50	150	6"		1100A	6"	
277+94	PP-08	JV-AV-05	4551.00	80	150	6"		1100A	6"	
293+88	PP-10	JV-AV-06	4542.00	80	150	6"		1100A	6"	
13400 S. MAINLINE VAULT	M-8	JV-AV-07	4549.25	80	150	10"		1100A	10"	
13400 S. MAINLINE VAULT	M-8	JV-AV-08	4549.25	80	150	10"		1100A	10"	
13400 S. MAINLINE VAULT	M-8	JV-AV-09	4549.25	80	150	6"		1100A	6"	

NOTES:

1. AIR VALVES SHALL BE RATED TO ACCOMMODATE THE SPECIFIED WORKING AND TEST PRESSURES SHOWN AT EACH LOCATION.

VALVE SCHEDULE

VALVE NO.	LOCATION	TYPE	SIZE (IN)	WORKING PRESSURE (PSI)	TEST PRESSURE (PSI)	OPERATOR	VOLTAGE	PHASE	DC BLOCKER REQUIRED (2)
BV 125	NOT USED (FUTURE)								
BV 126	JA-2 INTERCONN. VAULT	BUTTERFLY	72	10	150	ELECTRIC	460	THREE	YES
BV 127	JA-2 INTERCONN. VAULT	BUTTERFLY	72	10	150	ELECTRIC	460	THREE	YES
BV 128	JA-2 INTERCONN. VAULT	BUTTERFLY	78	10	150	ELECTRIC	460	THREE	YES
BV 129	JA-2 INTERCONN. VAULT	BUTTERFLY	78	10	150	ELECTRIC	460	THREE	YES
BV 130	JA-2 INTERCONN. VAULT	BUTTERFLY	12	10	150	MANUAL	NA	NA	NO
BV 131	JA-2 INTERCONN. VAULT	BUTTERFLY	12	10	150	MANUAL	NA	NA	NO
BV 132	JA-2 INTERCONN. VAULT	BUTTERFLY	24	10	150	MANUAL	NA	NA	NO
BV 133	JA-2 INTERCONN. VAULT	BUTTERFLY	24	10	150	MANUAL	NA	NA	NO
JV-BV-1	13400 S. MAINLINE VAULT	BUTTERFLY	8	80	150	MANUAL	NA	NA	NO
JV-BV-2	13400 S. MAINLINE VAULT	BUTTERFLY	8	80	150	MANUAL	NA	NA	NO
JV-BV-3	13400 S. MAINLINE VAULT	BUTTERFLY	8	80	150	MANUAL	NA	NA	NO
JV-BV-4	13400 S. MAINLINE VAULT	BUTTERFLY	36	80	150	ELECTRIC	460	THREE	YES
JV-BV-5	13400 S. MAINLINE VAULT	BUTTERFLY	48	80	150	ELECTRIC	460	THREE	YES
JV-BV-6	13400 S. MAINLINE VAULT	BUTTERFLY	48	80	150	ELECTRIC	460	THREE	YES
JV-BV-7	SWA - 13800 S. BLOWOFF	BUTTERFLY	8	85	150	MANUAL	NA	NA	NO
JV-BV-8	JA2 - 13800 S. BLOWOFF	BUTTERFLY	8	85	150	MANUAL	NA	NA	NO
JV-BV-9	RIVERTON PS AV/MW VAULT	BUTTERFLY	24	85	150	MANUAL	NA	NA	NO
JV-PV-1	13800 S. BLOWOFF PIPING	PLUG	8	85	150	MANUAL	NA	NA	NO
JV-PV-2	ROSE CREEK CROSSING	PLUG	14	80	150	MANUAL	NA	NA	NO
JV-GV-1	13400 S. MAINLINE VAULT	GATE	66	80	150	ELECTRIC	460	THREE	YES
JV-GV-2	SWA - ULDC BLOW-OFF AND INTERCONNECTION	GATE	14	75	150	MANUAL	NA	NA	NO
JV-GV-3	JA2 - ULDC BLOW-OFF AND INTERCONNECTION	GATE	14	75	150	MANUAL	NA	NA	NO
JV-GV-4	ROSE CREEK CROSSING	GATE	14	80	150	MANUAL	NA	NA	NO
JV-GV-6	14865 S. IRRIGATION PIPE	GATE	12	25	100	MANUAL	NA	NA	NO
JV-GV-7	14865 S. IRRIGATION PIPE	GATE	12	25	100	MANUAL	NA	NA	NO
JV-GV-8	14865 S. IRRIGATION PIPE	GATE	8	25	100	MANUAL	NA	NA	NO
JV-GV-9	14750 S. IRRIGATION PIPE	GATE	12	31	100	MANUAL	NA	NA	NO
JV-GV-10	VERA LN IRRIGATION PIPE	GATE	12	31	100	MANUAL	NA	NA	NO
JV-GV-11	15000 S. IRRIGATION PIPE	GATE	12	25	100	MANUAL	NA	NA	NO
JV-GV-12	15000 S. IRRIGATION PIPE	GATE	12	25	100	MANUAL	NA	NA	NO
JV-GV-13	15000 S. IRRIGATION PIPE	GATE	12	25	100	MANUAL	NA	NA	NO

PUMP SCHEDULE	
---------------	--

PUMP NO.	LOCATION	SERVICE	TYPE	DISCHARGE SIZE (IN)	MAX FLOW (GPM)	MAX HEAD (FT)	VOLTAGE	PHASE	HERTZ	HP (MIN)	PUMP MODEL NO.	REMARKS
JV-SP-01	JA-2 INTERCONN. VAULT	RAW WATER	SUMP PUMP	2	50	40	120	1	60	0.5	HSZ2.4S-62	TSURUMI PUMP
JV-SP-02	METER VAULT	RAW WATER	SUMP PUMP	2	50	40	120	1	60	0.5	HSZ2.4S-62	TSURUMI PUMP
JV-SP-03	13400 S. MANLINE VAULT	RAW WATER	SUMP PUMP	2	50	40	120	1	60	0.5	HSZ2.4S-62	TSURUMI PUMP

NOTES: REFER TO SPECIFICATION SECTION 11149- SUBMERSIBLE SUMP PUMPS FOR FURTHER INFORMATION.

EXHAUST FAN SCHEDULE	
----------------------	--

FAN NO.	VAULT	AIRFLOW (ACFM) AT 5,000 FT	ESP INCHES WC	DRIVE	MOTOR			COOK FAN MODEL (OR EQUAL)
					HP	VOLTS	PHASE	
JV-EF-01	JA-2 INTERCONN. VAULT	2500	0.25	DIRECT	0.50	120	SINGLE	16CV11D
JV-EF-02	JA-2 INTERCONN. VAULT	2500	0.25	DIRECT	0.50	120	SINGLE	16CV11D
JV-EF-03	METER VAULT	1400	0.25	DIRECT	0.33	120	SINGLE	12CV17D
JV-EF-04	13400 S. MAINLINE VAULT	2800	0.25	DIRECT	0.50	120	SINGLE	16CV11D


NOTES: REFER TO SECTION 15500 - HEATING, VENTILATING, AND AIR CONDITIONING FOR FURTHER INFORMATION.

METER SCHEDULE

METER NO.	LOCATION	TYPE	SIZE (IN)	REMARKS
JV-M-1	METER VAULT	MAGNETIC FLOW METER	78	ENDRESS-HAUSER PROMAG 53W OR ROSEMOUNT,8750 FLOWTUBE
JV-M-2	METER VAULT	MAGNETIC FLOW METER	66	ENDRESS-HAUSER PROMAG 53W OR ROSEMOUNT,8750 FLOWTUBE

NOTES: REFER TO SECTION 15075 - METERS, GENERAL

NOTES:

1. JWCD IS PROVIDING (3) REFURBISHED 72" DIA BUTTERFLY VALVES FOR THE PROJECT. SHOP DRAWINGS FOR THESE VALVES ARE INCLUDED WITH THE REFERENCE DRAWINGS IN THIS DRAWING SET. THE OWNER PROVIDED BUTTERFLY VALVES ARE IN STORAGE AT THE JWTP AND WILL BE AVAILABLE FOR THE PROJECT BY SEPTEMBER 1, 2010.
2. PROVIDE DC BLOCKER AT ALL ELECTRICAL VALVE OPERATORS, SEE 



SOUTHWEST AQUEDUCT REACH 2 PROJECT

MECHANICAL EQUIPMENT SCHEDULES

DISTRICT

VERIFY SCALE

REVIEW

CHECKED M. COLLINS
APPROVED J. LUETTINGER

DESIGN


IGN	T. OLSEN
WN	R. GARCIA

DATE: FEBRUARY 2010	PROJECT NUMBER 010-08-03
---------------------	--------------------------

DRAWING NO.

M-1


SHEET 64 OF 110

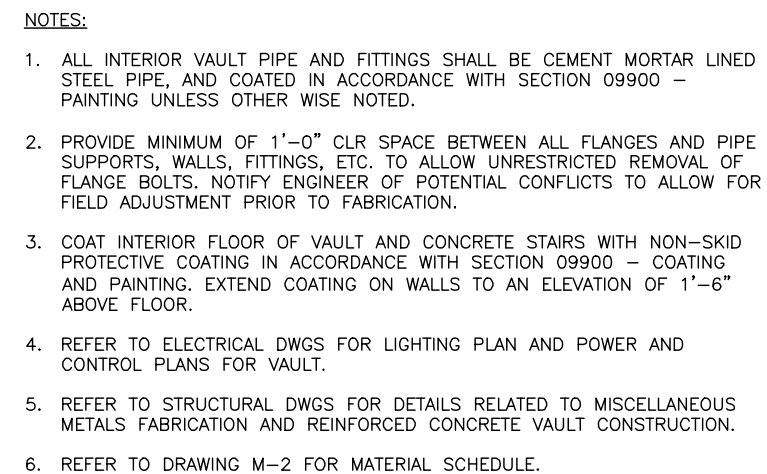

RECORD DRAWINGS

Revisions Drawn by S. Riggs Date November 2011


THESE RECORD DRAWINGS HAVE BEEN PREPARED, IN PART, ON THE BASIS OF INFORMATION COMPILED BY OTHERS. THEY ARE NOT INTENDED TO REPRESENT IN DETAIL THE EXACT LOCATION, TYPE OF COMPONENT NOR MANNER OF CONSTRUCTION. THE ENGINEER WILL NOT BE RESPONSIBLE FOR ANY ERRORS OR OMISSIONS WHICH HAVE BEEN INCORPORATED INTO THE RECORD DRAWINGS.

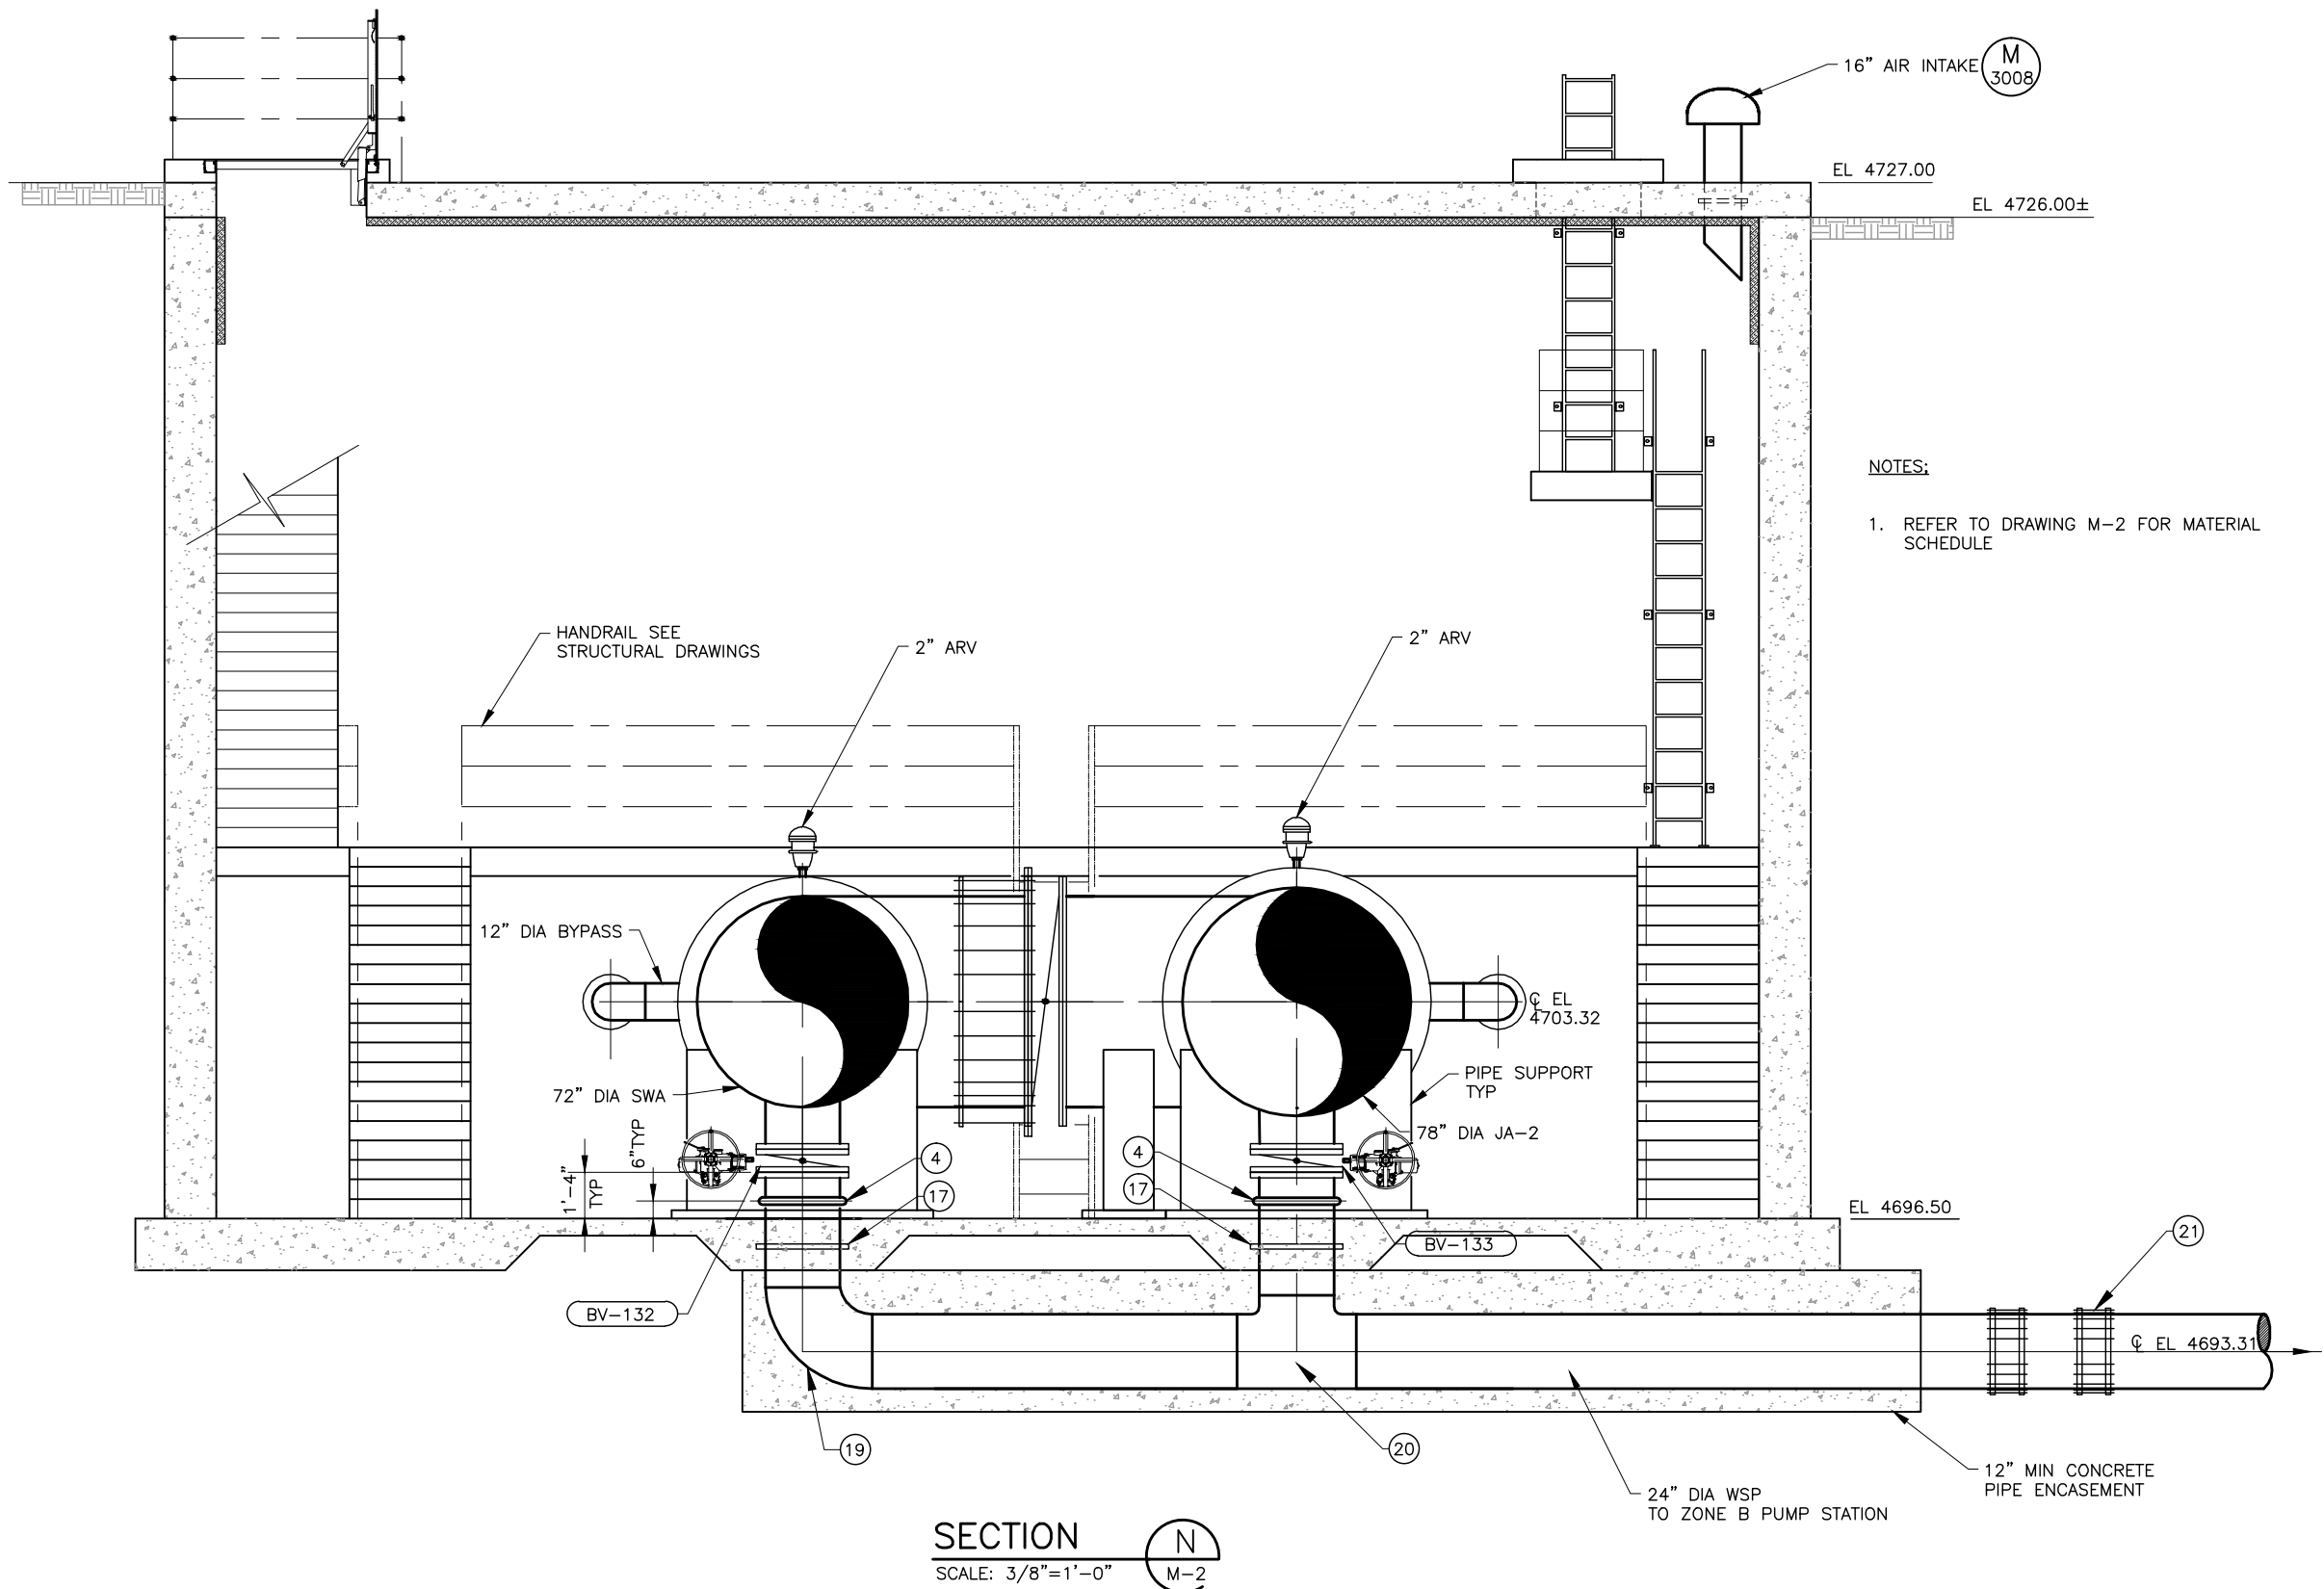

RECORD DRAWINGS

Revisions Drawn by S. Riggs Date November 2011

THESE RECORD DRAWINGS HAVE BEEN PREPARED, IN PART, ON THE BASIS OF INFORMATION COMPILED BY OTHERS. THEY ARE NOT INTENDED TO REPRESENT IN DETAIL THE EXACT LOCATION, TYPE OF COMPONENT NOR MANNER OF CONSTRUCTION. THE ENGINEER WILL NOT BE RESPONSIBLE FOR ANY ERRORS OR OMISSIONS WHICH HAVE BEEN INCORPORATED INTO THE RECORD DRAWINGS.

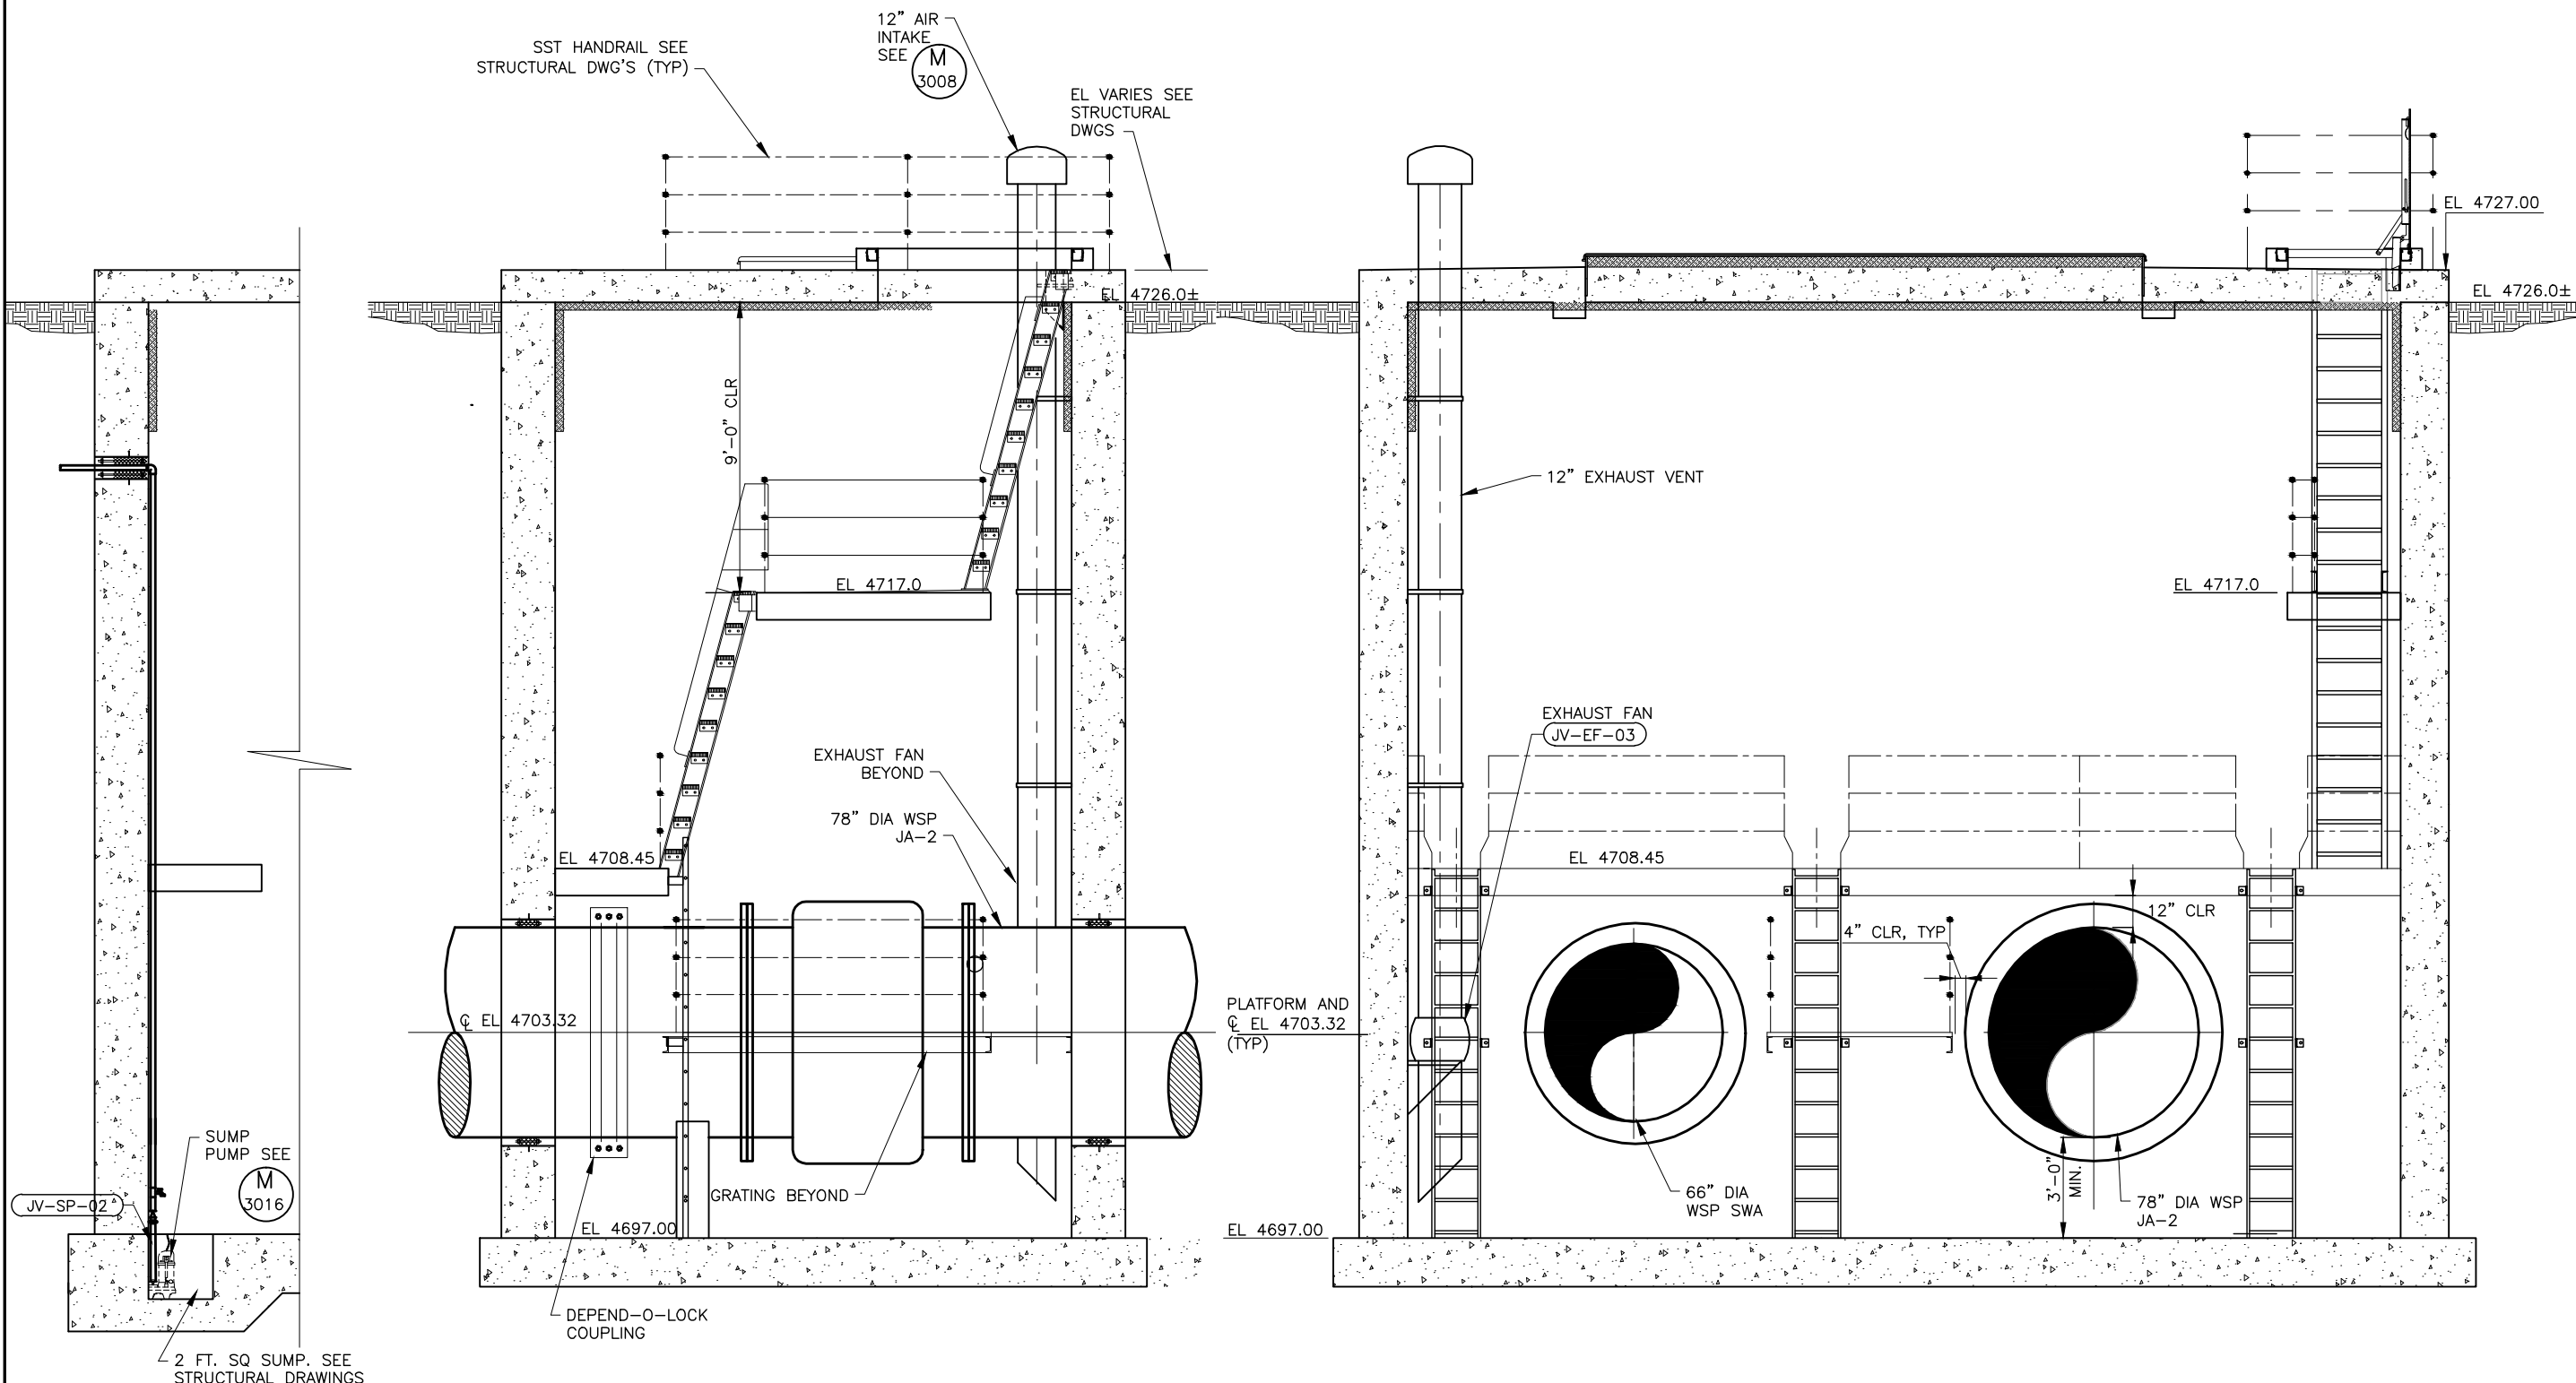

SECTION **PP**
SCALE: 3/8"=1'-0"
M-5

SECTION **P**
SCALE: 3/8"=1'-0"
M-5






SECTION **Q**
SCALE: 3/8"=1'-0"
M-5

RECORD DRAWINGS
Revisions Drawn by S. Riggs Date November 2011
THESE RECORD DRAWINGS HAVE BEEN PREPARED, IN PART, ON THE BASIS OF INFORMATION COMPILED BY OTHERS. THEY ARE NOT INTENDED TO REPRESENT IN DETAIL THE EXACT LOCATION, TYPE OF COMPONENT NOR MANNER OF CONSTRUCTION. THE ENGINEER WILL NOT BE RESPONSIBLE FOR ANY ERRORS OR OMISSIONS WHICH HAVE BEEN INCORPORATED INTO THE RECORD DRAWINGS.

JORDAN VALLEY WATER CONSERVANCY DISTRICT	
SOUTHWEST AQUEDUCT REACH 2 PROJECT	
METER VAULT SECTIONS	
DESIGN T. OLSEN	REVIEW CHECKED M. COLLINS
DRAWN R. GARCIA	APPROVED J. LUETTINGER
DATE: FEBRUARY 2010	PROJECT NUMBER 010-08-03
DRAWING NO. M-6	
SHEET 69 OF 110	

NO.	DATE	REV. BY	DESCRIPTION
REVISIONS			


VERIFY SCALE
BAR IS ONE INCH ON ORIGINAL DRAWING

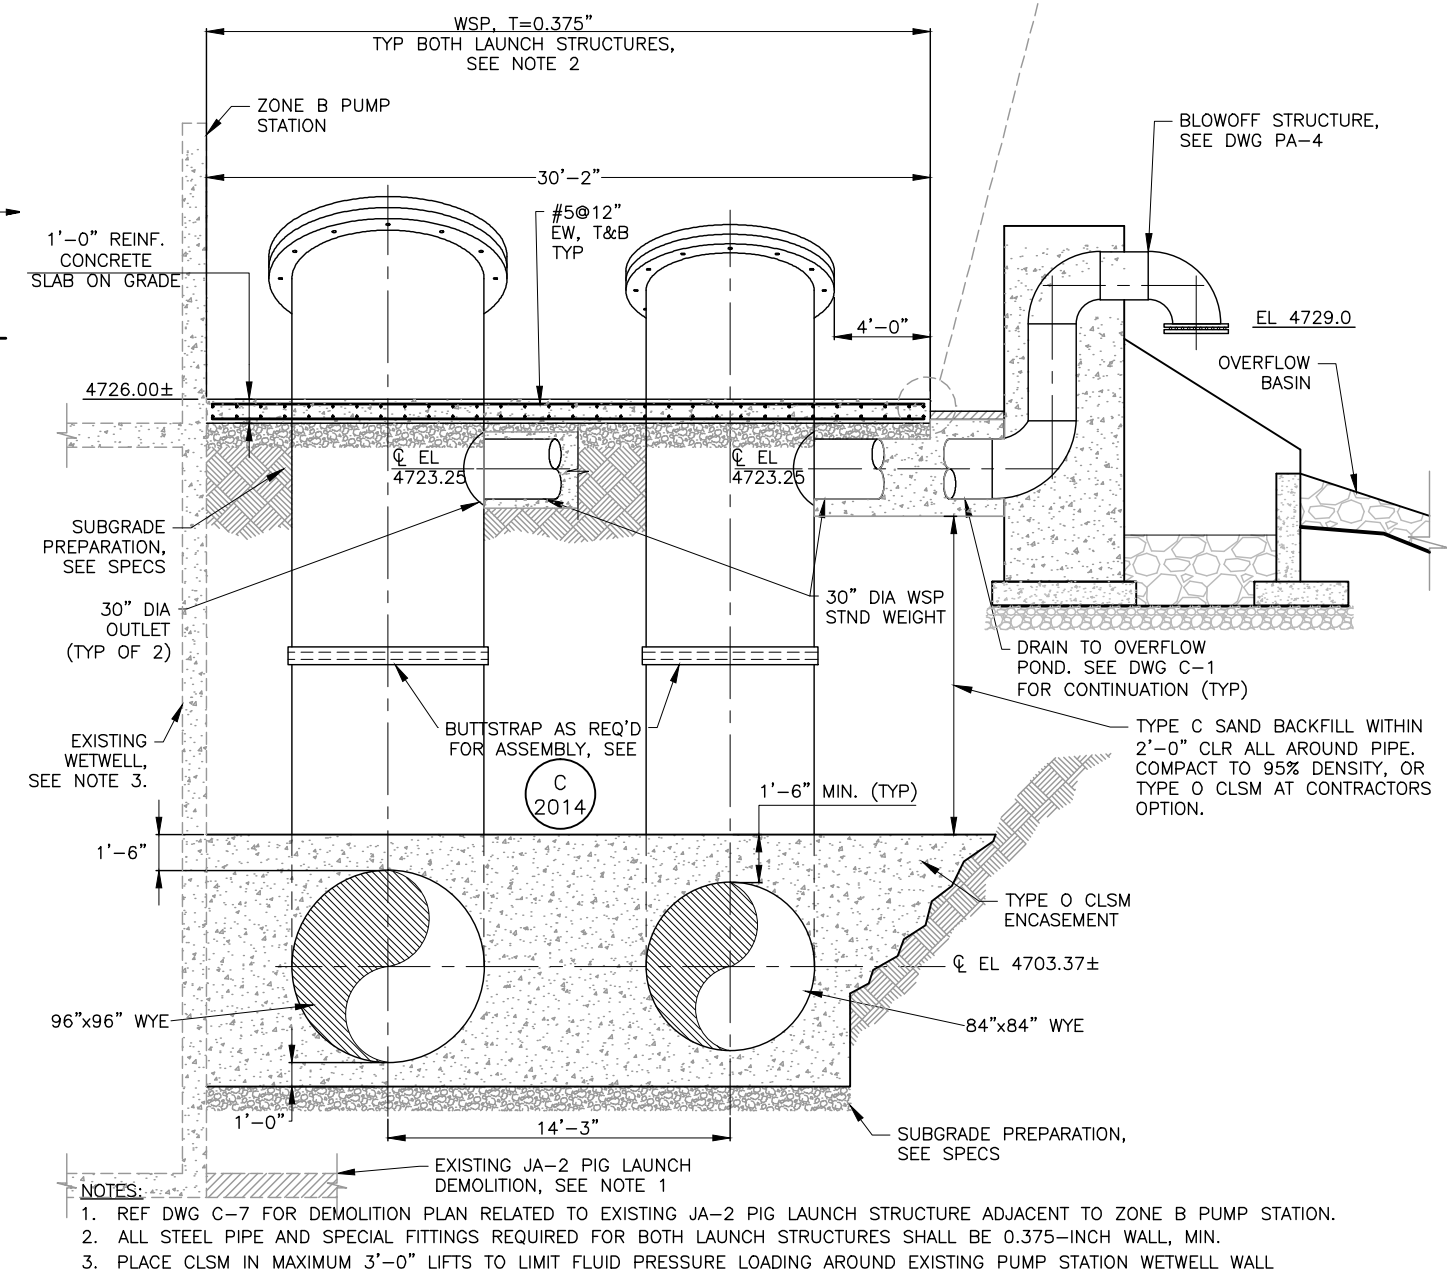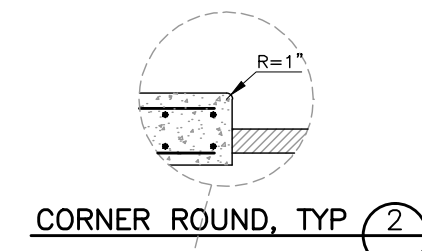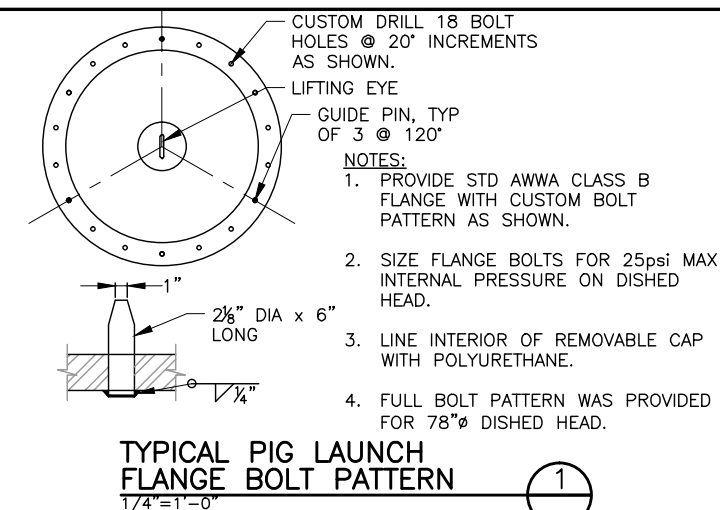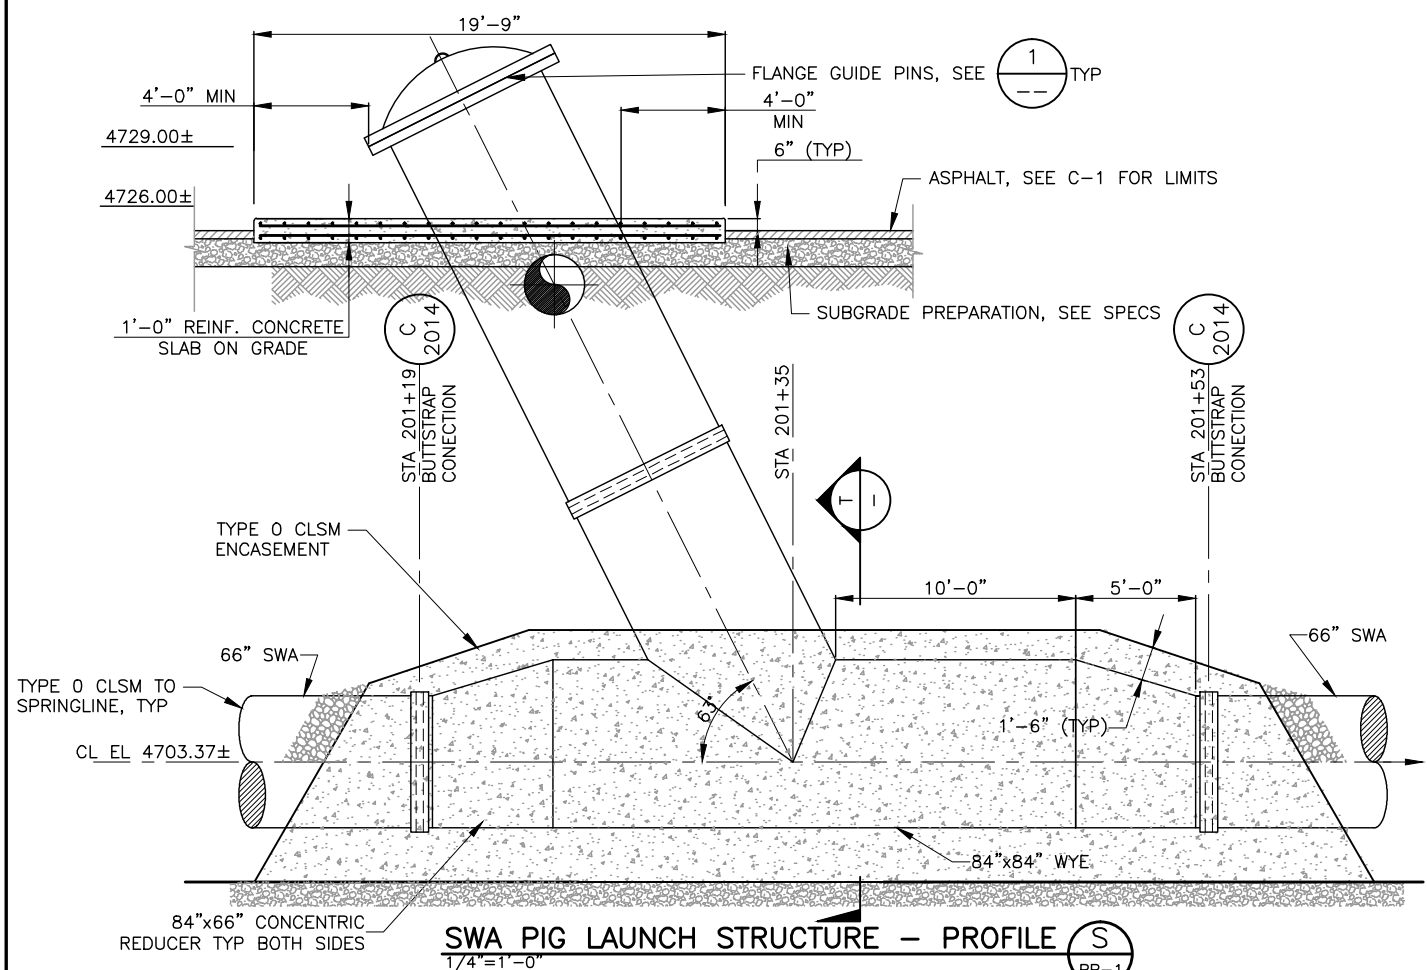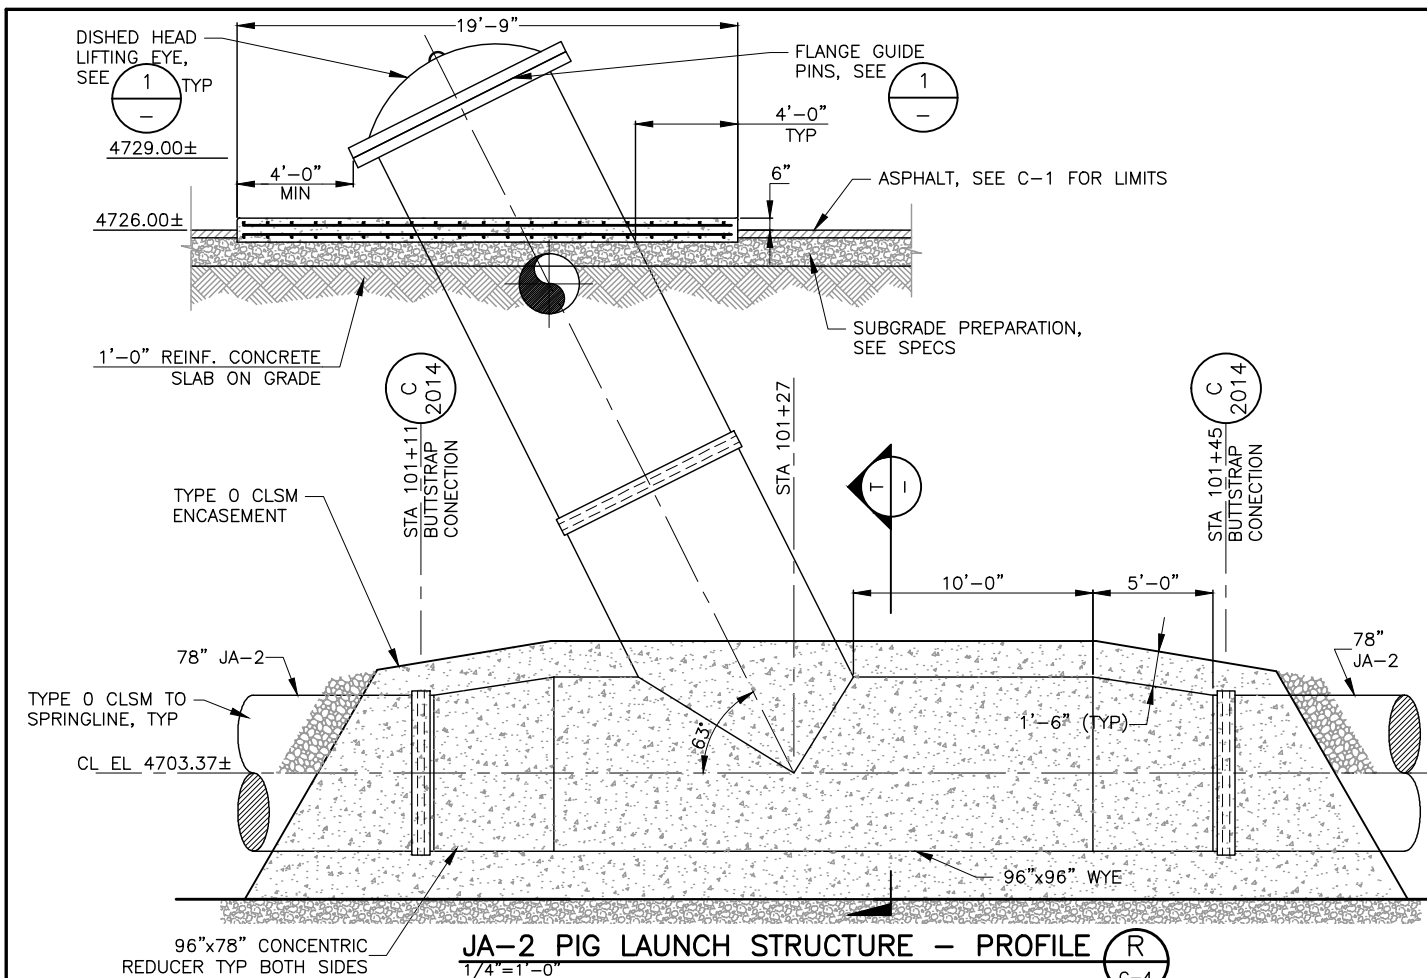


RECORD DRAWINGS

Revisions Drawn by S. Riggs Date November 2011

THESE RECORD DRAWINGS HAVE BEEN PREPARED, IN PART, ON THE BASIS OF INFORMATION COMPILED BY OTHERS. THEY ARE NOT INTENDED TO REPRESENT IN DETAIL THE EXACT LOCATION, TYPE OF COMPONENT NOR MANNER OF CONSTRUCTION. THE ENGINEER WILL NOT BE RESPONSIBLE FOR ANY ERRORS OR OMISSIONS WHICH HAVE BEEN INCORPORATED INTO THE RECORD DRAWINGS.

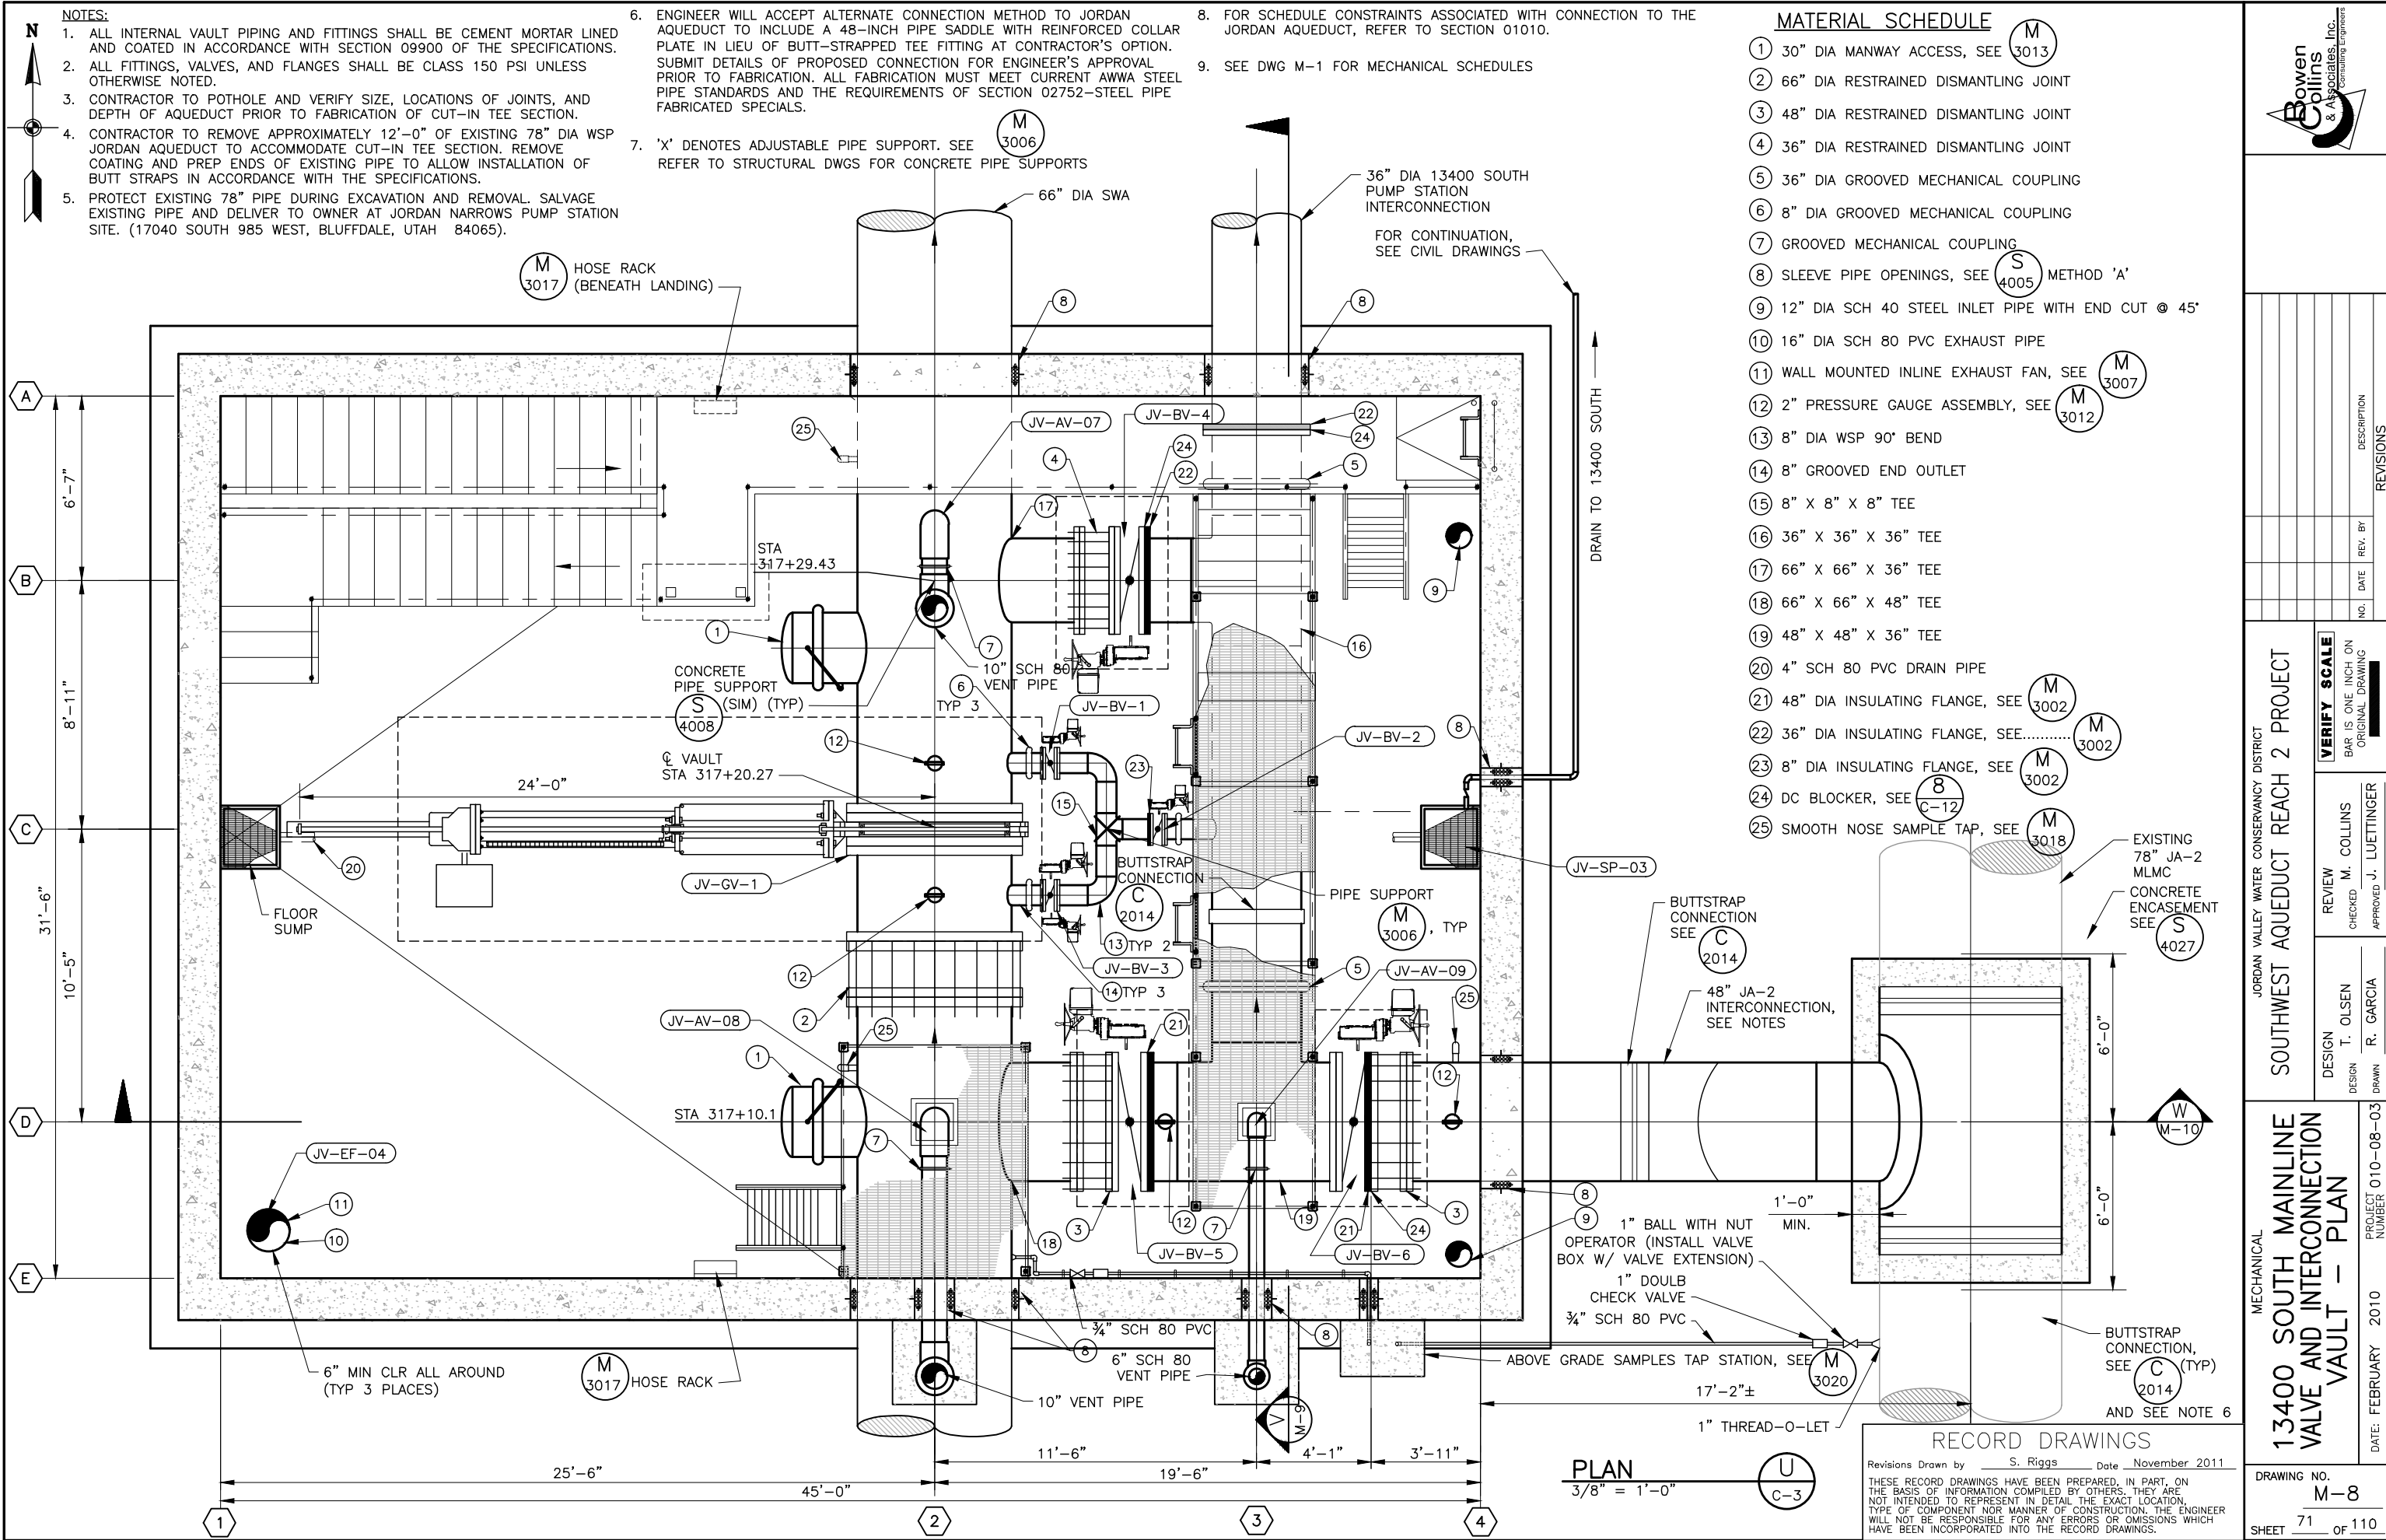

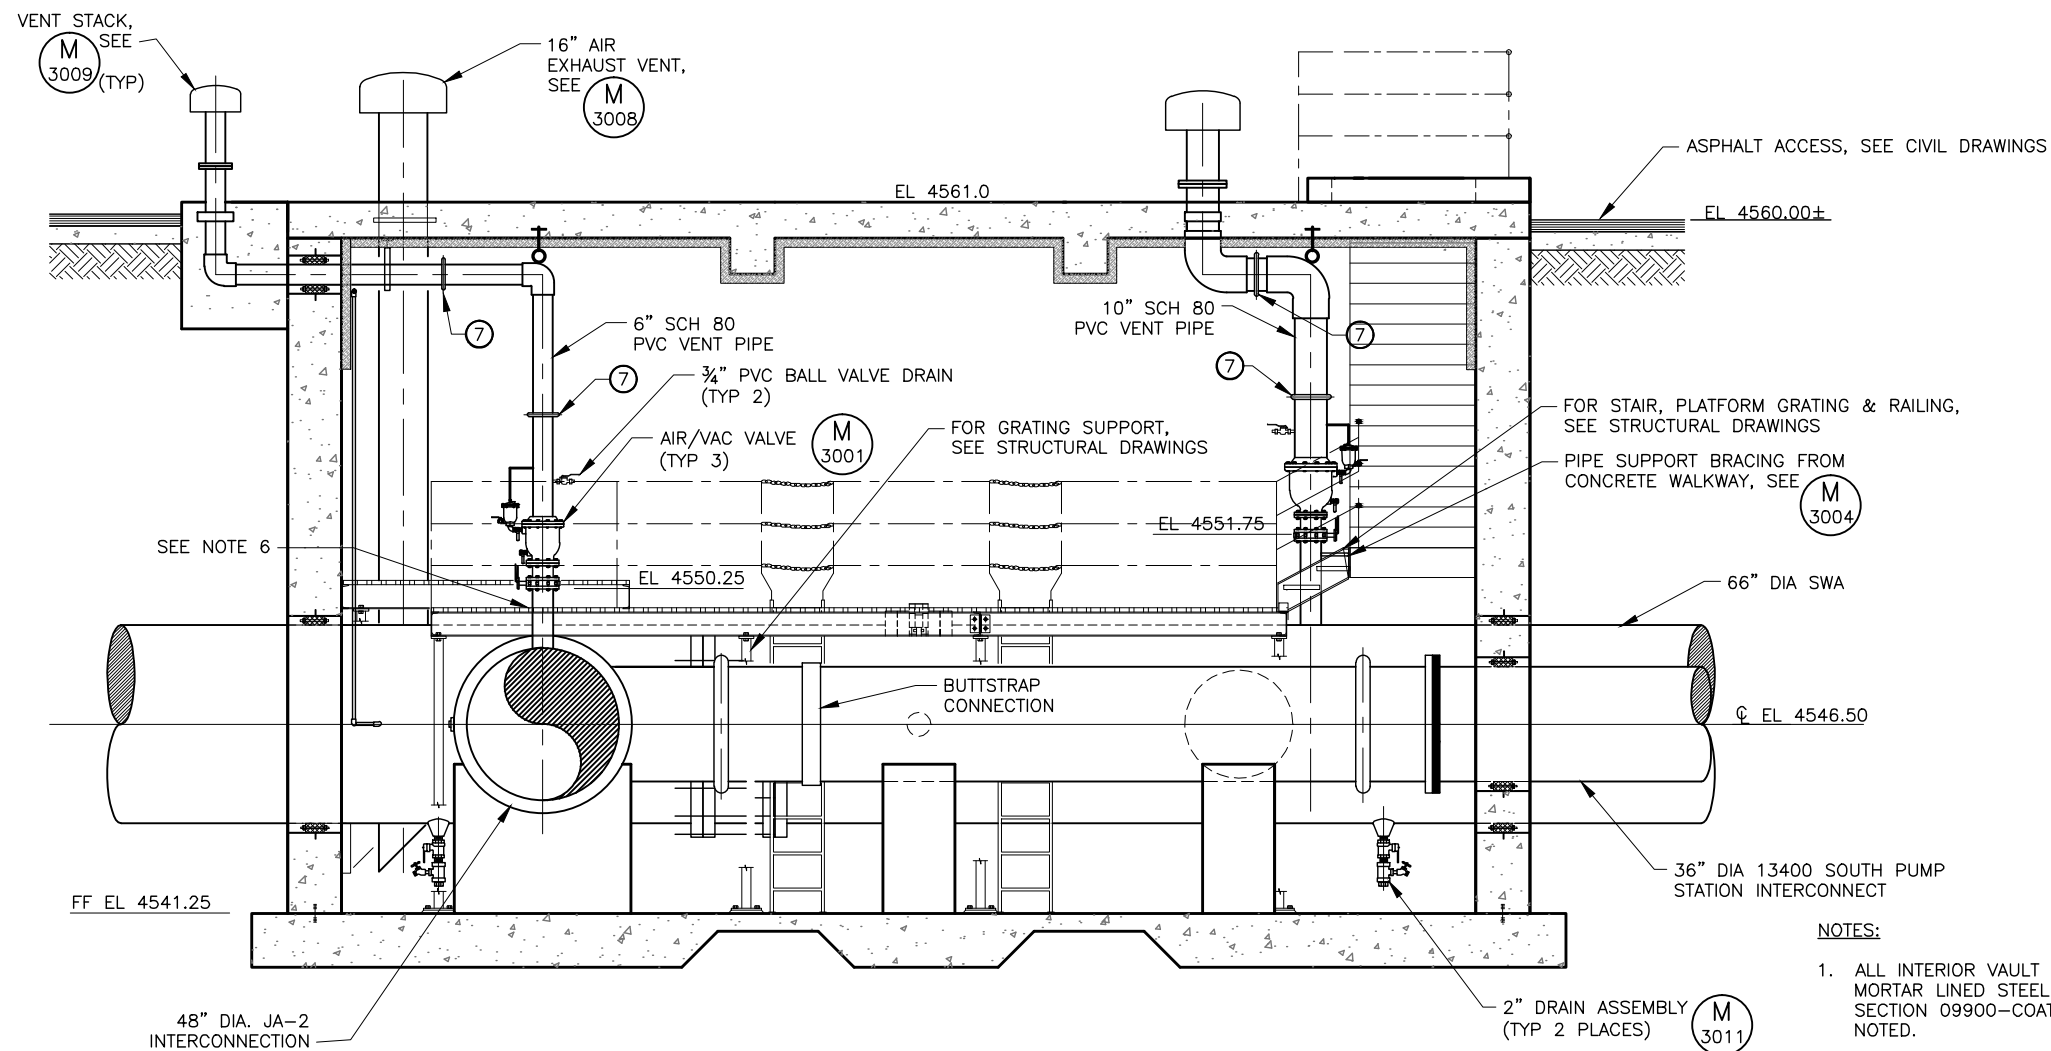

SECTION
3/8"=1'-0" V
M-8

NOTES:

1. ALL INTERIOR VAULT PIPE AND FITTINGS SHALL BE CEMENT MORTAR LINED STEEL PIPE, AND COATED IN ACCORDANCE WITH SECTION 09900-COATING AND PAINTING UNLESS OTHERWISE NOTED.
2. PROVIDE MINIMUM OF 1'-0" CLEARANCE BETWEEN ALL FLANGES AND PIPE SUPPORTS, WALLS, FITTINGS, ETC. TO ALLOW UNRESTRICTED REMOVAL OF FLANGE BOLTS. CONTRACTOR SHALL BE RESPONSIBLE FOR COORDINATION OF DIMENSIONAL FIT-UP OF PIPING, NOTIFY ENGINEER OF POTENTIAL CONFLICTS TO ALLOW FOR FIELD ADJUSTMENT PRIOR TO FABRICATION.
3. COAT INTERIOR FLOOR OF VAULT AND CONCRETE STAIRS WITH NON-SKID PROTECTIVE COATING IN ACCORDANCE WITH SECTION 09900-COATING AND PAINTING. EXTEND COATING IN WALLS TO AN ELEVATION OF 1'-6" ABOVE FLOOR.
4. REFER TO ELECTRICAL DRAWINGS FOR LIGHTING PLAN AND POWER AND CONTROL PLANS FOR VAULT.
5. REFER TO STRUCTURAL DRAWINGS FOR DETAILS RELATED TO MISCELLANEOUS METALS FABRICATION AND REINFORCED CONCRETE VAULT CONSTRUCTION.
6. CONTRACTOR SHALL NOTCH GRATING FOR 6" AIR VALVE PENETRATION.

RECORD DRAWINGS

Revisions Drawn by S. Riggs Date November 2011

THESE RECORD DRAWINGS HAVE BEEN PREPARED, IN PART, ON THE BASIS OF INFORMATION COMPILED BY OTHERS. THEY ARE NOT INTENDED TO REPRESENT IN DETAIL THE EXACT LOCATION, TYPE OF COMPONENT NOR MANNER OF CONSTRUCTION. THE ENGINEER WILL NOT BE RESPONSIBLE FOR ANY ERRORS OR OMISSIONS WHICH HAVE BEEN INCORPORATED INTO THE RECORD DRAWINGS.



NO.	DATE	REV. BY	DESCRIPTION

JORDAN VALLEY WATER CONSERVANCY DISTRICT
SOUTHWEST AQUEDUCT REACH 2 PROJECT

VERIFY SCALE
BAR IS ONE INCH ON ORIGINAL DRAWING

REVIEW
CHECKED M. COLLINS
APPROVED J. LEUTINGER


DESIGN
DESIGN T. OLSEN
DRAWN P. COLOSIMO

MECHANICAL
13400 SOUTH MAINLINE
VALVE AND INTERCONNECT
VAULT - SECTION

PROJECT NUMBER 010-08-03


DATE: FEBRUARY 2010

DRAWING NO.
M-9
SHEET 72 OF 110

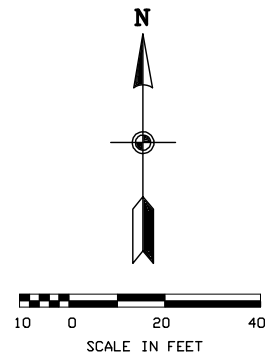

MATERIAL SCHEDULE

- (1) 48" INSULATING FLANGE, SEE (M) 3002
- (2) 6" INSULATING FLANGE, SEE (M) 3002

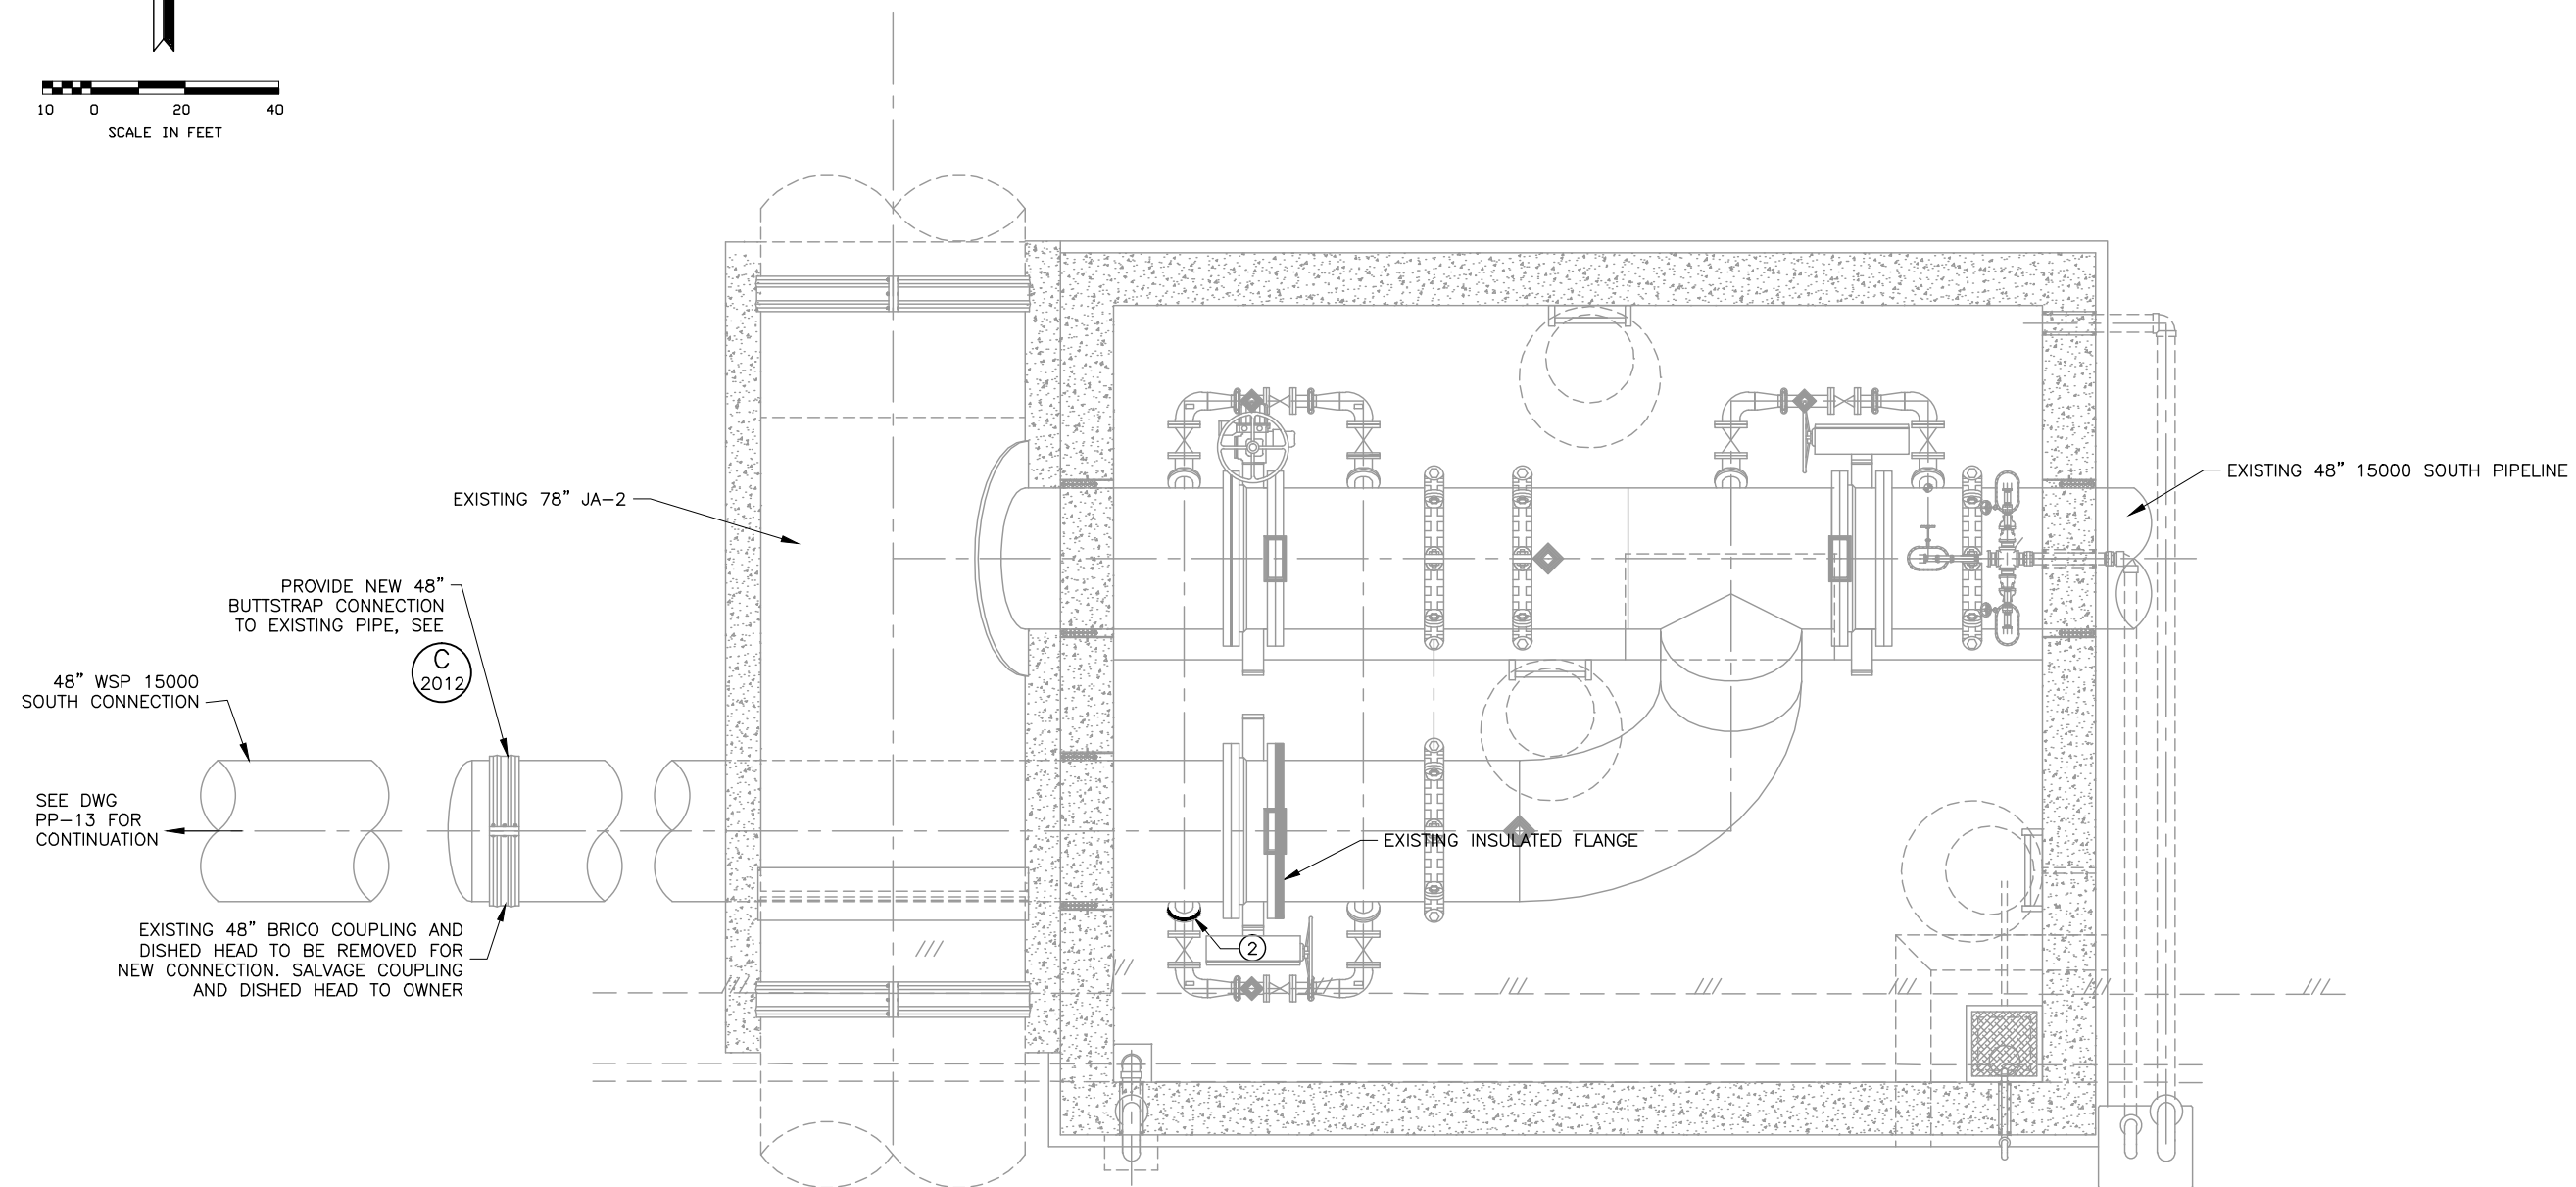

15000 SOUTH CONNECTION VAULT (X)
PP-13


RECORD DRAWINGS

Revisions Drawn by S. Riggs Date November 2011

THESE RECORD DRAWINGS HAVE BEEN PREPARED, IN PART, ON THE BASIS OF INFORMATION COMPILED BY OTHERS. THEY ARE NOT INTENDED TO REPRESENT IN DETAIL THE EXACT LOCATION, TYPE OF COMPONENT NOR MANNER OF CONSTRUCTION. THE ENGINEER WILL NOT BE RESPONSIBLE FOR ANY ERRORS OR OMISSIONS WHICH HAVE BEEN INCORPORATED INTO THE RECORD DRAWINGS.

- NOTES:

1. CONTRACTOR TO INSTALL INSULATING FLANGES IN 48" AND 6" PIPES, INCLUDING DISASSEMBLY AND REASSEMBLY OF PIPING AS REQUIRED.
2. COORDINATE SCHEDULE FOR MODIFICATIONS TO VAULT WITH OWNER PRIOR TO CONSTRUCTION



**Bowen
Collins
& Associates, Inc.**
Consulting Engineers

[illegible]

JORDAN VALLEY CONSERVANCY DISTRICT
SOUTHWEST AQUEDUCT REACH 2 PROJECT

BAR IS ONE INCH ON
ORIGINAL DRAWING

REVIEW
M. COLLINS
CHECKED
APPROVED J. LUETTINGER


DESIGN	
T. OLSEN	
DESIGN	
P. COLOSIMO	
DRAWN	

15000 SOUTH VAULT INSULATION PLAN

DATE: FEBRUARY 2010	PROJECT NUMBER 010-08-03
---------------------	--------------------------

DRAWING NO.
M-11

SHEET 74 OF 110

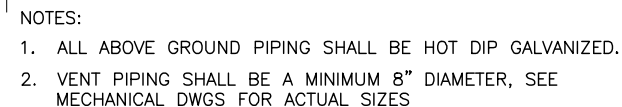

NTS

M
3007



M
3008

1. WELD ALL STEEL FITTINGS EXCEPT MATCHING BOLT ON FLANGE.
2. ALL ABOVE GRADE STL PIPING SHALL BE HOT DIP GALVANIZED. BOLTS, NUTS, AND WASHERS SHALL BE SST
3. VENT CAP FOR PIPELINE AIR VALVES MUST MEET STATE DRINKING WATER STANDARDS. ENGINEER MAY REQUIRE SUBSTITUTION WITH STANDARD GOOSNECK STYLE VENT IF SUPPLIER DOES NOT MEET STATE REQUIREMENTS.
4. VENT PIPING SHALL BE A MINIMUM 8" DIAMETER, SEE MECHANICAL DRAWINGS FOR ACTUAL SIZE.

SLE


SEE

M
3009




NTS

M
3010

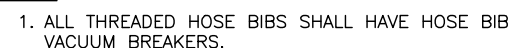

NTS

M
301






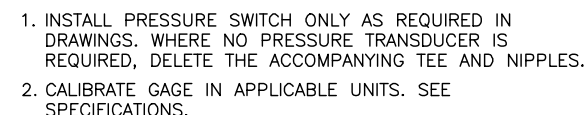


M
3012



NTS

M
3013

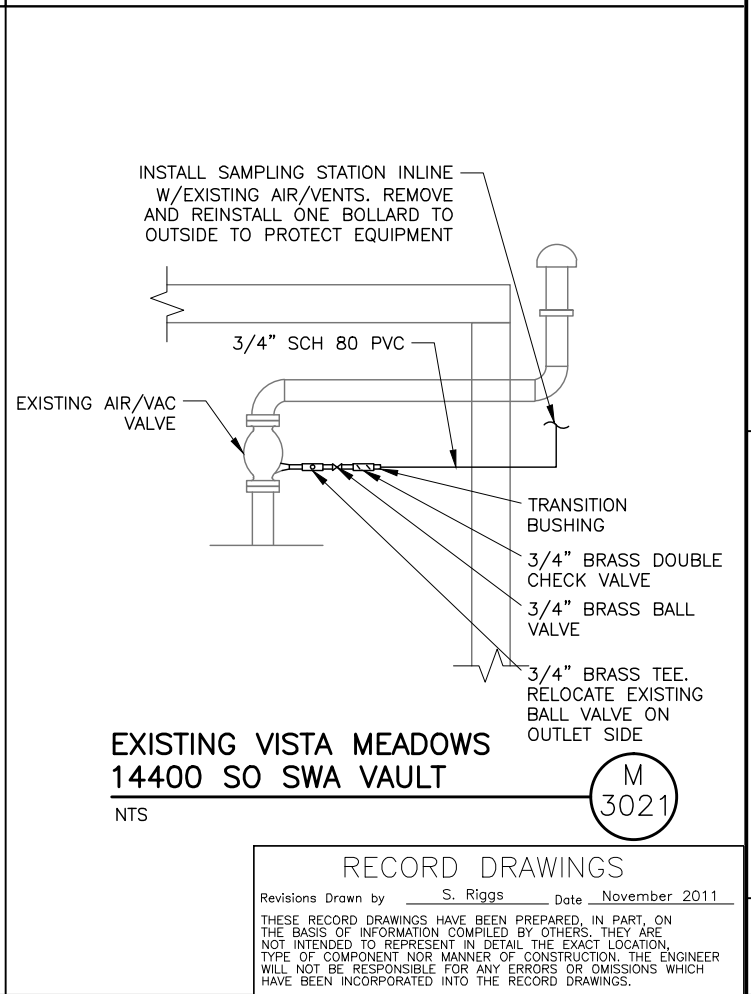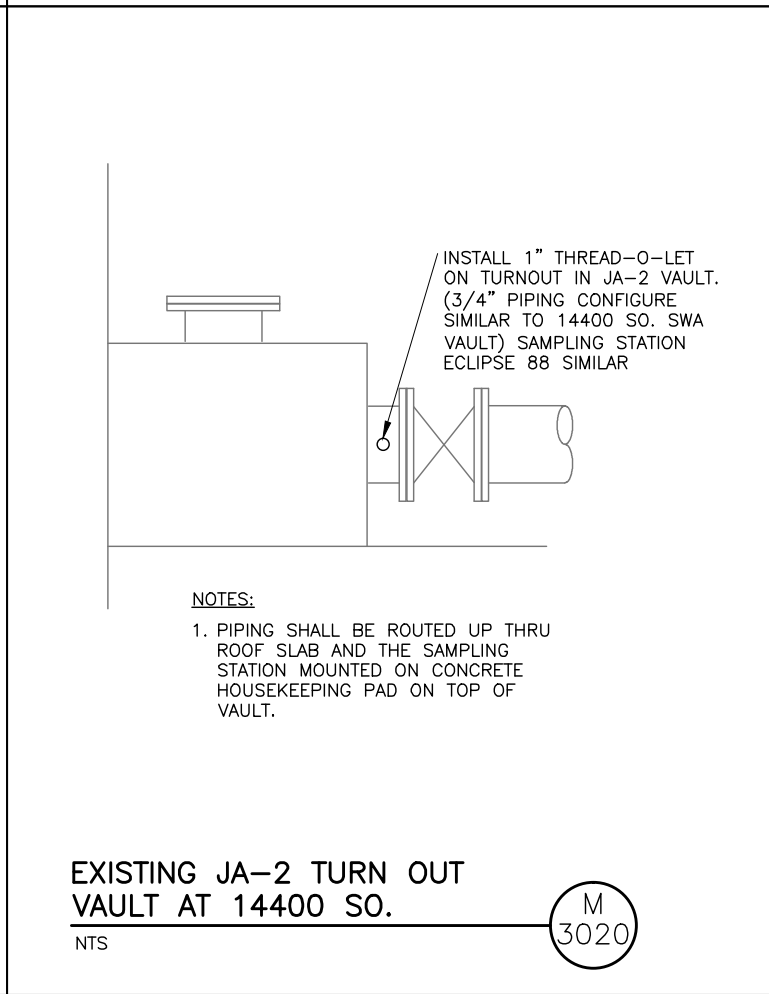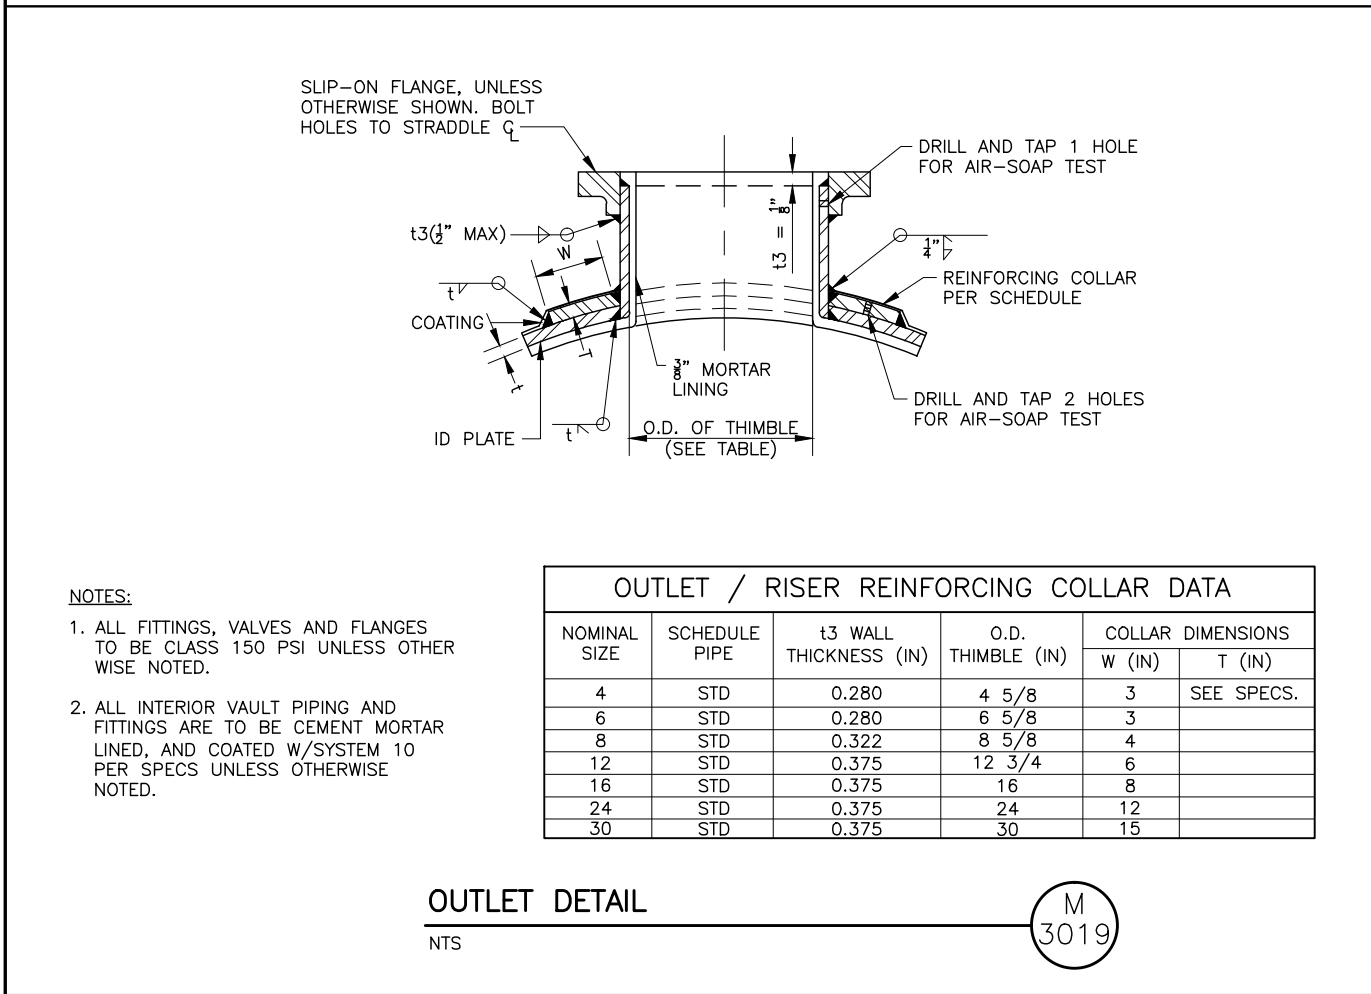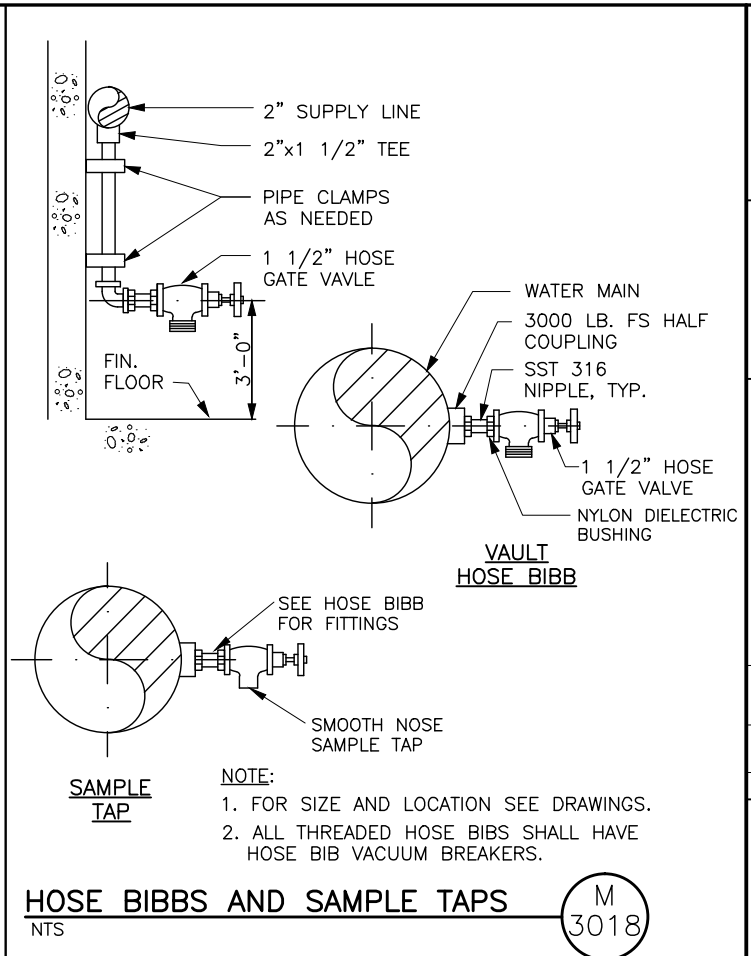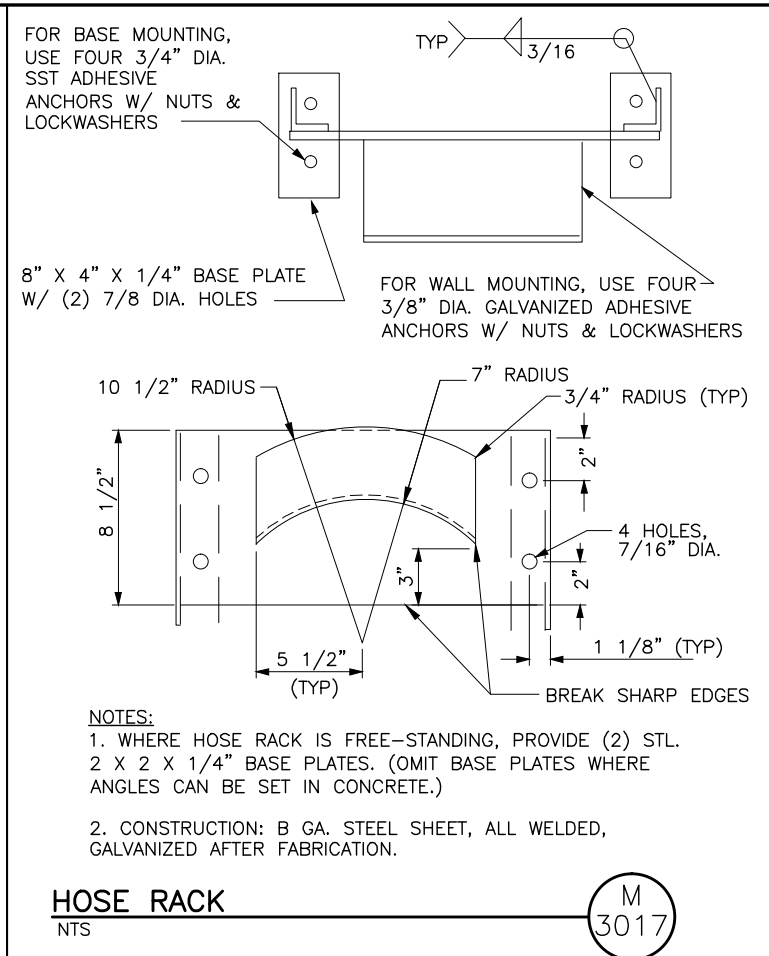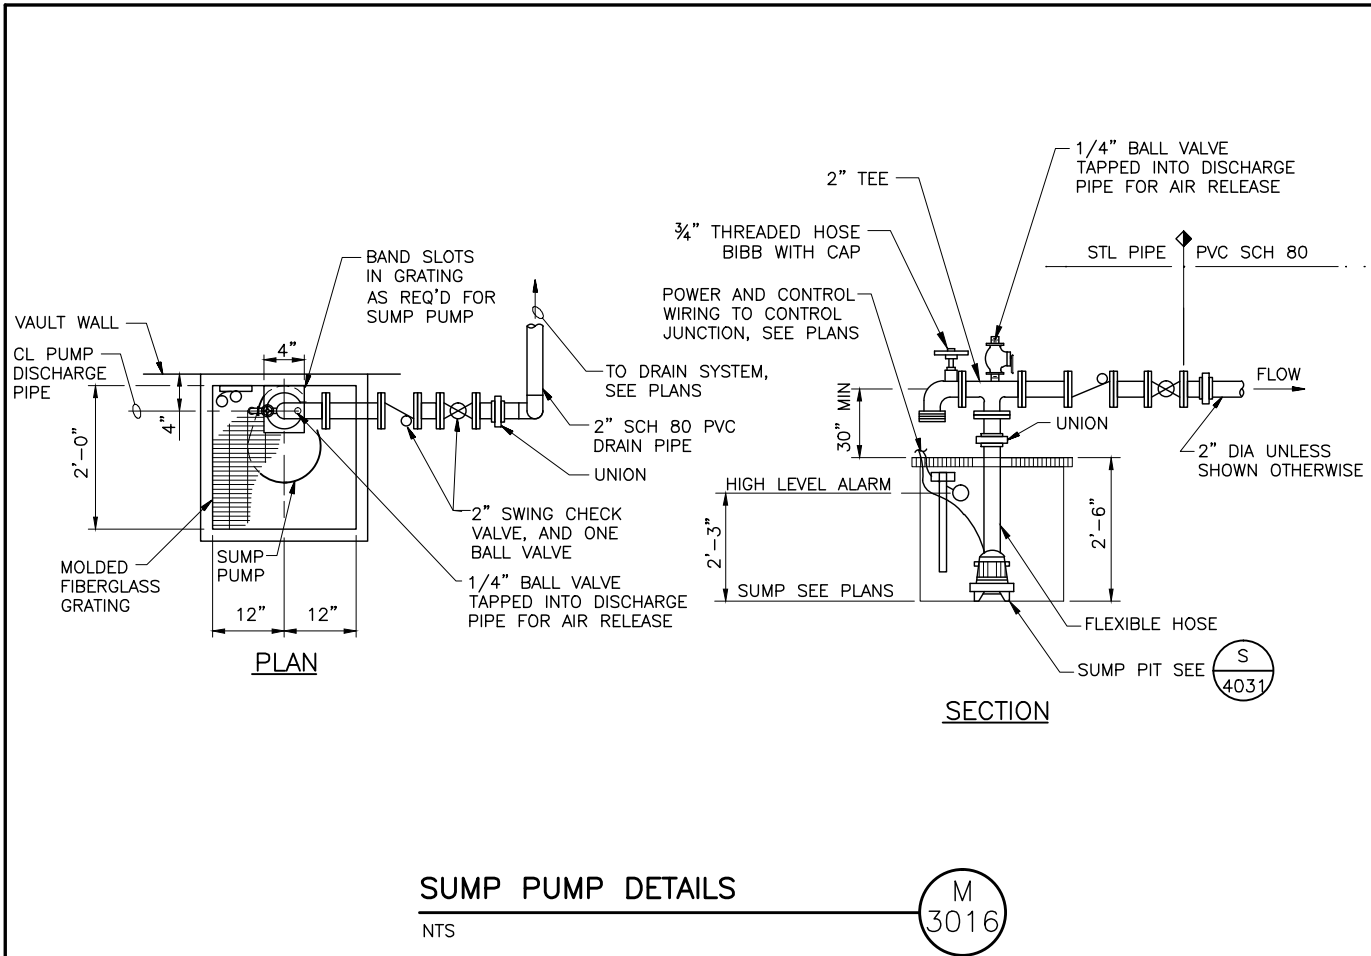

Bowen Collins & Associates, Inc.
Consulting Engineers

JORDAN VALLEY WATER CONSERVANCY DISTRICT SOUTHWEST AQUEDUCT REACH 2 PROJECT			
NO.	DATE	REV. BY	DESCRIPTION

VERIFY SCALE

BAR IS ONE INCH ON ORIGINAL DRAWING

DESIGN

DESIGN T. OLSEN
DRAWN B. ABEL

REVIEW




CHECKED M. COLLINS
APPROVED J. LUETTINGER

GENERAL MECHANICAL DETAILS - 3

DATE: FEBRUARY 2010 PROJECT NUMBER 010-08-03

DRAWING NO. **GM-3**

SHEET **77** OF **110**

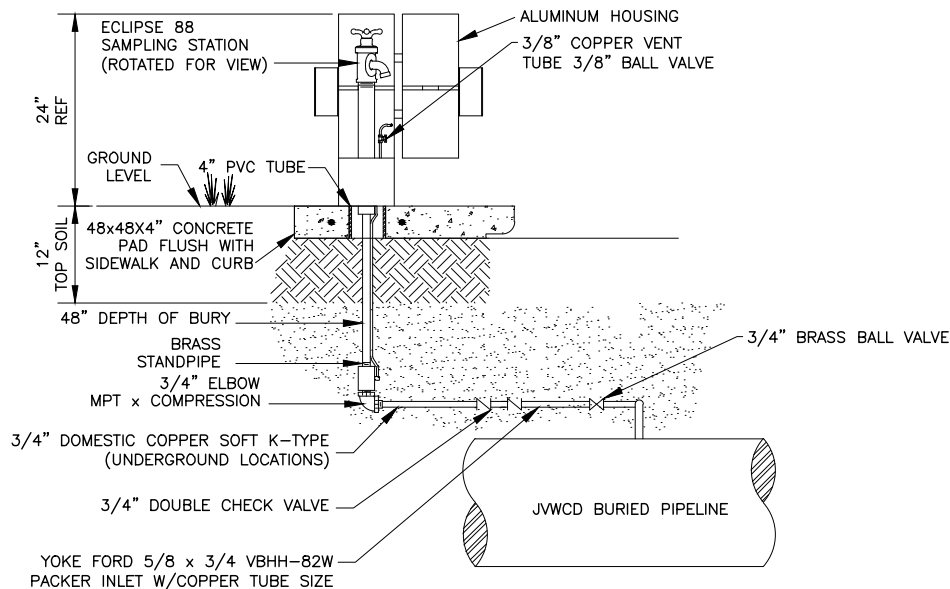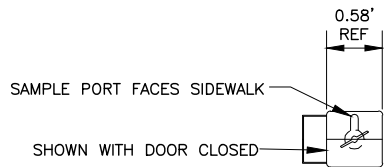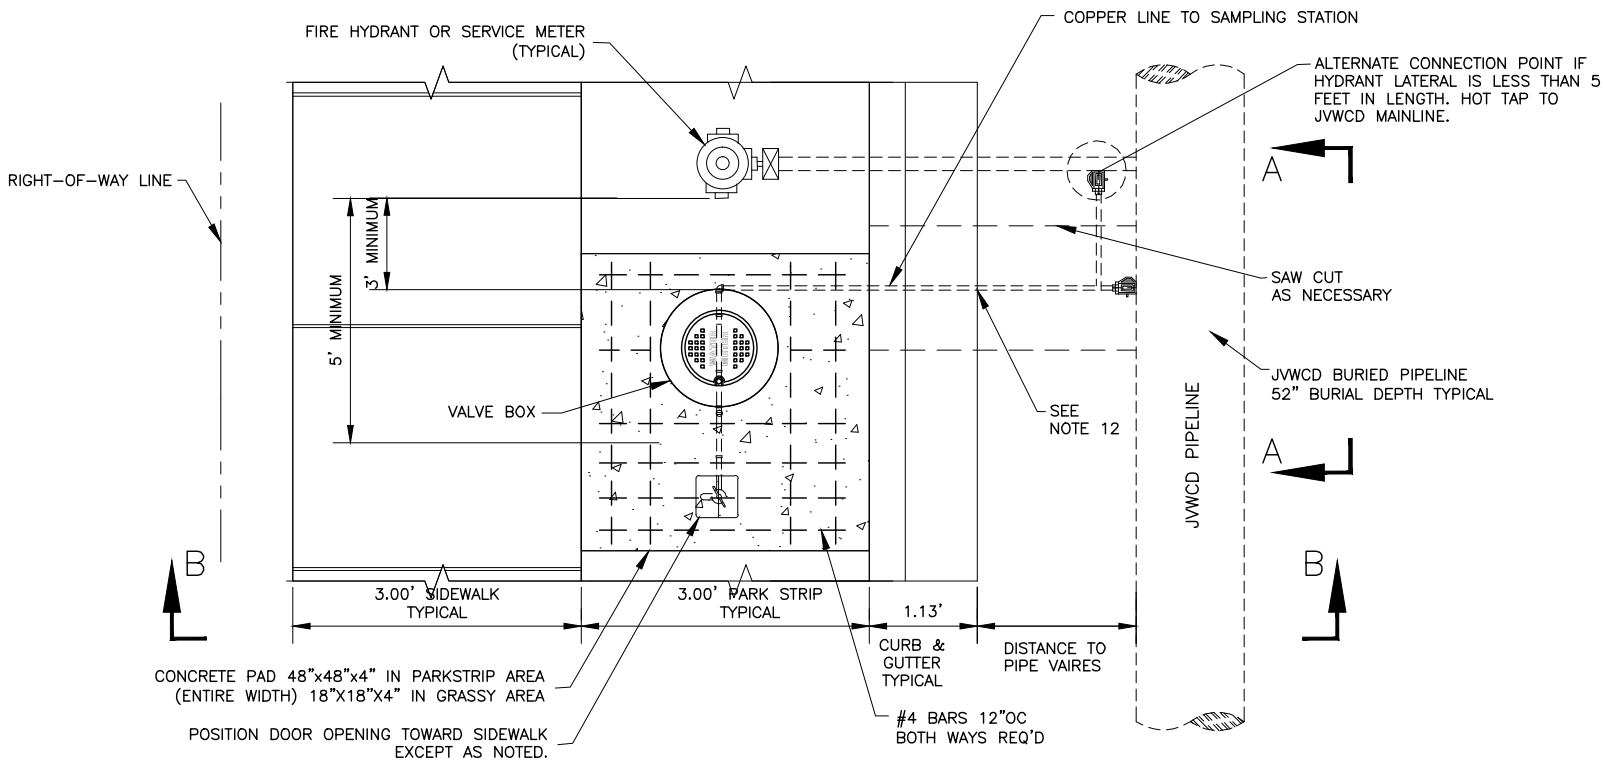

SECTION DETAIL A-A
NOT TO SCALE

TYPICAL SAMPLE TAP DETAIL
NTS

M
3020

PROJECT SPECIFIC NOTES – WATER QUALITY SAMPLING STATIONS:


- 1) A REPRESENTATIVE FROM THE OWNER MUST BE PRESENT DURING EACH HOT TAP TO THE OWNERS WATER LINES. 24 HOUR ADVANCE WRITTEN NOTICE TO THE OWNER OF "INTENT TO HOT TAP" IS REQUIRED. NOTICE IS TO INCLUDE THE ADDRESS AND TIME OF HOT TAPING OPERATION IS REQUIRED. SYSTEM PRESSURE RANGES FROM 50–150 PSI.
- 2) PENETRATIONS TO THE OWNERS WATER LINES ARE TO BE DONE WITH THE WATER LINE IN SERVICE (I.E. HOT TAP). BEST PRACTICES MUST BE USED DURING THIS OPERATION TO INSURE THE BACTERIOLOGICAL QUALITY AND STRUCTURAL INTEGRITY OF THE OWNERS WATER LINES.
- 3) SAMPLE TAPS ARE LOCATED AT 3 PLACES ON THE PROJECT.
 - EXISTING 14400 SOUTH VAULT (VISTA MEADOWS), SEE M/3021
 - EXISTING JA–2 TURNOUT VAULT AT 14400 SOUTH, SEE M/3020
 - 13400 SOUTH MAINLINE VALVE AND INTERCONNECTION VAULT, SEE DWG. M–8
- 4) POSITION SAMPLING STATION SQUARE TO THE ROAD.
- 5) DISINFECTION OF SAMPLING LINE IS THE RESPONSIBILITY OF THE CONTRACTOR. OWNER WILL BE RESPONSIBLE FOR BACTERIOLOGICAL TESTING.
- 6) THE CONTRACTOR MUST PROVIDE A SECURITY PADLOCK AT EACH SAMPLING STATION UNTIL BENEFICIAL USE IS TAKEN BY THE OWNER. AT THE TIME OF BENEFICIAL USE, THE OWNER WILL REPLACE THE CONTRACTOR LOCK WITH ITS OWN LOCK.
- 7) WATER QUALITY SAMPLING STATIONS MUST BE INSTALLED ON A CONCRETE BASE AND MUST BE PLUMB WITHIN 3 DEGREES.
- 8) IF SIDEWALKS, CURBS, OR GUTTERS ARE CUT PROVIDE THREE #4 DOWELS EACH SIDE PRIOR TO REPLACING CONCRETE.
- 9) CONTRACTOR LOCATE SAMPLE STATION SO SAMPLE WATER DOES NOT FLOW INTO UNDERGROUND VALVE BOX DURING FLUSHING.
- 10) THE CONTRACTOR MAY, UPON APPROVAL OF THE PROJECT REPRESENTATIVE, CONNECT DIRECTLY TO THE UPSTREAM SIDE OF AN EXISTING JWCD SERVICE METER.
- 11) THE CONTRACTOR MAY, UPON APPROVAL OF THE OWNER'S REPRESENTATIVE, CONNECT DIRECTLY TO A JWCD HYDRANT LATERAL IF THE HYDRANT LATERAL IS LESS THAN 5 FEET IN LENGTH. NO CONNECTIONS ALLOWED TO HYDRANT LATERALS OVER 5 FEET IN LENGTH, EXCEPT AS NOTED IN THE SPECIFICATIONS.
- 12) HORIZONTAL BORING FROM THE PARK STRIP IS ACCEPTABLE IN LIEU OF PAVEMENT REMOVAL / REPLACEMENT AT CONTRACTOR OPTION.
- 13) PIPING INSIDE OF BURIED VAULTS TO BE 3/4" HARD COPPER OR STAINLESS STEEL. SOFT COPPER PIPING MATERIAL NOT ACCEPTABLE INSIDE OF VAULT STRUCTURES. SUPPORTS SHALL BE LOCATED A MAXIMUM OF 48" ON-CENTER AND 6" OF EITHER SIDE OF A HORIZONTAL OR VERTICAL BEND.
- 14) CONTRACTOR SHALL REFER TO SITE SPECIFIC NOTES INCLUDED IN THE SPECIFICATIONS.

GENERAL NOTES:

- 1) SAMPLING STATIONS SHALL BE 48" BURY, WITH A 3/4" FIP INLET, AND A (3/4" HOSE OR UNTHREADED) NOZZLE.
- 2) ALL STATIONS SHALL BE ENCLOSED IN A LOCKABLE, NON-REMOVABLE HOUSING.
- 3) WHEN OPENED, THE STATION SHALL REQUIRE NO KEY FOR OPERATION, AND THE WATER WILL FLOW IN AN ALL BRASS WATERWAY.
- 4) ALL WORKING PARTS WILL BE OF BRASS AND BE REMOVABLE FROM ABOVE GROUND WITH NO DIGGING.
- 5) A 3/8" COPPER VENT TUBE WILL ENABLE EACH STATION TO BE PUMPED FREE OF STANDING WATER TO PREVENT FREEZING AND TO MINIMIZE BACTERIA GROWTH.
- 6) ECLIPSE NO. 88 "SECURE" SAMPLING STATION WITH JORDAN VALLEY WATER CONSERVANCY DISTRICT LOGO CAST IN DOOR. SEVERE COLD VERSION WITH 3/8" VENT TUBE, PVC SLEEVE, ALL BRASS WATERWAY WITH SECURITY ENHANCEMENTS. STATION SHALL BE MANUFACTURED BY KUPFERLE FOUNDRY, ST. LOUIS, MO 63102 (800–231–3990).
- 7) FORD FITTINGS AVAILABLE FROM PLUMBERS SUPPLY (801–261–1144).
- 8) CONTRACTOR SHALL ORIENT EACH OF THE SAMPLING STATIONS WITH THE LOCK CYLINDER FACING SOUTH WHEN POSSIBLE (FOR MELTING OF WINTER ICE ON LOCK CYLINDER). OWNER WILL CLARIFY THE DESIGN ORIENTATIONS AT TIME OF THE SUBMITTAL FOR THE SAMPLING STATIONS.
- 9) TAPPING SADDLE REQUIRED WHEN CONNECTING TO PVC PIPELINE. PROVIDE FORD MODEL F–700 CORP STOP AND ROMAC MODEL #202N SADDLE WITH EPOXY COATING AND STAINLESS STEEL STRAPS.

RECORD DRAWINGS

Revisions Drawn by S. Riggs Date November 2011
THESE RECORD DRAWINGS HAVE BEEN PREPARED, IN PART, ON THE BASIS OF INFORMATION COMPILED BY OTHERS. THEY ARE NOT INTENDED TO REPRESENT IN DETAIL THE EXACT LOCATION, TYPE OF COMPONENT NOR MANNER OF CONSTRUCTION. THE ENGINEER WILL NOT BE RESPONSIBLE FOR ANY ERRORS OR OMISSIONS WHICH HAVE BEEN INCORPORATED INTO THE RECORD DRAWINGS.

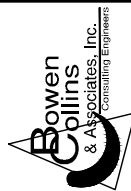

JORDAN VALLEY WATER CONSERVANCY DISTRICT
SOUTHWEST AQUEDUCT REACH 2 PROJECT

VERIFY SCALE
BAR IS ONE INCH ON ORIGINAL DRAWING

REVIEW
CHECKED M. COLLINS
APPROVED J. LUETTINGER

DESIGN
DESIGN T. OLSEN
DRAWN B. ABEL


GENERAL MECHANICAL
DETAILS – 4

DATE: FEBRUARY 2010 PROJECT NUMBER 010–08–03

DRAWING NO.

GM–4


SHEET 78 OF 110

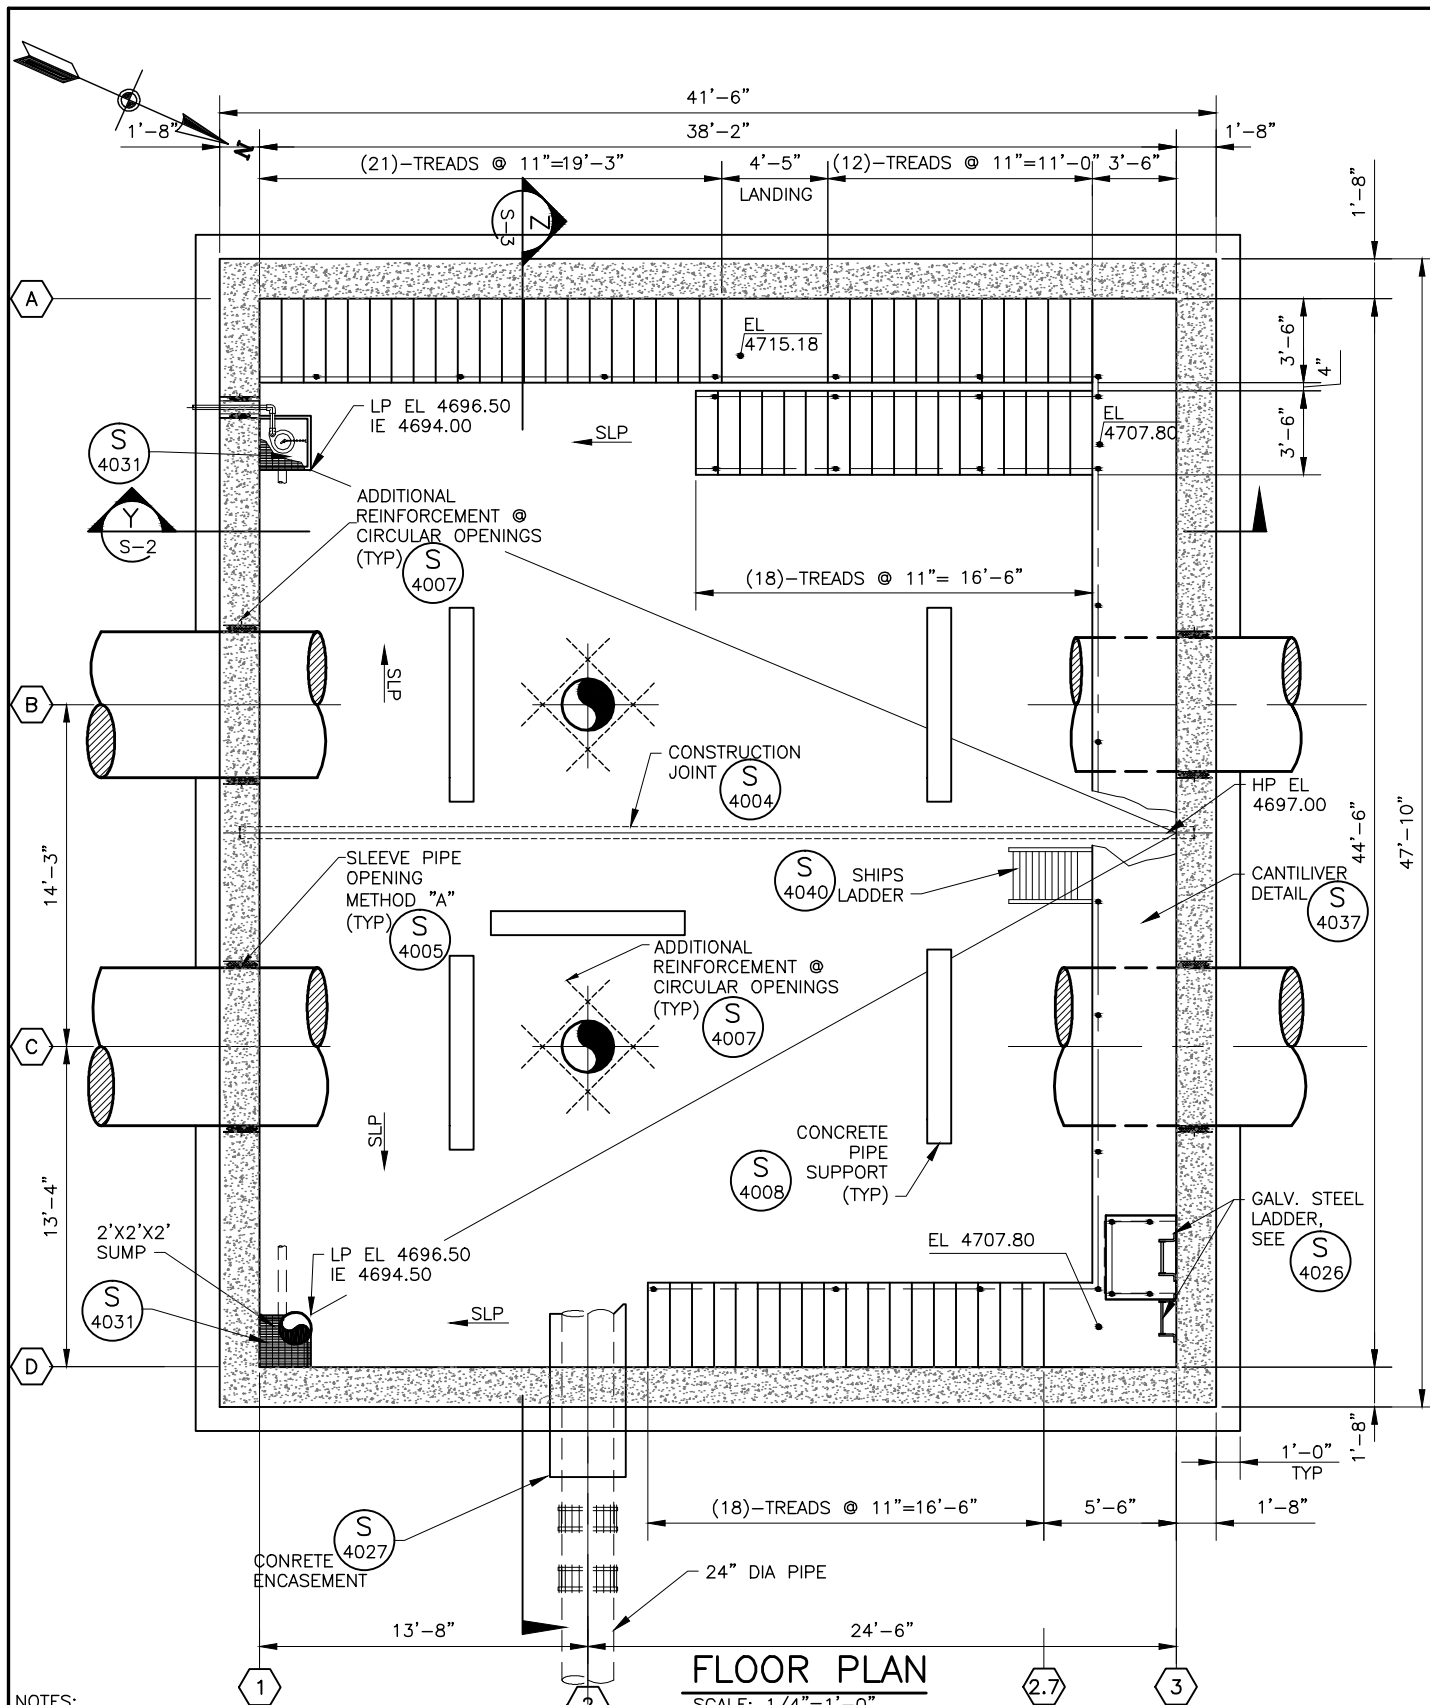

NOTES:


- COORDINATE WITH MECHANICAL DRAWINGS THE LOCATION OF PIPE PENETRATIONS, AND PIPE SUPPORTS.
- ALL CRACKS IN FLOOR, WALL, OR ROOF SLAB SHALL BE REPAIRED PER DETAIL S4012.
- SEE DRAWING GS-1 FOR GENERAL STRUCTURAL NOTES.
- SLOPE ROOF AND FLOOR OF VAULT AS SHOWN ON PLAN TO ENSURE FREE DRAINAGE FROM ENTIRE FLOOR AREA, DRAINAGE PROBLEMS CAUSED BY HIGH POINTS IN FLOOR SLAB SHALL BE CORRECTED AT CONTRACTORS EXPENSE.
- ALL PIPING UNDER FLOOR SLAB SHOULD BE CONCRETE ENCASED SEE S/4027.
- PROVIDE A MINIMUM OF 12" CLR SPACE BETWEEN PIPE SUPPORTS, COUPLINGS, AND WALLS.
- THE JWVCD INTERCONNECTION VAULT IS CLASSIFIED AS MILDLY-CORROSIVE ENVIRONMENT. ALL METAL FABRICATIONS AND HARDWARE SHALL CONFORM TO THE REQUIREMENTS OF SECTION 05500-MISCELLANEOUS METALS. ALL PROTECTIVE COATINGS SHALL CONFORM TO THE REQUIREMENTS OF SECTION 09900-COATING AND PAINTING.


- ALL HANDRAIL SHALL BE GALVANIZED STEEL SCHEDULE 40 STANDARD PIPE WITH STAINLESS STEEL HARDWARE UNLESS NOTED OTHERWISE.
- ALL STRUCTURAL SUPPORT STEEL, INCLUDING BEAMS, COLUMNS, AND MISCELLANEOUS SUPPORT ANGLES, SHALL BE GALVANIZED STEEL WITH STAINLESS STEEL HARDWARE.
- ALL GRATING SHALL BE ALUMINUM.
- ALL LADDERS SHALL BE GALVANIZED STEEL WITH STAINLESS STEEL HARDWARE.
- ALL LARGE DIAMETER (>24") FLANGE HARDWARE, INCLUDING BOLTS, NUTS, AND WASHERS, SHALL BE CARBON STEEL, ASTM A307, GRADE A AND COATED IN ACCORDANCE WITH SECTION 09900-COATING AND PAINTING.
- COAT INTERIOR FLOOR OF VAULT WITH NON-SKID PROTECTIVE COATING IN ACCORDANCE WITH SECTION 09900 - COATING AND PAINTING. EXTEND COATING ON WALLS TO AN ELEVATION OF 1'-6" ABOVE FLOOR.

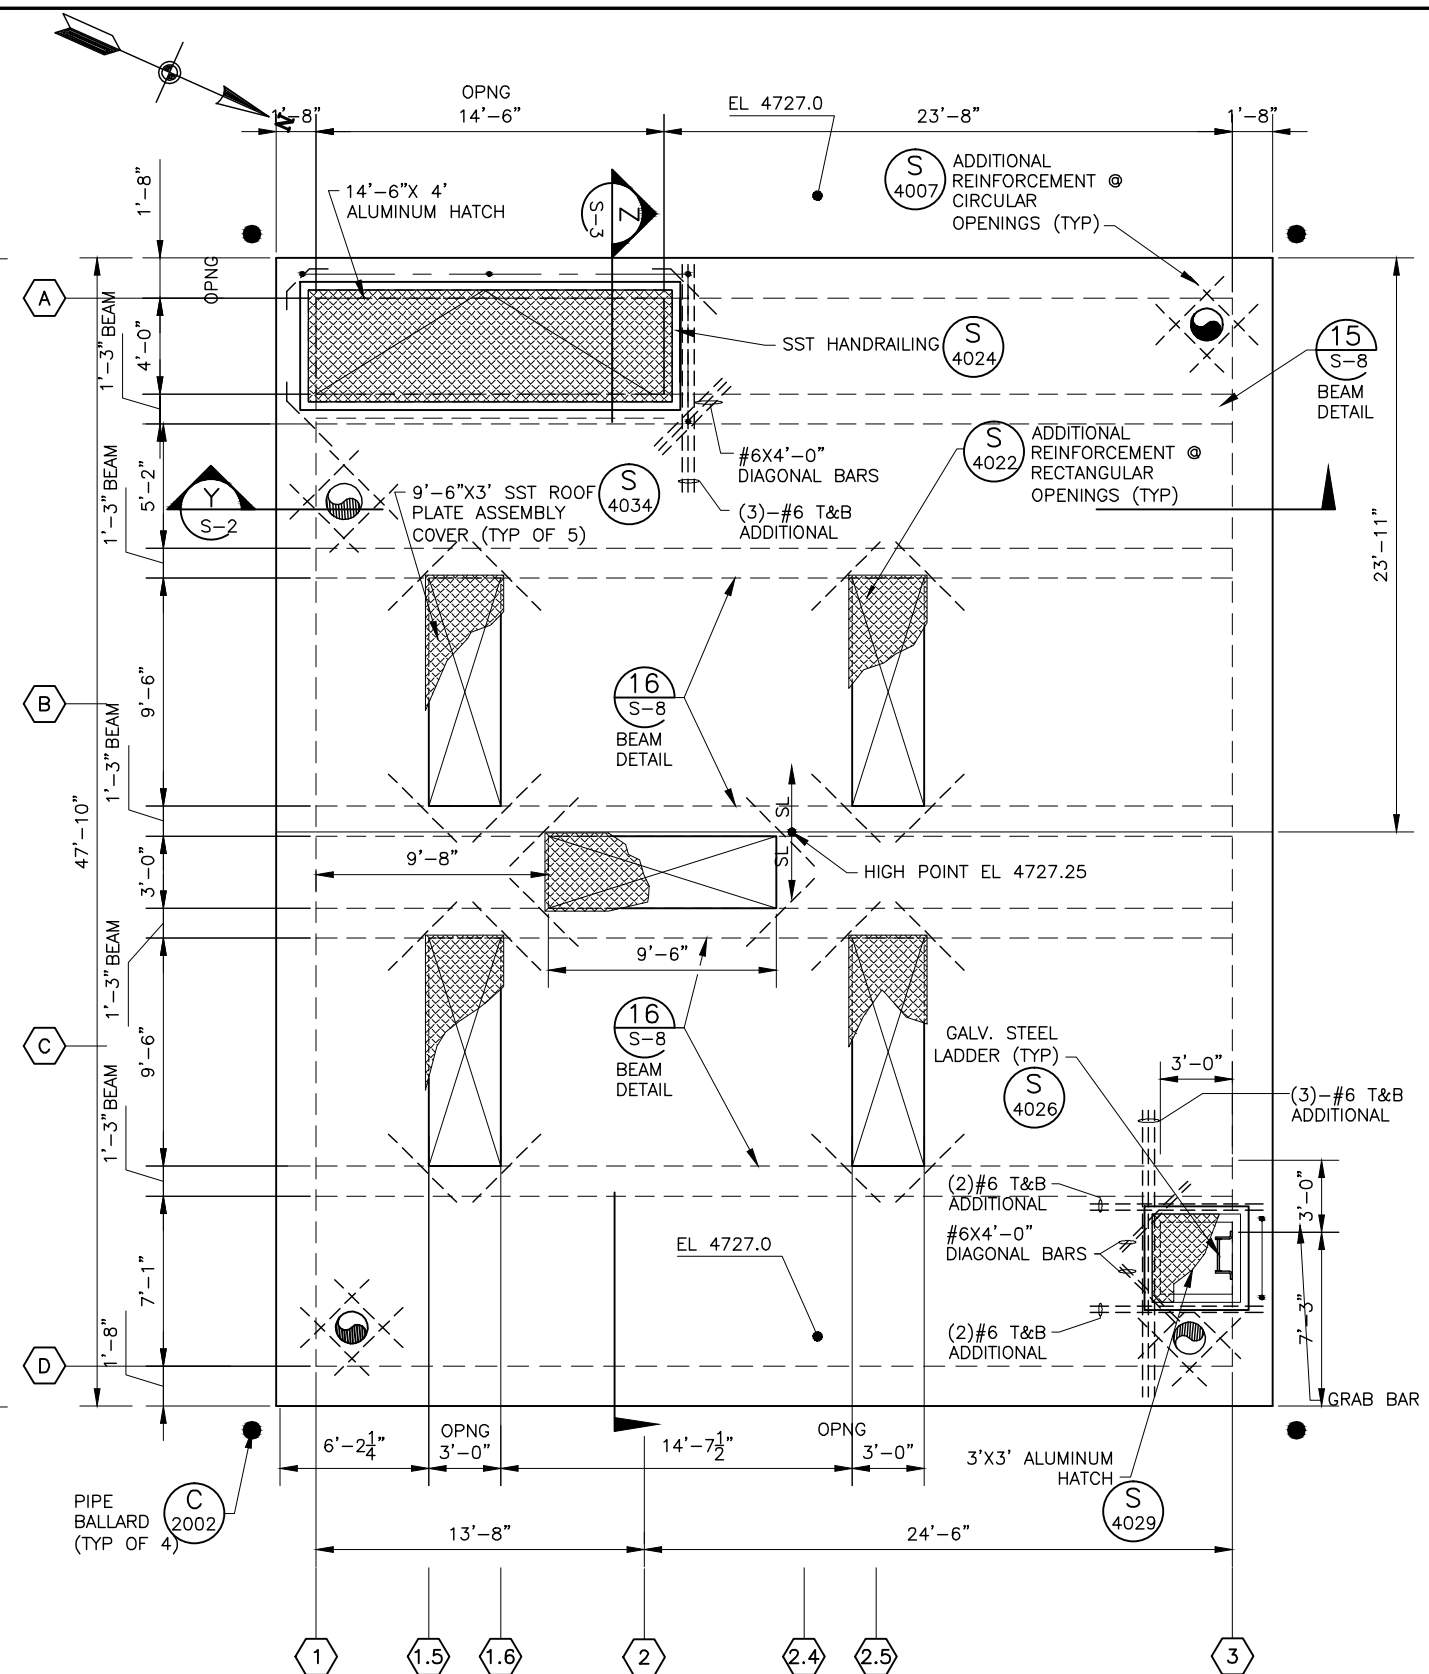

RECORD DRAWINGS
SCALE: 1/4"=1'-0"


Revisions Drawn by S. Riggs Date November 2011
 THESE RECORD DRAWINGS HAVE BEEN PREPARED, IN PART, ON THE BASIS OF INFORMATION COMPILED BY OTHERS. THEY ARE NOT INTENDED TO REPRESENT IN DETAIL THE EXACT LOCATION, TYPE OF COMPONENT NOR MANNER OF CONSTRUCTION. THE ENGINEER WILL NOT BE RESPONSIBLE FOR ANY ERRORS OR OMISSIONS WHICH HAVE BEEN INCORPORATED INTO THE RECORD DRAWINGS.

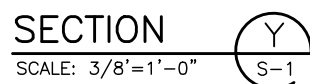

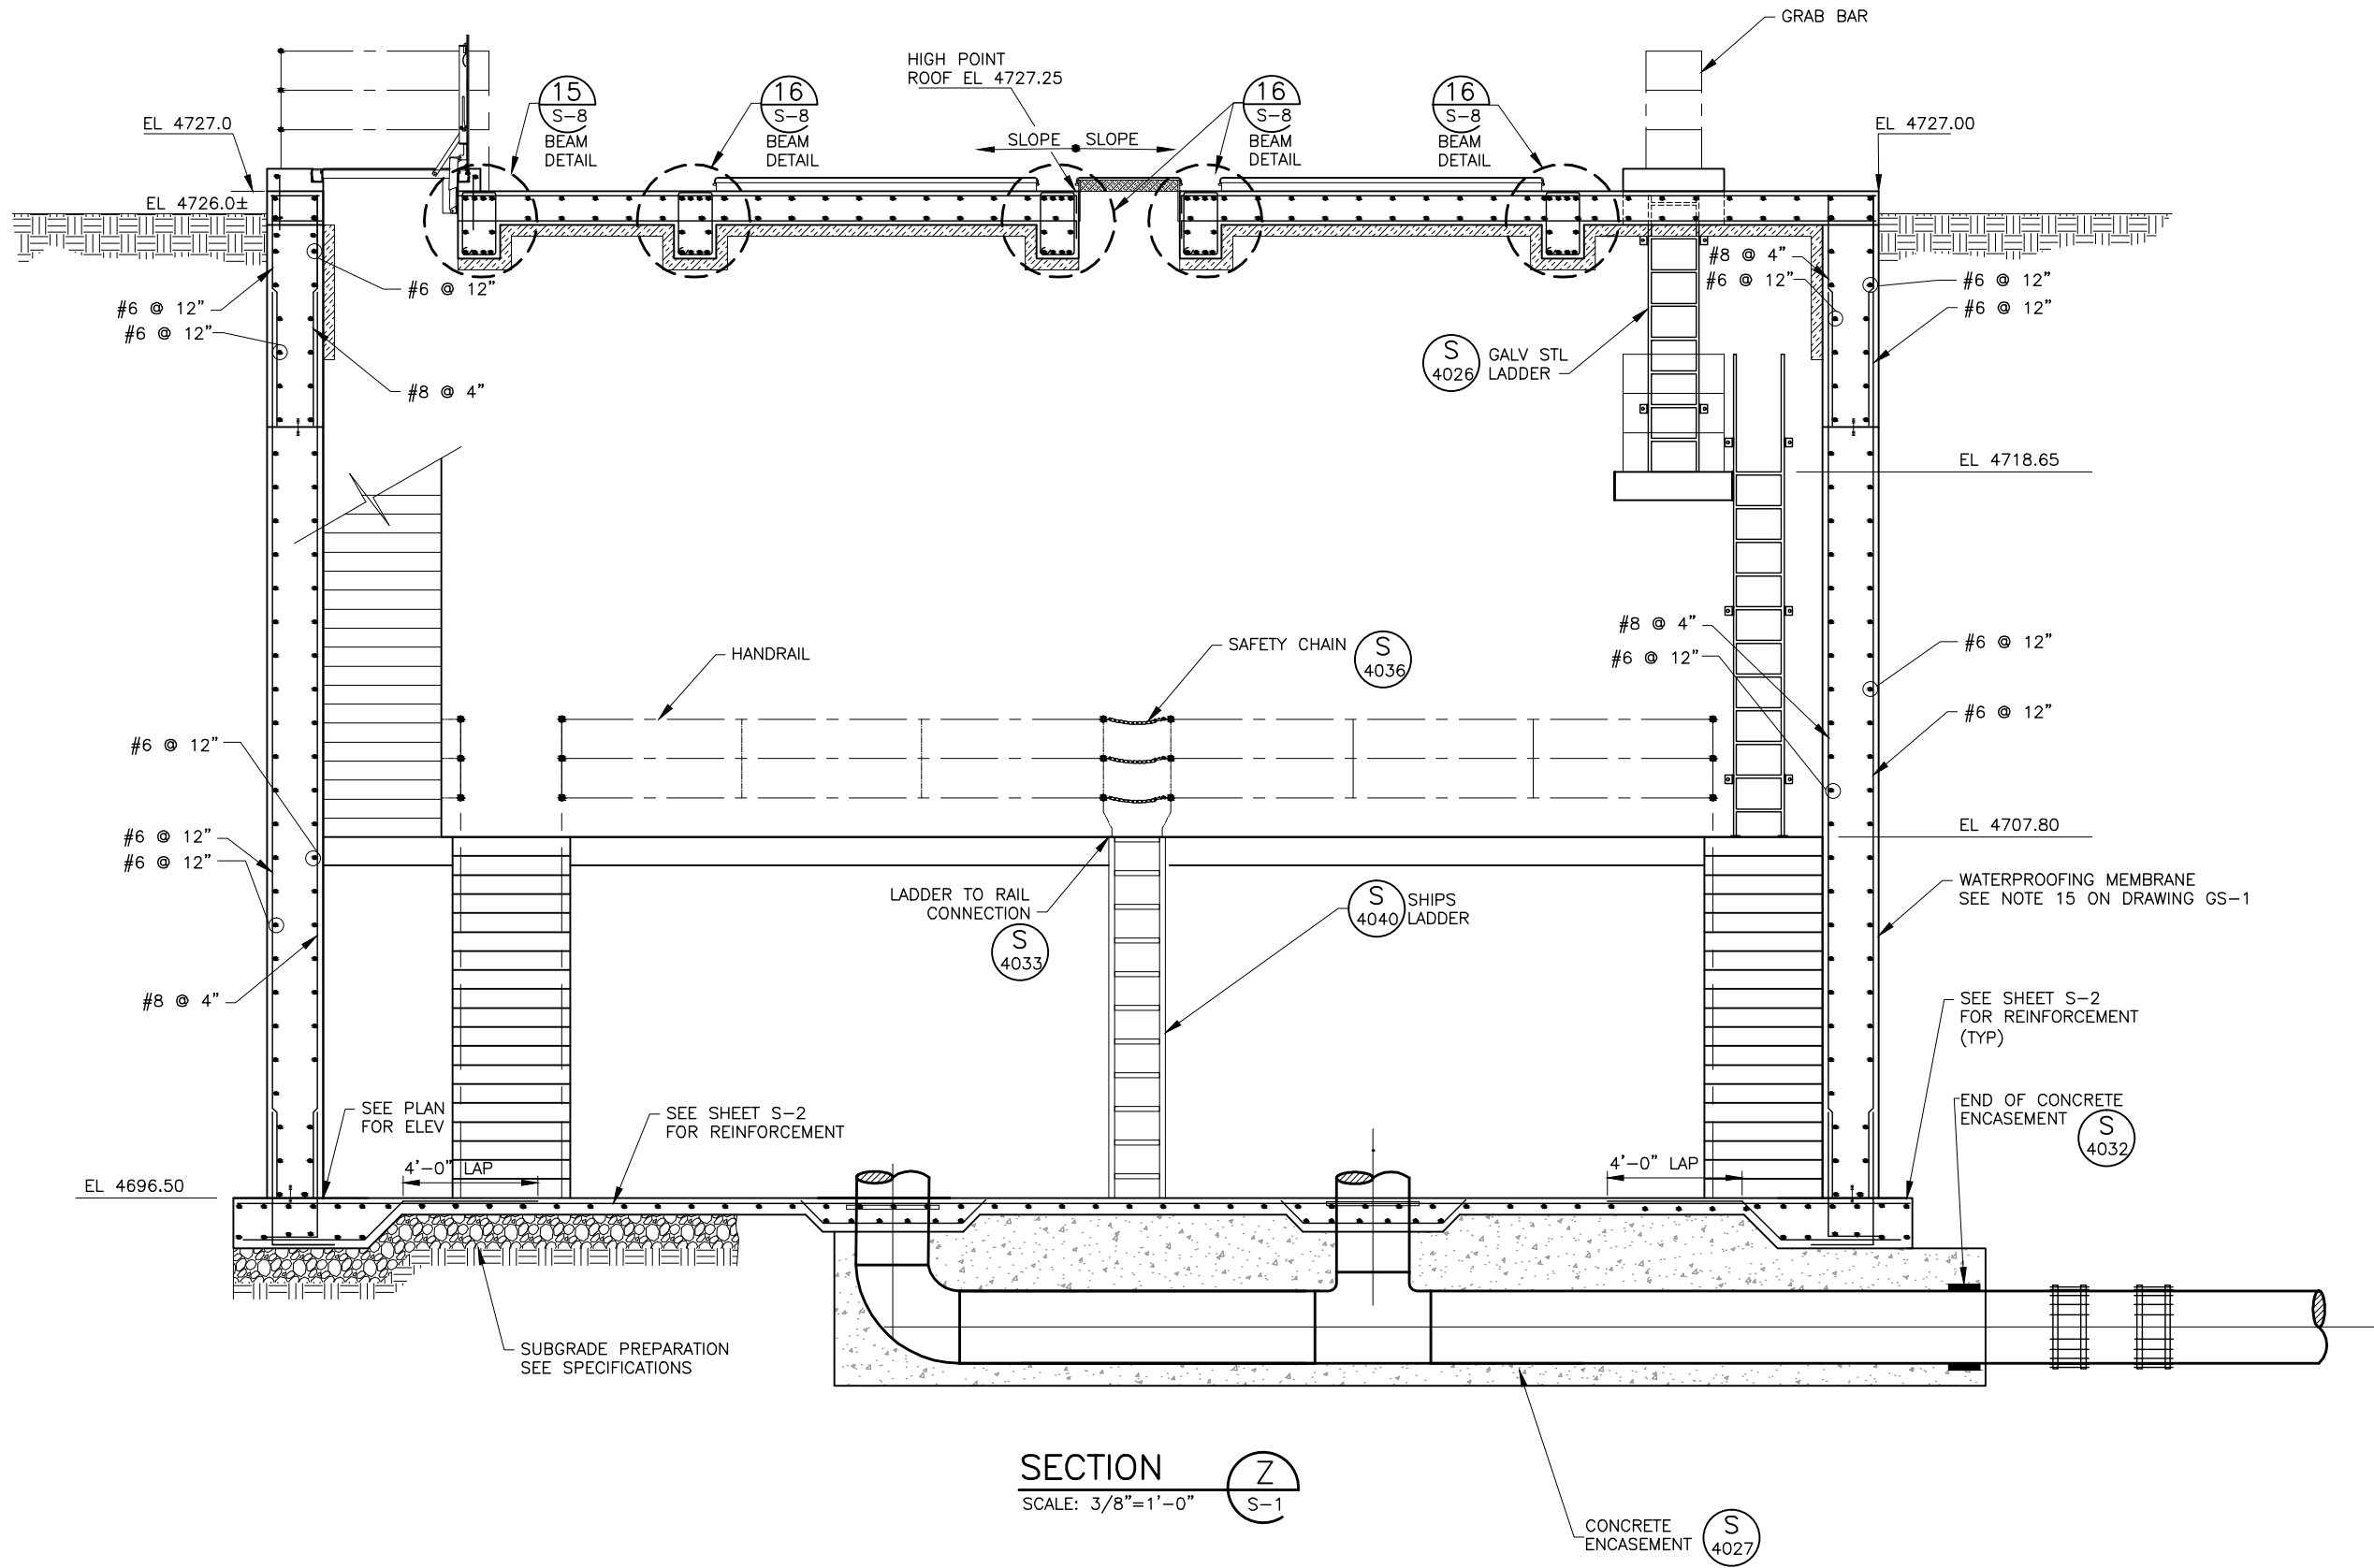

SECTION Z
SCALE: 3/8"=1'-0" S-1

RECORD DRAWINGS
Revisions Drawn by S. Riggs Date November 2011
THESE RECORD DRAWINGS HAVE BEEN PREPARED, IN PART, ON THE BASIS OF INFORMATION COMPILED BY OTHERS. THEY ARE NOT INTENDED TO REPRESENT IN DETAIL THE EXACT LOCATION, TYPE OF COMPONENT NOR MANNER OF CONSTRUCTION. THE ENGINEER WILL NOT BE RESPONSIBLE FOR ANY ERRORS OR OMISSIONS WHICH HAVE BEEN INCORPORATED INTO THE RECORD DRAWINGS.

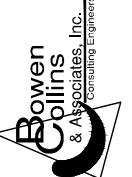

JORDAN VALLEY WATER CONSERVANCY DISTRICT
SOUTHWEST AQUEDUCT REACH 2 PROJECT

STRUCTURAL
JWTP INTERCONNECTION VAULT - SECTION
PROJECT NUMBER 010-08-03

DATE: FEBRUARY 2010



DRAWING NO.
S-3
SHEET 81 OF 110

NO.	DATE	REV. BY	DESCRIPTION
REVISIONS			

VERIFY SCALE
BAR IS ONE INCH ON ORIGINAL DRAWING

DESIGN M.R./R.G.
DRAWN R. GARCIA

REVIEW M. COLLINS
CHECKED J. LUETTINGER
APPROVED J. LUETTINGER

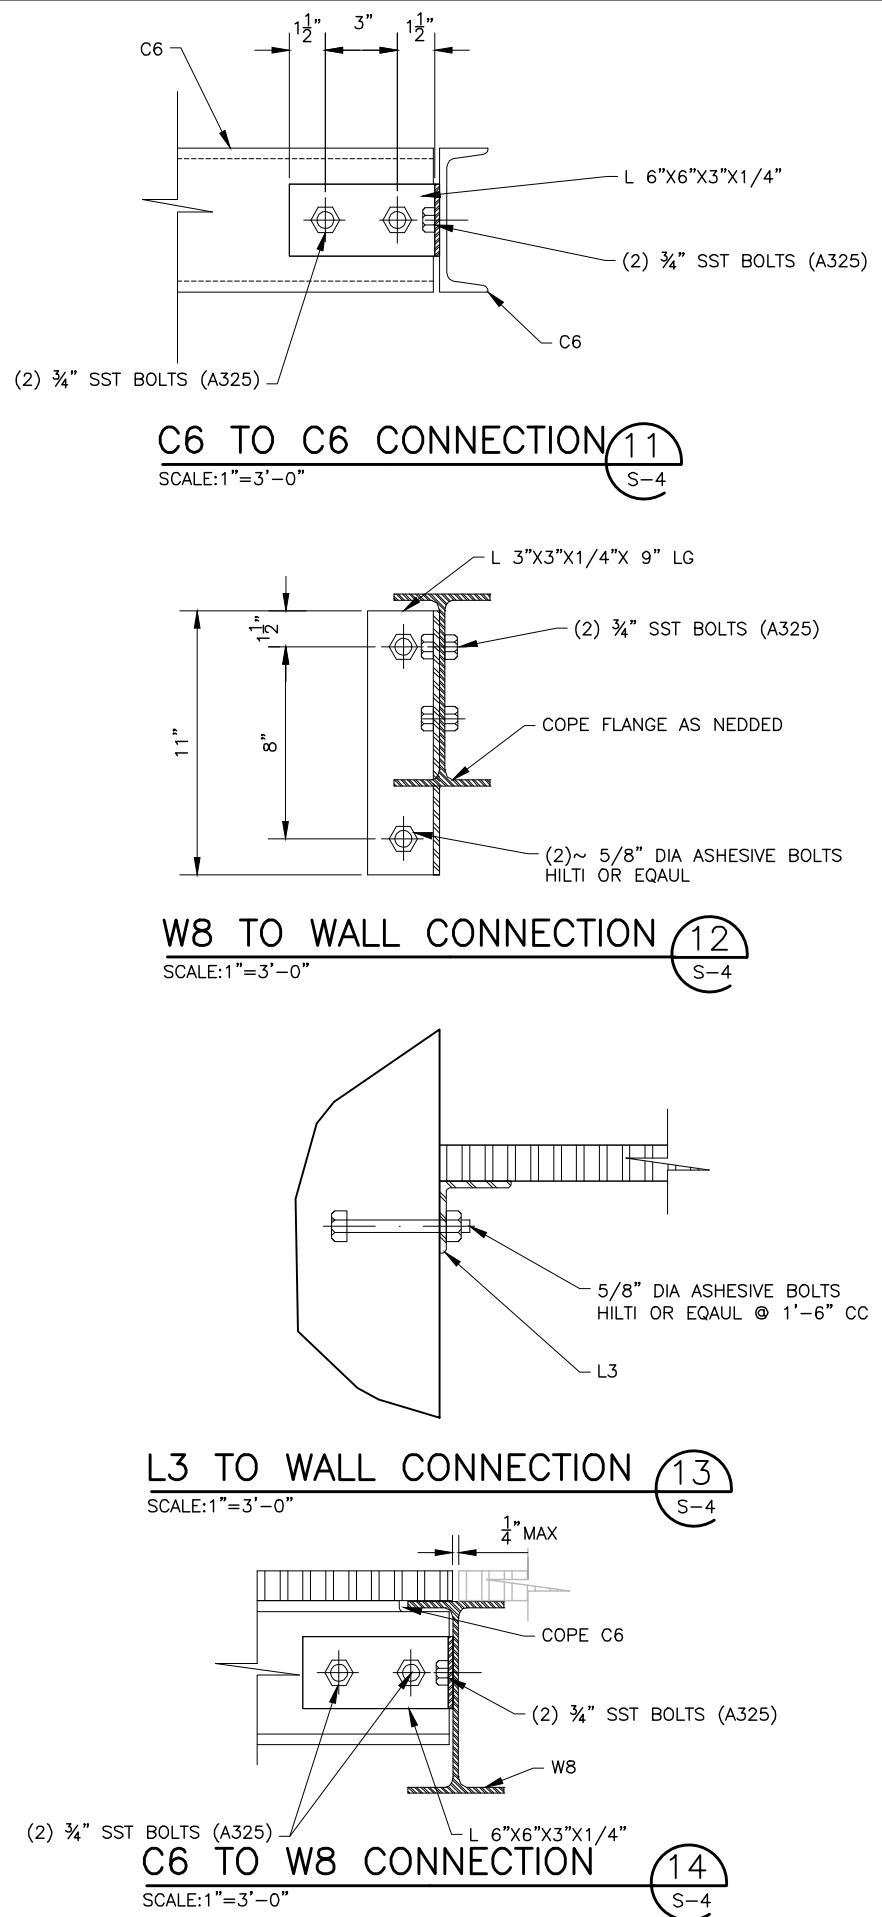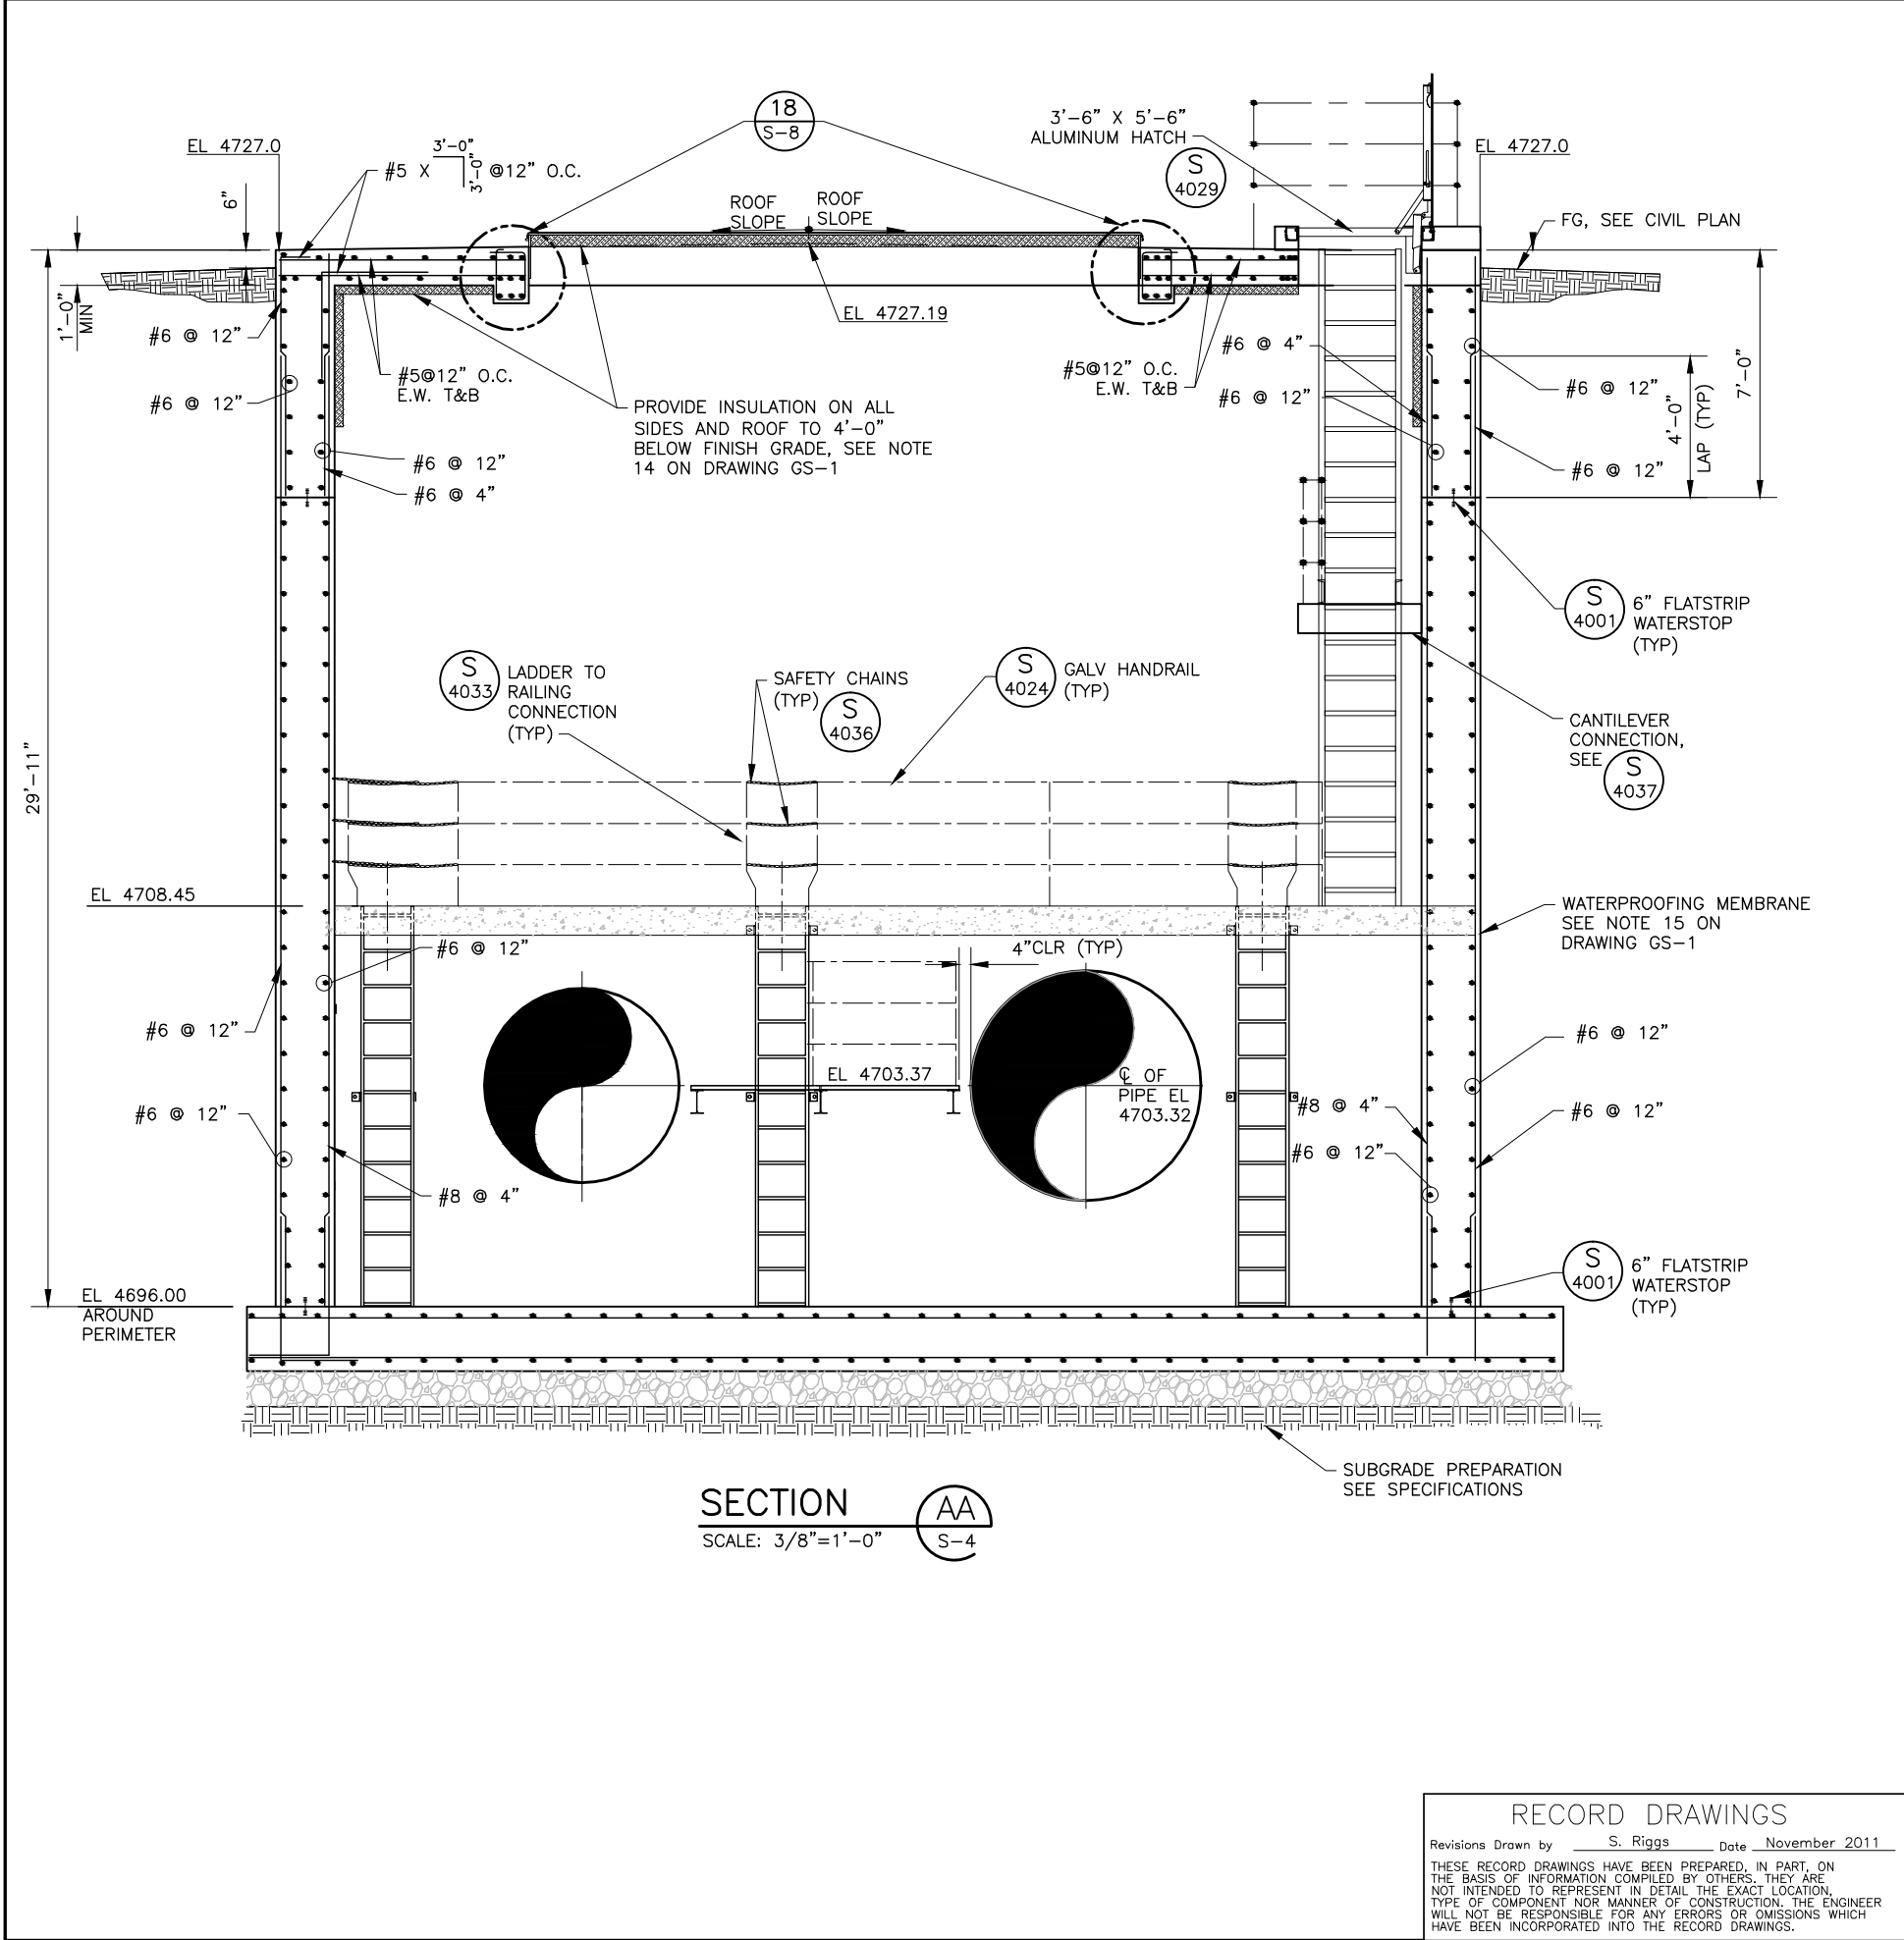

RECORD DRAWINGS

Revisions Drawn by S. Riggs Date November 2011

THESE RECORD DRAWINGS HAVE BEEN PREPARED, IN PART, ON THE BASIS OF INFORMATION COMPILED BY OTHERS. THEY ARE NOT INTENDED TO REPRESENT IN DETAIL THE EXACT LOCATION, TYPE OF COMPONENT NOR MANNER OF CONSTRUCTION. THE ENGINEER WILL NOT BE RESPONSIBLE FOR ANY ERRORS OR OMISSIONS WHICH HAVE BEEN INCORPORATED INTO THE RECORD DRAWINGS.

NO.		DATE	REV. BY	DESCRIPTION
REVISIONS				

JORDAN VALLEY WATER CONSERVANCY DISTRICT

SOUTHWEST AQUEDUCT REACH 2 PROJECT

DESIGN	REVIEW	VERIFY SCALE
DESIGN MR/RG	CHECKED M. COLINS	BAR IS ONE INCH ON ORIGINAL DRAWING
DRAWN R. GARCIA	APPROVED M. ROBLEZ	

STRUCTURAL

METER VAULT


SECTIONS AND DETAILS

DRAWING NO. S-5

DATE: FEBRUARY 2010

PROJECT NUMBER 010-08-03

SHEET 83 OF 110

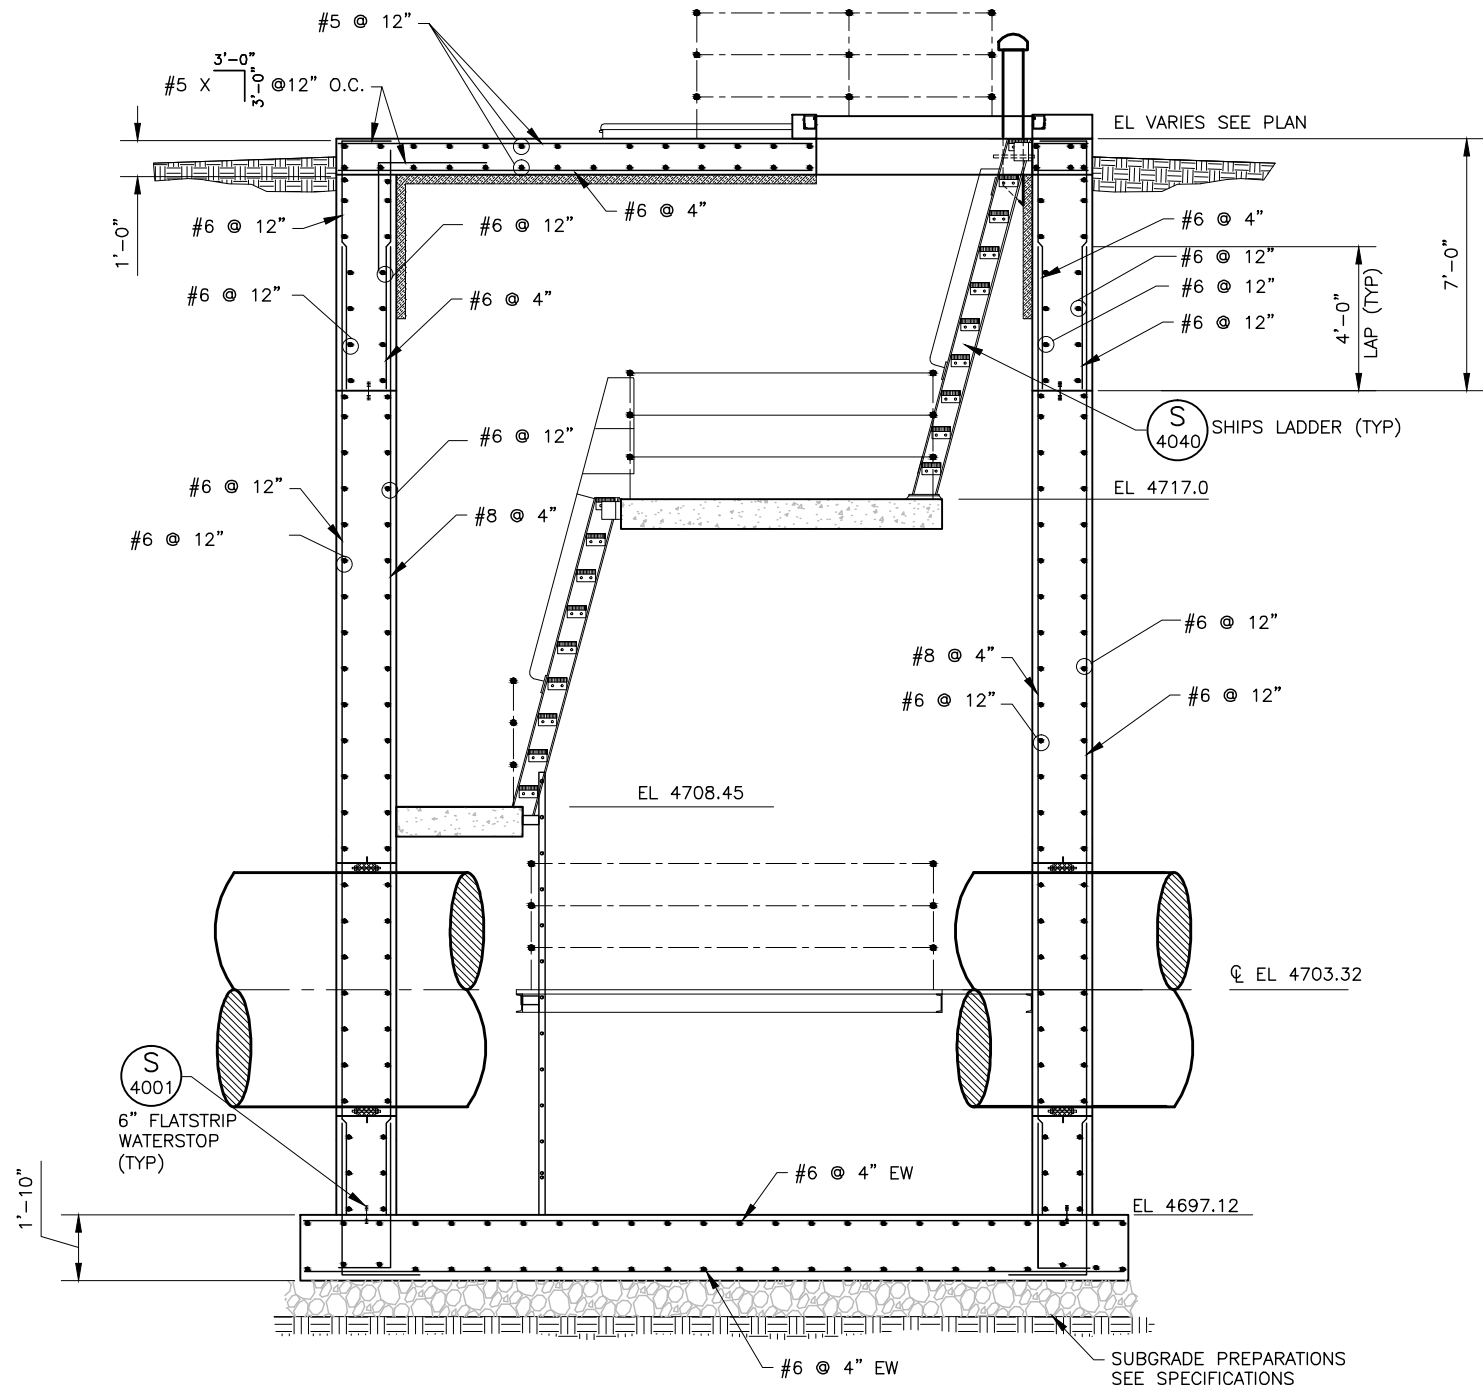

SECTION BB
SCALE: 3/8"=1'-0"

RECORD DRAWINGS

Revisions Drawn by S. Riggs Date November 2011

THESE RECORD DRAWINGS HAVE BEEN PREPARED, IN PART, ON THE BASIS OF INFORMATION COMPILED BY OTHERS. THEY ARE NOT INTENDED TO REPRESENT IN DETAIL THE EXACT LOCATION, TYPE OF COMPONENT NOR MANNER OF CONSTRUCTION. THE ENGINEER WILL NOT BE RESPONSIBLE FOR ANY ERRORS OR OMISSIONS WHICH HAVE BEEN INCORPORATED INTO THE RECORD DRAWINGS.

DRAWING NO.

S-6

SHEET 84 OF 110

JORDAN VALLEY WATER CONSERVANCY DISTRICT
SOUTHWEST AQUEDUCT REACH 2 PROJECT


VERIFY SCALE
BAR IS ONE INCH ON ORIGINAL DRAWING


REVIEW
CHECKED M. COLLINS
APPROVED M. ROBLEZ


DESIGN
DESIGN M. ROBLEZ
DRAWN R. GARCIA

STRUCTURAL
METER VAULT
SECTIONS AND DETAILS
DATE: FEBRUARY 2010
PROJECT NUMBER 010-08-03

NO. 3
DATE 6/2010
REV. BY OLSEN
DESCRIPTION FIELD ORDER NO. 3
REVISIONS

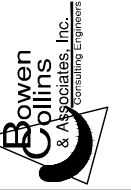

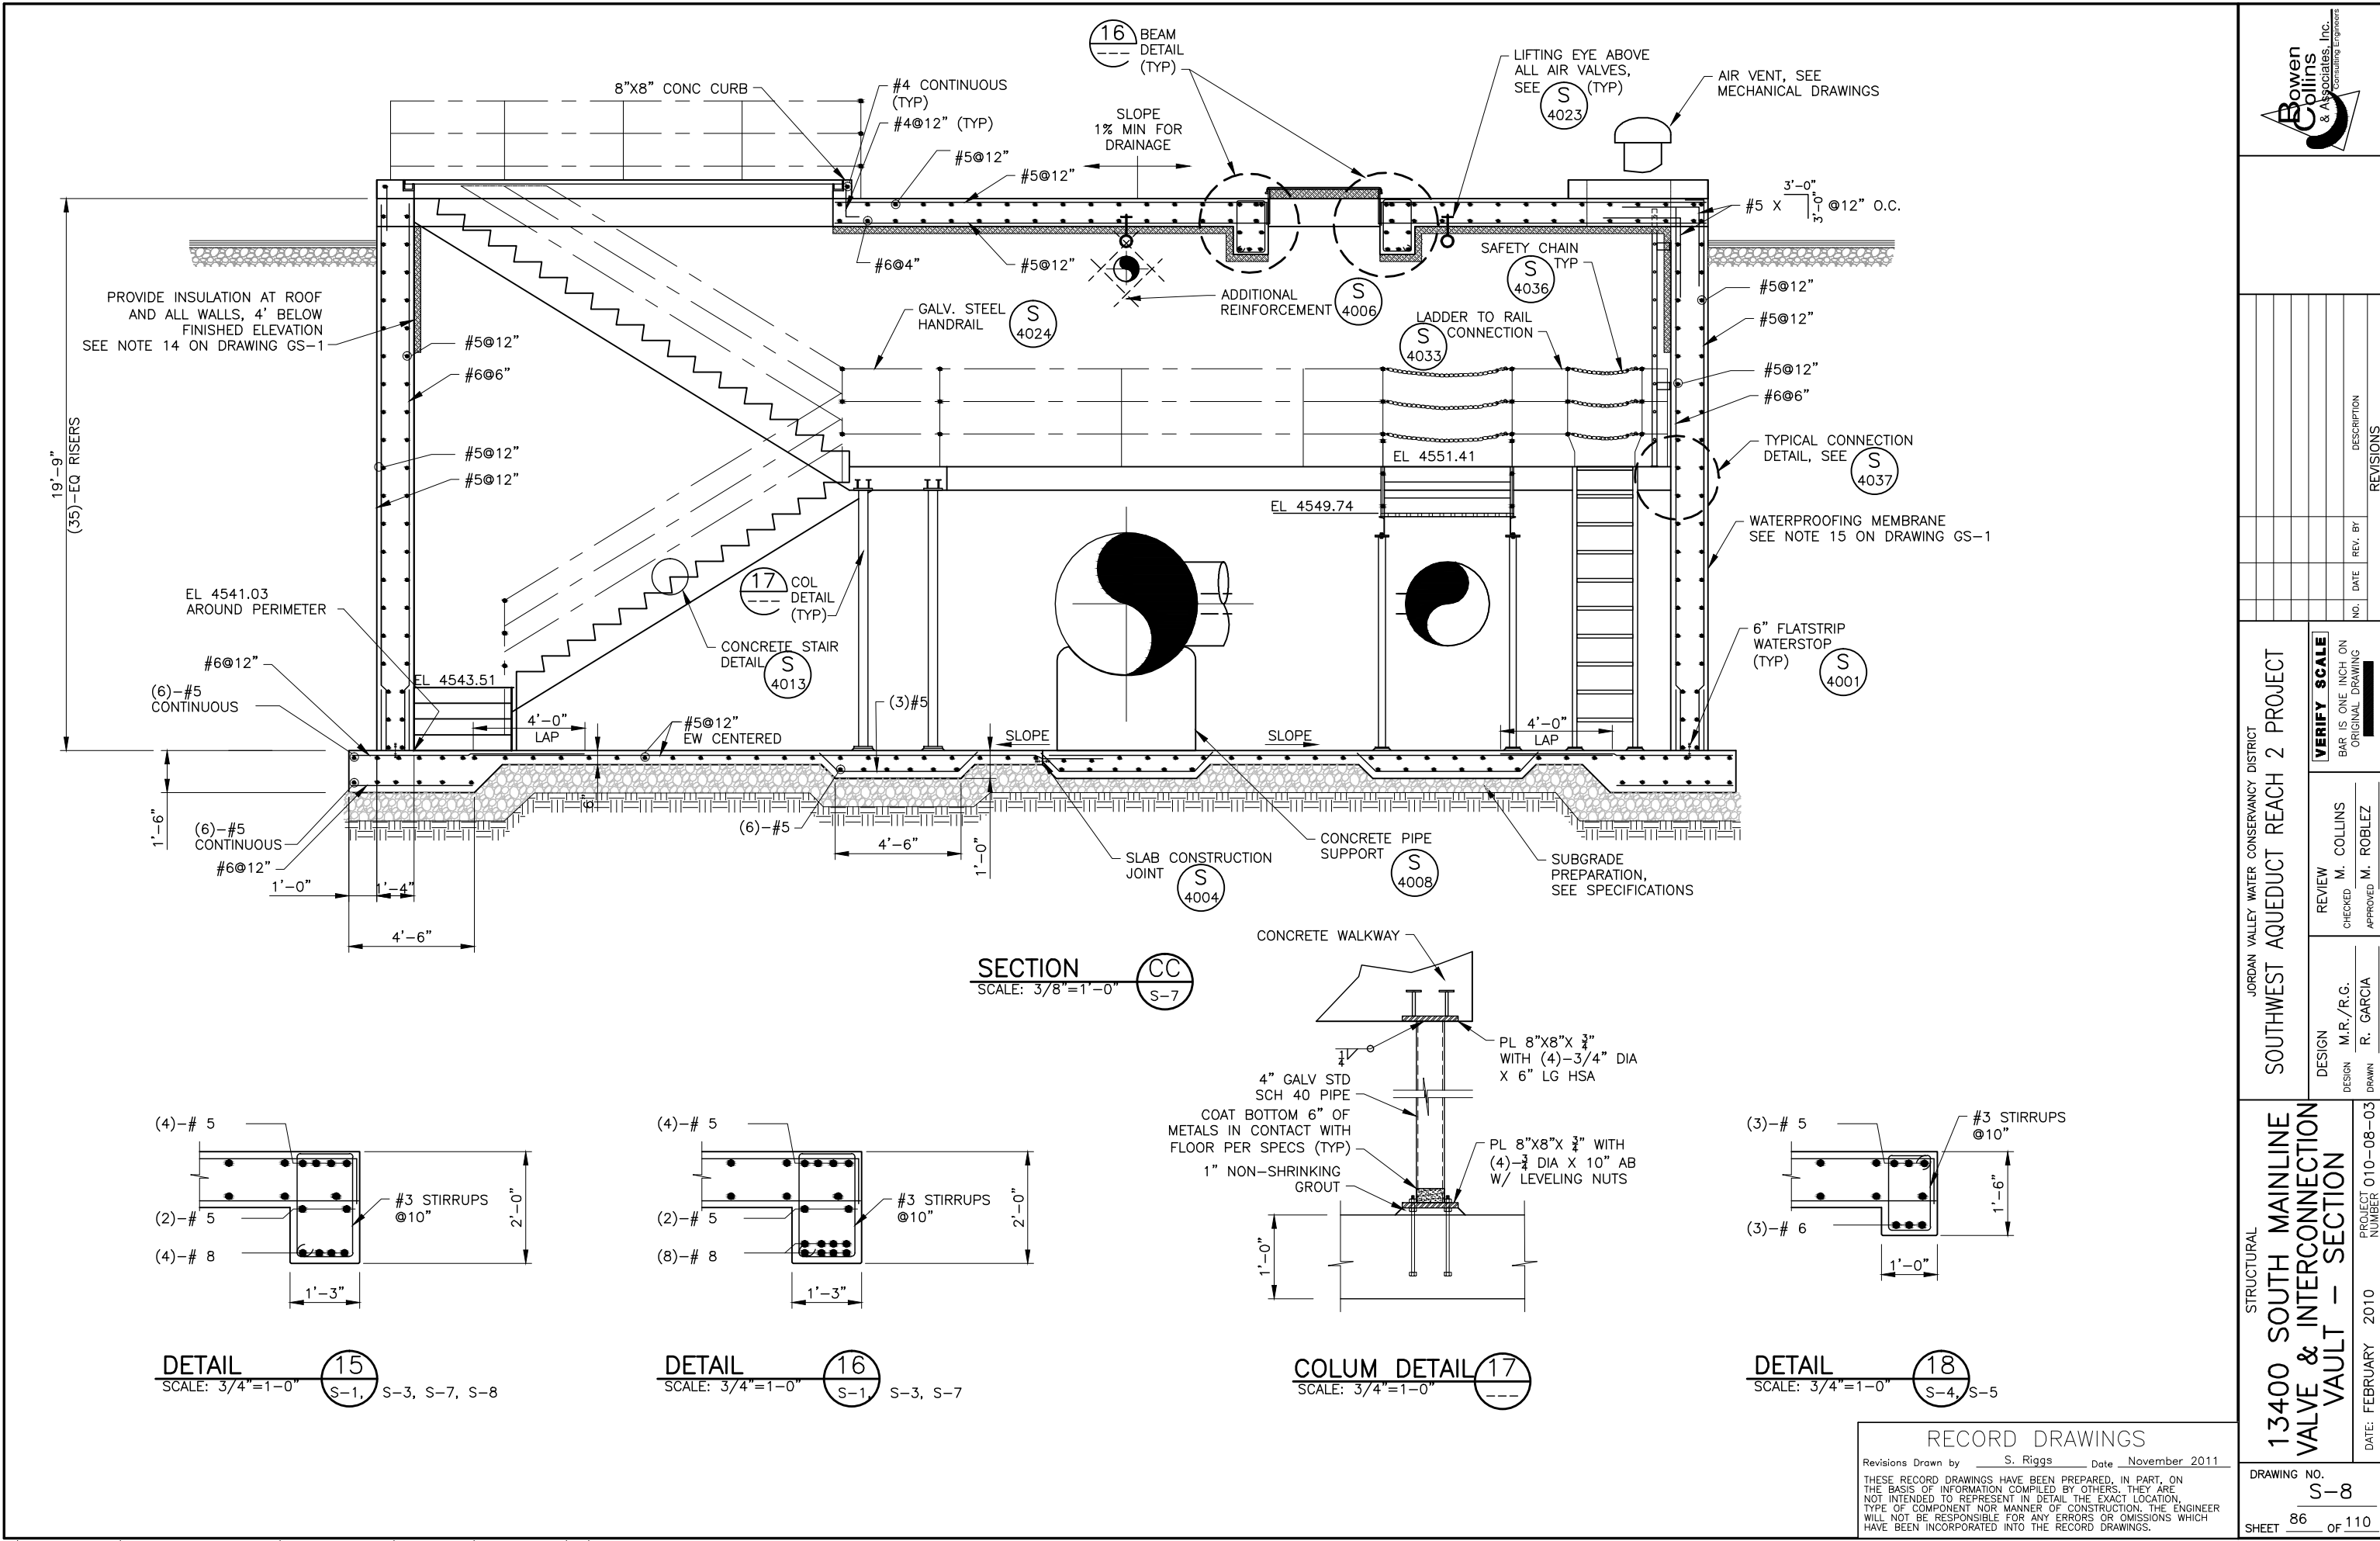

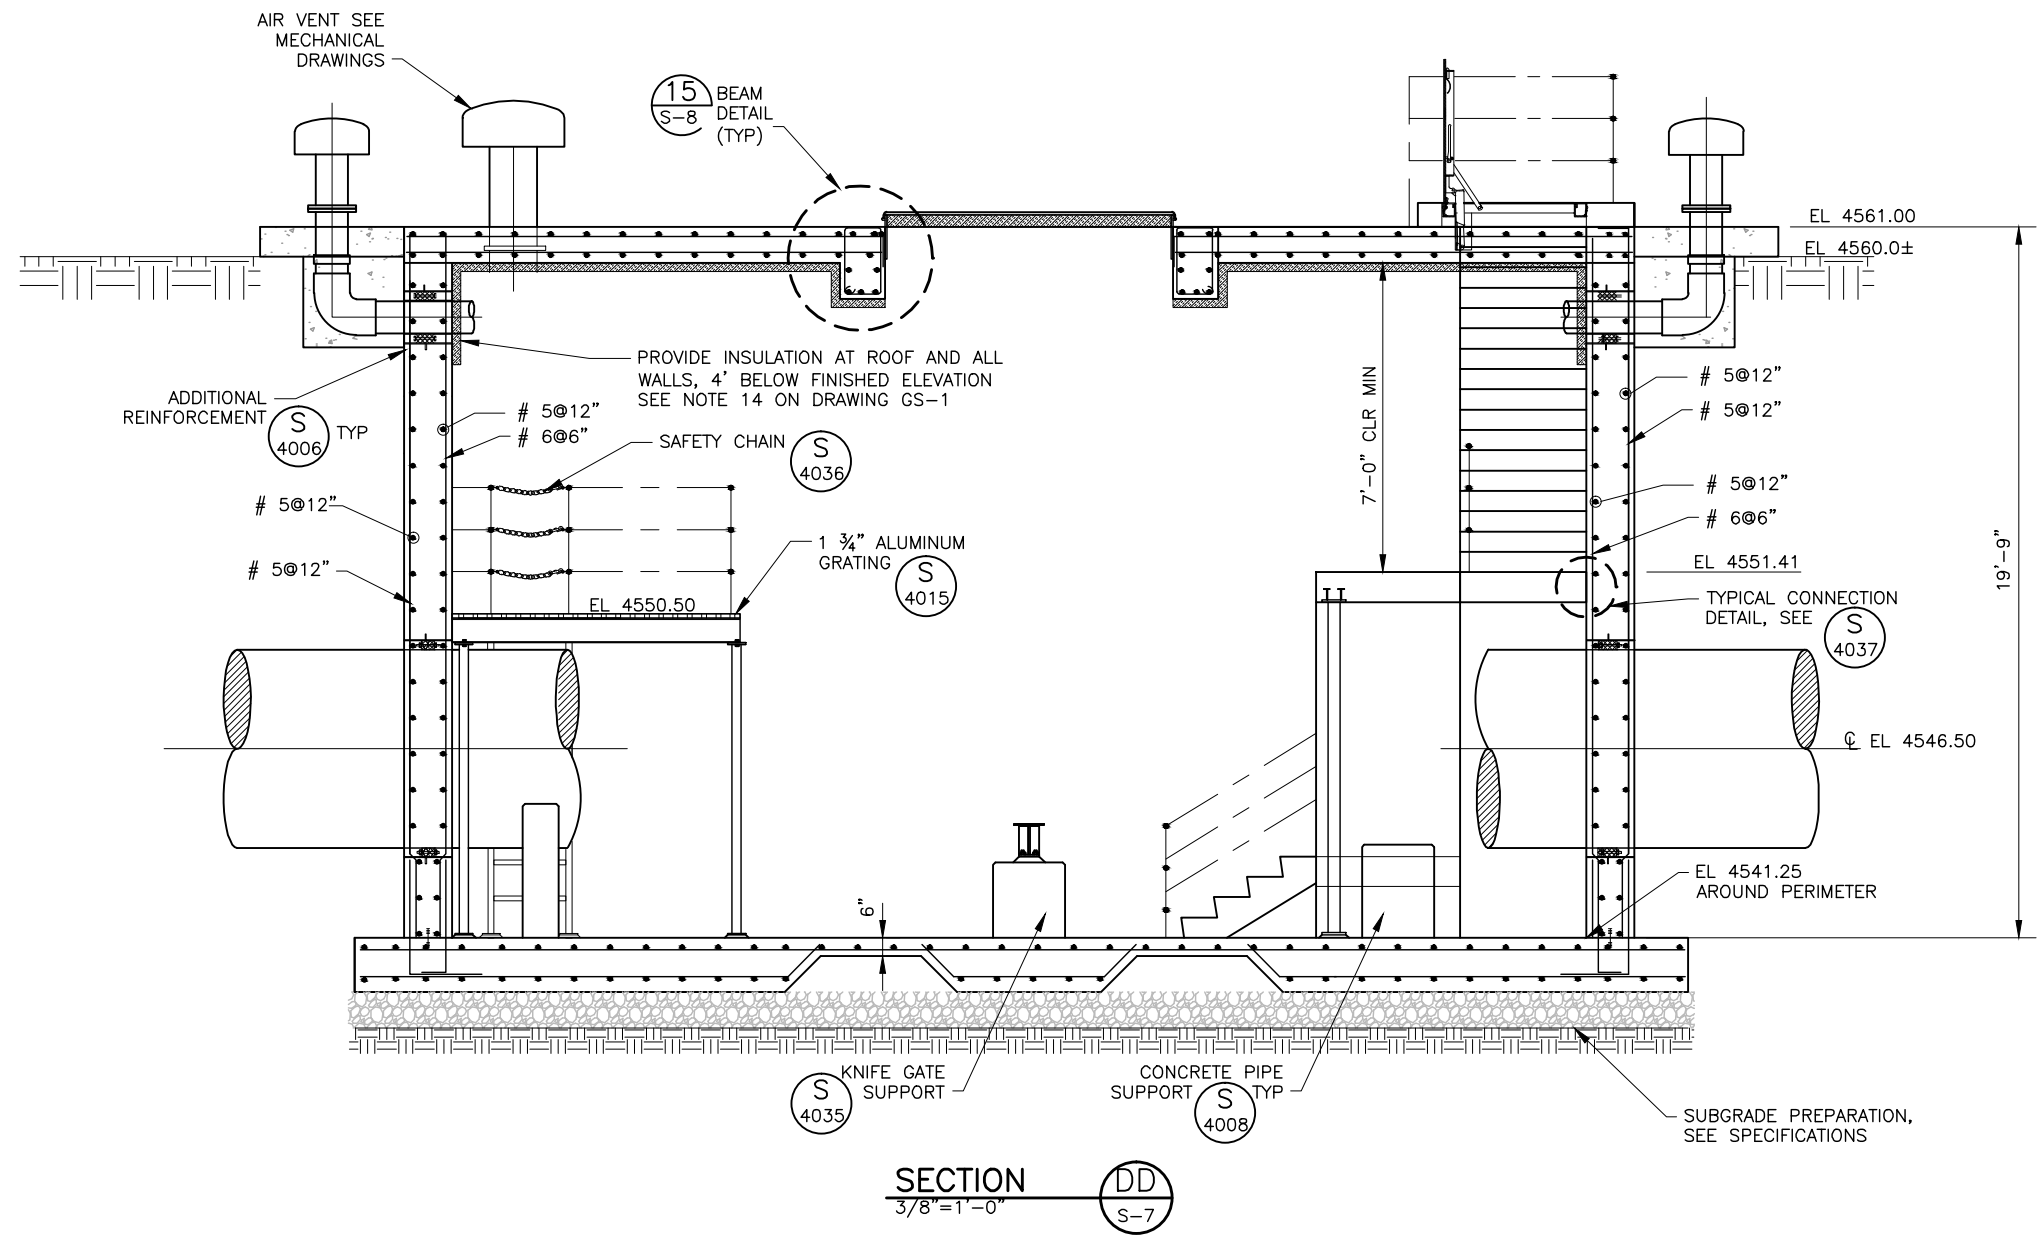

RECORD DRAWINGS

Revisions Drawn by S. Riggs Date November 2011

THESE RECORD DRAWINGS HAVE BEEN PREPARED, IN PART, ON THE BASIS OF INFORMATION COMPILED BY OTHERS. THEY ARE NOT INTENDED TO REPRESENT IN DETAIL THE EXACT LOCATION, TYPE OF COMPONENT NOR MANNER OF CONSTRUCTION. THE ENGINEER WILL NOT BE RESPONSIBLE FOR ANY ERRORS OR OMISSIONS WHICH HAVE BEEN INCORPORATED INTO THE RECORD DRAWINGS.



13400 SOUTH MAINLINE VALVE & INTERCONNECT VAULT - SECTION

STRUCTURAL

JORDAN VALLEY WATER CONSERVANCY DISTRICT



SOUTHWEST AQUEDUCT REACH 2 PROJECT

DESIGN		REVIEW		VERIFY SCALE	
DESIGN	DRAWN	CHECKED	APPROVED	BAR IS ONE INCH ON ORIGINAL DRAWING	
M. ROBLEZ	R. GARCIA	M. COLLINS	M. ROBLEZ	<div style="width: 100px; height: 10px; background-color: black;"></div>	

PROJECT		DATE		REVISIONS	
PROJECT NUMBER	DATE	NO.	DATE	REV. BY	DESCRIPTION
010-08-03	2010 FEBRUARY				

DRAWING NO. **S-9**

SHEET **87** OF **110**

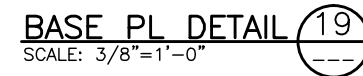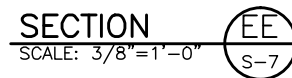

THESE RECORD DRAWINGS HAVE BEEN PREPARED, IN PART, ON THE BASIS OF INFORMATION COMPILED BY OTHERS. THEY ARE NOT INTENDED TO REPRESENT IN DETAIL THE EXACT LOCATION, TYPE OF COMPONENT NOR MANNER OF CONSTRUCTION. THE ENGINEER WILL NOT BE RESPONSIBLE FOR ANY ERRORS OR OMISSIONS WHICH HAVE BEEN INCORPORATED INTO THE RECORD DRAWINGS.

DRAWING NO.
S-10

SHEET 88 OF 110

CONCRETE:

ALL CONCRETE MATERIALS SHALL COMPLY WITH THE STANDARDS SPECIFIED IN THE LATEST EDITION OF THE ACI 318 BUILDING CODE. EACH MIX DESIGN SHALL BE REVIEWED BY AN APPROVED INDEPENDENT LABORATORY, AND SHALL BE SUBMITTED TO THE ENGINEER AT LEAST 2 WEEKS PRIOR TO THE PLACEMENT OF CONCRETE. CONTRACTOR SHALL INFORM THE ENGINEER AT LEAST 2 DAYS PRIOR TO PLACING ANY CONCRETE SO THAT THE ENGINEER MAY HAVE THE OPPORTUNITY TO REVIEW THE WORK.

CONCRETE SHALL CONSIST OF TYPE II CEMENT WITH A MAXIMUM C3A CONTENT OF 5 PERCENT. THE MAXIMUM WATER–CEMENT RATIO SHALL BE 0.45.

CONCRETE TESTING SHALL BE PERFORMED BY AN APPROVED INDEPENDENT TESTING LABORATORY. THE TESTING AGENCY SHALL TEST (4) CYLINDERS FROM EACH CLASS OF CONCRETE USED EACH DAY. A MINIMUM OF (1) SAMPLE MUST BE TAKEN FROM EACH 50 CUBIC YARDS OF CONCRETE.

LOCATION –	SPECIAL INSPECT.	SLUMP (MAX)	AGGREGATE (MAX SIZE)	COMPRESSIVE STRENGTH (PSI)
FOOTINGS	YES	4	1" DIA	4000
STEM WALLS	YES	4	1" DIA	4000
SLAB ON GRADE	YES	5	3/4" DIA	4000

ANY CONCRETE THAT FAILS TO MEET SPECIFICATIONS SHALL BE REMOVED AND REPLACED AT THE EXPENSE OF THE CONTRACTOR.

THE CONTRACTOR SHALL BE RESPONSIBLE FOR THE CONSTRUCTION, DESIGN, PLACEMENT AND REMOVAL OF ALL FORMWORK. ALL SHORING DURING PLACEMENT OF CONCRETE IS THE SOLE RESPONSIBILITY OF THE CONTRACTOR.

CONCRETE SHALL BE SPECIALLY INSPECTED PER IBC 2006 TABLE 1704.4

CONCRETE REINFORCING:

ALL REINFORCING BARS SHALL CONFORM TO ASTM A–615 GRADE 60, Fy=60,000 PSI MIN., UNLESS NOTED OTHERWISE. BARS SHALL BE TIED SECURE PRIOR TO PLACEMENT OF CONCRETE TO MAINTAIN PROPER PLACEMENT AFTER CONCRETE IS IN PLACE. LAP ALL BARS 40 DIAMETERS UNLESS NOTED OTHERWISE. SPLICE BARS ONLY WHERE SHOWN ON PLANS.

MAINTAIN THE FOLLOWING CONCRETE COVERAGES FOR CONCRETE REINFORCING:

UNFORMED SURFACES IN CONTACT WITH EARTH.....3”
FORMED SURFACES IN CONTACT WITH EARTH.....2”
FORMED SURFACES EXPOSED TO OUTSIDE WEATHER.....2”
SLABS AND WALLS NOT EXPOSED TO WEATHER.....1 ½”
CLEAR DISTANCE BETWEEN BARS.....2” U.N.O.
STEEL PIPE TO CONCRETE SURFACE.....2”

SHOP DRAWINGS OF ALL BARS AND LOCATIONS SHALL BE SUBMITTED TO THE ENGINEER FOR REVIEW PRIOR TO FABRICATION. NORMAL WEIGHT CONCRETE SHALL HAVE A UNIT WEIGHT OF POUNDS PER CUBIC FOOT. USE OF CALCIUM CHLORIDE IS NOT PERMITTED IN ANY CONCRETE MIXES. ALL OTHER ADDITIVES AND ADMIXTURES MUST HAVE THE WRITTEN APPROVAL OF THE ENGINEER. THE ENGINEER SHALL HAVE 10 BUSINESS DAYS TO REVIEW SHOP DRAWINGS.

FOUNDATIONS:

MAXIMUM ALLOWABLE SOIL PRESSURE: = 1500 PSF. PER GEOTECHNICAL INVESTIGATION REPORT TITLED "GEOTECHNICAL INVESTIGATION FOR THE SOUTHWEST AQUEDUCT REACH #2" WATER LINE, DATED MARCH 3, 2009.

ALL FOOTING DEPTHS INDICATED ON PLANS ARE MINIMUM DEPTHS. FOOTINGS MAY BE PLACED IN NEAT EXCAVATED TRENCHES. TRENCH SHALL BE APPROVED BY INSPECTOR PRIOR TO PLACEMENT OF CONCRETE. AT LOCATIONS WHERE STRUCTURAL FILL IS REQUIRED, FILL SHALL BE PLACED IN ACCORDANCE WITH THE GEOTECHNICAL INVESTIGATION’S RECOMMENDATIONS. IT IS THE RESPONSIBILITY OF THE CONTRACTOR TO BECOME FAMILIAR WITH THE RECOMMENDATIONS OF FILL AND SITE PREPARATION DIRECTED IN THE GEOTECHNICAL INVESTIGATION.

STRUCTURAL STEEL:

ALL STRUCTURAL STEEL COMPONENTS SHALL BE FABRICATED AND ERECTED ACCORDING TO THE LATEST EDITION OF THE AMERICAN INSTITUTE OF STEEL CONSTRUCTION "SPECIFICATIONS FOR DESIGN FABRICATION AND ERECTION OF STRUCTURAL STEEL FOR BUILDINGS", WITH " COMMENTARY", AND THE AISC "CODE OF STANDARD PRACTICE FOR STEEL BUILDINGS AND BRIDGES".

ALL STEEL SECTIONS SHALL CONFORM TO THE FOLLOWING:
WIDE FLANGE SHAPES: ASTM A572 GRADE 50 OR ASTM A992 GRADE 50.
HOLLOW STRUCTURAL SECTIONS: ASTM A500 GRADE B
Fy MIN. = 46 KSI
ANGLES, CHANNELS, PLATES & BARS: ASTM A36.

ALL WELDING SHALL BE DONE BY CERTIFIED AWS WELDERS, AND COMPLY WITH THE LATEST EDITION OF THE AWS D1.1 CODE FOR WELDING IN BUILDING CONSTRUCTION. ALL FILLET WELDS TO BE 3/16" UNLESS NOTED OTHERWISE. ALL STEEL TO STEEL BOLTED CONNECTIONS SHALL BE WITH ASTM A307, UNLESS NOTED OTHERWISE. PROVIDE EDGE DISTANCE IN ACCORDANCE TO AISC TABLE J3.7 UNLESS NOTED OTHERWISE. ALL FIELD WELDS SHALL BE SPECIALLY INSPECTED PER IBC 2000 TABLE 1704.3. ALL TESTING AND INSPECTION REPORTS SHALL BE SENT TO THE ENGINEER FOR REVIEW. SHOP DRAWINGS SHALL BE SUBMITTED TO THE ENGINEER FOR REVIEW PRIOR TO FABRICATION. THE ENGINEER SHALL HAVE 10 BUSINESS DAYS TO REVIEW SHOP DRAWINGS.

STRUCTURAL STEEL SHALL BE SPECIALLY INSPECTED AS PER IBC 2006, TABLE 1704.3

QUALITY ASSURANCE PLAN

SPECIAL INSPECTION:

- AN APPROVED SPECIAL INSPECTION AGENCY SHALL BE RETAINED BY THE CONTRACTOR TO PERFORM A LEVEL 1 SPECIAL INSPECTIONS PER IBC 2009 CHAPTER 17 TABLE 1704.4.

CONCRETE

- PROVIDE A WRITTEN CONTRACTOR’S STATEMENT OF RESPONSIBILITY AS LISTED BELOW.
- PROVIDE SPECIAL INSPECTIONS OF THE CONCRETE CONSTRUCTION AS LISTED BELOW.

WRITTEN CONTRACTOR’S STATEMENT OF RESPONSIBILITY:

AS PART OF THE QUALITY ASSURANCE AND SPECIAL INSPECTION PLAN, THE CONTRACTOR SHALL SUBMIT TO THE BUILDING OFFICIAL AND THE OWNER A WRITTEN CONTRACTOR’S STATEMENT OF RESPONSIBILITY CONTAINING THE FOLLOWING ITEMS:

- ACKNOWLEDGMENT AND AWARENESS OF THE SPECIAL INSPECTION REQUIREMENTS.
- ACKNOWLEDGMENT THAT CONTROL WILL BE EXERCISED TO OBTAIN CONFORMANCE WITH THE CONSTRUCTION DOCUMENTS APPROVED BY THE BUILDING OFFICIAL.
- PROCEDURES FOR EXERCISING CONTROL WITHIN THE CONTRACTOR’S ORGANIZATION, THE METHOD AND FREQUENCY OF REPORTING AND THE DISTRIBUTION OF REPORTS.
- IDENTIFICATION AND QALLIFICATIONS OF THE PERSON(S) EXERCIZING SUCH CONTROL AND THEIR POSITION(S) IN THE ORGANIZATION.

GENERAL NOTES

- ALL DETAILS, SECTIONS, AND NOTES SHOWN ON THE DRAWINGS ARE INTENDED TO BE TYPICAL AND SHALL APPLY TO SIMILAR SITUATIONS ELSEWHERE UNLESS NOTED OR SHOWN OTHERWISE. NOTES AND DETAILS ON DRAWINGS SHALL TAKE PRECEDENCE OVER THESE GENERAL NOTES.
- REFER TO THE SPECIFICATIONS FOR INFORMATION NOT COVERED BY THESE GENERAL NOTES OR THE STRUCTURAL DRAWINGS.
- ALL CONSTRUCTION AND INSPECTION SHALL BE IN ACCORDANCE WITH THE LATEST EDITION OF THE INTERNATIONAL BUILDING CODE. THE CONTRACTOR SHALL COORDINATE ALL REQUIRED INSPECTIONS AND SHALL NOT PROCEED WITH THE WORK INVOLVED UNTIL THE INSPECTIONS HAVE BEEN DONE.
- ALL ASTM DESIGNATIONS SHALL BE AS AMENDED TO DATE, U.N.O.
- THE CONTRACTOR MUST SUBMIT A WRITTEN REQUEST FOR, AND OBTAIN THE ENGINEER’S WRITTEN PRIOR APPROVAL FOR ALL CHANGES, MODIFICATIONS, AND/OR SUBSTITUTIONS.
- THE CONTRACTOR SHALL COORDINATE AND VERIFY ALL DIMENSIONS AND ELEVATIONS WITH THE MECHANICAL, AND ELECTRICAL DRAWINGS.
- THE CONTRACTOR SHALL BE RESPONSIBLE FOR SAFETY AND PROTECTION IN AND AROUND THE JOB SITE AND/OR ADJACENT PROPERTIES.
- THE CONTRACTOR SHALL PROVIDE ADEQUATE TEMPORARY BRACING FOR ALL PORTIONS OF THE STRUCTURES UNTIL THE ENTIRE STRUCTURE IS COMPLETE.
- OBSERVATION VISITS TO THE SITE BY THE ENGINEER SHALL NEITHER BE CONSTRUED AS INSPECTION NOR APPROVAL OF CONSTRUCTION.
- IF EXISTING CONDITIONS AT THE SITE ARE NOT AS SHOWN ON THE DRAWINGS, THE ENGINEER SHALL BE NOTIFIED IMMEDIATELY. CHANGES MAY OCCUR DUE TO SUCH VARIATIONS IN EXISTING CONDITIONS.
- NO PENETRATIONS SHALL BE ALLOWED THROUGH ANY CONCRETE BEAMS, COLUMNS, PIERS, OR JAMBS, WITHOUT THE ENGINEER’S WRITTEN APPROVAL. MECHANICAL AND/OR OTHER PENETRATIONS SHALL BE RE–ROUTED AT THESE LOCATIONS.
- PRIOR TO PLACING STRUCTURAL FILL, THE EXPOSED SOILS SHALL BE SCARIFIED TO A DEPTH OF 6 INCHES; BROUGHT TO WITHIN 2 PERCENT OF THE OPTIMUM MOISTURE CONTENT FOR GRANULAR SOILS AND SLIGHTLY ABOVE OPTIMUM FOR FINE–GRAINED SOILS. EXPOSED SOILS SHALL THEN BE COMPACTED TO AT LEAST 95 % OF THE MAXIMUM DRY DENSITY AS DETERMINED BY ASTM D–1557.
- STRUCTURES AND CONCRETE FLATWORK SHALL BE ON A 6–INCH LAYER OF COMPACTED GRAVEL. THE LAYER OF COMPACTED GRAVEL SHALL CONSIST OF TYPE G ROAD BASE WITH A 1–INCH MAXIMUM PARTICLE SIZE AS SPECIFIED. THE GRAVEL LAYER SHALL BE COMPACTED TO AT LEAST 95% OF THE MAXIMUM DRY DENSITY AS DETERMINED BY ASTM–D1557.
- CONTRACTOR SHALL INSTALL HIGH DENSITY FOAM INSULATION (BLUE BOARD) IN CONCRETE VAULTS USING HILTI IDP POLY INSULATION ANCHORS. ANCHOR SHALL BE PLACED NEAR EACH CORNER OF THE BOARD INSULATION AND A MINIMUM OF TWO ROWS OF THREE ANCHORS BE INSTALLED PER SHEET. ON SMALLER SHEETS ENOUGH ANCHORS SHALL BE SUPPLIED TO SUFFICIENTLY SUPPORT THE INSULATION.
- CONTRACTOR SHALL APPLY ECOBASE II WATERPROOFING MEMBRANE BY EPRO WATERPROOFING SYSTEMS ON ALL WALLS, ROOF AND GRADE RINGS ON STRUCTURES PRIOR TO BACK FILL.
- COAT THE BOTTOM 6” OF ALL MISC METALS IN CONTACT WITH CONCRETE FLOORS IN ACCORDANCE WITH SECTION 09900 – COATINGS AND PAINTING.



JORDAN VALLEY WATER CONSERVANCY DISTRICT
SOUTHWEST AQUEDUCT REACH 2 PROJECT

VERIFY SCALE
BAR IS ONE INCH ON ORIGINAL DRAWING

REVIEW
CHECKED M. COLLINS
APPROVED M. ROBLEZ








DESIGN
DESIGN M. ROBLEZ
DRAWN R. GARCIA

STRUCTURAL
GENERAL STRUCTURAL NOTES

PROJECT NUMBER 010–08–03
DATE: FEBRUARY 2010

RECORD DRAWINGS
Revisions Drawn by S. Riggs Date November 2011
THESE RECORD DRAWINGS HAVE BEEN PREPARED, IN PART, ON THE BASIS OF INFORMATION COMPILED BY OTHERS. THEY ARE NOT INTENDED TO REPRESENT IN DETAIL THE EXACT LOCATION, TYPE OF COMPONENT NOR MANNER OF CONSTRUCTION. THE ENGINEER WILL NOT BE RESPONSIBLE FOR ANY ERRORS OR OMISSIONS WHICH HAVE BEEN INCORPORATED INTO THE RECORD DRAWINGS.

DRAWING NO.
GS–1
SHEET 89 OF 110

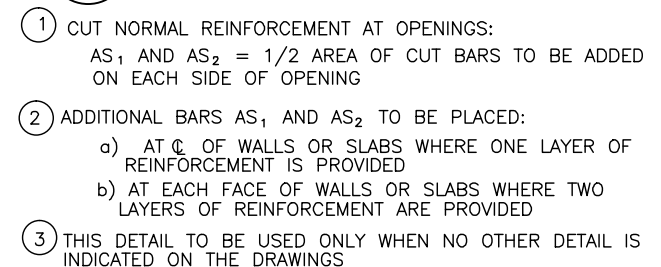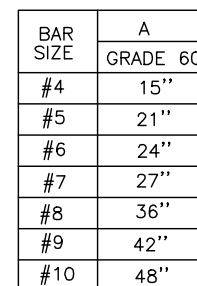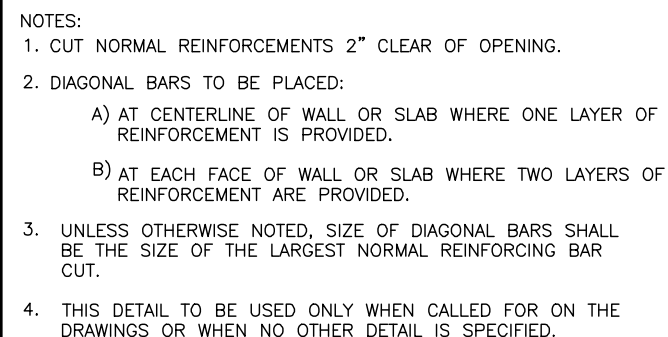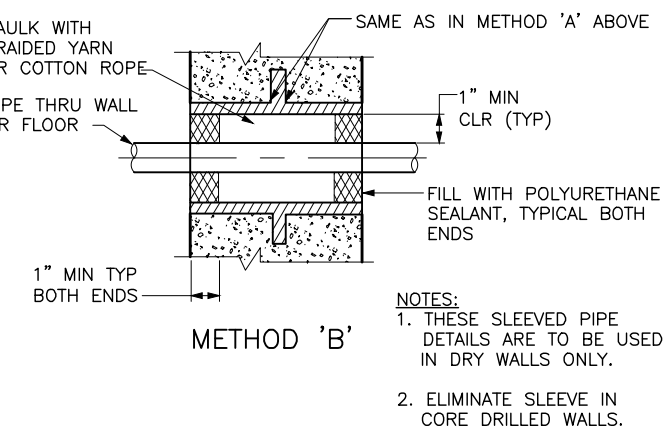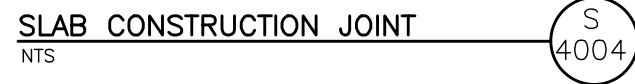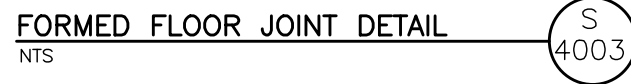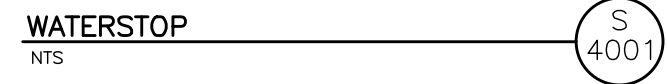

TYPICAL BASE

ALTERNATE BASE

UNACCEPTABLE BASE

NOTES:

- C-MIN CLR FOR REINF BARS, SEE GENERAL STRUCTURAL NOTES.
- T-FOOTING THICKNESS AS DETAILED.
- WHEN USING ALTERNATIVE BASE INCREASE DOWEL BARS TO PROVIDE SAME LAP LENGTH AS TYPICAL BASE.

WALL BASE CONSTRUCTION JOINT S 4014
NTS

GRATING DETAIL S 4015
NTS

ANGLE FRAME. MATERIAL TO MATCH GRATING. SEE TABLE. MITER AND WELD CORNERS

GRATING 1/4"

5/8" BOLTS @ 18" OC

SUPPORT ANGLE L - 2 1/2" x 1 1/2" x 1/4"

1/2" 0 X 4" WELDED STUDS @ 12" OC (MAX) WELDED TO ANGLE FRAME

ALUMINUM GRATING

BEARING BARS: DEPTH T X 3/16" @ 1 3/16" OC

CROSS BARS @ 4" OC USE ALUM ANGLE SUPPORTS AND SS BOLTS

GALVANIZED STEEL GRATING

BEARING BARS: DEPTH T X 3/16" @ 1 3/16" OC

CROSS BARS @ 4" OC USE STEEL ANGLE SUPPORTS AND BOLTS GALVANIZE AFTER FABRICATION

STAINLESS STEEL GRATING

BEARING BARS: DEPTH T X 3/16" @ 1 3/16" OC

CROSS BARS @ 4" OC USE STAINLESS STEEL ANGLE SUPPORTS AND BOLTS

GRATING FRAME TABLE					
TYPE	GRATING DEPTH T	FRAME ANGLE	TYPE	GRATING DEPTH T	FRAME ANGLE
1	1"	1 3/4 x 1 1/4 x 1/4	5	2"	2 1/2 x 2 1/2 x 1/2
2	1 1/4"	2 x 1 1/2 x 1/4	6	2 1/4"	2 1/2 x 2 1/2 x 1/4
3	1 1/2"	1 3/4 x 1 3/4 x 1/4	7	2 1/2"	3 x 2 1/2 x 1/2
4	1 3/4"	2 x 2 x 1/4	8		

GRATING OF DEPTH T AS NOTED ON DRAWINGS SHALL BE AS SPECIFIED HEREIN

ALL ENDS AND OPENINGS SHALL BE Banded

ALL GRATINGS SHALL BE SECURED IN PLACE WITH REMOVABLE FASTENERS

WEIGHT OF GRATING SECTION SHALL NOT EXCEED 80 LBS

* OR USE 2 1/2 x 2 1/2 x 1/4 WITH 1/4" SHIM PLATE WELDED TO BOTTOM

FORM SNAP-TIE HOLE S 4016
NTS

INSIDE OR WATER SIDE OF WALL

USE CONICAL TYPE INSERTS EACH FACE

FILL WITH DRY PACK NONSHRINK GROUT, SEE NOTES (TYP)

WATERSTOP

DEPTH OF CONE AS SPECIFIED, TYP

NOTES:

- FOR FORM TIE HOLES ON OUTSIDE FACE OF WALL BELOW GRADE, FILL WITH NONSHRINK GROUT, (DRY PACK)
- THE SPACING OF FORM TIES ON EXPOSED PORTIONS OF WALLS SHALL BE APPROXIMATELY EQUAL HORIZONTALLY AND VERTICALLY AND SHALL BE UNIFORM IN EACH DIRECTION.
- WHERE CAULKING IS NOT SPECIFIED OR SHOWN, DRY PACK EXTERIOR TIE HOLES WITH NONSHRINK GROUT WITH COLOR OF GROUT TO MATCH COLOR OF CONCRETE AS CLOSE AS POSSIBLE.
- DRY PACK METHOD SHALL BE AS SPECIFIED USING STEEL TOOLS.

PIPE BELOW FTG.

PIPE THROUGH FTG.

PIPE PERPENDICULAR TO FOOTING S 4017
NTS

1/2" CLR.

12" MIN

12" MIN

6" MIN.

PROVIDE TYP. FTG. STEP IF THIS DIM. EXCEEDS 1'-6".

1/2"

24 DIA.

2" CLR

12" MIN

12" MIN

PROVIDE SLEEVES FOR ALL PIPES PASSING THROUGH WALLS & FTGS.

PROVIDE ADD'L REINF. AS SHOWN TO MATCH TYP. WHERE BAR IS CUT.

STANDARD FOR REINFORCEMET BAR DETAILS S 4018
NTS

STRAIGHT BAR

WALL

STRAIGHT BARS

STOP ALTERNATE BARS

FLOOR SLAB

STRAIGHT BARS

3" CLR

3" CLR

VERT WALL BARS TO LAP SHORT DOWELS ALL 3 BARS IN THE SAME PLANE PARALLEL TO WALL FACE

WALL

VERT WALL BARS AND DOWELS IN THE SAME PLANE PARALLEL TO WALL FACE

FLOOR SLAB

3" CLR

3" CLR

ALL BOTTOM BARS IN THE SAME HORIZONTAL PLANE

WALL

INTERSECTING WALL OR SLAB

T = S/2 OR 4 1/2" WHICH EVER IS LESS (TYP)

WHEN BAR HOOK IS NOT SPECIFIED PROVIDE STD 90° BAR HOOK, SEE SD-210

SLAB

WALL

* SEE DRAWINGS

CJ OR EXP JT

S = BAR SPACING AS NOTED ON DWGS

WALL OR SLAB DETAIL

WALL & FOOTING JOINT DETAIL S 4019
NTS

WALL REINF, SEE DWGS

6" FLAT STRIP WATERSTOP S 4001

CAULK WALL & FOOTING JOINTS W/ FLEXIBLE SEALANT (INSIDE) S 4020

PLAN

JOINT SEALANT S 4020
NTS

FLEXIBLE SEALANT

3/4"

1/2" DIA MINICELL BACKER ROD

EXPANSION JOINT MATERIAL WHEN REQUIRED

1/8"

3/8"

RECORD DRAWINGS

Revisions Drawn by S. Riggs Date November 2011

THESE RECORD DRAWINGS HAVE BEEN PREPARED, IN PART, ON THE BASIS OF INFORMATION COMPILED BY OTHERS. THEY ARE NOT INTENDED TO REPRESENT IN DETAIL THE EXACT LOCATION, TYPE OF COMPONENT NOR MANNER OF CONSTRUCTION. THE ENGINEER WILL NOT BE RESPONSIBLE FOR ANY ERRORS OR OMISSIONS WHICH HAVE BEEN INCORPORATED INTO THE RECORD DRAWINGS.

Bowen Collins & Associates, Inc.
Consulting Engineers

JORDAN VALLEY WATER CONSERVANCY DISTRICT

SOUTHWEST AQUEDUCT REACH 2 PROJECT

STRUCTURAL

GENERAL STRUCTURAL DETAILS - 3

DATE: FEBRUARY 2010 PROJECT NUMBER 010-08-03

DRAWING NO. GS-4

SHEET 92 OF 110

VERIFY SCALE

BAR IS ONE INCH ON ORIGINAL DRAWING






DESIGN M. ROBLEZ

DESIGN R. GARCIA

REVIEW CHECKED M. COLLINS

APPROVED M. ROBLEZ

NO. DATE REV. BY DESCRIPTION REVISIONS

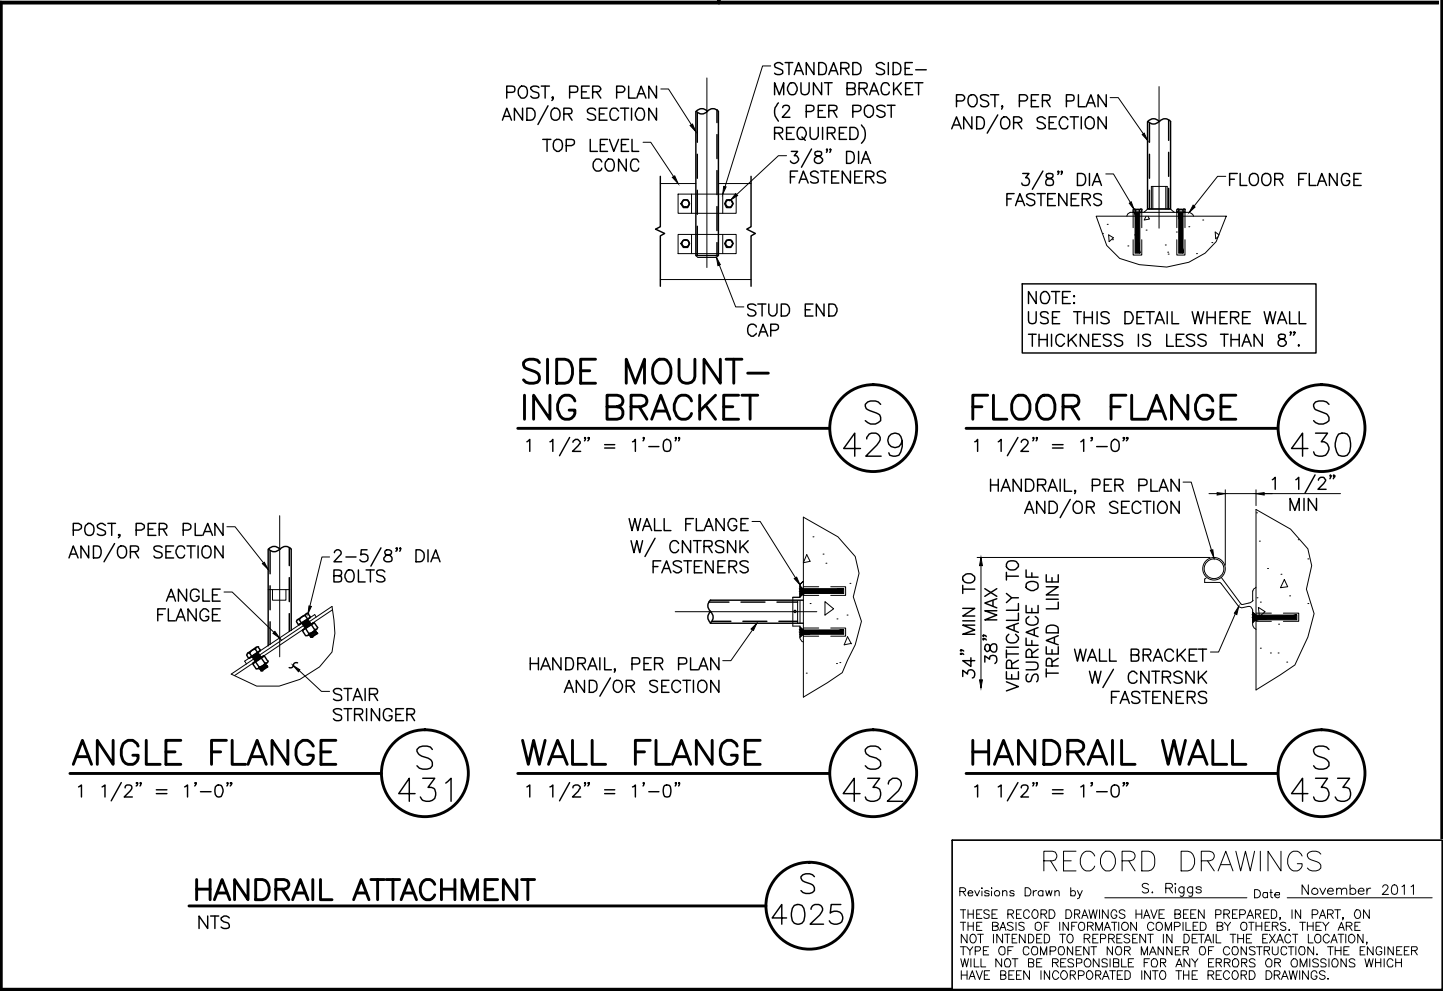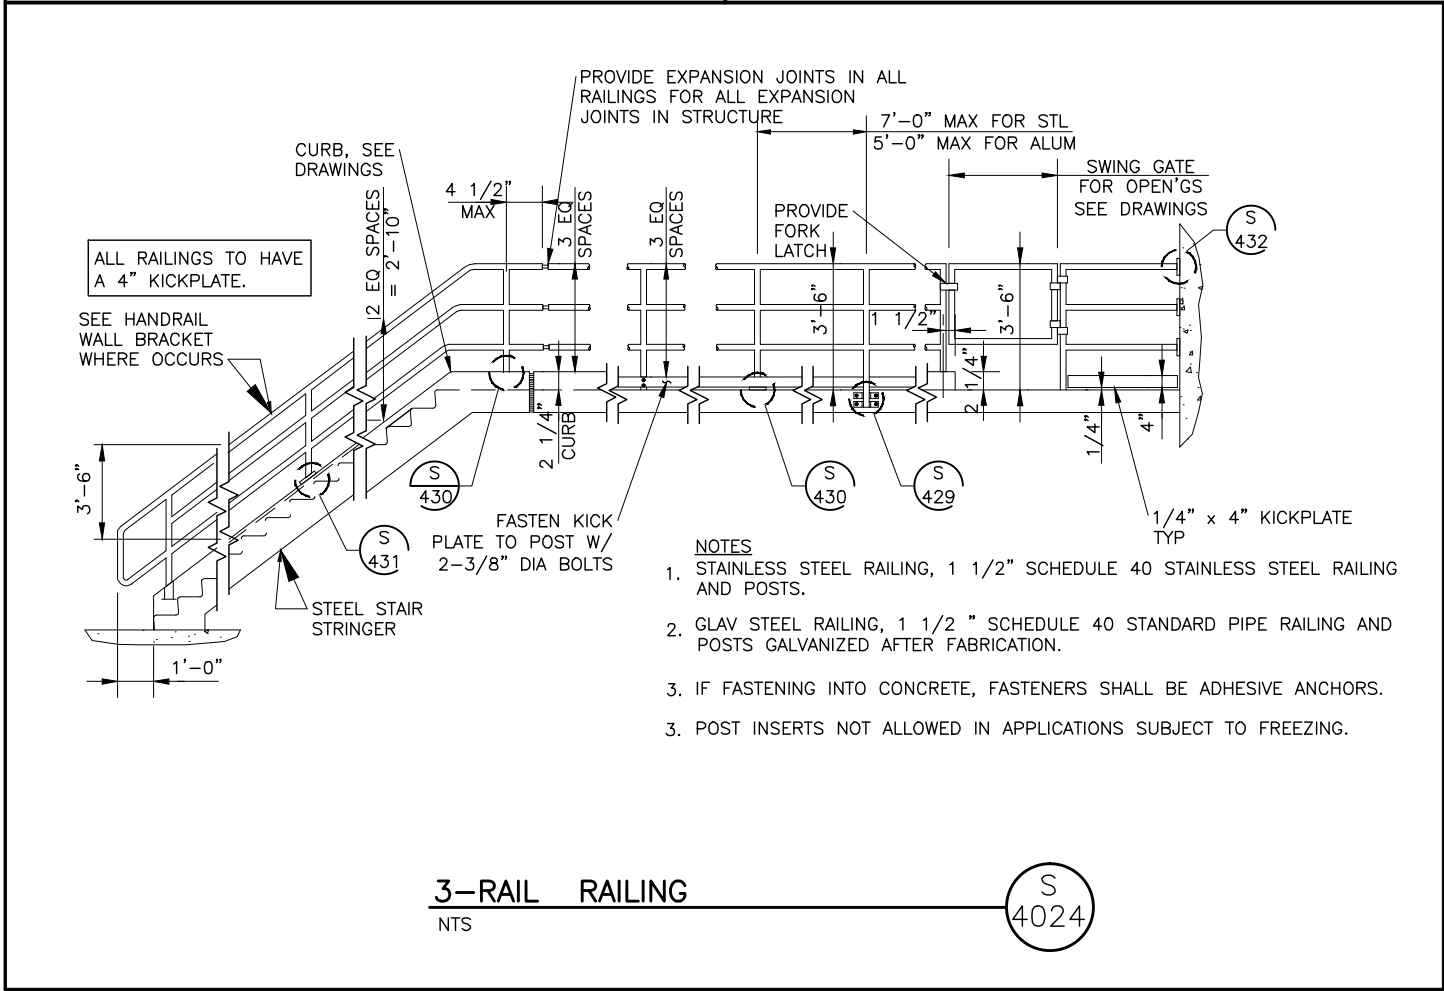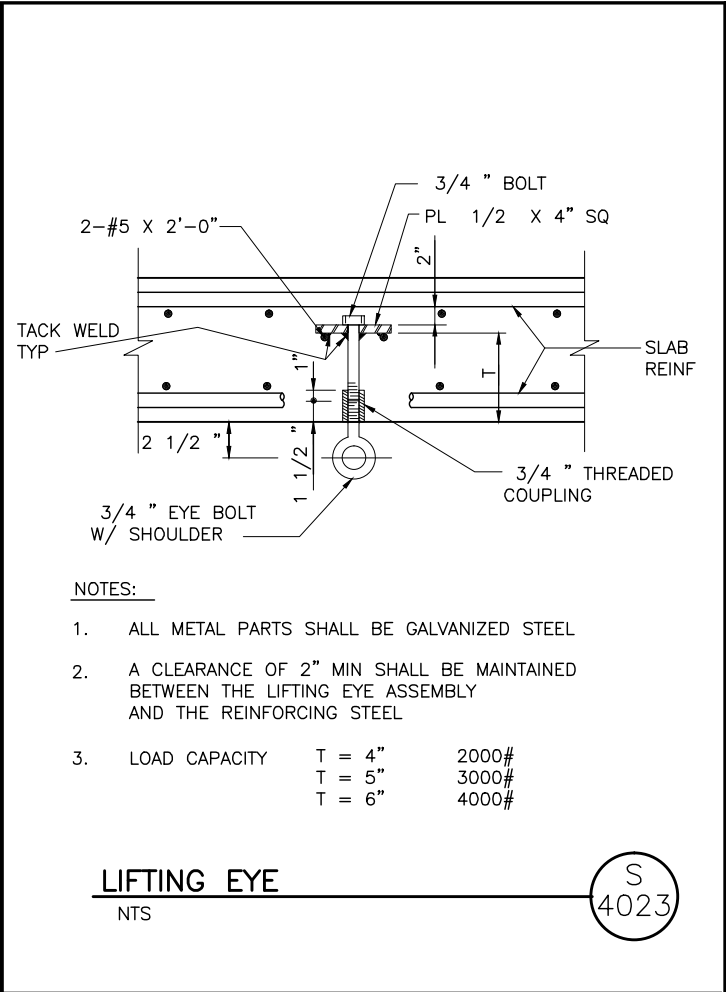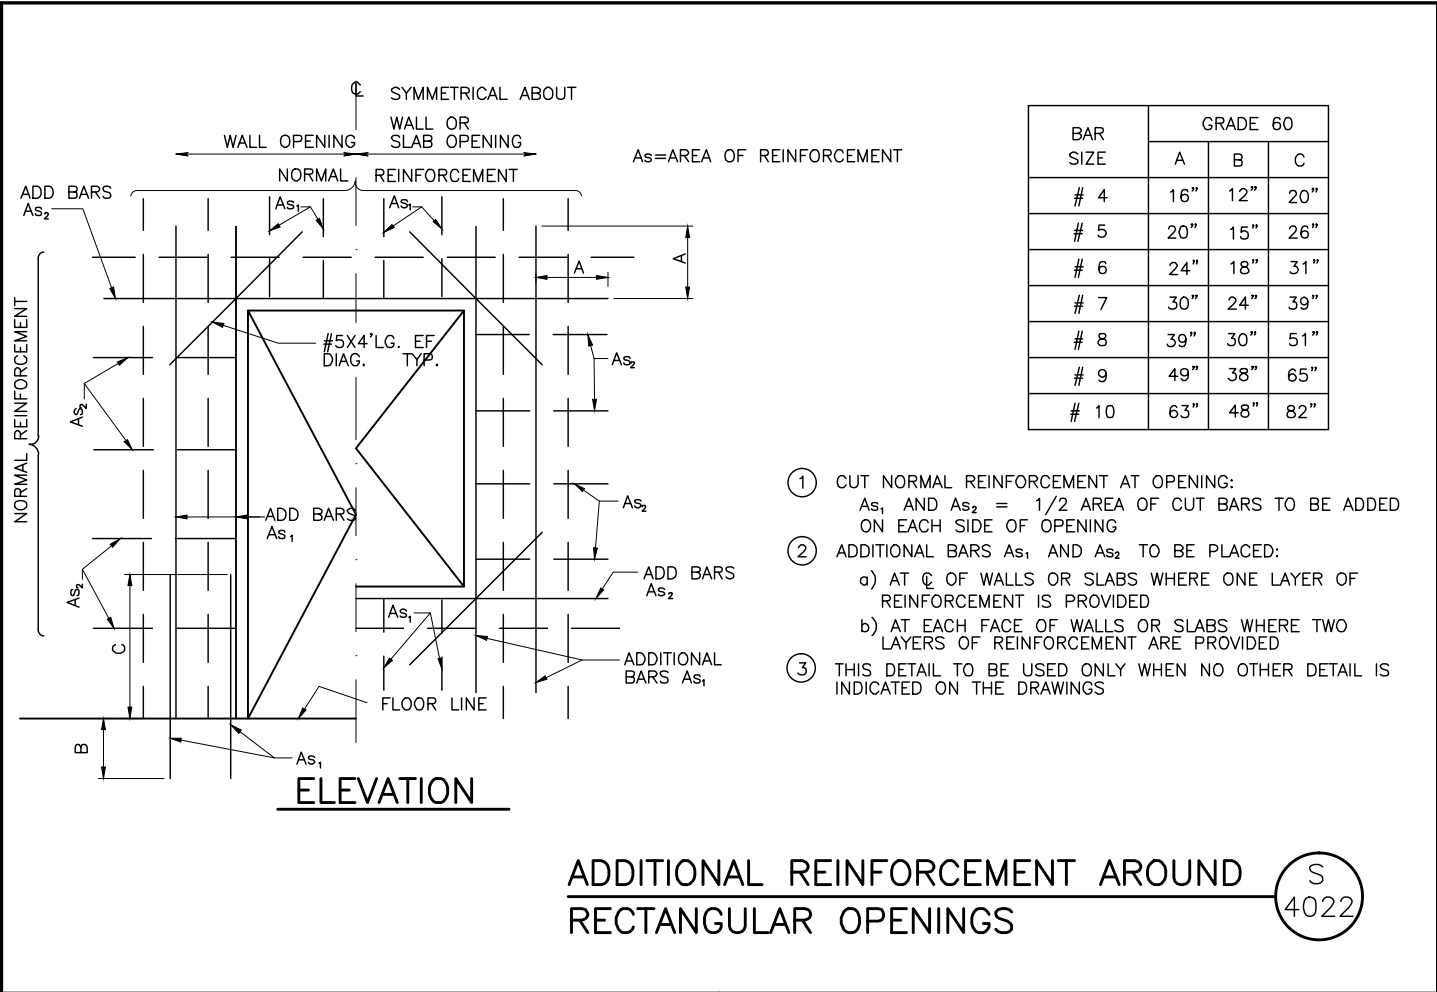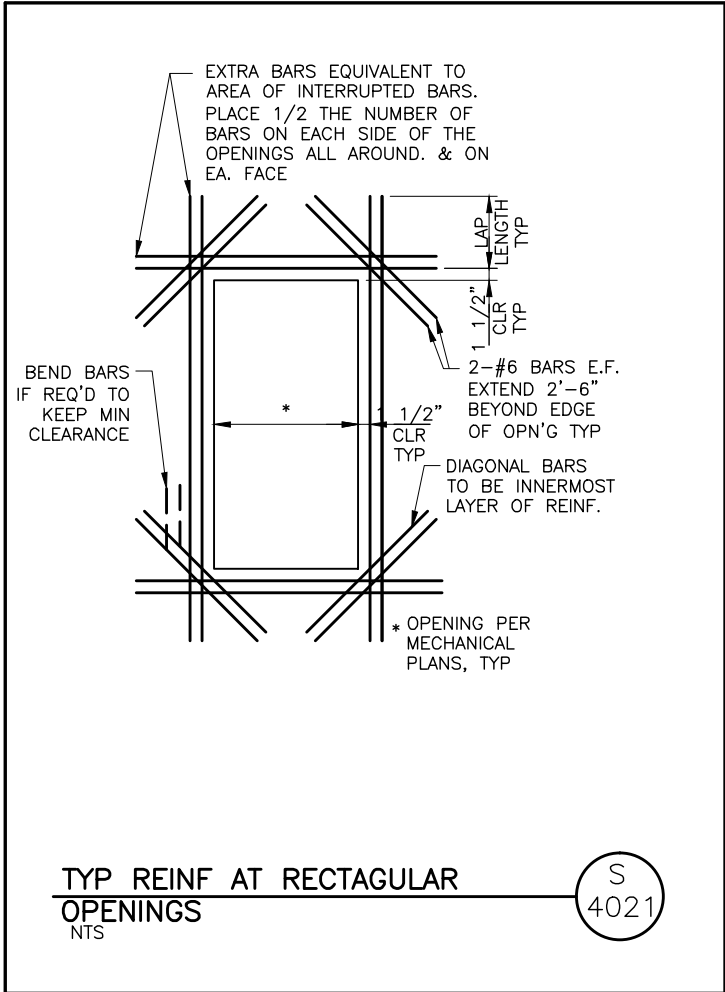

RECORD DRAWINGS

Revisions Drawn by S. Riggs Date November 2011

THESE RECORD DRAWINGS HAVE BEEN PREPARED, IN PART, ON THE BASIS OF INFORMATION COMPILED BY OTHERS. THEY ARE NOT INTENDED TO REPRESENT IN DETAIL THE EXACT LOCATION, TYPE OF COMPONENT NOR MANNER OF CONSTRUCTION. THE ENGINEER WILL NOT BE RESPONSIBLE FOR ANY ERRORS OR OMISSIONS WHICH HAVE BEEN INCORPORATED INTO THE RECORD DRAWINGS.

Bowen Collins & Associates, Inc.
Professional Engineers

REVISIONS			
NO.	DATE	REV. BY	DESCRIPTION

JORDAN VALLEY WATER CONSERVANCY DISTRICT

SOUTHWEST AQUEDUCT REACH 2 PROJECT

DESIGN M. ROBLEZ
CHECKED M. COLLINS
APPROVED M. ROBLEZ

VERIFY SCALE

BAR IS ONE INCH ON ORIGINAL DRAWING

STRUCTURAL

GENERAL STRUCTURAL DETAILS - 4





PROJECT NUMBER 010-08-03

DATE: FEBRUARY 2010

DRAWING NO. **GS-5**

SHEET **93** OF **110**


DATE: FEBRUARY 2010

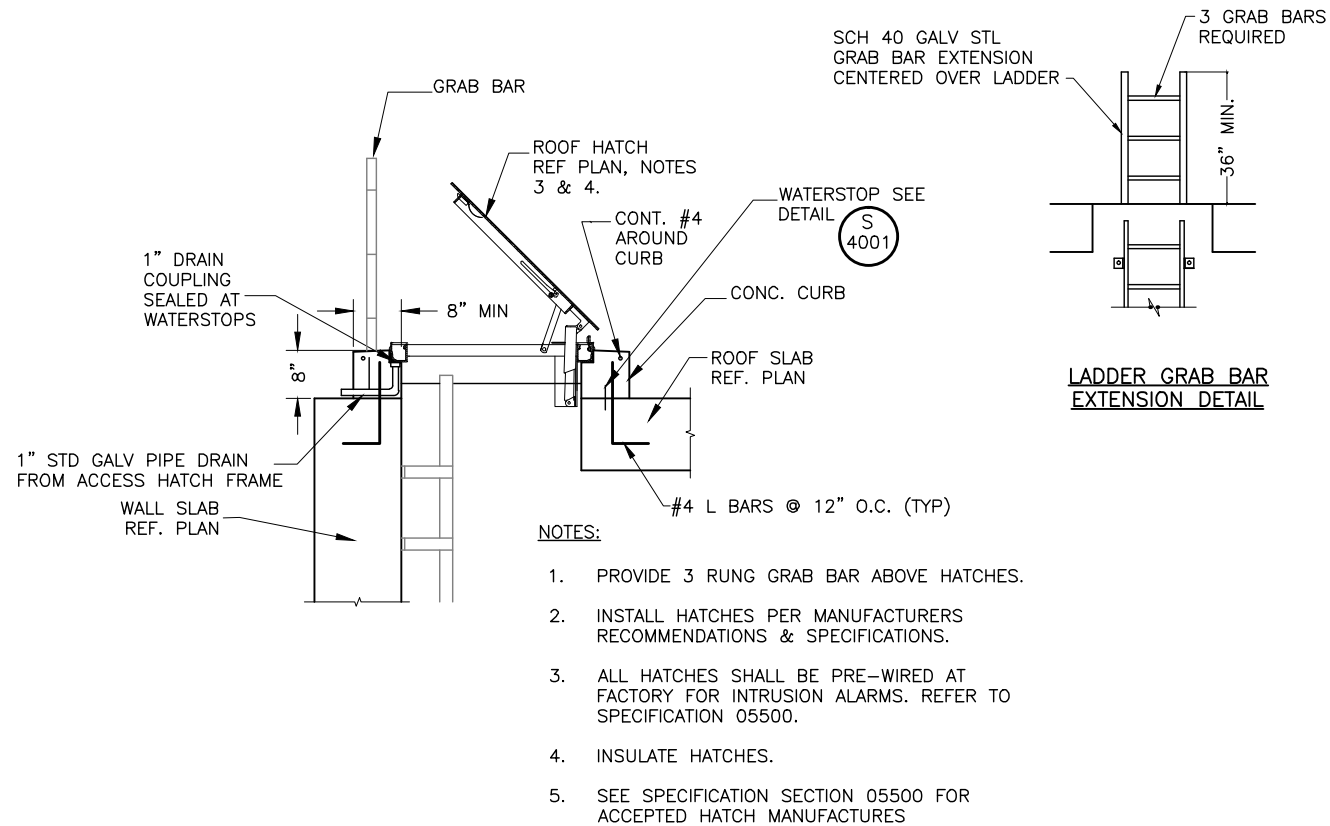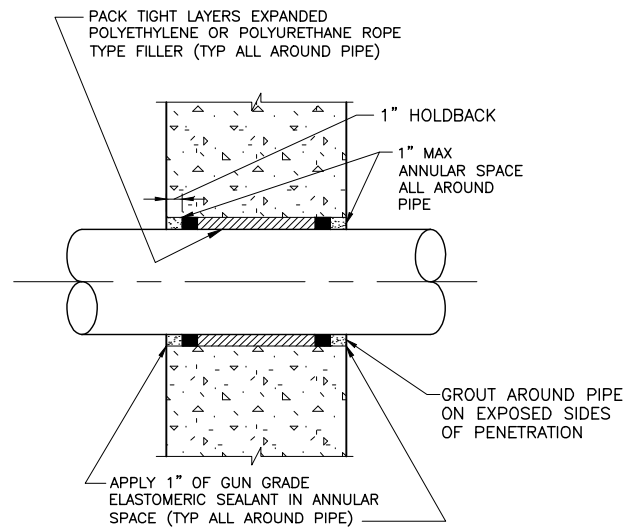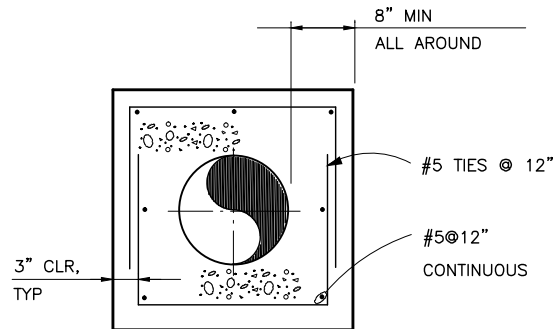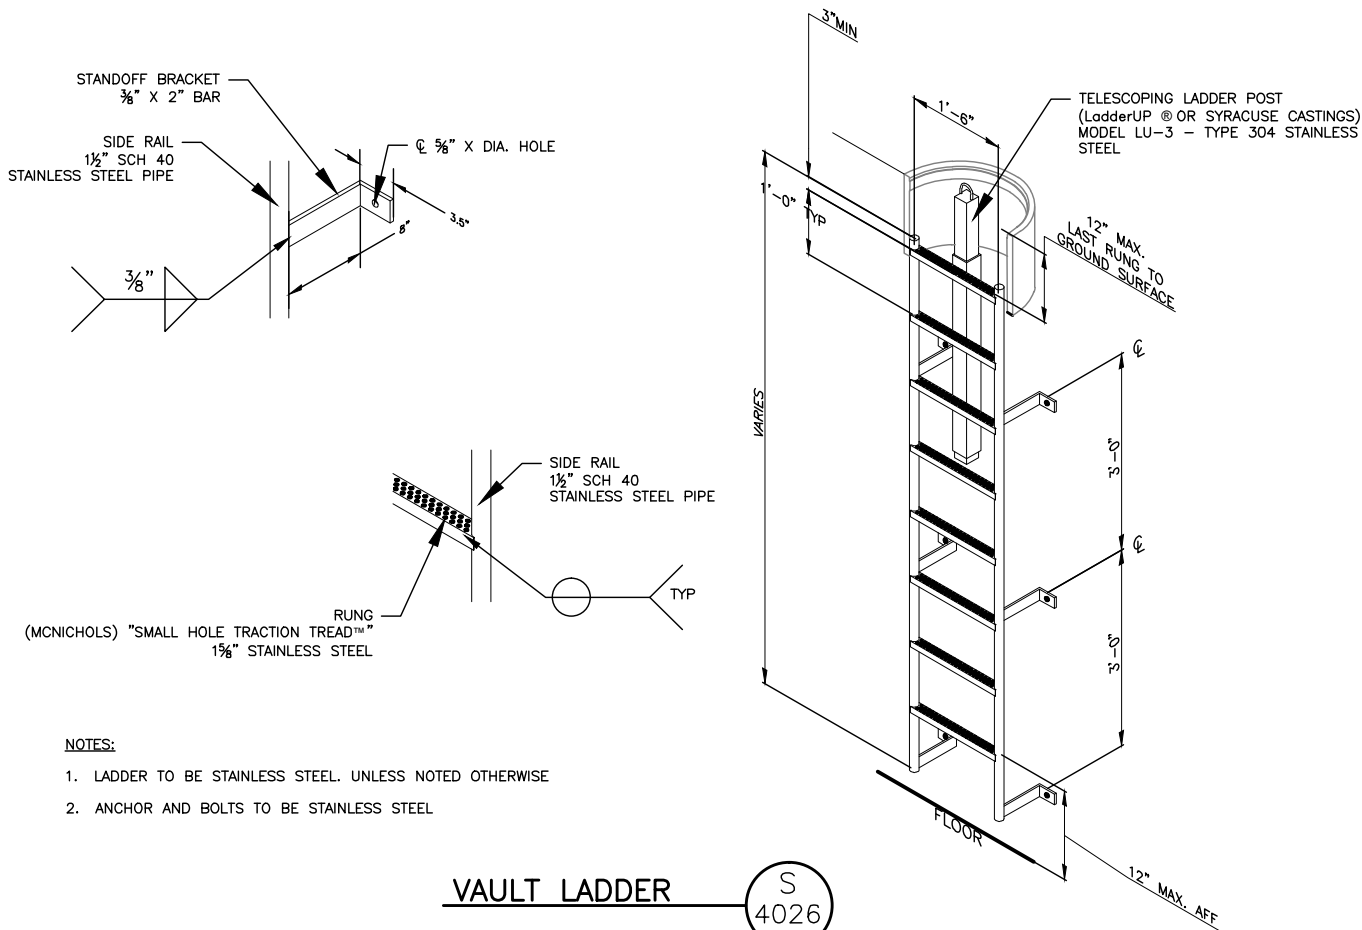

RECORD DRAWINGS

Revisions Drawn by S. Riggs Date November 2011



THESE RECORD DRAWINGS HAVE BEEN PREPARED, IN PART, ON THE BASIS OF INFORMATION COMPILED BY OTHERS. THEY ARE NOT INTENDED TO REPRESENT IN DETAIL THE EXACT LOCATION, TYPE OF COMPONENT NOR MANNER OF CONSTRUCTION. THE ENGINEER WILL NOT BE RESPONSIBLE FOR ANY ERRORS OR OMISSIONS WHICH HAVE BEEN INCORPORATED INTO THE RECORD DRAWINGS.

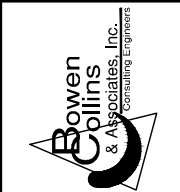

NO.	DATE	REV. BY	DESCRIPTION

JORDAN VALLEY WATER CONSERVANCY DISTRICT	VERIFY SCALE	REVIEW	DESIGN
SOUTHWEST AQUEDUCT REACH 2 PROJECT	BAR IS ONE INCH ON ORIGINAL DRAWING	CHECKED M. COLLINS	M. ROBLEZ
		APPROVED M. ROBLEZ	R. GARCIA


STRUCTURAL	PROJECT NUMBER 010-08-03	DATE: FEBRUARY 2010
GENERAL STRUCTURAL DETAILS - 5		
DRAWING NO. GS-6		
SHEET 94 OF 110		

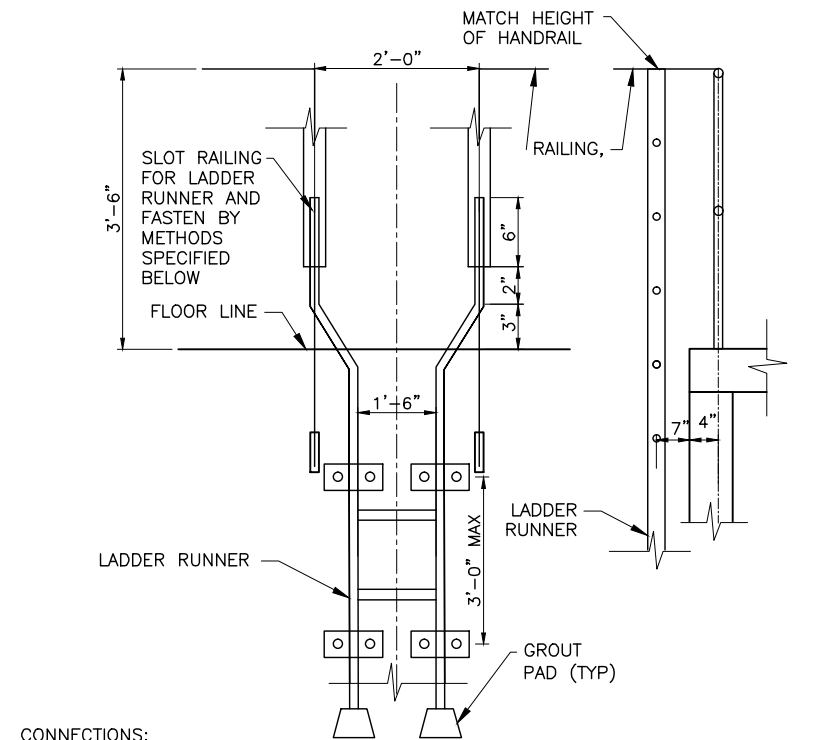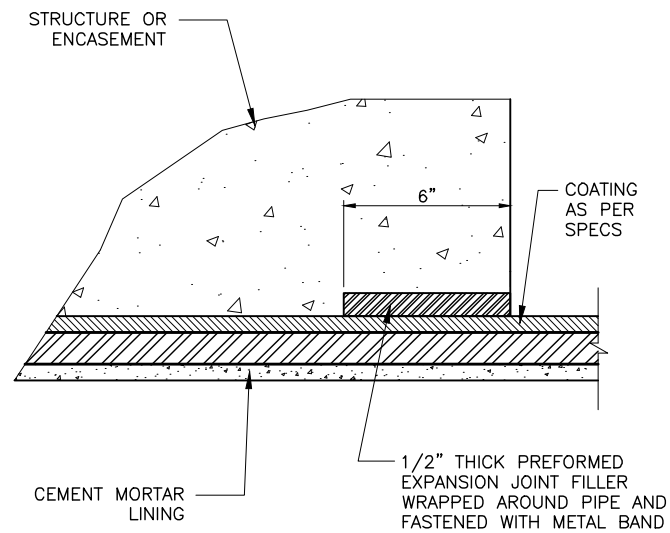

CONNECTIONS:


STEEL TO STEEL OR ALUMINUM TO ALUMINUM: WELDED CONNECTION, GRIND SMOOTH

STEEL TO ALUMINUM: DRILL HOLE THROUGH LADDER RUNNER AND RAILING FOR 1/2" PIN. INSERT PIN AND WELD BOTH ENDS AND GRIND SMOOTH. PIN SHALL BE THE SAME MATERIAL AS RAILING.

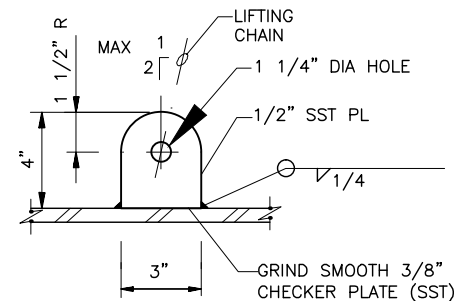


SECTION A

NTS

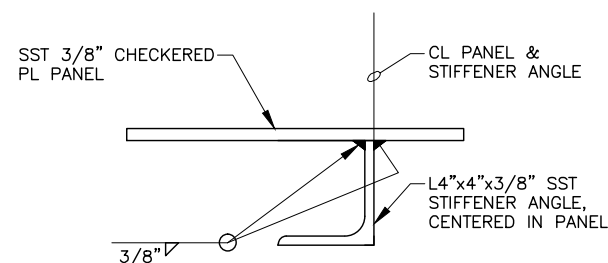

SECTION C
NTS

SST ROOF COVER PLATE

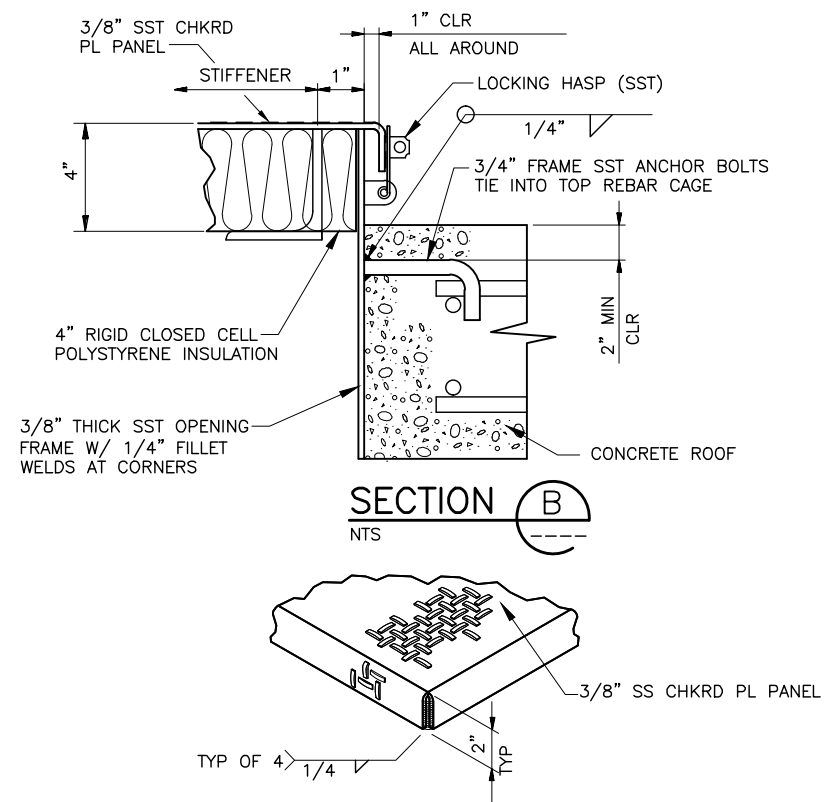


SECTION B
NTS

CORNER DETAIL (2)

RECORD DRAWINGS

Revisions Drawn by S. Riggs Date November 2011

THESE RECORD DRAWINGS HAVE BEEN PREPARED, IN PART, ON THE BASIS OF INFORMATION COMPILED BY OTHERS. THEY ARE NOT INTENDED TO REPRESENT IN DETAIL THE EXACT LOCATION, TYPE OF COMPONENT NOR MANNER OF CONSTRUCTION. THE ENGINEER WILL NOT BE RESPONSIBLE FOR ANY ERRORS OR OMISSIONS WHICH HAVE BEEN INCORPORATED INTO THE RECORD DRAWINGS.

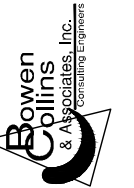[illegible]

SOUTHWEST AQUEDUCT REACH 2 PROJECT

BAR IS ONE INCH ON
ORIGINAL DRAWING

CHECKED M. COLLINS
APPROVED M. ROBLEZ

DESIGN	M. ROBLEZ
DRAWN	R. GARCIA

STRUCTURAL

GENERAL STRUCTURAL

DETAILS - 6

E: FEBRUARY


2010

PROJECT NUMBER

010-08-C

DRAWING NO.
GS-7

SHEET 95 OF 110

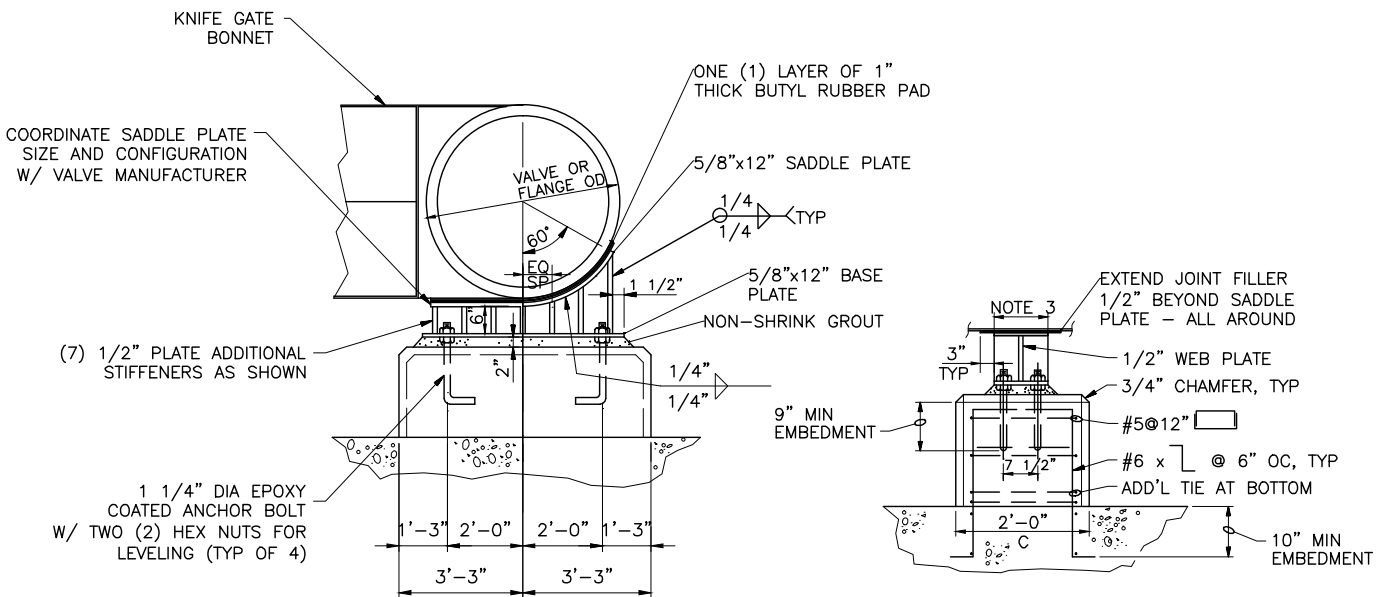


NOTES:

1. SEE PLAN FOR LOCATION OF PIPE SUPPORTS.
2. FINISH PAINT AS SPECIFIED.
3. WIDTH OF SUPPORT IS EQUAL TO FACE TO FACE DIM OF VALVE PLUS THICKNESS OF TWO PIPE FLANGES.

66" KNIFE GATE SUPPORT

NTS

S
4035

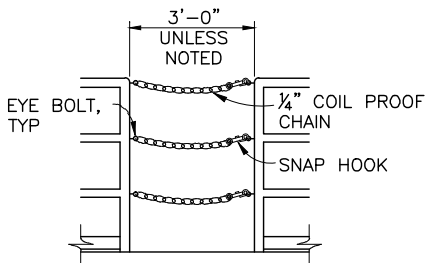

NOTES:


1. SAFETY CHAIN AND HARDWARE SHALL BE STAINLESS STEEL UNLESS OTHERWISE NOTED.

SAFETY CHAIN

NTS

(GALVANIZED & STAINLESS STEEL)


S
4036

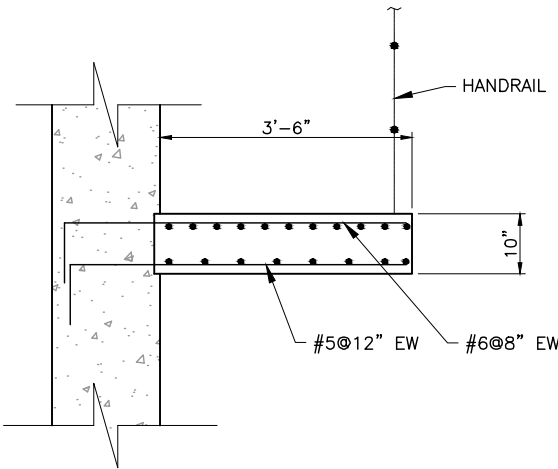

CANTILEVER DETAIL

NTS


S
4037

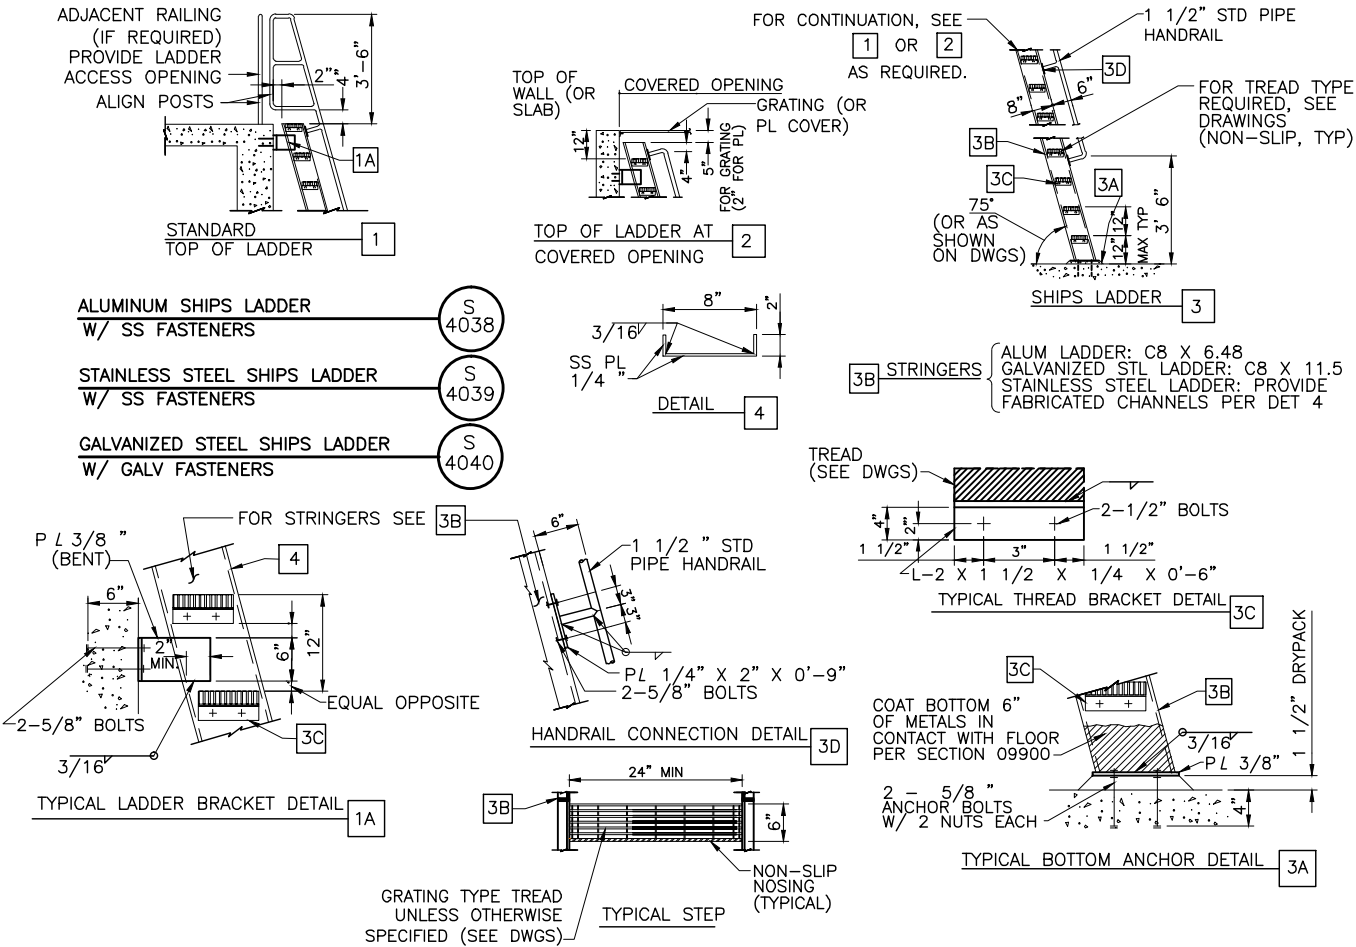

RECORD DRAWINGS

Revisions Drawn by S. Riggs Date November 2011

THESE RECORD DRAWINGS HAVE BEEN PREPARED, IN PART, ON THE BASIS OF INFORMATION COMPILED BY OTHERS. THEY ARE NOT INTENDED TO REPRESENT IN DETAIL THE EXACT LOCATION, TYPE OF COMPONENT NOR MANNER OF CONSTRUCTION. THE ENGINEER WILL NOT BE RESPONSIBLE FOR ANY ERRORS OR OMISSIONS WHICH HAVE BEEN INCORPORATED INTO THE RECORD DRAWINGS.

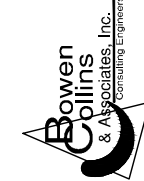

REVISIONS			
NO.	DATE	REV. BY	DESCRIPTION

JORDAN VALLEY WATER CONSERVANCY DISTRICT
SOUTHWEST AQUEDUCT REACH 2 PROJECT

VERIFY SCALE

BAR IS ONE INCH ON ORIGINAL DRAWING

REVIEW

CHECKED M. COLLINS
APPROVED M. ROBLEZ

DESIGN

DESIGN M. ROBLEZ
DRAWN R. GARCIA

STRUCTURAL

GENERAL STRUCTURAL
DETAILS - 7

DRAWING NO.

GS-8

SHEET 96 OF 110

ELECTRICAL SYMBOLS LEGEND

	SELECTOR SWITCH 2 POSITION NORMALLY OPEN TIME DELAY CLOSING AFTER COIL ENERGIZED		THERMAL OVERLOAD RELAY
	NORMALLY CLOSED TIME DELAY OPENING AFTER COIL ENERGIZED		SURGE PROTECTION DEVICE
	INDICATOR LIGHT		DC BLOCKER
	REMOTE DEVICE CONNECTION		DETAIL DESIGNATION
	CLOSED RELAY CONTACT		DETAIL CALL OUT
	OPEN RELAY CONTACT		SHEET REFERENCE
	TERMINAL TO EXTERNAL REMOTE DEVICE		
	WIRE TERMINAL OR CONNECTION POINT		
	SINGLE PHASE MOTOR		
	MOTOR OVERLOAD RELAY		
	LIMIT SWITCH		
	CONTROL RELAY		
	TRANSFORMER		
	SELECTOR SWITCH 3 POSITION MAINTAINED CONTACT		CONDUIT EXPOSED
	LEVEL SWITCH CLOSES ON FALLING LEVEL		CONDUIT RUN UNDERGROUND OR IN CONCRETE
	LEVEL SWITCH CLOSES ON RISING LEVEL		BARE COPPER WIRE IN SLAB OR UNDERGROUND GRID, SIZE AS NOTED
	CONTROL SWITCH PUSHBUTTON, MOMENTARY CONTACT		TRANSFORMER W/ DELTA-Y AND GROUND
	GROUND CONNECTION		UTILITY METER
	FRACTIONAL HP MOTOR		UTILITY CT
	CONTROL STATION		MOTOR, HORSEPOWER AS NOTED
	JUNCTION BOX		CIRCUIT BREAKER
	DUPLEX RECEPTACLE		ELECTRICAL PANEL
	LIGHT FIXTURE TYPE AS INDICATED		FUSE
	FUSED DISCONNECT		MOTOR STARTER NEMA SIZE AS NOTED
	SINGLE LIGHT SWITCH		DISCONNECT SWITCH SIZE AS NOTED
	DISCONNECT UNFUSED SIZE NOTED		RECEPTACLE
	CONTACTOR/STARTER (NO. OF POLES SHOWN)		INCANDESCENT FIXTURE
	CIRCUIT BREAKER (NO. OF POLES SHOWN)		SOLENOID
	FLOW SWITCH CLOSES ON LOW FLOW		POLE MOUNTED HID FIXTURE
	PRESSURE SWITCH CLOSES ON RISING PRESSURE		ELECTRICAL CONNECTION

	PLC DIGITAL INPUT
	PLC DIGITAL OUTPUT
	PLC ANALOG INPUT
	PLC ANALOG OUTPUT

GENERAL NOTES:

- 1.VERIFY ALL EQUIPMENT DIMENSIONS AND LOCATIONS BEFORE BEGINNING ROUGH-IN. CONSULT ALL APPLICABLE CONTRACT DRAWINGS AND SHOP DRAWINGS TO ENSURE NEC CODE CLEARANCE REQUIRED AROUND ALL ELECTRICAL EQUIPMENT.
- 2.CONTRACTOR SHALL VERIFY ALL ELECTRICAL LOADS (VOLTAGE, PHASE, CONNECTION REQUIREMENTS, ETC.) OF EQUIPMENT FURNISHED BEFORE BEGINNING ROUGH-IN.
- 3.SEE APPLICABLE SHOP DRAWINGS FOR ROUGH-IN LOCATION OF ALL EQUIPMENT, WIRING DEVICES, ETC.
- 4.THE ELECTRICAL CONTRACTOR SHALL NOTIFY AND COOPERATE WITH THE MECHANICAL CONTRACTOR SUCH THAT NO PIPING, OR EQUIPMENT FOREIGN TO THE OPERATION OF THE ELECTRICAL EQUIPMENT SHALL BE PERMITTED TO BE INSTALLED IN, ENTER OR PASS THROUGH ELECTRICAL ROOMS OR SPACES; OR ABOVE OR BELOW ELECTRICAL EQUIPMENT IN THE OTHER AREAS.
- 5.ALL PENETRATIONS OF FLOORS, WALLS AND CEILINGS SHALL BE SEALED WITH APPROVED MATERIAL.
- 6.FOR PACKAGE EQUIPMENT PROVIDED ON THE PROJECT, SOME CONDUITS AND WIRES ARE SHOWN ON THE DRAWINGS, BUT IT IS EXPECTED THAT SOME ADDITIONAL CONDUITS AND WIRES MAY BE REQUIRED BY EQUIPMENT MANUFACTURERS TO COMPLETE INSTALLATION. IT IS INCUMBENT UPON THE GENERAL CONTRACTOR TO COORDINATE THIS REQUIREMENT WITH HIS SUBCONTRACTORS TO MAKE SURE THAT EQUIPMENT SUPPLIER PROVIDED ALL NECESSARY ELECTRICAL INFORMATION TO ELECTRICAL SUBCONTRACTOR FOR INCLUSION WHETHER SHOWN OR NOT SHOWN ON THE DRAWINGS.
- 7.IF OTHER THAN FIRST NAMED EQUIPMENT IS USED, IT SHALL BE CAREFULLY CHECKED FOR ELECTRICAL REQUIREMENTS AND CONTROL REQUIREMENTS OF ALTERNATE EQUIPMENT. SHOULD CHANGES OR ADDITIONS OCCUR IN ELECTRICAL WORK, OR THE WORK OF OTHER CONTRACTORS BE REVISED BY THE ALTERNATE EQUIPMENT, THE COST OF ALL CHANGES SHALL BE BORNE BY THE CONTRACTOR.

EQUIPMENT GROUNDING CONDUCTORS

FUSE OR CB SIZE	SIZE (COPPER)
15	14
20	12
30	10
40	10
60	10
100	8
200	6
300	4
400	3
500	2
600	1
800	1/0
1000	2/0
1200	3/0
1600	4/0
2000	250
2500	350

GROUNDING ELECTRODE CONDUCTOR SERVICE ENTRANCE OR SEPARATELY DERIVED SYSTEM

COPPER CONDUCTOR	WIRE SIZE
#2 OR SMALLER	#8
1 OR 1/0	#6
2/0 OR 3/0	#4
>3/0 THRU 350 KCMIL	#2
>350 KCMIL THRU 600 KCMIL	1/0

FIXTURE SCHEDULE

SYMBOL	DESCRIPTION	MANUFACTURER	CATALOG NO.	VA	LAMP	MOUNTING	NOTES
F1	ENCLOSED INDUSTRIAL, FIBERGLASS HOUSING, WET LOCATION TWO LAMP FLUORESCENT 120 VOLT, INSTANT START ELECTRONIC BALLAST	LITHONIA METALUX HOLOPHANE	DMW 232 AR 120 GEB VT2-232DR-120V-EB81-WL-U EMS04YBBMP042EP1U	74	F32T8/ COOL WHITE	WALL OR CEILING AS SPECIFIED	
F2	EMERGENCY LIGHT WITH TWO HEADS, 90 MIN BATTERY POWER, WET LOCATION, 120 VAC	SURE-LITES	UMB16	16	20-16 HALOGEN LAMP	WALL	

RECORD DRAWINGS

Revisions Drawn by S. Riggs Date November 2011

THESE RECORD DRAWINGS HAVE BEEN PREPARED, IN PART, ON THE BASIS OF INFORMATION COMPILED BY OTHERS. THEY ARE NOT INTENDED TO REPRESENT IN DETAIL THE EXACT LOCATION, TYPE OF COMPONENT NOR MANNER OF CONSTRUCTION. THE ENGINEER WILL NOT BE RESPONSIBLE FOR ANY ERRORS OR OMISSIONS WHICH HAVE BEEN INCORPORATED INTO THE RECORD DRAWINGS.

JORDAN VALLEY WATER CONSERVANCY DISTRICT
SOUTHWEST AQUEDUCT REACH 2 PROJECT

DESIGN
DESIGN D. MAXWELL

REVIEW
CHECKED D. STEWART


VERIFY SCALE
BAR IS ONE INCH ON ORIGINAL DRAWING

ELECTRICAL
ELECTRICAL LEGENDS, SCHEDULES AND NOTES

DATE: FEBRUARY 2010 PROJECT NUMBER 010-08-03

DRAWING NO.
E-1

SHEET 97 OF 110

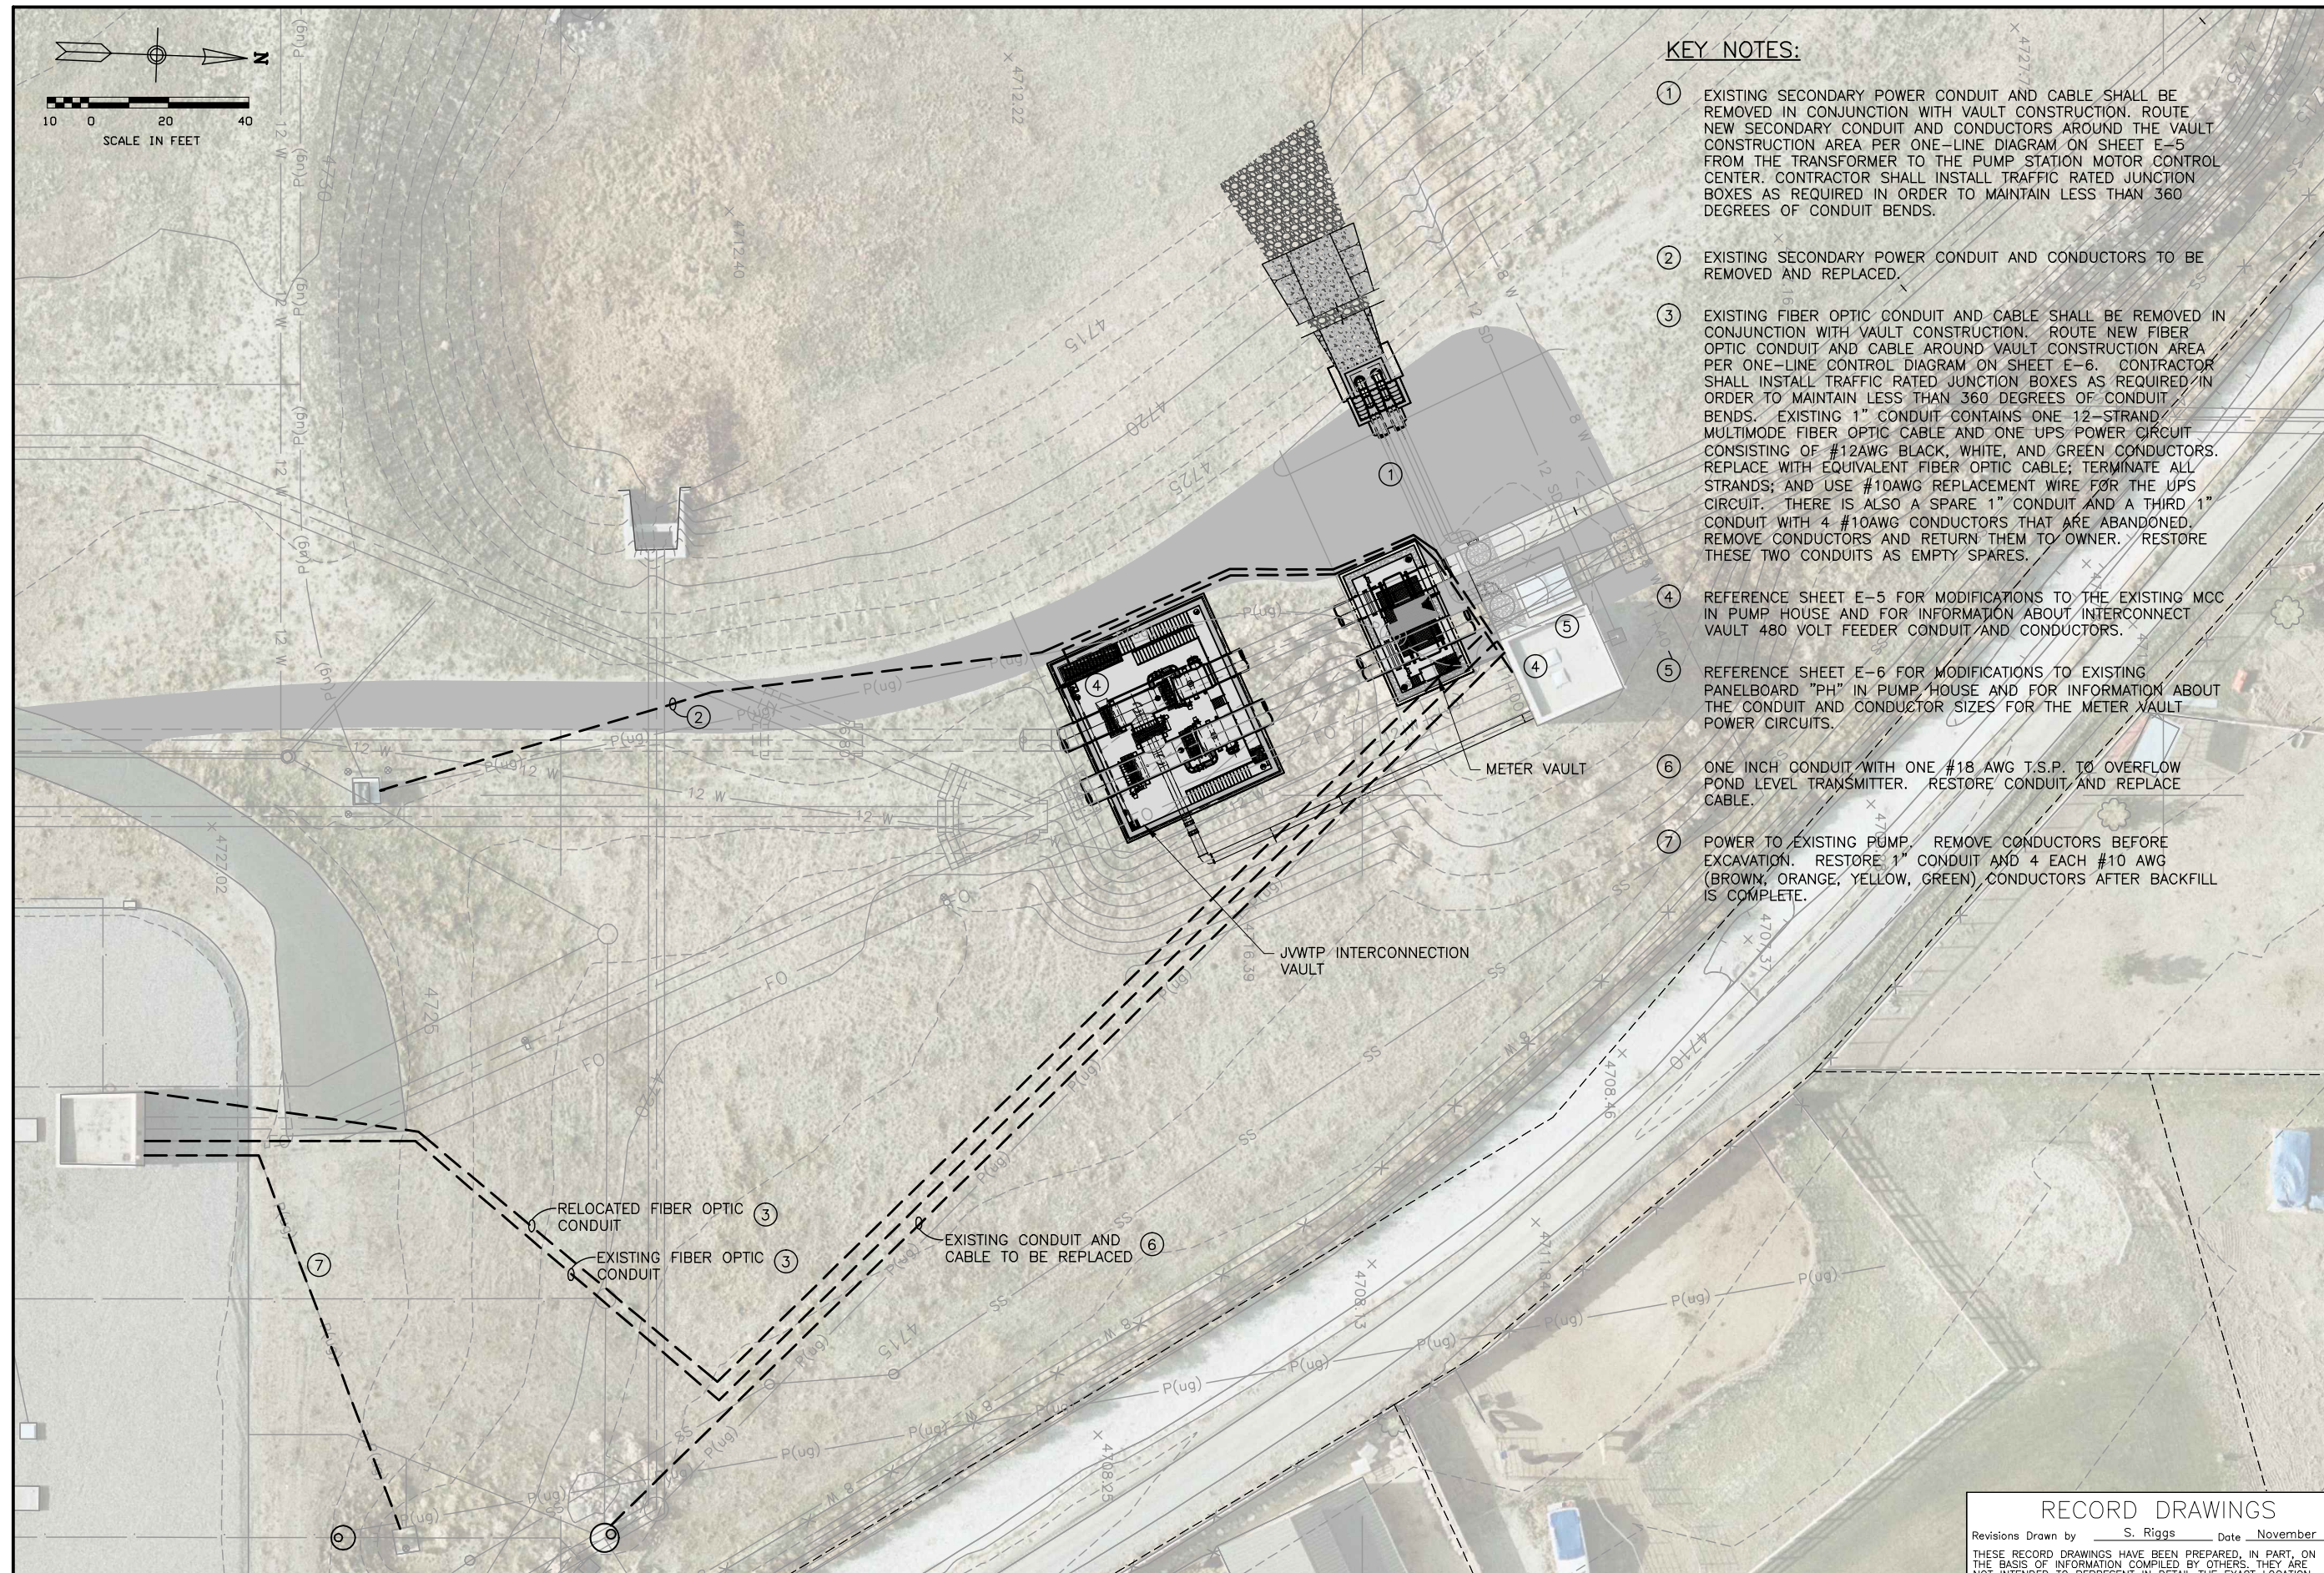

KEY NOTES:

② EXISTING SECONDARY POWER CONDUIT AND CONDUCTORS TO BE REMOVED AND REPLACED.

④ REFERENCE SHEET E-5 FOR MODIFICATIONS TO THE EXISTING MCC IN PUMP HOUSE AND FOR INFORMATION ABOUT INTERCONNECT VAULT 480 VOLT FEEDER CONDUIT AND CONDUCTORS.

⑥ ONE INCH CONDUIT WITH ONE #18 AWG T.S.P. TO OVERFLOW POND LEVEL TRANSMITTER. RESTORE CONDUIT AND REPLACE CABLE.


RELOCATED FIBER OPTIC CONDUIT (3)

EXISTING FIBER OPTIC CONDUIT (3)

METER VAULT

RECORD DRAWINGS

THESE RECORD DRAWINGS HAVE BEEN PREPARED, IN PART, ON THE BASIS OF INFORMATION COMPILED BY OTHERS. THEY ARE NOT INTENDED TO REPRESENT IN DETAIL THE EXACT LOCATION, TYPE OF COMPONENT NOR MANNER OF CONSTRUCTION. THE ENGINEER WILL NOT BE RESPONSIBLE FOR ANY ERRORS OR OMISSIONS WHICH HAVE BEEN INCORPORATED INTO THE RECORD DRAWINGS.

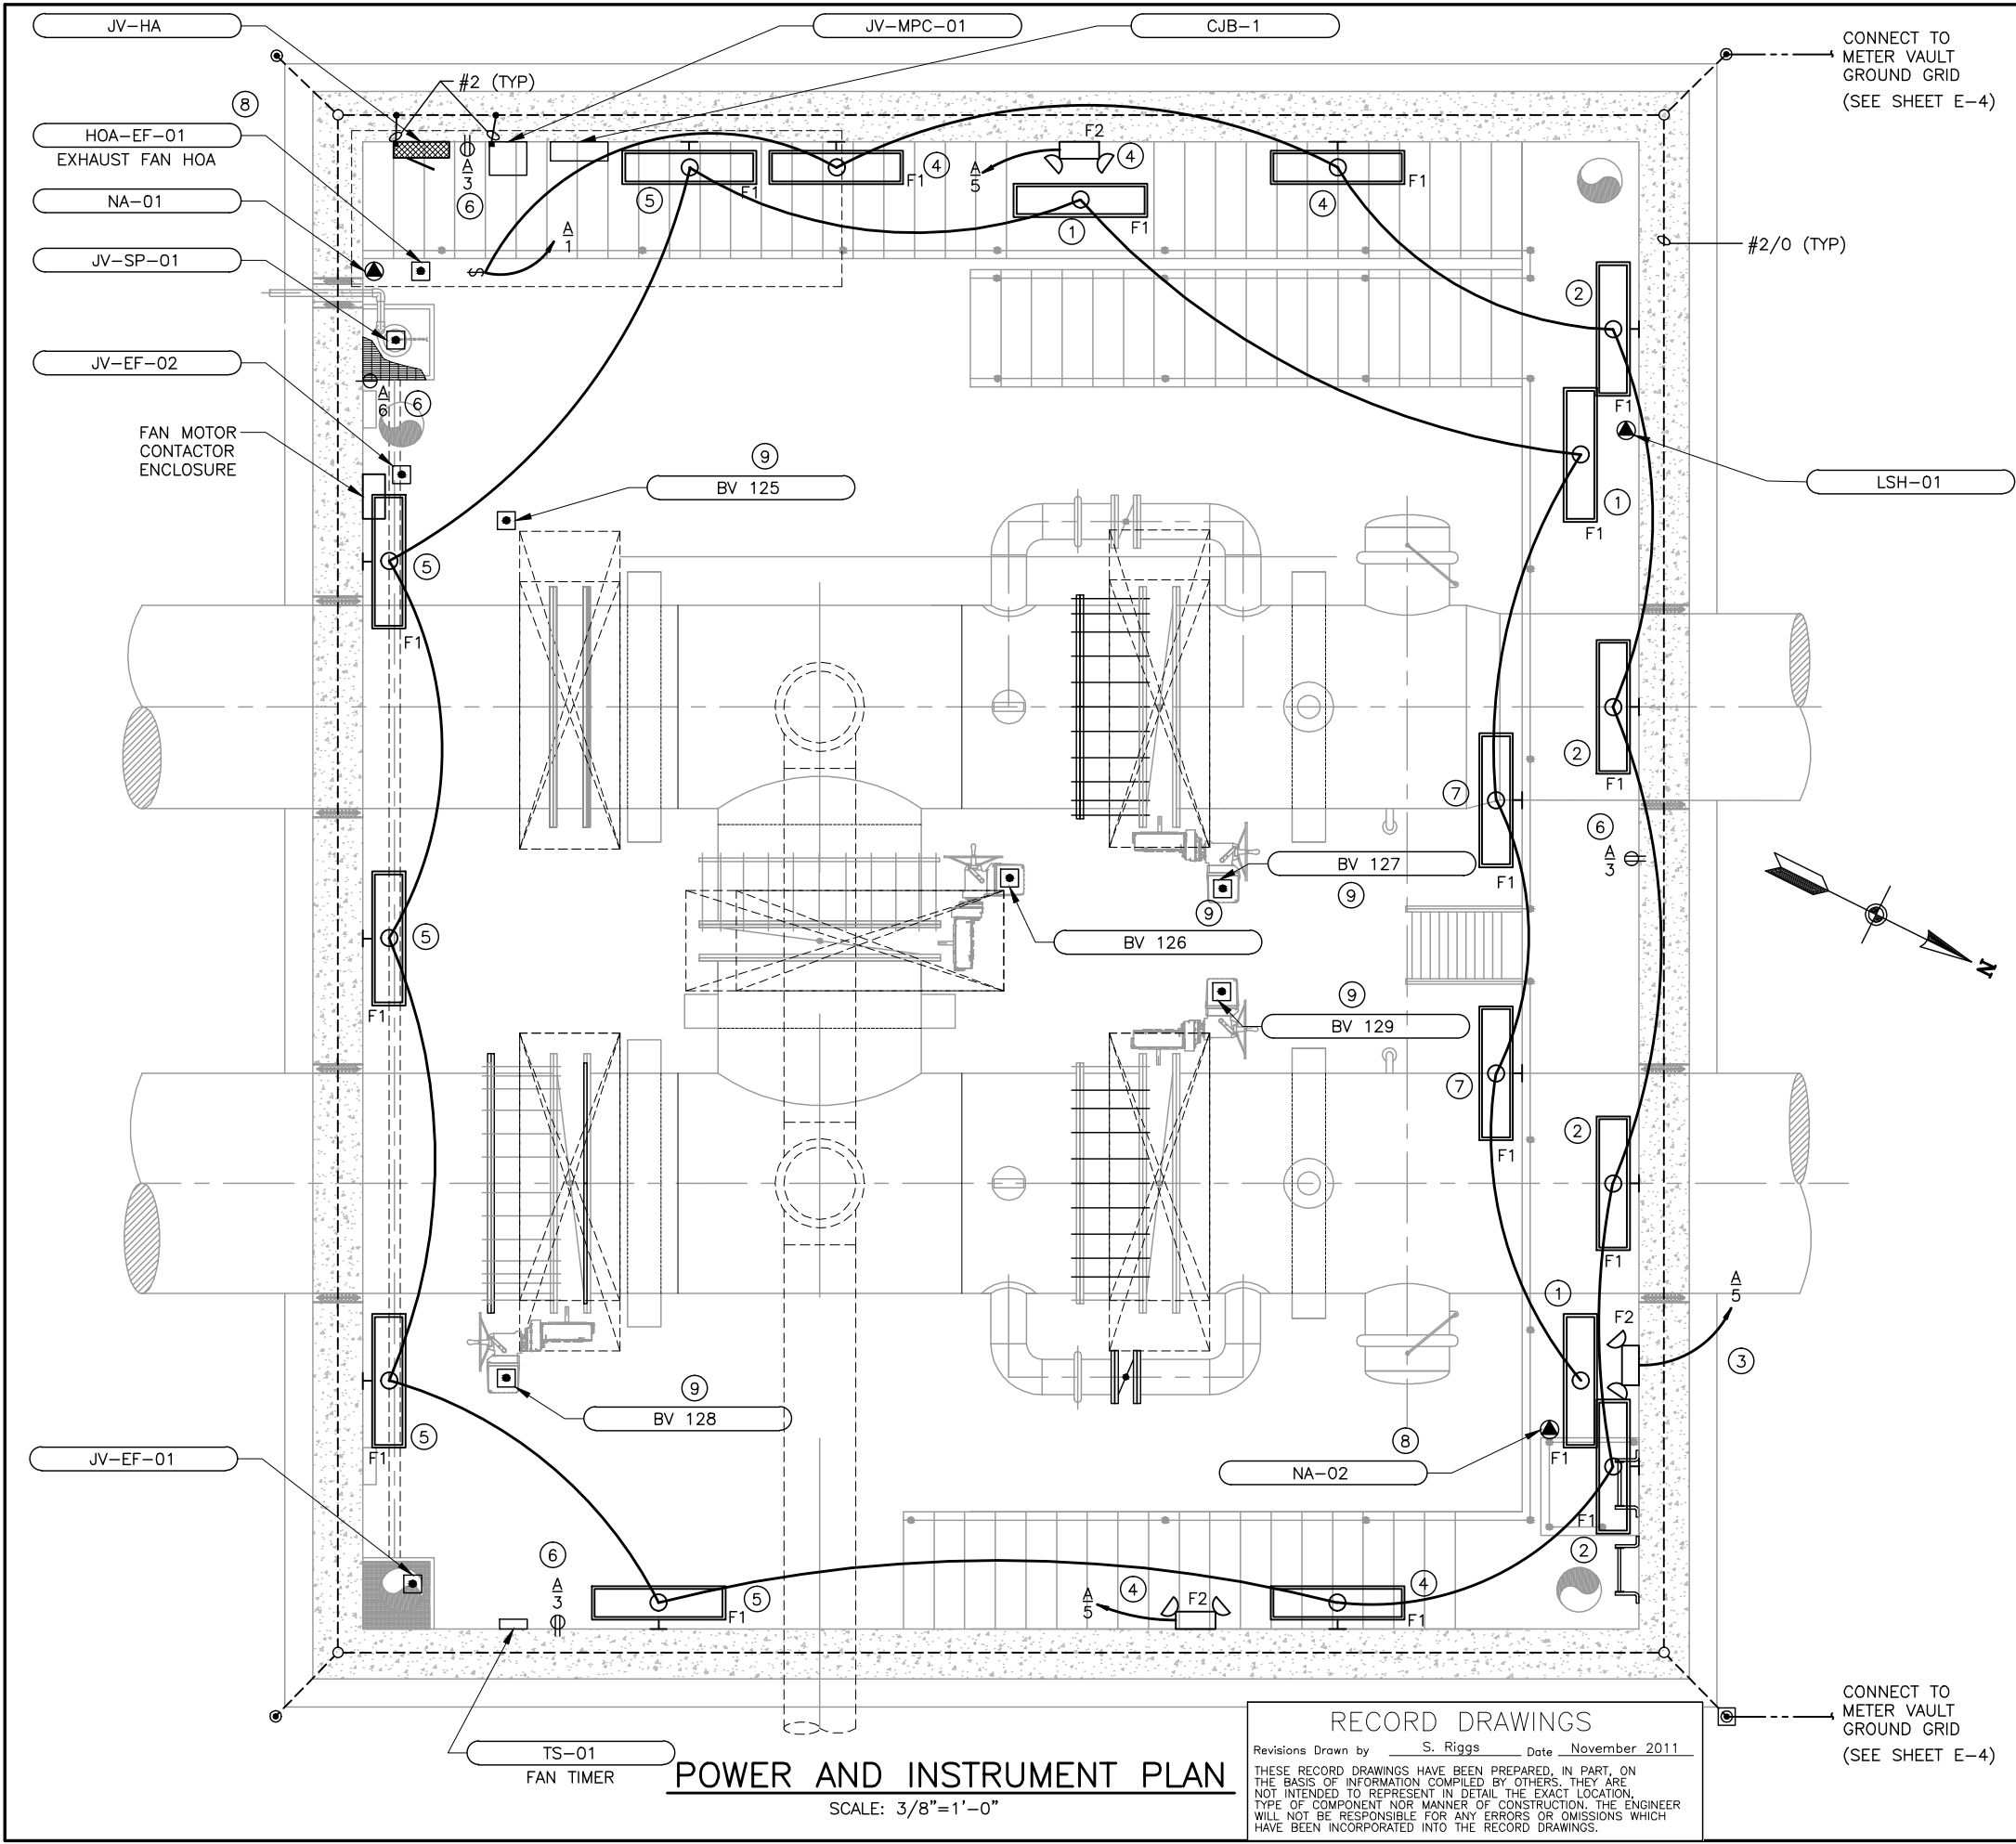

- GENERAL NOTES:**
- 2/0 AWG BARE COPPER GROUND RING SHALL BE BURIED NOT LESS THAN 30" BELOW THE EARTH'S SURFACE. CONNECT REBAR TO THE GROUND RING VIA 2/0 AWG BARE COPPER GROUND CABLE (GROUND RISERS). EQUIPMENT AND MISCELLANEOUS METALWORK SHALL BE CONNECTED TO THE GROUND RING WITH #2 AWG BARE COPPER GROUND CABLE. THE GROUND RING SHALL BE A MINIMUM OF 2 FEET FROM BUILDING FOUNDATION.
 - DRAWING SHOWS TYPICAL LOCATIONS OF GROUNDING SYSTEM COMPONENTS.
 - DRAWING SHOWS APPROXIMATE LOCATIONS AND MINIMUM NUMBER OF RISERS AND GROUNDING CONNECTIONS TO BE INSTALLED.
 - SUPPORT ELECTRICAL CONDUITS ON SUPPORTS INDEPENDENT OF PIPING. SUPPORTING ELECTRICAL CONDUIT OFF PIPING WILL NOT BE PERMITTED.
 - PROVIDE INSULATED UNION AT ELECTRICAL CONDUIT CONNECTIONS TO SENSORS OR EQUIPMENT IN CONTACT WITH PIPING.
 - SEE ONE-LINE POWER DIAGRAM AND PANEL SCHEDULE JV-LP-A ON SHEET E-5 AND ONE-LINE CONTROL DIAGRAM ON SHEET E-7 FOR CONDUIT/CONDUCTOR NUMBER AND SIZE.
 - FIELD COORDINATE FINAL EQUIPMENT LOCATION AND CONFIRM WITH ENGINEER PRIOR TO INSTALLATION.
 - FOR ACTUATOR INFORMATION SEE DWG M-1 FOR MECHANICAL EQUIPMENT SCHEDULE.

- KEY NOTES:**
- CEILING MOUNT FLUORESCENT FIXTURE UNDER STAIRWELL OR PLATFORM.
 - WALL MOUNT FLUORESCENT FIXTURE AT ABOUT 8' ABOVE FINISHED PLATFORM.
 - WALL MOUNT EMERGENCY FIXTURE AT ABOUT 16' ABOVE PLATFORM NEXT TO LADDER.
 - WALL MOUNT LIGHT FIXTURE AT ABOUT 7' ABOVE STAIRWAY.
 - WALL MOUNT FLUORESCENT FIXTURE AT ABOUT 12' ABOVE FLOOR.
 - MOUNT RECEPTACLES AT ABOUT 4' ABOVE FLOOR. SUMP PUMP RECEPTACLE SHALL BE A SIMPLEX RECEPTACLE WITHOUT GFCI PROTECTION. ALL OTHER RECEPTACLES SHALL BE DUPLEX GFCI RATED RECEPTACLES.
 - MOUNT FLUORESCENT FIXTURE TO PLATFORM. AVOID INTERFERENCE WITH LADDER AND PIPING.
 - EXHAUST FAN HOA SWITCHES, INTRUSION ALARMS AND LIGHT SWITCH ARE MOUNTED AT HATCH OPENING.
 - PROVIDE DC BLOCKERS ON ALL ELECTRICAL VALVE ACTUATORS AS SHOWN ON DETAIL 9, SHEET C-12.

PLAN SYMBOLS	
GROUNDING	
	GROUND ROD
	GROUND ROD WITH GROUND WELL
	GROUND RISER FROM THE GROUND PLATE
	BOLTED AND WELDED GROUND CONNECTIONS, RESPECTIVELY
	GROUND CABLE: EMBEDDED IN CONCRETE BURIED IN EARTH EXPOSED

RECORD DRAWINGS
Revisions Drawn by S. Riggs Date November 2011
THESE RECORD DRAWINGS HAVE BEEN PREPARED, IN PART, ON THE BASIS OF INFORMATION COMPILED BY OTHERS. THEY ARE NOT INTENDED TO REPRESENT IN DETAIL THE EXACT LOCATION, TYPE OF COMPONENT NOR MANNER OF CONSTRUCTION. THE ENGINEER WILL NOT BE RESPONSIBLE FOR ANY ERRORS OR OMISSIONS WHICH HAVE BEEN INCORPORATED INTO THE RECORD DRAWINGS.

JORDAN VALLEY WATER CONSERVANCY DISTRICT

SOUTHWEST AQUEDUCT REACH 2 PROJECT

ELECTRICAL

JWTP INTERCONNECTION VAULT ELECTRICAL PLAN

PROJECT NUMBER 010-08-03

DRAWING NO.

F-3

SHEET 99 OF 110

VERIFY SCALE

BAR IS ONE INCH ON ORIGINAL DRAWING

REVIEW

CHECKED D. STEWART



APPROVED D. MAXWELL

DESIGN

DESIGN D. MAXWELL

DRAWN D. LAMPH

DATE: FEBRUARY 2010

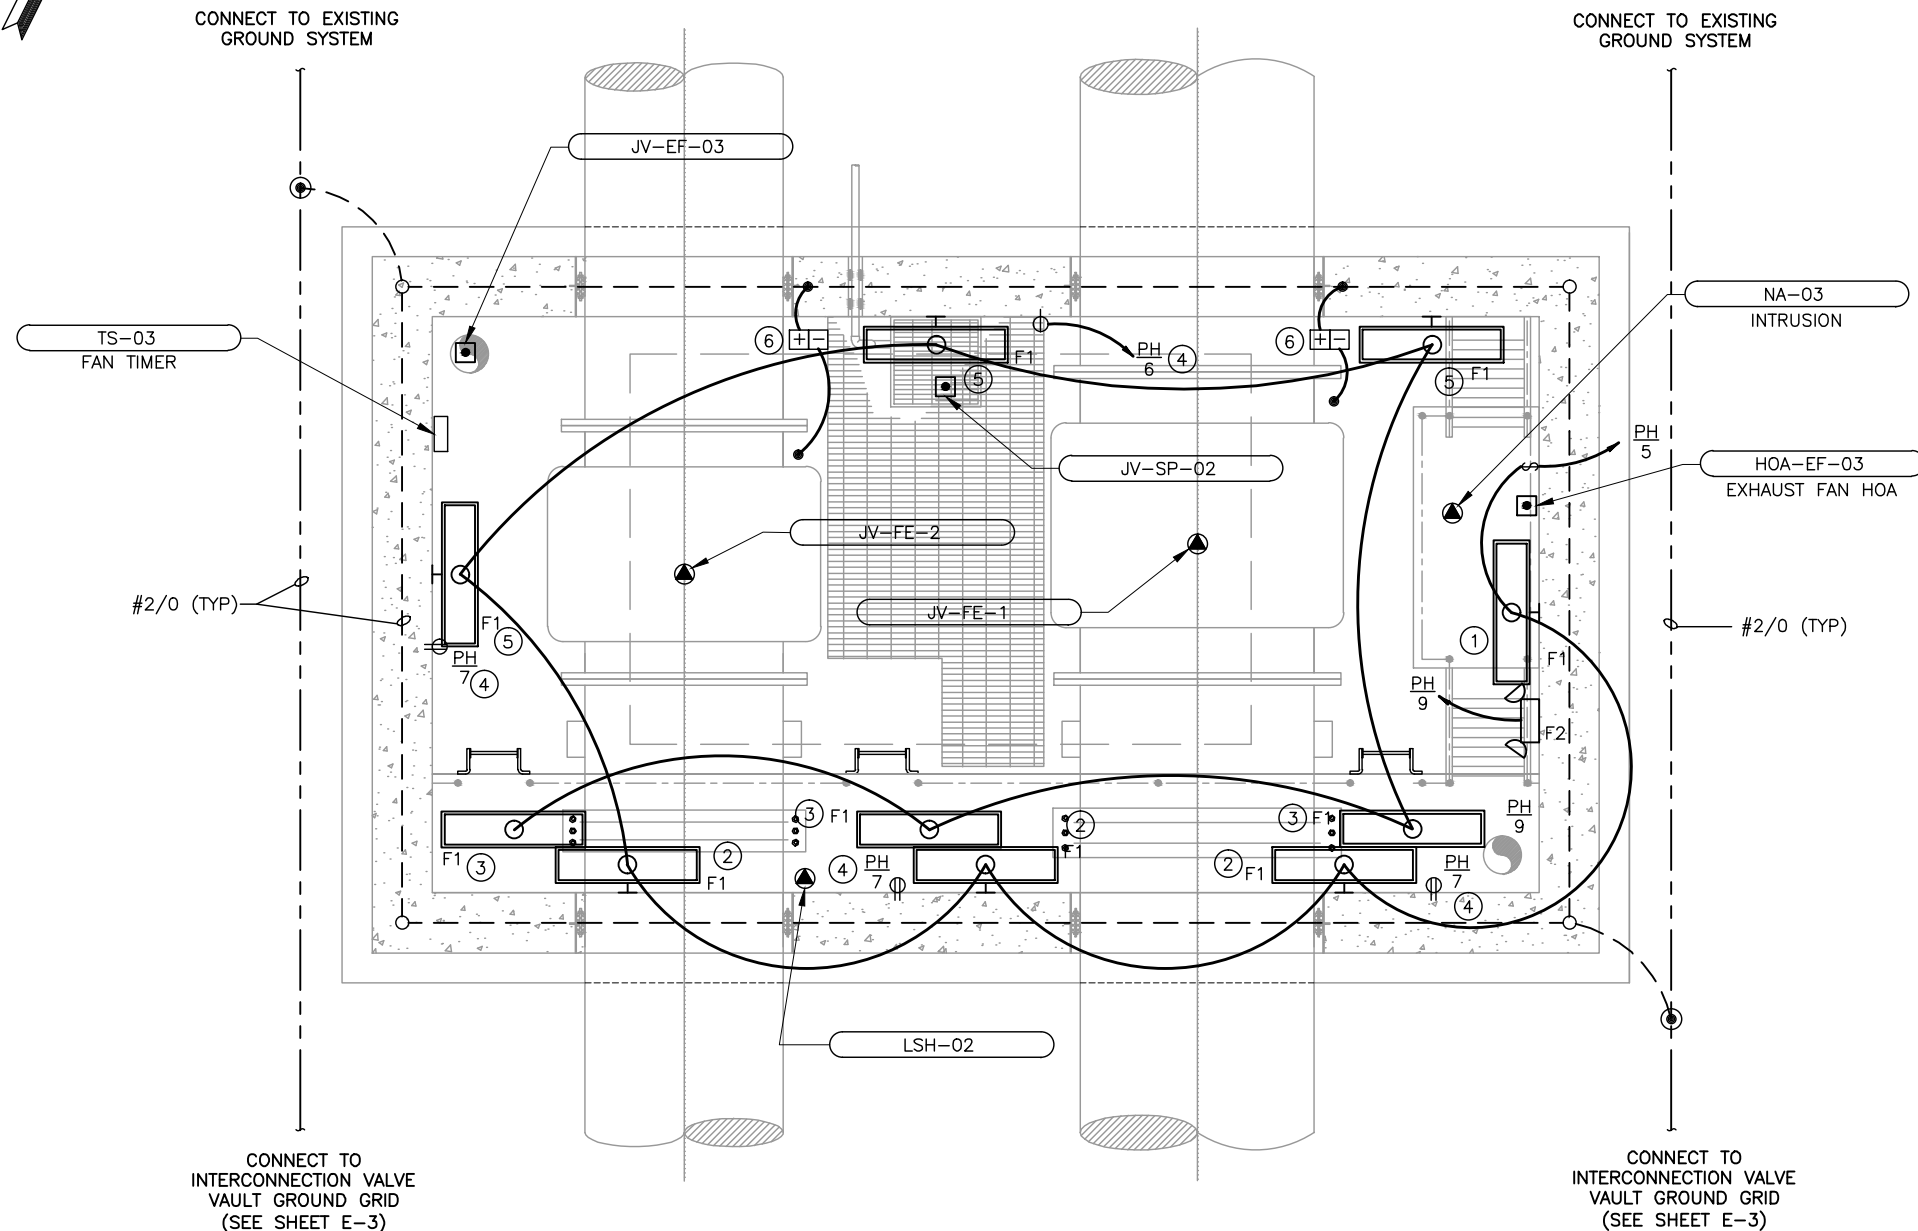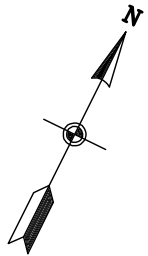

POWER, LIGHTING AND INSTRUMENT PLAN
3/8"=1'-0"

GENERAL NOTES:

- 2/0 AWG BARE COPPER GROUND RING SHALL BE BURIED NOT LESS THAN 30" BELOW THE EARTH'S SURFACE. CONNECT REBAR TO THE GROUND RING VIA 2/0 AWG BARE COPPER GROUND CABLE (GROUND RISERS). EQUIPMENT AND MISCELLANEOUS METALWORK SHALL BE CONNECTED TO THE GROUND RING WITH #2 AWG BARE COPPER GROUND CABLE. THE GROUND RING SHALL BE A MINIMUM OF 2 FEET FROM BUILDING FOUNDATION.
- DRAWING SHOWS TYPICAL LOCATIONS OF GROUNDING SYSTEM COMPONENTS.
- DRAWING SHOWS APPROXIMATE LOCATIONS AND MINIMUM NUMBER OF RISERS AND GROUNDING CONNECTIONS TO BE INSTALLED.
- SEE PANEL SCHEDULE PH ON SHEET E-6 AND ONE-LINE CONTROL DIAGRAM ON SHEET E-7 FOR CONDUIT/CONDUCTOR NUMBER AND SIZE.
- FIELD COORDINATE FINAL EQUIPMENT LOCATION AND CONFIRM WITH ENGINEER PRIOR TO INSTALLATION.
- SUPPORT ELECTRICAL CONDUITS ON SUPPORTS INDEPENDENT OF PIPING. SUPPORTING ELECTRICAL CONDUIT OFF PIPING WILL NOT BE PERMITTED.
- PROVIDE INSULATED UNION AT ELECTRICAL CONDUIT CONNECTIONS TO SENSORS OR EQUIPMENT IN CONTACT WITH PIPING.

KEY NOTES:


- WALL MOUNT FLUORESCENT FIXTURE AT ABOUT 7' ABOVE FINISHED LANDING. AVOID INTERFERENCE WITH LADDER OR USE THEREOF.
- WALL MOUNT FLUORESCENT FIXTURE AT ABOUT 8' ABOVE PLATFORM.
- CEILING MOUNT FLUORESCENT FIXTURE UNDER PLATFORM.
- MOUNT RECEPTACLES AT ABOUT 4' ABOVE FLOOR. SUMP PUMP RECEPTACLE SHALL BE A SIMPLEX RECEPTACLE WITHOUT GFCI PROTECTION. ALL OTHER RECEPTACLES SHALL BE DUPLEX GFCI RATED RECEPTACLES.
- WALL MOUNT FLUORESCENT FIXTURE AT ABOUT 8' ABOVE FINISHED FLOOR. AVOID INTERFERENCE WITH SUMP PUMP AND MAIN WATER PIPING.
- CONNECT GROUND GRID TO MAGMETER THROUGH DC BLOCKING DEVICES AS SHOWN ON DETAILS 7, 8 AND 9 OF SHEET C-12 (SIMILAR). MOUNT DC BLOCKING DEVICE ON WALL.

PLAN SYMBOLS	
GROUNDING	
	GROUND ROD
	GROUND ROD IN GROUND WELL
	GROUND RISER FROM THE GROUND PLATE (REBAR)
	BOLTED AND WELDED GROUND CONNECTIONS, RESPECTIVELY
	GROUND CABLE: <ul style="list-style-type: none">EMBEDDED IN CONCRETEBURIED IN EARTHEXPOSED

RECORD DRAWINGS

Revisions Drawn by S. Riggs Date November 2011

THESE RECORD DRAWINGS HAVE BEEN PREPARED, IN PART, ON THE BASIS OF INFORMATION COMPLIED BY OTHERS. THEY ARE NOT INTENDED TO REPRESENT IN DETAIL THE EXACT LOCATION, TYPE OF COMPONENT NOR MANNER OF CONSTRUCTION. THE ENGINEER WILL NOT BE RESPONSIBLE FOR ANY ERRORS OR OMISSIONS WHICH HAVE BEEN INCORPORATED INTO THE RECORD DRAWINGS.

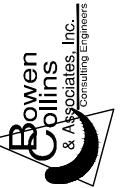

JORDAN VALLEY WATER CONSERVANCY DISTRICT
SOUTHWEST AQUEDUCT REACH 2 PROJECT

VERIFY SCALE
BAR IS ONE INCH ON ORIGINAL DRAWING

REVIEW
CHECKED D. STEWART
APPROVED D. MAXWELL

DESIGN
DESIGN D. MAXWELL
DRAWN D. LAMPH


ELECTRICAL
METER VAULT ELECTRICAL PLAN

PROJECT NUMBER 010-08-03

DATE: FEBRUARY 2010


DRAWING NO.
E-4

SHEET 100 OF 110

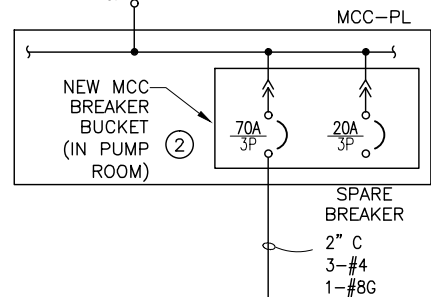

TOTAL WATTS:	1306	540	2,425	0	0	540	0	1119
CONTINUOUS LOAD:	2425							
CONTINUOUS LOAD *125%:	3,031		NOTE:					
NON-CONTINUOUS LOAD:	540							
DESIGN WATTS:	3,571							
MIN. RATING (AMPS):	15	0						

- ① SIZE OF CIRCUIT BREAKER MAY VARY WITH DIFFERENT SURGE PROTECTIVE DEVICE (SPD) MANUFACTURER REQUIREMENTS AND THE SIZE OF CONDUCTORS THE MANUFACTURER USES FOR THE SPD.
- ② THE CONTRACTOR SHALL SUPPLY AND INSTALL A NEW DUAL BREAKER BUCKET WITH TWO BREAKERS AS SHOWN ON THIS SHEET IN THE PUMP ROOM MOTOR CONTROL CENTER. THE NEW BUCKET WILL REPLACE THE EXISTING SPARE MOTOR START BUCKET. DELIVER EXISTING MCC BUCKET TO OWNER.

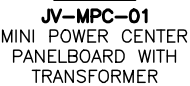

POWER ONE-LINE DIAGRAM


RECORD DRAWINGS

Revisions Drawn by S. Riggs Date November 2011







THESE RECORD DRAWINGS HAVE BEEN PREPARED, IN PART, ON THE BASIS OF INFORMATION COMPLIED BY OTHERS. THEY ARE NOT INTENDED TO REPRESENT IN DETAIL THE EXISTING LOCATION, TYPE OF COMPONENT NOR MANNER OF CONSTRUCTION. THE ENGINEER WILL NOT BE RESPONSIBLE FOR ANY ERRORS OR OMISSIONS WHICH HAVE BEEN INCORPORATED INTO THE RECORD DRAWINGS.


DRAWING NO.
E-7

SHEET 103 OF 110

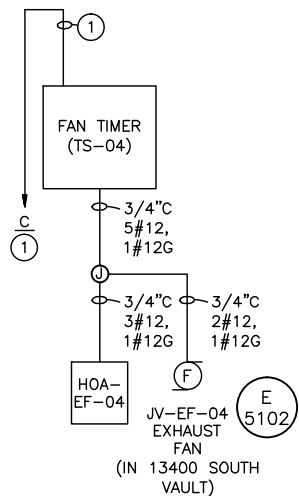



- ① SEE PANEL SCHEDULE JV-HB ON SHEET E-10 FOR CONDUIT/CONDUCTOR SIZE.
- ② FIBER CABLE CONDUIT SHALL BE INSTALLED IN THE SAME TRENCH AS THE POWER CONDUIT. SEE SHEET E-10 FOR DETAILS. ANY 90 DEGREE BENDS IN THE FIBER CONDUIT TO PUMP STATION RTU SHALL HAVE A RADIUS GREATER THAN OR EQUAL TO 3'. INSTALL TRAFFIC RATED PULLBOXES AS REQUIRED TO EASE PULLING.
- ③ THE FIBER SHALL MEET THE FOLLOWING:
FIBER OPTIC CABLE SHALL MEET THE FOLLOWING REQUIREMENTS:
 - FIBER TYPE: MULTIMODE FIBER
 - NUMBER OF FIBERS: 12
 - CORE DIAMETER: 62.5 MICRONS
 - CLADDING DIAMETER : 125 MICRONS
 - MAXIMUM ATTENUATION: 3.5 DB/KM @ 850 NM; 1.5 DB/KM @ 1300 NM
 - BANDWIDTH: 200 MHZ X KM @ 850 NM; 500 MHZ X KM @ 1300 NM
 - BUFFER TYPE: LOOSE TUBE
 - CABLE FILL: WATER BLOCKING TAPE
 - CABLE CENTRAL STRENGTH MEMBER: DIELECTRIC
 - OUTER JACKET: FLAME-RETARDANT, UV- RESISTANT PVC
 - MAX. RECOMMENDED PULLING LOAD: 600LBF (2700 N)
 - OUTER TEMPERATURE RANGE: -40 °C TO +70 °C
 - PACKING: SPOOLS/REELS, PROTECTED DURING SHIPMENT
 - MANUFACTURE: CORNING CABLE SYSTEMS

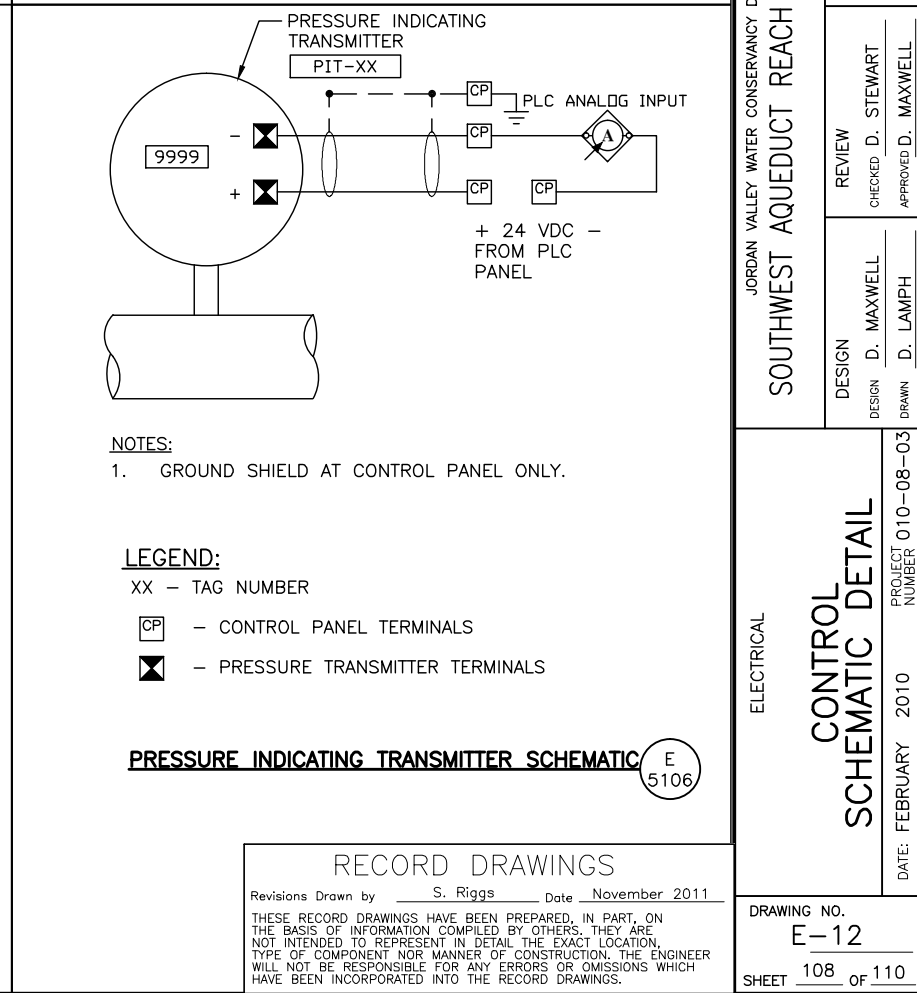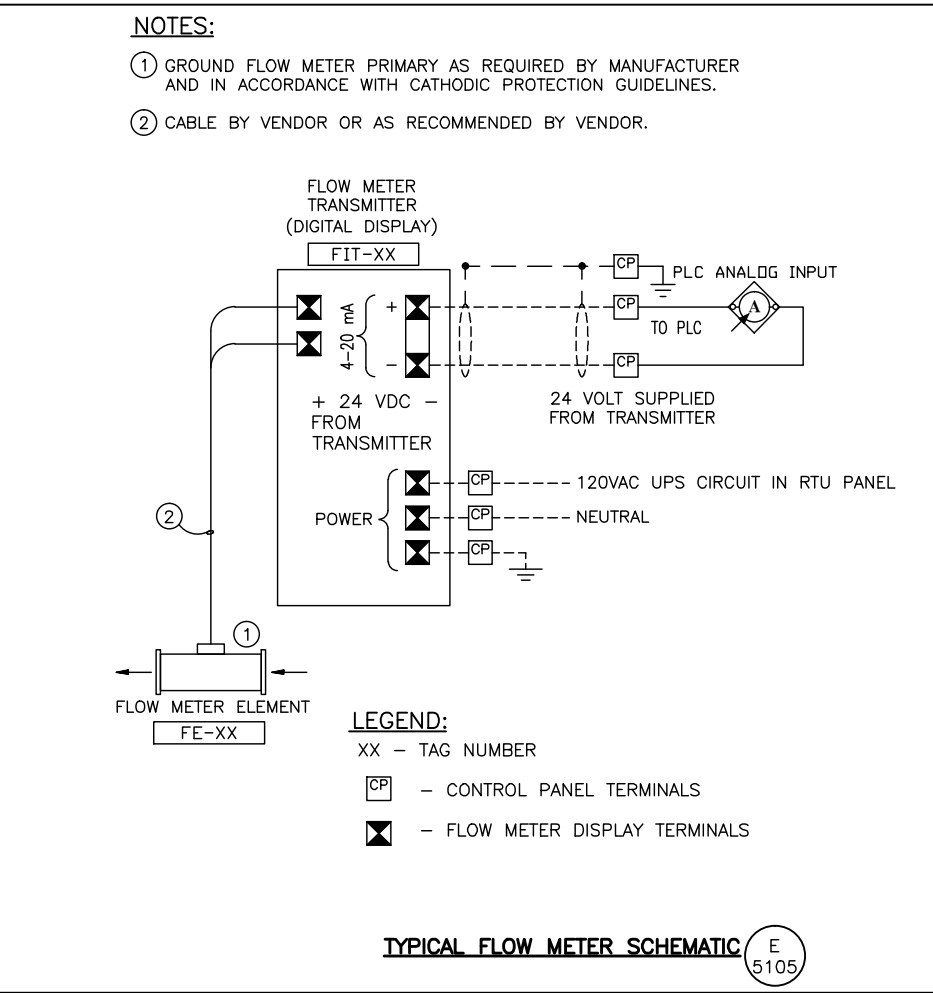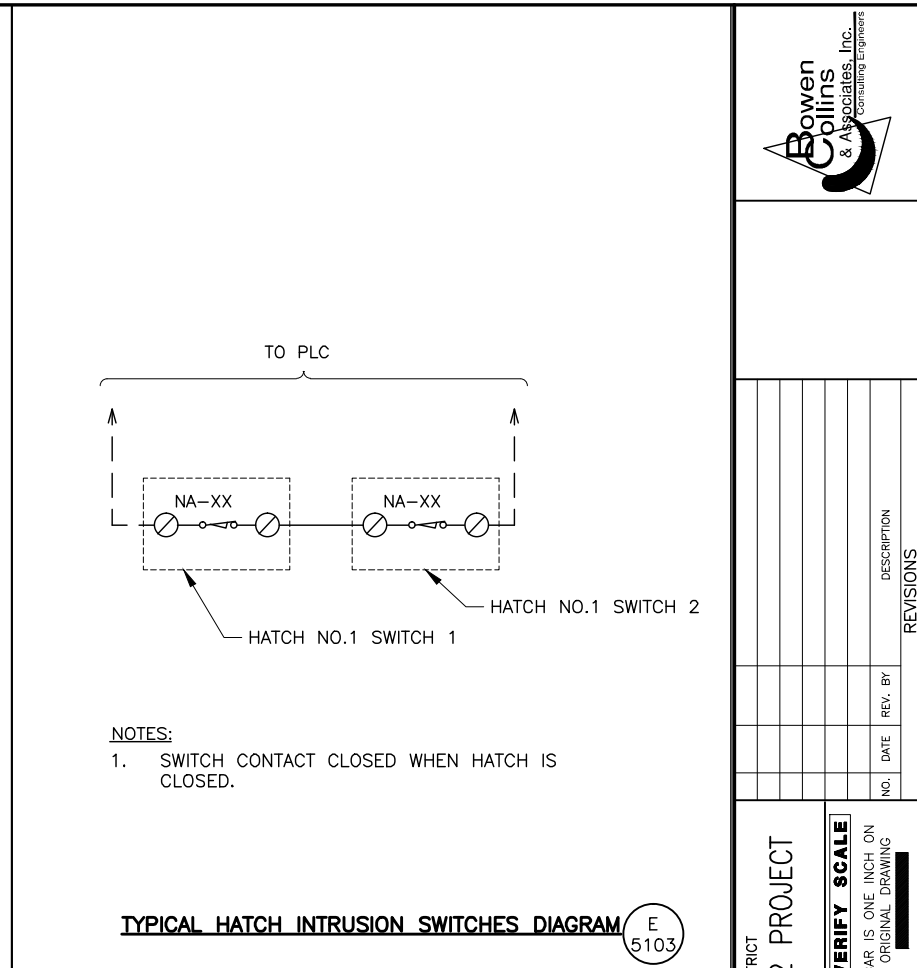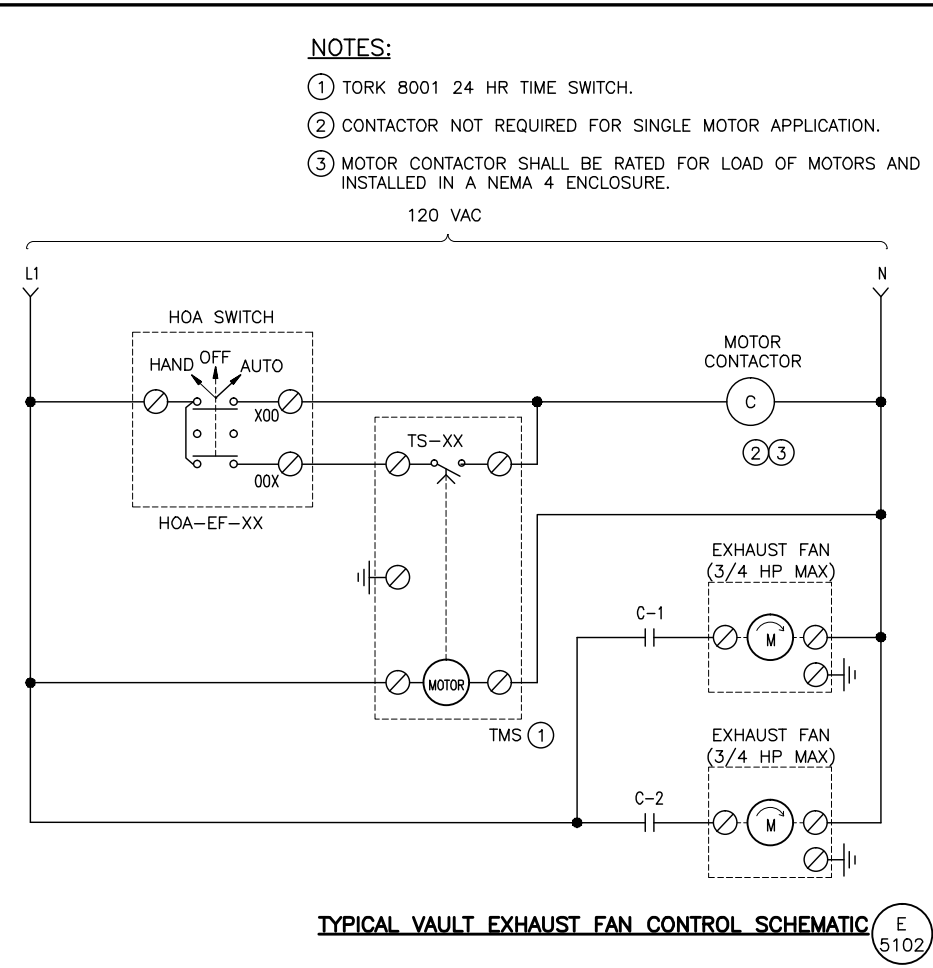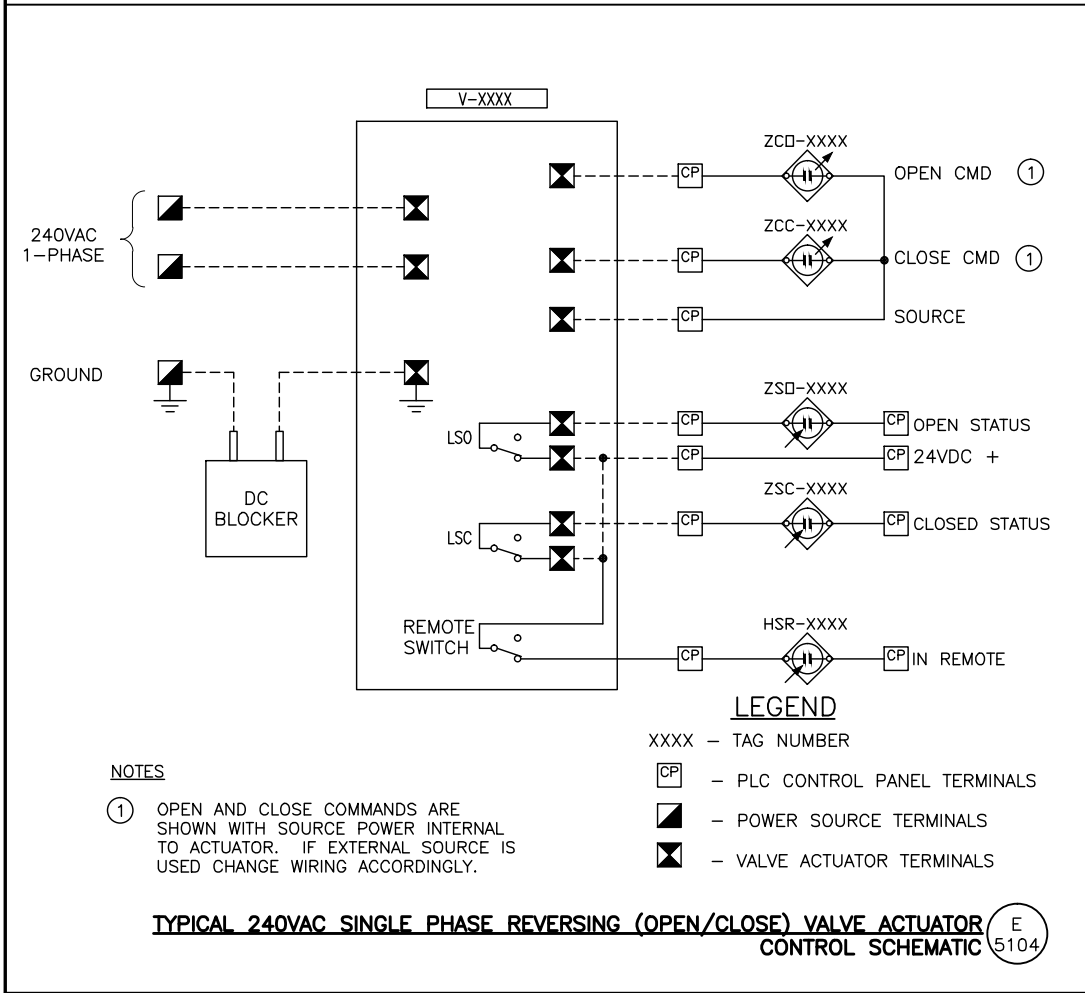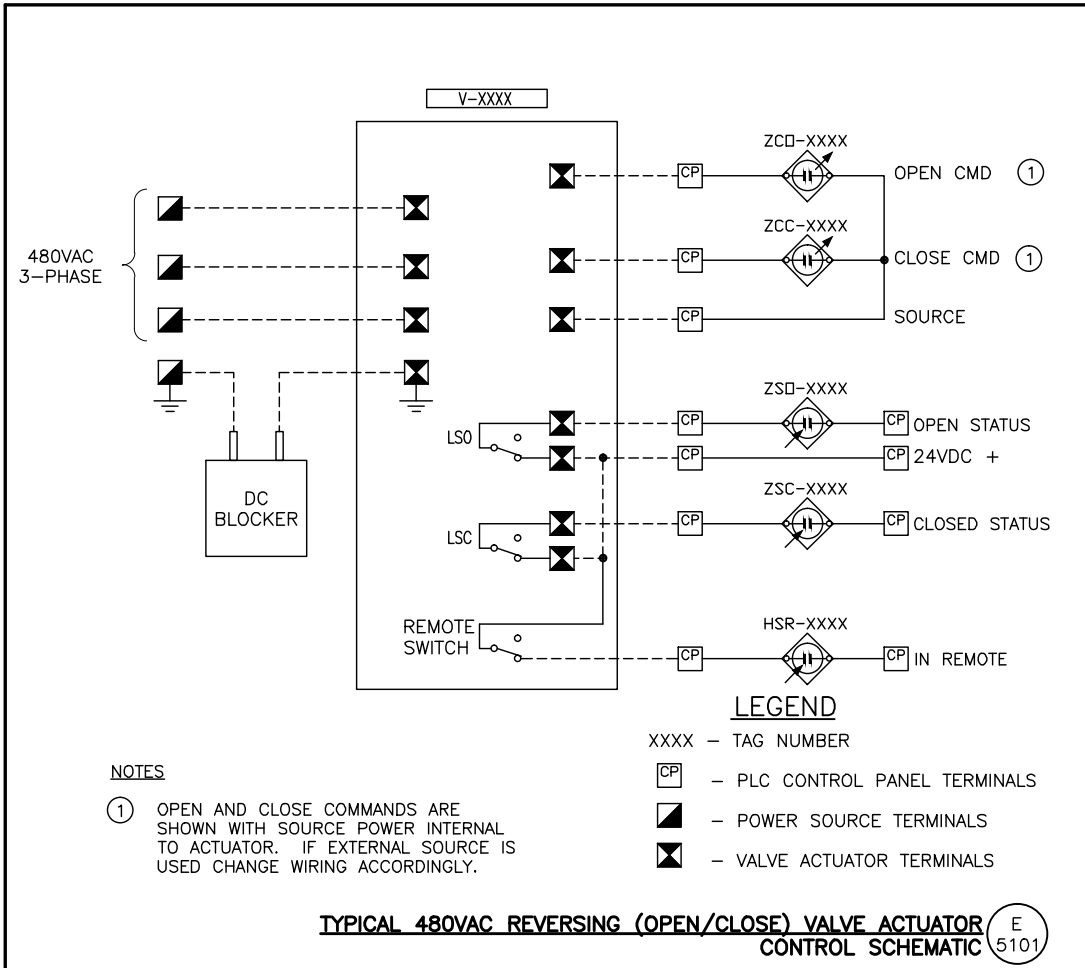

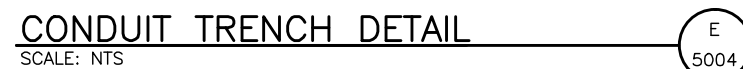

NA _____ E
SCALE: NTS 5005

THESE RECORD DRAWINGS HAVE BEEN PREPARED, IN PART, ON THE BASIS OF INFORMATION COMPILED BY OTHERS. THEY ARE NOT INTENDED TO REPRESENT IN DETAIL THE EXACT LOCATION, TYPE OF COMPONENT NOR MANNER OF CONSTRUCTION. THE ENGINEER WILL NOT BE RESPONSIBLE FOR ANY ERRORS OR OMISSIONS WHICH HAVE BEEN INCORPORATED INTO THE RECORD DRAWINGS.

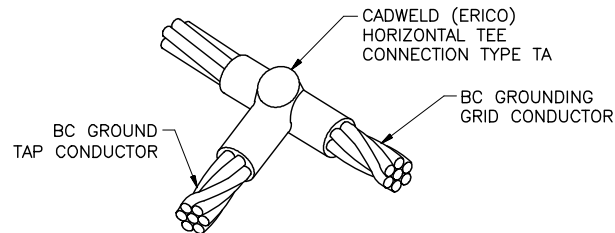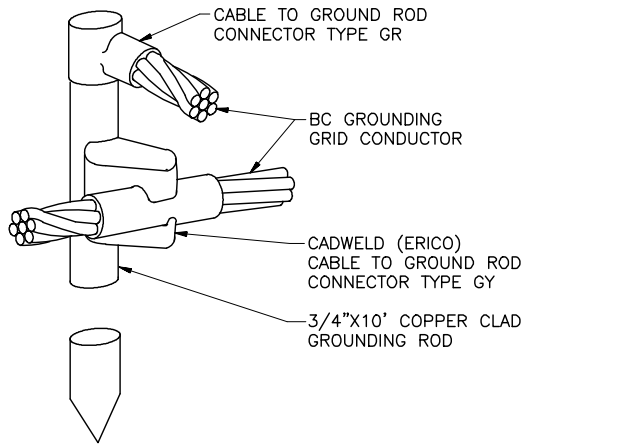

GROUND CONNECTION DETAIL
SCALE: NTS


E
5006

NA
SCALE: NTS

E
5007

NA
SCALE: NTS

E
5008

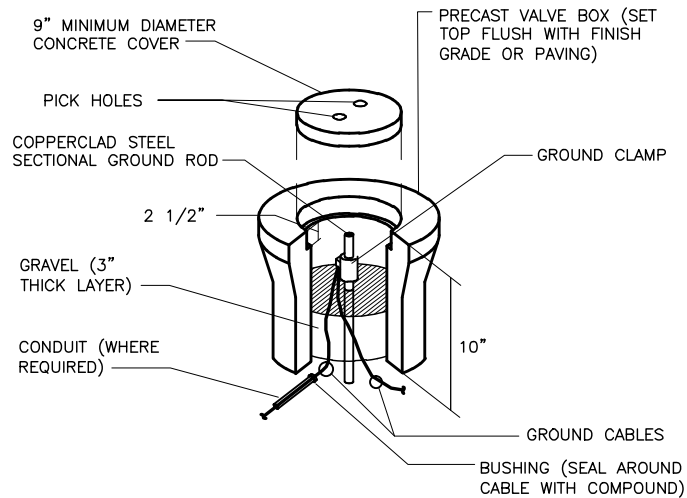

GROUND ROD AND WELL DETAIL
SCALE: NTS


E
5009

**GROUND
ROD INSTALLATION DETAIL**
SCALE: NTS

E
5010

NOTES

1. ALL CONDUITS ARE NOT SHOWN IN THIS DETAIL. REFER TO OTHER DRAWINGS FOR SIZE AND NUMBER OF CONDUITS.
2. CONTRACTOR SHALL SIZE PULL BOX IN ACCORDANCE WITH NEC AND IF APPLICABLE CABLE MANUFACTURER'S RECOMMENDATIONS.

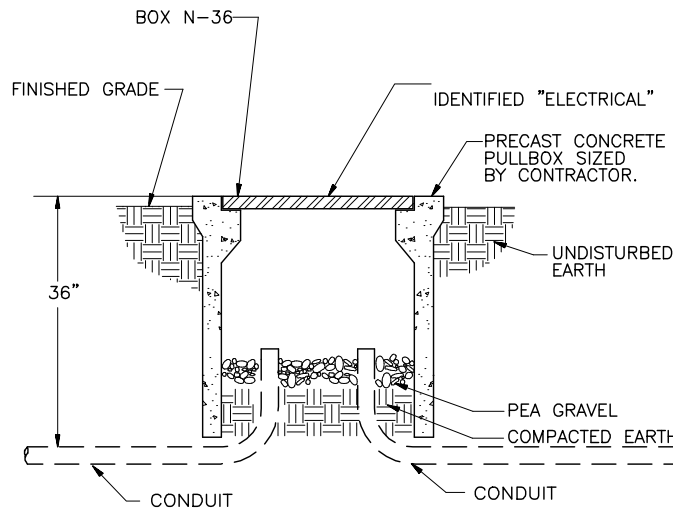


PULL BOX DETAIL
SCALE: NTS

E
5011

NOTES:

1. LUGGED AND BOLTED, INSULATED WITH 1/2 LAPPED LAYER OF VARNISHED CAMBRIC TAPE AND TWO 1/2 LAPPED LAYERS OF VINYL PLASTIC ELECTRICIANS TAPE WITH IRREGULAR SURFACES PADDED PER SPEC.

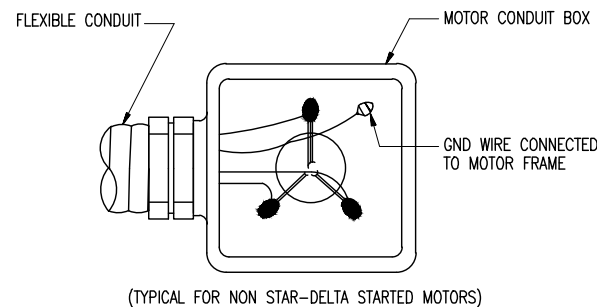

MAKEUP AT MOTOR DETAIL
SCALE: NTS

RECORD DRAWINGS

Revisions Drawn by S. Riggs Date November 2011

THESE RECORD DRAWINGS HAVE BEEN PREPARED, IN PART, ON THE BASIS OF INFORMATION COMPILED BY OTHERS. THEY ARE NOT INTENDED TO REPRESENT IN DETAIL THE EXACT LOCATION, TYPE OF COMPONENT NOR MANNER OF CONSTRUCTION. THE ENGINEER WILL NOT BE RESPONSIBLE FOR ANY ERRORS OR OMISSIONS WHICH HAVE BEEN INCORPORATED INTO THE RECORD DRAWINGS.

JORDAN VALLEY WATER CONSERVANCY DISTRICT
SOUTHWEST AQUEDUCT REACH 2 PROJECT

ELECTRICAL

**ELECTRICAL
DETAILS - 2**

DRAWING NO.
E-14

SHEET 110 OF 110

VERIFY SCALE
BAR IS ONE INCH ON ORIGINAL DRAWING

REVIEW
CHECKED D. STEWART
APPROVED D. MAXWELL

DESIGN
DESIGN D. MAXWELL
DRAWN D. LAMPH

DATE: FEBRUARY 2010 PROJECT NUMBER 010-08-03

NO. DATE REV. BY DESCRIPTION REVISIONS