# **CONTRACT DOCUMENTS**

FOR CONSTRUCTION OF THE

# ROSECREST PIPELINE CAPACITY UPGRADES

Volume 1 of 2 DRAWINGS

**60% REVIEW** 



# JORDAN VALLEY WATER CONSERVANCY DISTRICT


# JORDAN VALLEY WATER CONSERVANCY DISTRICT

For Information Regarding this Project Contact: Lindsay Minck, P.E. 154 E 14075 S Draper, Utah 82020 (801) 495-2224




# DRAWINGS FOR CONSTRUCTION OF THE ROSECREST PIPELINE CAPACITY UPGRADES

JORDAN VALLEY WATER CONSERVANCY DISTRICT HERRIMAN AND RIVERTON CITY, UT

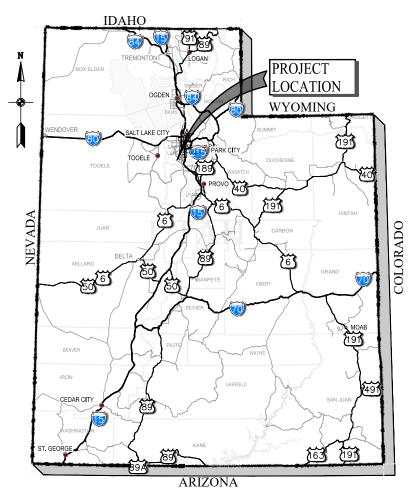


PROJECT LOCATION MAP

# 60% REVIEW

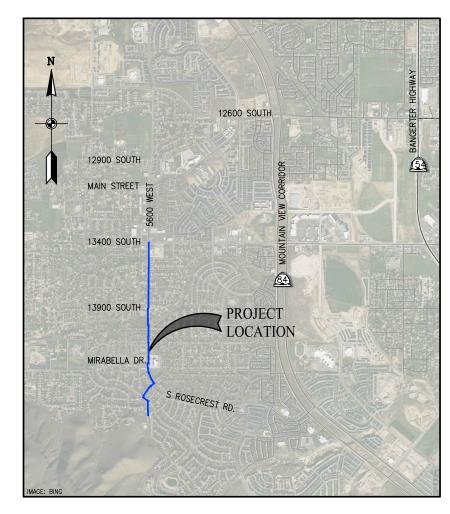

PROJECT VICINITY MAP

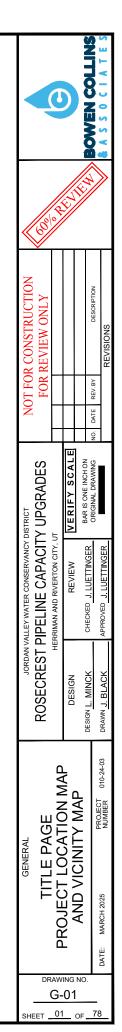

CIVIL/MECHANICAL

CATHODIC PROTECTION

STRUCTURAL

ECTRICAL/INSTRUMENTATION \_\_\_


	Sheet List Table							
Sheet Number	Sheet Title	Sheet Description						
		GENERAL						
00	G-00	DRAWINGS						
01	G-01	TITLE PAGE PROJECT LOCATION MAP AND VICINITY MAP						
02	G-02	INDEX OF DRAWINGS						
03	G-03	ABBREVIATIONS						
04	G-04	SYMBOLS						
05	G-05	GENERAL NOTES						
06	G-06	OVERALL DRAWING INDEX MAP						
07	G-07	OVERALL ROSECREST HYDRAULIC PROFILE AND DESIGN CRITERIA						
		PLAN & PROFILE						
08	PP-01	PLAN & PROFILE - 1						
09	PP-02	PLAN & PROFILE - 2						
10	PP-03	PLAN & PROFILE - 3						
11	PP-04	PLAN & PROFILE - 4						
12	PP-05	PLAN & PROFILE - 5						
13	PP-06	PLAN & PROFILE - 6						
14	PP-07	PLAN & PROFILE - 7						
15	PP-08	PLAN & PROFILE - 8						
16	PP-09	PLAN & PROFILE - 9						
17	PP-10	PLAN & PROFILE - 10						
18	PP-11	PLAN & PROFILE - 11						
		CIVIL						
19	C-01	JVWCD CHLORINATION BUILDING AND RESERVOIR VAULT						
20	C-02	ROSECREST PIPELINE MAINLINE ISOLATION VALVE VAULT						
21	C-03	13400 SOUTH INTERSECTION SITE PLAN						
22	C-04	BLOWOFF STRUCTURE						
23	C-10	RESERVOIR VAULT CROSS SECTIONS						
24	C-11	POTHOLE DATA						
GENERAL CIVIL DETAILS								
25 GC-01 GENERAL CIVIL DETAILS - 1								
26	GC-02	GENERAL CIVIL DETAILS - 2						
27	GC-03	GENERAL CIVIL DETAILS - 3						
28	GC-04	GENERAL CIVIL DETAILS - 4						
29	GC-05	GENERAL CIVIL DETAILS - 5						
30	GC-06	GENERAL CIVIL DETAILS - 6						
31	GC-07	GENERAL CIVIL DETAILS - 7						
32	GC-08	GENERAL CIVIL DETAILS - 8						
CATHODIC PROTECTION								
33	CP-01	CATHODIC FINOTECTION  CATHODIC PROTECTION SCHEDULES, GENERAL NOTES, AND DETAILS - 1						
34	CP-01 CP-02	CATHODIC PROTECTION SCHEDULES, GENERAL NOTES, AND DETAILS - 1						
35	CP-02 CP-03	CATHODIC PROTECTION DETAILS - 1  CATHODIC PROTECTION DETAILS - 2						
33	O1 =03	STRUCTURAL						
20	0.04							
36	S-01	ROSECREST ROAD VAULT FOUNDATION PLAN						
37	S-02	ROSECREST ROAD VAULT ROOF PLAN						
38	S-03	ROSECREST ROAD VAULT SECTIONS						
39	S-04 S-05	DOCKY DOINT DRIVE VALUET CTRUCTURAL DUAN AND CECTIONS						
40		ROCKY POINT DRIVE VAULT STRUCTURAL PLAN AND SECTIONS						
41	S-06	DOSCOPEST DESERVADO VALIDA CONTROLO DA SASE DI AMI						
42	S-07 S-08	ROSECREST RESERVOIR VAULT STRUCTURAL BASE PLAN ROSECREST RESERVOIR VAULT STRUCTURE ROOF PLAN						
43	S-08 S-09	ROSECREST RESERVOIR VAULT STRUCTURE ROOF PLAN ROSECREST RESERVOIR VAULT STRUCTURAL SECTIONS 1						
45	S-10	ROSECREST RESERVOIR VAULT STRUCTURAL SECTIONS						

Sheet Number   Sheet Title   Sheet Description							
GENERAL STRUCTURAL DETAILS							
	_						
46	GS-01	GENERAL STRUCTURAL NOTES					
47	GS-02						
48	GS-03						
49	GS-04						
50	GS-05						
		MECHANICAL					
51	M-01	PIPING SCHEDULE - 1					
52	M-02	PIPING SCHEDULE - 2					
53	M-03	EQUIPMENT AND VALVE SCHEDULES					
54	M-04	13400 SOUTH INTERCONNECT VAULT - PLAN					
55	M-05	13400 SOUTH INTERCONNECT VAULT - PROFILE A-B					
56	M-06	13400 SOUTH INTERCONNECT VAULT - PROFILE C					
57	M-07	ROCKY POINT DRIVE VAULT MECHANICAL PLAN AND SECTION					
58	M-08	ROSECREST RESERVOIR VAULT MECHANICAL PLAN					
59	M-09	ROSECREST RESERVOIR VAULT MECHANICAL SECTIONS					
60	M-10	ROSECREST RESERVOIR VAULT MECHANICAL PROFILE C					
	GE	ENERAL MECHANICAL DETAILS					
61	GM-01	GENERAL MECHANICAL DETAILS - 1					
62	GM-02	GENERAL MECHANICAL DETAILS - 2					
63	GM-03	GENERAL MECHANICAL DETAILS - 3					
64	GM-04	GENERAL MECHANICAL DETAILS - 4					
		ELECTRICAL					
65	E-01	ELECTRICAL LEGENDS, SYMBOLS, AND NOTES					
66	E-02	13400 SOUTH INTERCONNECT VAULT SITE PLAN					
67	E-03	13400 SOUTH INTERCONNECT VAULT LIGHTING PLAN					
68	E-04	13400 SOUTH INTERCONNECT VAULT ELECTRICAL PLAN					
69	E-05	13400 SOUTH INTERCONNECT VAULT POWER ONE-LINE DIAGRAM					
70	E-06	13400 SOUTH INTERCONNECT VAULT CONTROL BLOCK DIAGRAM					
71	E-07	ROSECREST RESERVOIR VAULT SITE PLAN					
72	E-08	ROSECREST RESERVOIR VAULT LIGHTING PLAN					
73	E-09	ROSECREST RESERVOIR VAULT ELECTRICAL PLAN					
74	E-10	ROSECREST RESERVOIR VAULT POWER ONE-LINE DIAGRAM					
75	E-11	ROSECREST RESERVOIR VAULT CONTROL BLOCK DIAGRAM					
	GI	ENERAL ELECTRICAL DETAILS					
76	GE-01	GENERAL ELECTRICAL DETAILS - 1					
77	GE-02	GENERAL ELECTRICAL DETAILS - 2					

ROSECREST PIPELINE CAPACITY UPGRADES
HERRIMAN AND RIVERTON CITY, UT

DESIGN
REVIEW
BAR IS ONE INCH ON
OHECKED J. LUETTINGER
PROGRAM ORIGINAL DRAWING
ORIGINAL DRAWING INDEX OF DRAWINGS DRAWING NO. G-02 SHEET 02 OF 78

				_		T		T		_			- 10
<b>©</b>	AT	CL	CHLORINATOR, CHAIN LINK, CENTERLINE OR	EQL SP	EQUALLY SPACED	ICFM	INLET CUBIC FEET PER MINUTE	NSF	NATIONAL SANITATION FOUNDATION	SP	SPACING, STATIC PRESSURE		Ž
AASHT0	AMERICAN ASSOCIATION OF STATE HIGHWAY TRANSPORTATION OFFICIALS	CLR	CHLORINE CLEAR, CLEARANCE	EQUIP	EQUIPMENT	ID II	INSIDE DIAMETER INVERT ELEVATION	NTS NW	NOT TO SCALE NORTHWEST	SPA	SPACED SPECIFICATION		Į⊢l
AB	ANCHOR BOLT	CLST	CEMENT LINED STEEL PIPE	ETC EVAP	ETCETERA EVAPORATOR	I IE	INVERT ELEVATION INSIDE FACE	NW	NORTHWEST	SPEC SPECS	SPECIFIED, SPECIFICATION SPECIFICATIONS	_ 7	₹<
ABBR	ABBREVIATION	CLSM	CONTROLLED LOW STRENGTH MATERIAL	EVC	END VERTICAL CURVE	IN	INCH			SPG	SPACING		ا ت ز
ABS AC	ACRYLONITRILE—BUTADIENE—STYRENE ASPHALTIC CONCRETE OR ALTERNATING	CM CML & C	CENTIMETER CEMENT MORTAR LINED AND COATED	EVCE	END VERTICAL CURVE ELEVATION	IN LB INFL	INCH-POUND	0 TO 0 0C	OUT TO OUT ON CENTER, OVER—CROSSING	SPKR	SPEAKER		20
	CURRENT OR ACTIVATED CARBON	CMP	CORRUGATED METAL PIPE	EVCS EW	END VERTICAL CURVE STATION EACH WAY, EYE WASH	INFL	INFLUENT INSULATING	OD OD	ON CENTER, OVER-CROSSING OUTSIDE DIAMETER, OVERALL DIMENSION	SPLY SPRT	SUPPLY SUPPORT		Ī ∽
ACI ACP	AMERICAN CONCRETE INSTITUTE ASPHALTIC CONCRETE PAVEMENT	CMU	CONCRETE MASONRY UNIT	EXH	EXHAUST	INVT	INVERT	OF	OUTSIDE FACE, OVERFLOW	SQ	SQUARE	]	S
ADDL	ADDITIONAL	CO COL	CLEANOUT COLUMN	EXIST	EXISTING	IOB IPS	INLET OUTLET BYPASS	OFS	OVERFLOW STRUCTURE	SQ FT	SQUARE FOOT	9	<u> </u>
ADJ	ADJACENT OR ADJUSTABLE	СОММ	COMMUNICATION	EXP ANR EXP JT	EXPANSION BOLT, ANCHOR EXPANSION JOINT	IRR	IRON PIPE SIZE IRRIGATION	OH OPER	OVERHEAD OPERATOR, OPERATING	SR SS	SUPPLY REGISTER SANITARY SEWER. SERVICE SINK		
AER AFF	AERATION ABOVE FINISH FLOOR	COMB CONC	COMBINED CONCRETE, CONCENTRIC	EXT	EXTERIOR, EXTENSION, EXTERNAL			OPNG	OPENING	SST	SANITART SEWER, SERVICE SINK STAINLESS STEEL		$\mathcal{L}_{L}$
AGGR	AGGREGATE	COND	CONDENSER. CONDENSATE			<b>1</b>	JORDAN AQUEDUCT	OPP OPIO	OPPOSITE	STA	STATION		//
AH	AIR HANDLER	CONN	CONNECTION	F	FAHRENHEIT, FACE	JA JBID	JORDAN BASIN IMPROVEMENT DISTRICT	ORIG OVHD	ORIGINAL OVERHEAD	STD STIFF	STANDARD STIFFENER		
AIR CONT AISC	AIR CONDITIONING  AMERICAN INSTITUTE OF STEEL CONSTRUCTION	CONST	CONSTRUCTION, CONSTRUCT	F TO F	FACE TO FACE	JT	JOINT	OZ	OUNCE	STL	STEEL	/0/05//	
		CONT COORD	CONTINUED, CONTINUOUS, CONTINUATION COORDINATE	FAB	FABRICATION, FABRICATE, OR FABRICATED	JTS JVWCD	JOINTS			STRL	STRUCTURAL	<i>[[8]</i>	
AL ALTN	ALUMINUM, ALUM ALTERNATIVE, ALTERNATE	COP	COPPER	FB	FLAT BAR		JORDAN VALLEY WATER CONSERVANCY DISTRICT	PC	PORTLAND CEMENT, POINT OF CURVE OR	SUC SWA	STRUCTURAL UNDERDRAIN COLLECTOR SOUTHWEST AQUEDUCT		
ANOD	ANODIZED	COTG	CLEAN-OUT TO GRADE COUPLING	FC FOA	FLEXIBLE COUPLING	JVWTP	JORDAN VALLEY WATER TREATMENT PLANT	1	PRIMARY CLARIFIER	SYM	SYMBOL		
ANSI	AMERICAN NATIONAL STANDARDS INSTITUTE	CPLG CPS	CULINARY PUMP STATION	FCA FCO	FLANGE COUPLING ADAPTER FLOOR CLEANOUT	k	KELVIN, KILO OR THOUSAND POUNDS	PCC PCF	PORTLAND CEMENT CONCRETE	SYMM	SYMMETRICAL		
APPROX	APPROXIMATE	CPVC	CHLORINATED POLYVINYL CHLORIDE	FD	FLOOR DRAIN	KG	KILOGRAM	PE	POUNDS PER CUBIC FOOT PLAIN END. POLYELECTROLYTE POLYMER.	SYS	SYSTEM		z
APVD	APPROVED	CS CTRD	CAST STEEL OR CAUSTIC SODA	FDN	FOUNDATION	KV	KILOVOLT	50	POLYETHYLENE				EPTIC
ARCH ARV	ARCHITECTURAL AIR RELEASE VALVE	CTR	CENTERED CENTER	FDR FEXT	FEEDER FIRE EXTINGUISHER	KW KWH	KILOWATT KILOWATT HOUR	PG	PRESSURE GAUGE	T, t	THICKNESS, TOP, TOILET		ESCF
ASME	AMERICAN SOCIETY OF MECHANICAL ENGINEERS	CTSK	COUNTERSUNK	FF	FLAT FACE, FAR FACE, FINISH FLOOR	1		pН	HYDROGEN ION CONCENTRATION	T&B T&G	TOP AND BOTTOM TONGUE AND GROOVE	TR V C	ျွန္
ASTM	AMERICAN SOCIETY FOR TESTING AND MATERIAL	CU FT	CUBIC FOOT	FG	FINISH GRADE, FLOW GLASS	1.	LEET OR LITER	PI	PLANT INFLUENT, POINT OF INTERSECTION	TAN	TANGENT	NS PA	Į O
		CU IN CU YD	CUBIC INCH CUBIC YARD	FH FLR	FIRE HYDRANT FLOOR	L LAB	LEFT OR LITER LABORATORY	PJF	PREMOLDED JOINT FILLER	TBC	TOP BACK OF CURB		EVIS
ASSY AUTO	ASSEMBLY AUTOMATIC	CULV	CULVERT	FL	FLOW LINE	LAV	LAVATORY	PL	PLATE, PROPERTY LINE, PLACE	TBM TDH	TEMPORARY BENCH MARK	R C RE	쮼
AUTO	AUXILIARY	CV	CHECK VALVE	FLEX	FLEXIBLE	LB	POUND	PLYWD PM	PLYWOOD PUMP, PROPELLER METER	TECH	TOTAL DYNAMIC HEAD TECHNICAL		E E
AVAR	AIR VACUUM AND AIR RELEASE VALVE	CWO	COLD WATER CHAIN WHEEL OPERATOR	FLG FM	FLANGE FORCE MAIN (SANITARY SEWER)	LC LF	LENGTH OF CURVE LINEAR FEET	POB	POINT OF BEGINNING	TEL	TELEPHONE	[ <u>[</u> ]	RE
AWS AWWA	AMERICAN WELDING SOCIETY  AMERICAN WATER WORKS ASSOCIATION	CYL	CYLINDER	FND	FOUND	LG .	LENGTH OR LONG	PP	POTASSIUM PERMANGANATE	TEMP THK	TEMPERATURE, TEMPORARY THICK		<u> </u>
AWWA	AMILITORIN WATER WORKS ASSUCIATION			FNSH	FINISH	LH LIP	LEFT HAND	PPD PPH	POUNDS PER DAY POUNDS PER HOUR	THR'D	THICK THREADED		ð
		d	PENNY	FO FRP	FIBER OPTIC FIBERGLASS REINFORCED PLASTIC	LIP	LIP OF GUTTER LIVE LOAD	PPM	PARTS PER MILLION	TK	TANK		ġ Z
B & S BC	BELL & SPIGOT	DBA	DEFORMED ANCHOR	FW	FINISH WATER	LLV	LONG LEG VERTICAL	PR	PAIR	TO TOO	TOP OF CONODETE	Ш	
BF	BEGIN CURVE, BOLT CIRCLE BLIND FLANGE. BUTTERFLY VALVE	DBL	DOUBLE	FWR	FINISH WATER RESERVOIR	LOL	LENGTH OF LINE	PRC	POINT OF REVERSE CURVE	TOC TOG	TOP OF CONCRETE TOP OF GRADE	S AL	§ <b>■</b>
BFG	BELOW FINISH GRADE	DC DEG	DIRECT CURRENT DEGREE			LP IR	LOW POINT LONG RADIUS	PREFAB PRI	PREFABRICATED PRIMARY	TP	TELEPHONE POLE, TURNING POINT		SAW
BFP BFV	BACK FLOW PREVENTER BUTTERFLY VALVE	DEMO	DEMOLITION, DEMOLISH	G	GAS	LT	LIGHT, LEFT	PRV	PRESSURE REGULATING/REDUCING VALVE	TW TYP	TOP OF WALL	UPGRAD ERIFY SO	ā H
BH BH	BORE HOLE	DEQ	DEPARTMENT OF ENVIRONMENTAL QUALITY	GA	GAGE, GAUGE	LVL	LEVEL	PS	,	1114	TYPICAL	7. CT	20
BHD	BULKHEAD	DET	DETAIL	GAL GALV	GALLON GALVANIZED	LWL LWR	LOW WATER LEVEL LOWER	PSF PSF	PRESSURE SWITCH, PUMP STATION POUNDS PER SQUARE FOOT	1		UP REP	Q N
BHP	BRAKE HORSEPOWER	DI	DUCTILE IRON, DROP INLET	GEN	GENERATOR	L''''\	LOWER	PSI	POUNDS PER SQUARE INCH	UBC	UNIFORM BUILDING CODE		
BLDG BLK	BUILDING BLACK OR BLOCK	DIA DIAG	DIAMETER DIAGONAL	GFI	GROUND FAULT INTERRUPTER	1		PSIG	POUNDS PER SQUARE INCH GAUGE	UD UG	UNDERDRAIN UNDERGROUND	CIT (IITY, U	<u> </u>
BLKG	BLOCKING	DIAC	DIAPHRAGM	GI	GALVANIZED IRON	I M	METER, MALE (PIPE THREAD)	PT PTDF	POINT OF TANGENT, PRESSURE TREATED PRESSURE TREATED DOUGLAS FIR	UH	UNIT HEATER	\$ 4 0   2	
BLT	BOLT	DIFF	DIFFUSER	GIS GL	GEOGRAPHIC INFORMATION SYSTEM GLASS	MACH MAN	MACHINE MAGNETIC, MANUAL	PV	PAVEMENT	UL	UNDERWRITERS LABORATORIES	AP, AP, VIEW	
BM BO	BEAM, BENCH MARK BLOW-OFF ASSEMBLY, BLOW-OFF	DIM DIP	DIMENSION DUCTILE IRON PIPE	GLAZ	GLAZING	MATL	MATERIAL	PVC	POLYVINYL CHLORIDE	UNO USBR	UNLESS NOTED OTHERWISE U.S. BUREAU OF RECLAMATION		4 3 E
BOR	BUREAU OF RECLAMATION	DIR	DIRECTION PIPE	GLV	GLOBE VALVE	MAX MB	MAXIMUM MACHINE BOLT	PVI PW	POINT OF VERTICAL INTERSECTION	3351	SIG. SOURCE OF THEORY MATION	ATER AND R AND R	
BOT BPS	BOTTOM BOOSTER DUMBING STATION	DISCH	DISCHARGE	GND GPD	GROUND GALLONS PER DAY	WCC WR	MACHINE BOLT MOTOR CONTROL CENTER	l "w	POTABLE WATER		VALVE VENT VOLT VARVIUM	WA.	30VE
BPS BPV	BOOSTER PUMPING STATION BACK PRESSURE VALVE	DIST DIV	DISTANCE DIVISION	GPH	GALLONS PER HOUR	MECH	MECHANICAL, MECHANISM			V VAR	VALVE, VENT, VOLT, VACUUM VARIES, OR VARIABLE	I≿Ш≴I ≝	AP PF
BRK	BRICK	D-LOAD	LOADING CONDITION FOR RCP	GPM GR	GALLONS PER MINUTE	MEMB MET	MEMBRANE METAL	RAD	RADIUS	VC	VERTICAL CURVE	A VALLE  T PIP  HERRIN  OF	己
BTU	BRITISH THERMAL UNIT	DMPR	DAMPER	GR BRK	GRADE GRADE BREAK, GRADE CHANGE	MEI MFR	METAL MANUFACTURER	RC RCP	REINFORCED CONCRETE REINFORCED CONCRETE PIPE	VCP	VITRIFIED CLAY PIPE	ST	
BTWN BUR	BETWEEN BUILT-UP ROOFING	DN DOT	DOWN, DECANT DEPARTMENT OF TRANSPORTATION	GRTG	GRATING	MG	MILLION GALLONS	RD RD	ROOF DRAIN OR ROAD	VERT VIC	VERTICAL VICTAULIC COUPLING		<u> </u>
BVC	BEGIN VERTICAL CURVE	DP DOI	DAMP PROOFING	GRV GSP	GROOVED GALVANIZED STEEL PIPE	MGD MH	MILLION GALLONS PER DAY MANHOLE, MONORAIL HOIST	RDCR	REDUCER, REDUCING	VOL	VOLUME		:   위
BVCE	BEGIN VERTICAL CURVE ELEVATION	DR	DOOR, DRAIN	GSP	GALVANIZED STEEL PIPE GATE VALVE	MI MI	MANHOLE, MONORAIL HOIST MALLEABLE IRON	RECIRC RED	RECIRCULATION REDUCING	VPI	VERTICAL POINT OF INFLECTION	SE SE IN	<u> </u>
BVCS BW	BEGIN VERTICAL CURVE STATION BACK WASH, FILTER BACKWASH	DS	DRENCH SHOWER & EYE WASH, DOWNSPOUT	GYP	GYPSUM BOARD	MID	MIDDLE	REF	REFERENCE, REFER	VSS VTC	VOLATILE SUSPENDED SOLIDS VENT THROUGH CEILING	ROSECRE DESIGN	, ₹
	. ,	DWG	DRAWING	1		MIL	1/1,000 INCH	REG	REGULATING, REGISTER	VTR	VENT THROUGH ROOF	DESI	DR.
C	CENTICPANE OR OF CHIE	DWL	DOWEL	<b>1</b> H	HEIGHT	MIN MISC	MINIMUM OR MINUTE MISCELLANEOUS	REINF	REINFORCE, REINFORCED	1		<u> </u>	$\dashv$
C CAB	CENTIGRADE OR CELSIUS CABINET			HAS	HEADED ANCHOR STUD	MJ	MECHANICAL JOINT	REQD REV	REQUIRED REVISION	I w	WEST, WASTE, WIDE FLANGE (BEAM)		_ [
CAP	CAPACITY	E(UG)	ELECTRICAL (UNDERGROUND)	HB	HOSE BIBB	MO	MASONRY OPENING	RF.	ROOF, RAISED FACE	" "/	WEST, WASTE, WIDE FLANGE (BEAM) WITH		24-03
CARV	COMBINATION AIR RELEASE VALVE	E(OH)	ELECTRICAL (OVERHEAD POWER)	HD HDPE	HUB DRAIN HIGH DENSITY POLYETHYLENE	MPH MTG	MILES PER HOUR MOUNTING	RND	ROUND	w/o	WITHOUT		310-2
CB CC	CATCH BASIN CENTER TO CENTER	E EA	EAST EACH	HDR	HEADER	MTL	METAL OR MATERIAL	RPM RP	REVOLUTIONS PER MINUTE RADIUS POINT	wc	WATER COLUMN OR WATER CLOSET		ا نا
CCP	CONCRETE CYLINDER PIPE	EB EB	EXPANSION BOLT	HDW HEX	HARDWARE	MTR	MOTOR	RS RP	RADIUS POINT RAW SEWAGE	WCO WD	WALL CLEANOUT WOOD	S	ER.
CD	CEILING DIFFUSER CHEMICAL DRAIN AND VENT	EC	END CURVE	HEX HGR	HEXAGONAL HANGER	MWS	MAXIMUM WATER SURFACE	RST	REINFORCING STEEL, RESET	WH	WATER HEATER	ĺ	PRO
CER	CERAMIC	ECC EF	ECCENTRIC EACH FACE, EXHAUST FAN	НМ	HOLLOW METAL	1		RT	REGULATING TANK, RADIOGRAPHIC, RIGHT	WS	WATER STOP, WATER SURFACE	_ <u> </u>	
CFH	CUBIC FEET PER HOUR	EFF	EFFLUENT	HORIZ HP	HORIZONTAL	N	NORTH	RV	ROOF VENT	WSP WSTP	WELDED STEEL PIPE WATER STOP	GENERAL ABBREVIATION	
CFM CFR	CUBIC FEET PER MINUTE CODE OF FEDERAL REGULATIONS	EG	EXISTING GRADE		HORSEPOWER, HIGH PRESSURE, HEAT PUMP, HIGH POINT	NAVD NBS	NORTH AMERICAN VERTICAL DATUM NATIONAL BUREAU OF STANDARDS	R/W	RIGHT OF WAY	WT	WEIGHT		
CFS	CUBIC FEET PER SECOND	EL ELB	ELEVATION ELBOW	HR	HEATING RETURN, HOUR, HOSE RACK	NC	NORMALLY CLOSED	RW	RAW WATER	WWM	WELDED WIRE MESH	° 7	
CG	CHLORINE GAS	ELEV	ELEVATION	HS HSS	HIGH STRENGTH HOLLOW STRUCTURAL SECTION	NE	NORTHEAST			1		Bi	2
CGB CHBD	CORD GRIP BUSHING CHALKBOARD	ELEC	ELECTRICAL, ELECTRONIC	HTG	HEATING	NEC NEMA	NATIONAL ELECTRIC CODE  NATIONAL ELECTRICAL MANUFACTURES	s	SOUTH, SECOND, SLOPE	XMFR	TRANSFORMER	9	202
CHEM	CHEMICAL	EMB EMER	EMBEDMENT EMERICENCY	HTR	HEATER		ASSOCIATION	SA	SAMPLE, SAMPLE LINE	XMTR	TRANSMITTER	4	RCH H
CHG	CHANGE	ENCL	EMERGENCY ENCLOSURE	HV HVAC	HOSE VALVE	NF NFPA	NEAR FACE	SCFM	STANDARD CUBIC FEET PER MINUTE SCHEDULE	XS	EXTRA STRONG		ΨΨ
CHKD PL CI	CHECKERED PLATE CAST IRON	ENG	ENGINE		HEATING, VENTILATING AND AIR CONDITIONING		NATIONAL FIRE PROTECTION ASSOCIATION	SCH SD	STORM DRAIN	1			[ [
CIP	CAST IRON CAST IRON PIPE	ENGR FP	ENGINEER	HWL	HIGH WATER LEVEL	NIC	NOT IN CONTRACT	SECT	SECTION	YD	YARD		DATE
CISP	CAST IRON SOIL PIPE	EPDM	EDGE OF PAVEMENT ETHYL PROPYLENE DIENE MONOMER	HWO HYD	HANDWHEEL OPERATED HYDRANT, HYDRAULIC	NO NOM	NUMBER OR NORMALLY OPEN NOMINAL	SHT	SHEET	YP YR	YARD PIPING YEAR	DRAWING NO.	二
CJ CJP	CONSTRUCTION JOINT COMPLETE JOINT PENETRATION	EPS	EXPANDED POLYSTYRENE	1		NPT	NATIONAL PIPE THREAD	SIM SLP	SIMILAR SLOPE	"\	I LAIN		ļ
001	SOMI LETE CONTENT FENERICATION	EQ	EQUAL	1		NS	NEAR SIDE		<del></del>	1		<u>G-03</u>	_ I
				1		1				1		SHEET03 OF	78
		-	NGS\SHT\0102403 G.03 dwg Plotted: 3/27/2025 3:11 PM Rv: Jeremy Black	-		~		-		-			

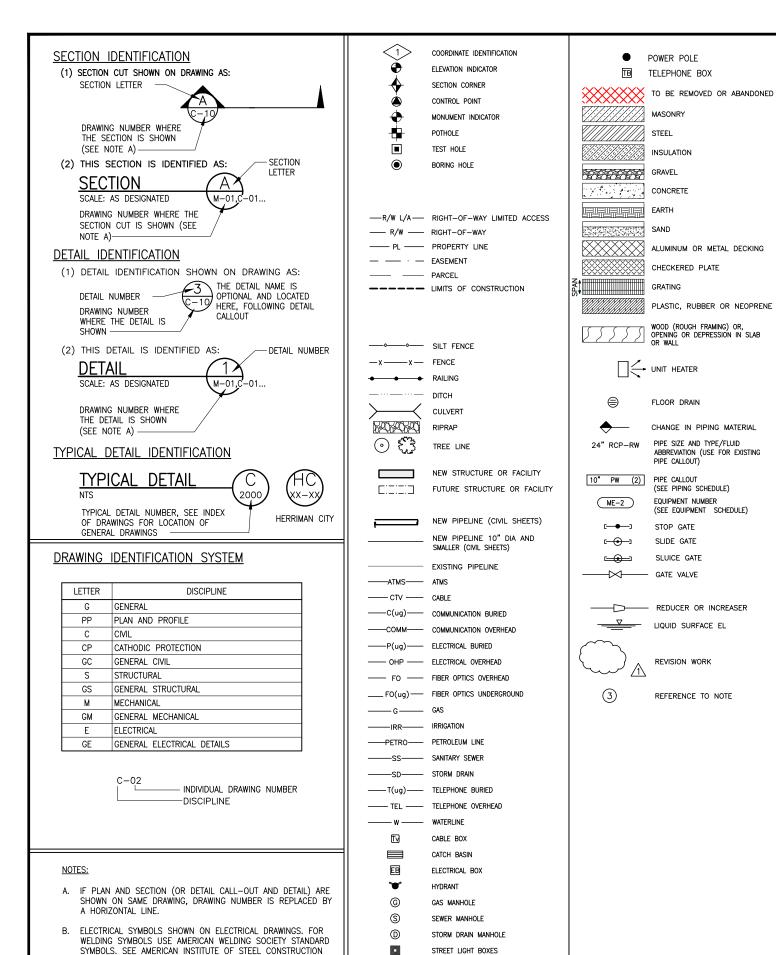

	DIP/PVC WATERLINE FITTING SCHEDULE
VALVES (SEE NOTE 2)	V8 (8" VALVE)  SIZE IN INCHES  FITTING DESIGNATION (VALVE)
COUPLINGS & PLUGS	COUPLING PLUG  C8 (8" COUPLING) P8 (8" PLUG)  SIZE IN INCHES  FITTING DESIGNATION (COUPLING)
REDUCERS	R86 (8" X 6" REDUCER)  SIZE IN INCHES (SMALL END)  SIZE IN INCHES (LARGE END)  FITTING DESIGNATION (REDUCER)
TEES, CROSSES & WYES	TEE CROSS WYE  SIZE IN INCHES (BRANCH)  SIZE IN INCHES (BRANCH)  SIZE IN INCHES  FITTING DESIGNATION (TEE, CROSS, WYE)  TEE CROSS WYE  (8" X 8" X (X86) (8" X 8" X (8" X 8" X (8" X 8" X (8" X 8" X
BENDS	B84 (8" 90° BEND)  TYPE OF BEND (SEE BEND LEGEND)  SIZE IN INCHES  SIZE IN INCHES  FITTING DESIGNATION (BEND)  * ALL BENDS SHALL BE 45° UNLESS OTHERWISE NOTED
NOTES	1. UNLESS NOTED OTHERWISE, FITTINGS WITH A CONNECTION TO ANOTHER FITTING OR VALVE SHALL HAVE FLANGED CONNECTIONS. ALL FITTINGS WITH A CONNECTION TO A STRAIGHT RUN OF PIPE SHALL HAVE MECHANICAL JOINTS. ALL FITTINGS TO BE CLASS 52 DUCTILE IRON.  2. ALL VALVES 12 INCHES AND SMALLER SHALL BE GATE VALVES, VALVES LARGER THAN 12 INCHES TO BE BUTTERFLY VALVES WITH VALVE BOX AND COVER. BUTTERFLY VALVES TO BE PER SPEC SECTION 40 05 64.  3. ALL FITTINGS AND APPURTENANCES SHALL BE EQUIPPED WITH THRUST BLOCKS PER THE SPECIFICATIONS AND STANDARD DRAWINGS. CONTRACTOR SHALL PROVIDE TEMPORARY THRUST RESTRAINT AS NECESSARY DURING CONSTRUCTION.  4. NOT ALL FITTINGS ARE SHOWN. CONTRACTOR SHALL INSTALL ALL FITTINGS REQUIRED TO FOLLOW THE ALIGNMENT SHOWN IN THE DRAWINGS, REGARDLESS OF WHETHER SUCH FITTINGS ARE CALLED OUT. WHERE POSSIBLE, THE CONTRACTOR MAY DEFLECT PIPE JOINTS AS ALLOWED BY THE PIPE MANUFACTURER, BUT NO MORE THAN 2 DEGREES, TO ACHIEVE THE DESIRED ALIGNMENT. WHERE THIS IS NOT POSSIBLE, THE CONTRACTOR SHALL INSTALL THE REQUIRED FITTINGS AT NO ADDITIONAL COST TO THE OWNER.

Ö CAPACITY UPGRADES JORDAN VALLEY WATER O ROSECREST PIPELINE HERRIMAN AND RIV SYMBOL DRAWING NO.

G-04

SHEET <u>04</u> OF <u>78</u>

LIORDAN VALLEY WCD010-24-03 ROSECREST PIPEL INF CAPACITY LIPGRADESI2 0 DESIGN PHASEV 9 DRAWINGSISHT0012403 G-04 dwn Plotted: 3/27/2025 3:11 PM By ..leremy Black

1

**(N)** 

TELEPHONE MANHOLE

WATER MANHOLE


WATER METER

# GENERAL NOTES

- SYMBOLS FOR STRUCTURES, PIPE, ETC. USED FOR IDENTIFICATION ARE SHOWN IN LEGENDS AND SHALL BE FOLLOWED THROUGHOUT THE PLANS WHENEVER APPLICABLE, NOT ALL OF THE VARIOUS COMPONENTS SHOWN IN THESE LEGENDS ARE NECESSARILY USED IN THE PROJECT.
- SCALE OF THE DRAWINGS OR DETAILS ARE SHOWN IN TITLE BLOCK OR DIRECTLY UNDER THE PLAN OR DETAIL. THE SIZE OF THE ORIGINAL PLOTTED DRAWINGS IS 22"X34". CARE SHOULD BE TAKEN TO VERIFY THE SCALE BAR IN THE TITLE BLOCK AREA TO DETERMINE THE SCALE OF REDUCED
- IT SHALL BE THE CONTRACTORS RESPONSIBILITY TO PERFORM CONSTRUCTION ACTIVITIES PER THE CONTRACT DOCUMENTS AND IN A WORKMANLIKE SAFE MANNER IN ACCORDANCE WITH ALL STATE AND LOCAL CODES AND JOB-SITE RELATED CONSTRUCTION CONDITIONS AND REQUIREMENTS. ANY ADDITIONS, DELETIONS, OR MODIFICATIONS SHALL FIRST MEET WITH THE WRITTEN APPROVAL OF THE ENGINEER AND THE OWNER.
- CONTRACTOR SHALL OBTAIN ALL NECESSARY AND REQUIRED PERMIT(S), INSPECTIONS AND APPROVALS, AND COMPLY WITH ALL REQUIREMENTS OF
- THE CONTRACTOR SHALL PREPARE AND SUBMIT TRAFFIC CONTROL PLANS FOR REVIEW AND APPROVAL BY HERRIMAN CITY AND RIVERTON CITY. WORK WILL NOT BEGIN UNTIL THE PLANS HAVE BEEN APPROVED.
- 6. THE CONTRACTOR SHALL KEEP ALL CONSTRUCTION ACTIVITIES WITHIN THE ESTABLISHED RIGHTS-OF-WAY, EASEMENTS AND DESIGNATED STAGING AREAS. THIS SHALL INCLUDE BUT NOT BE LIMITED TO, VEHICLES AND EQUIPMENT, LIMITS OF TRENCH EXCAVATION, AND EXCAVATED MATERIAL AND BACKFILL STORAGE. IF THE CONTRACTOR REQUIRES ADDITIONAL CONSTRUCTION EASEMENTS, IT SHALL BE SOLELY THE CONTRACTOR'S RESPONSIBILITY TO OBTAIN SUCH EASEMENTS FROM INDIVIDUAL PROPERTY OWNERS.
- 7. UTILITY LOCATIONS:
  - CONTRACTOR SHALL CONTACT BLUE STAKES TO LOCATE EXISTING UTILITIES.
- ALL UTILITY LOCATIONS, SHOWN ON DRAWINGS, ARE APPROXIMATE AND ARE NOT INCLUSIVE OF ALL EXISTING UTILITIES.
- CONTRACTOR TO VERIFY DEPTHS OF UTILITIES IN THE FIELD BY POT HOLING A MINIMUM OF TWO WEEKS TIME OR 200—FEET AHEAD OF PIPELINE CONSTRUCTION TO AVOID CONFLICTS WITH DESIGNED PIPELINE GRADE AND ALIGNMENT. IF A CONFLICT ARISES RESULTING FROM THE CONTRACTOR NEGLECTING TO POT HOLE UTILITIES, THE CONTRACTOR TO RESOLVE THE CONFLICT WITHOUT ADDITIONAL COST OR CLAIM TO THE
- CONTRACTOR SHALL POT HOLE CRITICAL LOCATIONS AND OBTAIN ALL EXISTING PIPE O.D. PRIOR TO ORDERING OR OBTAINING MATERIALS REQUIRED FOR CONNECTIONS TO EXISTING PIPING. UTILITY SHUT-DOWNS AND OTHER WORK WILL NOT BE SCHEDULED OR ALLOWED UNTIL THIS IS ACCOMPLISHED AND MATERIALS ARE ON SITE AND APPROVED FOR USE BY
- 8. THE CONTRACTOR SHALL TAKE ALL PRECAUTIONARY MEASURES NECESSARY TO PROTECT EXISTING IMPROVEMENTS FROM DAMAGE WHICH ARE TO REMAIN IN PLACE. ALL SUCH IMPROVEMENTS OR STRUCTURES DAMAGED BY THE CONTRACTORS OPERATIONS SHALL BE REPAIRED OR RECONSTRUCTED TO ORIGINAL OR BETTER CONDITION TO THE SATISFACTION OF THE OWNER AT THE EXPENSE OF THE CONTRACTOR.
- 9. UTILITY SERVICE LATERALS ARE NOT SHOWN ON THESE PLANS, CONTRACTOR SHALL ANTICIPATE THAT THERE ARE NO LESS SERVICE LATERALS THAN THERE ARE HOMES WHERE PROJECT TRENCHES ARE LOCATED IN OR WITHIN 100 FEET OF A STREET BETWEEN A HOME AND THE UTILITY MAIN. IT IS THE CONTRACTOR'S RESPONSIBILITY TO PROTECT IN PLACE, OR REMOVE AND REPLACE TO THE SATISFACTION OF THE UTILITY OWNER, ALL UTILITY SERVICE LATERALS ENCOUNTERED DURING CONSTRUCTION. DURATION OF UTILITY OUTAGES AND PUBLIC NOTIFICATION PROCEDURES SHALL CONFORM TO THE STANDARDS OF THE CONTROLLING AGENCY.
- 10. CONTRACTOR IS SOLELY RESPONSIBLE FOR CONFORMANCE WITH LOCAL AND FEDERAL CODES GOVERNING SHORING AND BRACING OF EXCAVATIONS AND TRENCHES. CONTRACTOR IS RESPONSIBLE FOR THE SAFETY OF THE PUBLIC AND PROTECTION OF PERSONNEL AND WORKERS.
- 11. IF THE CONTRACTOR CHO SES TO WORK ON THE PROJECT WHEN HOT MIX ASPHALT IS NOT AVAILABLE. E CONTRACTOR SHALL OBTAIN APPROVAL FROM THE GOVERNING AGENCY PRIOR TO CONSTRUCTION. THE CONTRACTOR SHALL FURNISH AND INSTALL TEMPORARY ASPHALT SURFACING MATERIAL. WHEN PERMANENT ASPHALT BECOMES AVAILABLE. THE CONTRACTOR SHALL REMOVE THE TEMPORARY ASPHALT, FURNISH AND INSTALL THE PERMANENT ASPHALT AT NO ADDITIONAL COST TO THE OWNER.
- 12. CONTRACTOR SHALL NOT DESTROY, REMOVE, OR DISTURB ANY EXISTING SURVEY MONUMENTS WITHOUT AUTHORIZATION OF CONTROLLING AGENCY. NO PAVEMENT CUTTING OR REMOVAL SHALL BEGIN UNTIL ALL SURVEY MARKERS OR MONUMENT POINTS THAT HAVE THE POTENTIAL OF BEING DISTURBED BY THE CONSTRUCTION OPERATIONS HAVE BEEN PROPERLY REFERENCED BY A REGISTERED LAND SURVEYOR. ALL SURVEY MONUMENTS OR POINTS DISTURBED BY THE CONTRACTOR SHALL BE ACCURATELY RESET BY A REGISTERED LAND SURVEYOR AFTER ALL RESTORATION AND RESURFACING HAS BEEN COMPLETED.


- 13. TRENCHING OPERATIONS SHALL BE PERFORMED SO AS TO PROTECT THE EXISTING CURB AND GUTTER, UNLESS IDENTIFIED FOR REMOVAL. DAMAGED CURB AND GUTTER SHALL BE REPLACED TO MATCH THE EXISTING AT THE CONTRACTOR'S EXPENSE, REPLACE PER APWA STANDARDS FOR RIVERTON CITY AND HERRIMAN CITY. TRENCH SUPPORTS AND DEWATERING SHALL ALSO BE THE RESPONSIBILITY OF THE CONTRACTOR, MAXIMUM OPEN TRENCH DURING WORKING HOURS SHALL BE 300 FEET. ALL TRENCHES SHALL BE BACKFILLED AND/OR PLATED DURING NON-WORKING HOURS, PER EXCAVATION PERMIT
- 14. DEWATERING: GROUND WATER AND SURFACE WATER CONTROL SHALL BE PERFORMED AND RESPONSIBLY HANDLED BY THE CONTRACTOR ACCORDING TO, AND IN COMPLIANCE WITH, ALL LOCAL GOVERNING AUTHORITIES, IT IS THE CONTRACTOR'S SOLE RESPONSIBILITY TO DETERMINE POTENTIAL PLIMPING NEEDS. THE CONTRACTOR SHALL NOT RELY ON OWNER SUPPLIED PROCTOR. GROUND WATER AND/OR SURFACE WATER DATA. CONTRACTOR SHALL OBTAIN
- 15 AFRIAL PHOTOS IN DRAWINGS: THE AERIAL PHOTOS PROVIDED AS BACKGROUND IN THESE DRAWINGS ARE PROVIDED TO HELP CLARIFY THE WORK SITE. HOWEVER, THE PHOTOS DEPICT CONDITIONS AS THEY EXISTED IN SEPTEMBER OF 2024 PRESENT DAY CONDITIONS MAY VARY FROM THOSE SHOWN. CONTRACTOR SHALL VERIFY EXISTING CONDITIONS PRIOR TO BIDDING. BID SHALL INCLUDE ALL WORK REQUIRED TO COMPLETE THE PROJECT.
- 16. CONTRACTOR SHALL BE RESPONSIBLE FOR CORRECTING ANY SETTLEMENT OF EXCAVATIONS, AND ANY DAMAGE OF UTILITIES RESULTING FROM SETTLEMENT.
- 17. CONTRACTOR SHALL PREVENT ANY GROUND WATER OR DEBRIS FROM ENTERING NEW PIPES DURING CONSTRUCTION. THE ENDS OF THE PIPES SHALL BE SEALED AT THE END OF EACH WORKDAY
- 18. PROFILE DRAWINGS ARE HORIZONTAL PROJECTIONS OF THE PIPELINE CENTERLINE, UNLESS OTHERWISE NOTED. PLAN AND PROFILE SHEETS SHOW REPRESENTED HORIZONTAL, VERTICAL AND COMBINATION CURVES, TO BE MET THE FABRICATOR, SUBMIT SHOP DRAWINGS FOR REVIEW
- 19 LAY PIPE TO DEPTH AND ALONG HORIZONTAL ALIGNMENT AS DEFINED IN THESE DRAWINGS. CONTRACTOR SHALL NOT DEVIATE FROM PROPOSED ALIGNMENT OR GRADE WITHOUT THE WRITTEN APPROVAL OF THE ENGINEER. AVOID HIGH AND LOW POINTS EXCEPT WHERE DESIGNED.
- 20. CONTRACTOR SHALL BACKFILL TRENCH AREAS WHERE NEW WATERLINES CROSS UNDER EXISTING BURIED UTILITIES WITH FLOWABLE FILL (SOIL CEMENT BACKFILL, CLSM), WHERE MECHANICAL COMPACTION CANNOT BE ADEQUATELY
- 21. ALL BURIED REBAR, FITTINGS, COUPLINGS, VALVES AND MECHANICAL JOINT NUTS AND BOLTS ARE TO BE COATED WITH WAX TAPE COATING SYSTEM, PER
- 22. CONTRACTOR SHALL MAINTAIN A 10-FOOT HORIZONTAL AND AN 18-INCH VERTICAL SEPARATION (OUTSIDE OF PIPE TO OUTSIDE OF PIPE/MANHOLE) BETWEEN ALL SEWER AND WATER LINES, UNLESS EXCEPTION IS NOTED
- 23. CONTRACTOR SHALL RESTORE OR REPLACE ANY SPRINKLING SYSTEMS AND LANDSCAPING DAMAGED DURING CONSTRUCTION TO EQUAL OR BETTER CONDITION THAN WHAT EXISTED PRIOR TO CONSTRUCTION UNLESS OTHERWISE NOTED, AT NO ADDITIONAL COST TO THE OWNER.
- 24 CONTRACTOR SHALL PROTECT ADJACENT PRESSURE PIPELINES AND PROVIDE TEMPORARY THRUST RESTRAINT AS NECESSARY DURING CONSTRUCTION INCLUDING EXISTING VALVES, TEES, BENDS, ETC. ALL NEW PRESSURE PIPE AND FITTINGS SHALL HAVE THRUST RESTRAINED JOINTS, THRUST BLOCKS, THRUST TIES OR OTHER APPROVED THRUST RESTRAINT. THRUST PROTECTION SHALL BE ADEQUATE FOR THE TEST PRESSURE SPECIFIED.
- 25. MINIMUM DEPTH OF ROSECREST PIPELINE: 4 FEET TO TOP OF PIPE
- 26. COORDINATE ANY RELOCATIONS OF EXISTING WATER MAINS WITH OWNER (JVWCD, RIVERTON CITY AND/OR HERRIMAN CITY).
  - OPERATION OF ALL EXISTING MAIN LINE VALVES TO BE COORDINATED THROUGH OWNER 48-HOURS IN ADVANCE OF SHUTDOWN. CONNECTIONS TO SOME WATERLINES SERVING MAY REQUIRE NIGHT OR WEEKEND SHUTDOWNS. CONTRACTOR TO PERFORM NIGHT OR WEEKEND WORK IN THESE AREAS AT NO ADDITIONAL COST TO OWNER.
  - OWNER DOES NOT GUARANTEE WATER SHUT-DOWNS. CONTRACTOR TO DEVISE PLANS TO AVOID WORK STOPPAGES IN THE EVENT A SHUT-DOWN DOES NOT GO AS PLANNED
  - CONTRACTOR SHALL SUBMIT FOR REVIEW A SEQUENTIAL PLAN FOR CONNECTION. TESTING, AND FLUSHING OF ALL NEW WATER MAINS, HYDRANTS, AND SERVICE CONNECTIONS.
- 28. CONTRACTOR SHALL PERFORM CHLORINATION TEST, PRESSURE TEST. AND BACTERIA TEST. ALL WATERLINES INSTALLED SHALL BE DISINFECTED IN ACCORDANCE WITH THE "AMERICAN WATER WORKS ASSOCIATION STANDARD FOR DISINFECTING WATER MAINS" (AWWA C651) AND SPECIFICATIONS. ALL CHLORINATED WATER SHALL BE DISPOSED OF IN ACCORDANCE WITH THE UTAH DEPT OF ENVIRONMENTAL QUALITY RULES AND REQUIREMENTS FOR SURFACE DISCHARGE AND PROJECT SPECIFICATIONS.

- 29. PRESSURE TEST TO HYDROSTATIC TEST HGL AS SHOWN ON DRAWING #### FOR FOUR HOURS WITH ZERO LEAKAGE. IN THE CASE OF FAIL TO PASS THE LEAKAGE TEST. THE CONTRACTOR SHALL DETERMINE THE CAUSE OF THE LEAKAGE, SHALL TAKE CORRECTIVE MEASURES NECESSARY TO REPAIR THE LEAKS, AND SHALL AGAIN TEST THE PIPELINES, ALL AT NO COST TO THE
- 30. WORKING PRESSURE FOR THIS PORTION OF THE SOUTHW SUPPLY QUEDUCT PIPELINE SHOWN ON THE HYDRAULIC PROFILE ON DRAWIN ##, ALL FLANGES, VALVES, FITTINGS, THRUST BLOCKS, ETC. SHALL BE RATED
- 31. ALL MATERIALS WHICH MAY CONTACT DRINKING WATER INCLUDING PIPES, GASKETS, FITTINGS, LUBRICANTS, LININGS, FIELD JOINT REPAIR MATERIALS, O-RINGS, AND VALVES SHALL BE NSF 61 COMPLIANT FOR CULINARY WATER USE. TO PERMIT FIELD VERIFICATION OF THIS CERTIFICATION, ALL SUCH COMPONENTS SHALL BE APPROPRIATELY STAMPED WITH THE NSF LOGO.
- 32. CONTRACTOR TO PROVIDE AND DISTRIBUTE APPROVED WRITTEN NOTICE OF CONSTRUCTION ACTIVITIES TO ALL RESIDENTS AND BUSINESSES LOCATED IN THE CONSTRUCTION AREA AT LEAST OURS PRIOR TO CONSTRUCTION. WRITTEN NOTICE SHALL BE APPROVE THE ENGINEER PRIOR TO
- 33. CONTRACTOR SHALL PROVIDE AND UPDATE A CONSTRUCTION SCHEDULE FOR WORKING IN THE PUBLIC RIGHT-OF-WAY PRIOR TO CONSTRUCTION
- 34. CONTRACTOR SHALL BE RESPONSIBLE FOR MAINTAINING CONTROL OF DRAINAGE AND EROSION DURING CONSTRUCTION AT CONSTRUCTION SITE, STAGING, AND SPOILS AREA. CONTRACTOR SHALL SUBMIT STORM RUNOFF CONTROL PLAN FOR APPROVAL BY ENGINEER AND OBTAIN A SWPPP PERMIT FROM THE UTAH
- 35. ALL ASBESTOS CEMENT PIPES REQUIRING REMOVAL SHALL BE DISPOSED OF IN ACCORDANCE WITH ALL FEDERAL, STATE, AND LOCAL REQUIREMENTS IN AN APPROVED LOCATION EQUIPPED TO HANDLE SUCH MATERIALS. ANY CUTTING REQUIRED SHALL BE PERFORMED IN ACCORDANCE WITH PROPER REGULATORY PROCEDURES. IN NO CASE SHALL THE PIPE AND FITTINGS BE BROKEN OR
- 36. CONTRACTOR SHALL SAW CUT ASPHALT, CURB AND GUTTER AND SIDEWALK TO THE NEAREST JOINT AT THE LIMITS OF ALL TRENCH EXCAVATION, WHERE
- 37. CONTRACTOR SHALL COORDINATE WITH DRIVEWAY OWNERS FOR ACCESS DURING WORKING HOURS. ALL TRENCHES SHALL BE BACKFILLED AND/OR PLATED DURING NON-WORKING HOURS.
- 38. WORKING HOURS IN RIVERTON CITY AND HERRIMAN CITY SHALL BE 8:00 AM TO 7:00 PM. IF ANY WORK IS DEEMED NECESSARY OUTSIDE OF THESE HOURS, COORDINATE WITH ENGINEER, OWNER, AND RIVERTON CITY OR HERRIMAN CITY AS PERTINENT.
- 39. INSTALL ALL MATERIALS ACCORDING TO MANUFACTURER RECOMMENDATIONS AND STATE AND LOCAL REQUIREMENTS. USE ONLY NEW AND UNUSED MATERIALS. ALL MATERIALS SHALL BE PROVIDED BY MANUFACTURERS REGULARLY ENGAGED IN PRODUCING SAID ITEMS, AND WHICH SHALL BE FIRST QUALITY, HEAVY DUTY, COMMERCIAL/INDUSTRIAL GRADE, SUITABLE FOR THE
- 40. ANY WORK RELATED TO NATURAL GAS LINES (RELOCATION, ABANDONMENT, FTC.) SHALL BE COORDINATED DIRECTLY WITH ENBRIDGE GAS. FORMERLY DOMÍNION ENERGY.
- 41. THE CONSTRUCTION AREA CONTAINS TREES THAT MAY BE AFFECTED BY CONSTRUCTION ACTIVITIES DUE TO BRANCHES OR ROOTS EXTENDING INTO THE CONSTRUCTION AREA. CONTRACTOR TO PRESERVE AND PROTECT TREES UNLESS IDENTIFIED TO BE REMOVED. CONTRACTOR TO COORDINATE WITH CITY FOR ANY TREE WORK PRIOR TO CONSTRUCTION.

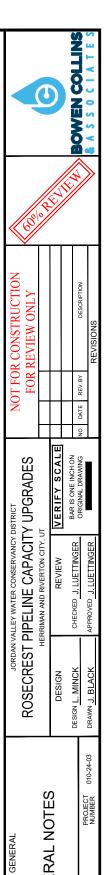

GENERAL

DRAWING NO. G-05 SHEET <u>05</u> OF 78

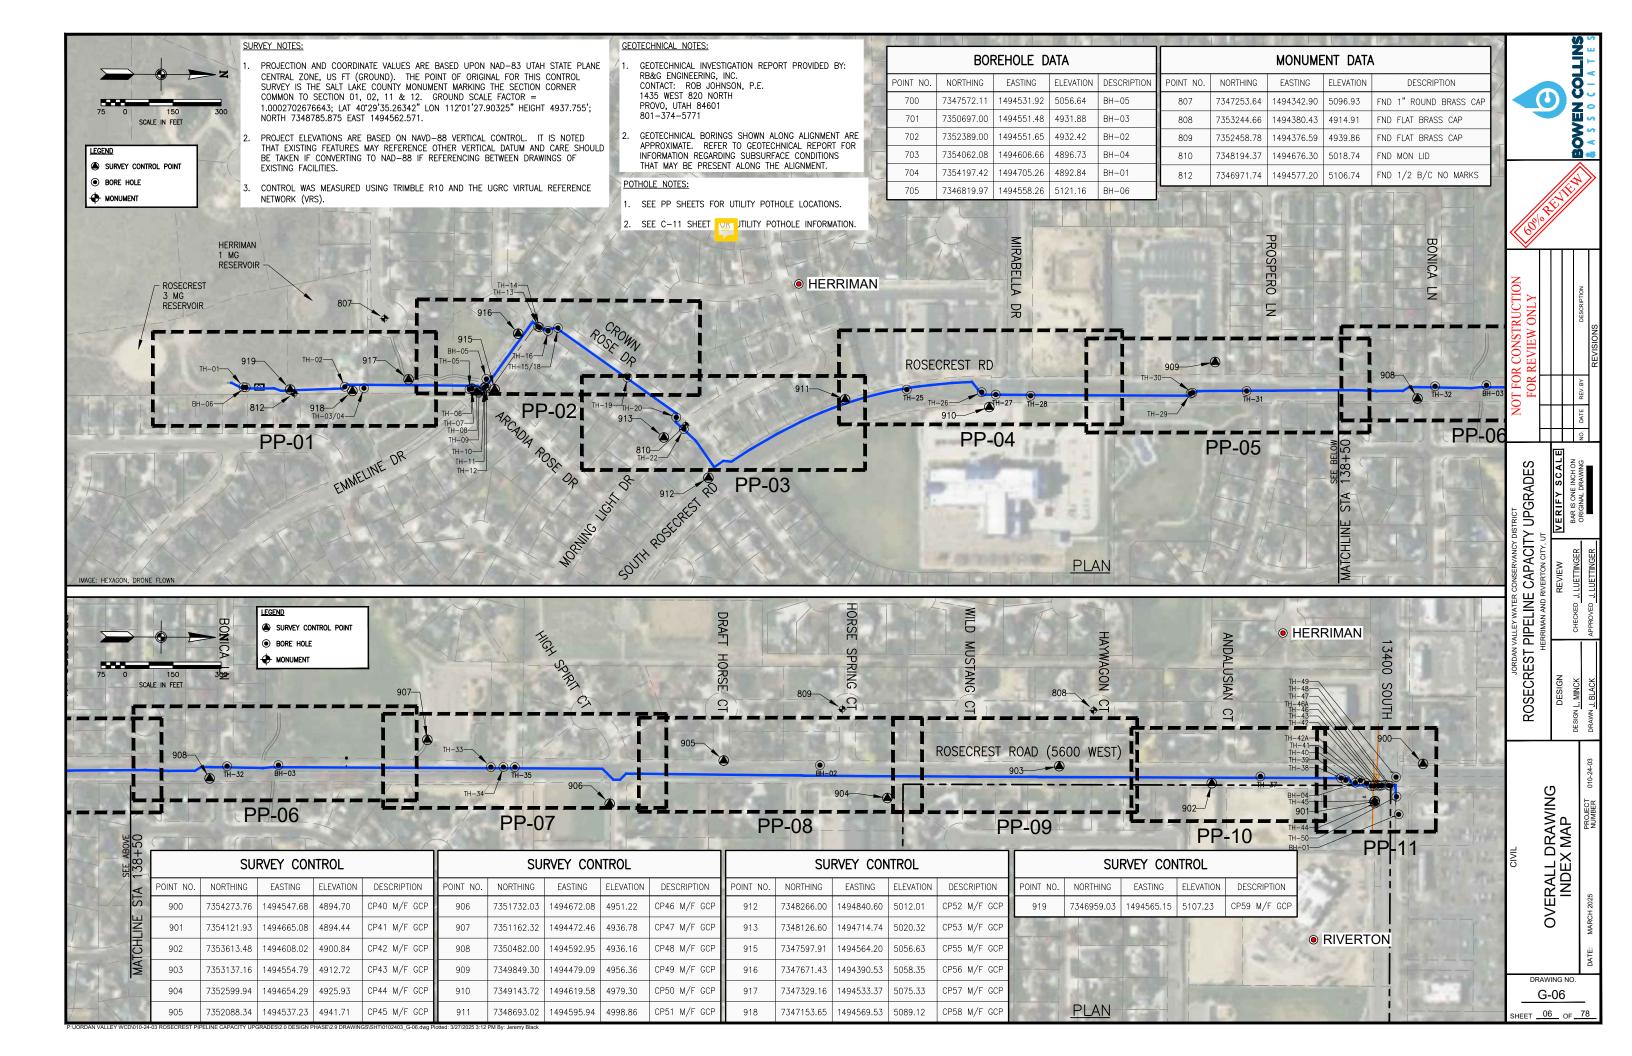

# ROSECREST PIPELINE CAPACITY UPGRADES OVERALL LINE PROFILE AND HYDROSTATIC TEST DATA

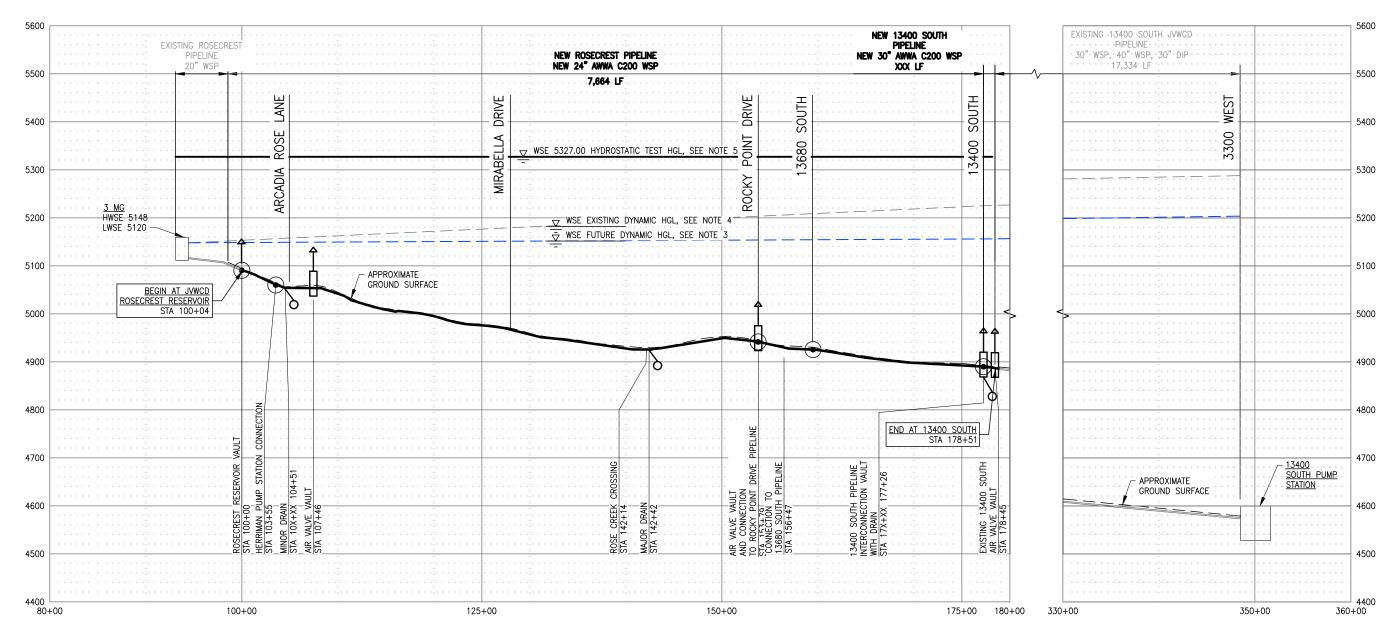


TABLE 1 HYDRAUL	IC CAPACITY
2024 PEAK DAY DEMAND	10.5 mgd (16.2 cfs)
BUILDOUT PEAK DAY DEMAND	13.9 mgd (21.5 cfs)
PRESSURE AT 13400 SOUTH PUMP STATION PRE-CONSTRUCTION	303.0 psi
PRESSURE AT 13400 SOUTH PUMP STATION AFTER CONSTRUCTION (BOTH PIPELINES OPERATING)	272.4 psi

LEGEND:		
CONNECTION	lacktriangle	EXISTING DYNAMIC HGL — — —
AIR VALVE	Ť	FUTURE DYNAMIC HGL
BLOW-OFF	P	WORKING HGL
VAULT		HYDROSTATIC TEST HGL
MAINLINE VALVE	$\bowtie$	MAX SURGE HGL — — — —

CONNECTION LOCATION	NEW ROSECREST PIPELINE APPROX	AGENCY RECEIVING WATER	DEMANDS A	D PEAK DAY T CONNECTIONS NOTE 2)	FUTURE DYNAMIC HGL
	STATION		(mgd)	(cfs)	(ft)
HERRIMAN TANK TURNOUT	STA 103+55	HERRIMAN CITY	8.2	12.7	5148.9
ROCKY POINT DRIVE TURNOUT (CONNECTION TO HERRIMAN 10" WATERLINE)	STA 153+80	JVWCD RETAIL	0.2	0.3	5153.8
13680 SOUTH TURNOUT (CONNECTION TO HERRIMAN 12" WATERLINE)	STA 159+50	JVWCD RETAIL	0.2	0.3	5154.4
RIVERTON COMMERCIAL CONNECTION - 13400 SOUTH	STA 177+25 INTERCONNECT VAULT	RIVERTON CITY	0.1	0.2	5156.1
HERRIMAN COMMERCIAL CONNECTION - 13400 SOUTH	STA 177+25 INTERCONNECT VAULT	HERRIMAN CITY	5.1	7.9	5156.1

TABLE 3 PROJECT TEST P	RESSURES	
LOCATION	WORKING	TEST
13400 S INTERCONNECT VAULT	130	150
13680 S CONNECTION	110	150
ROCKY POINT DR MAINLINE VALVE VAULT	100	150
ROSE CREEK DRAIN	105	150
EMMELINE DR	50	100
HERRIMAN PUMP STATION TURNOUT	30	100
ROSECREST RESERVOIR VAULT	15	100

# NOTES:

- 1. ELEVATIONS REFERENCED TO NAVD 88 VERTICAL DATUM.
- 2. EXPECTED DEMANDS WERE OBTAINED FROM THE DISTRICT'S 2060 HYDRAULIC MODEL OR FROM EXISTING DEMANDS (WHICHEVER WAS GREATER).
- 3. FUTURE DYNAMIC HGL REPRESENTS BOTH ROSECREST PIPELINES IN OPERATION.
- 4. EXISTING DYNAMIC HGL REPRESENTS CONDITIONS PRIOR TO CONSTRUCTION OF THE NEW 24" ROSECREST PIPELINE (16"/20" ROSECREST PIPELINE ONLINE ONLY).
- 5. HYDROSTATIC TESTING IS FOR NEW PIPELINE AND APPURTENANCES ONLY.


//×		
/	//	


ES		N(	OT FO FOR	NOT FOR CONSTRUCTION FOR REVIEW ONLY	$\sim$
CALE					
200					
	ON.	DATE	REV. BY	DESCRIPTION	


JORDAN VALLEY WATER CONSERVANCY DISTRICT
ROSECREST PIPELINE CAPACITY UPGRADI
HERRIMAN AND RIVERTON CITY 11T


OVERALL ROSECREST HYDRAULIC PROFILE AND DESIGN CRITERIA


DRAWING NO. G-07 SHEET 07 OF 78

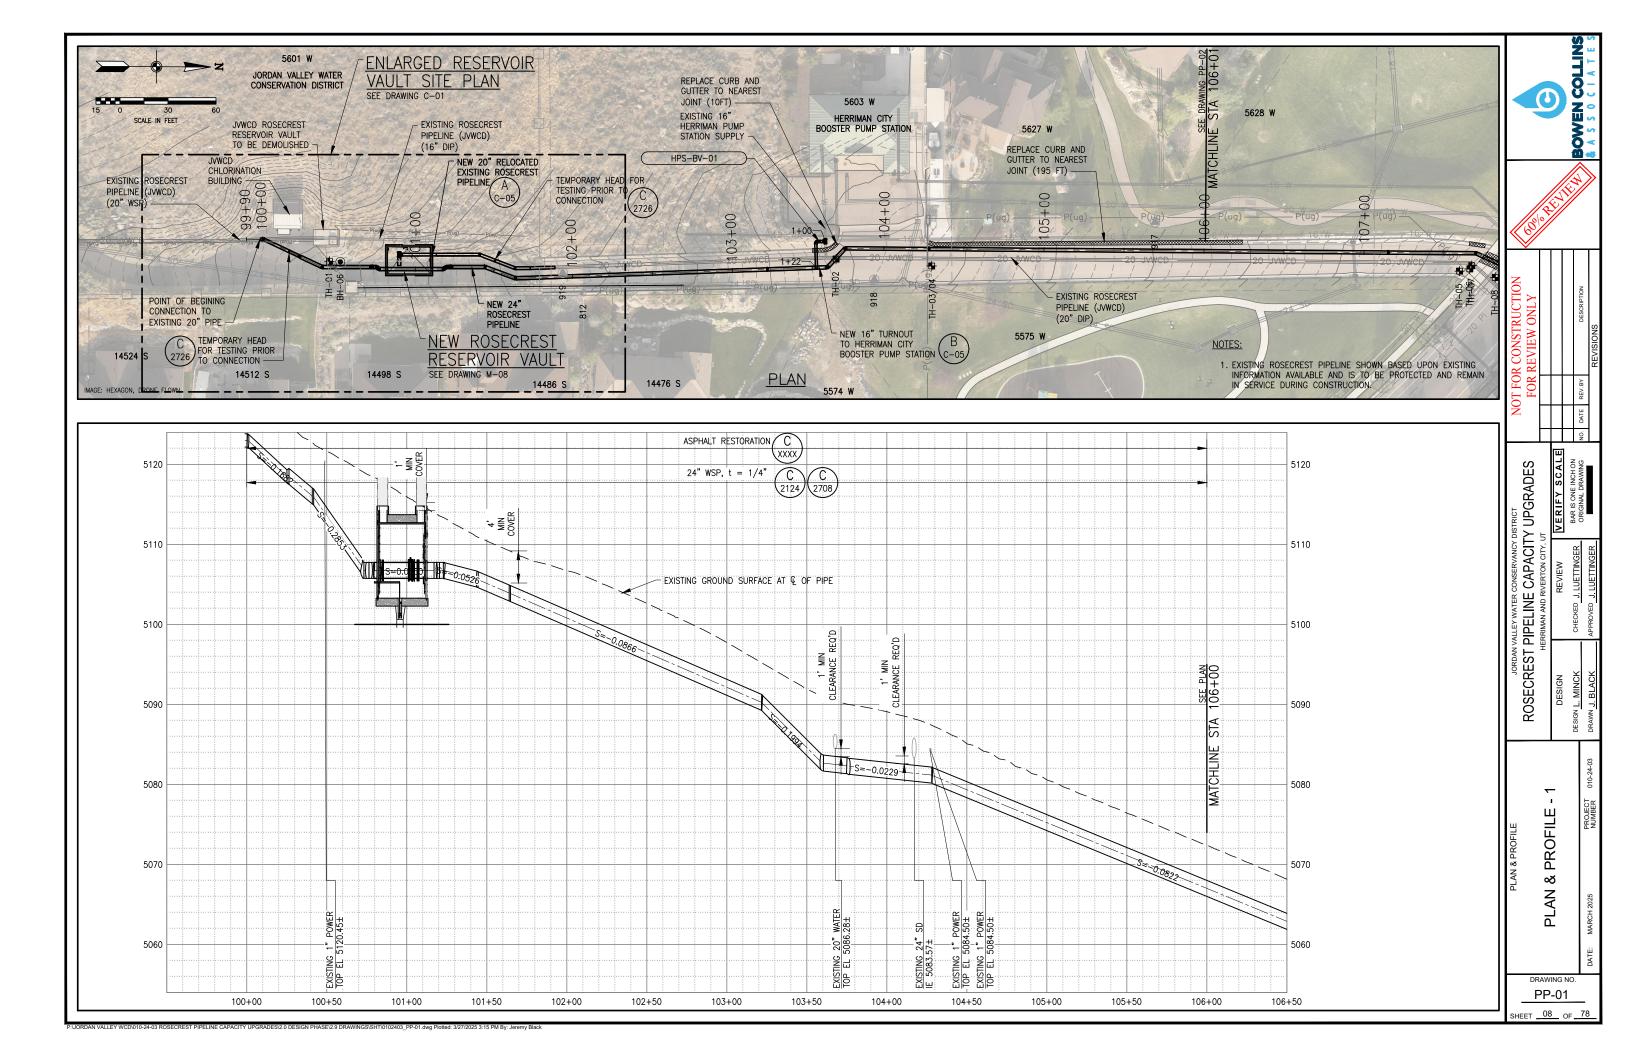

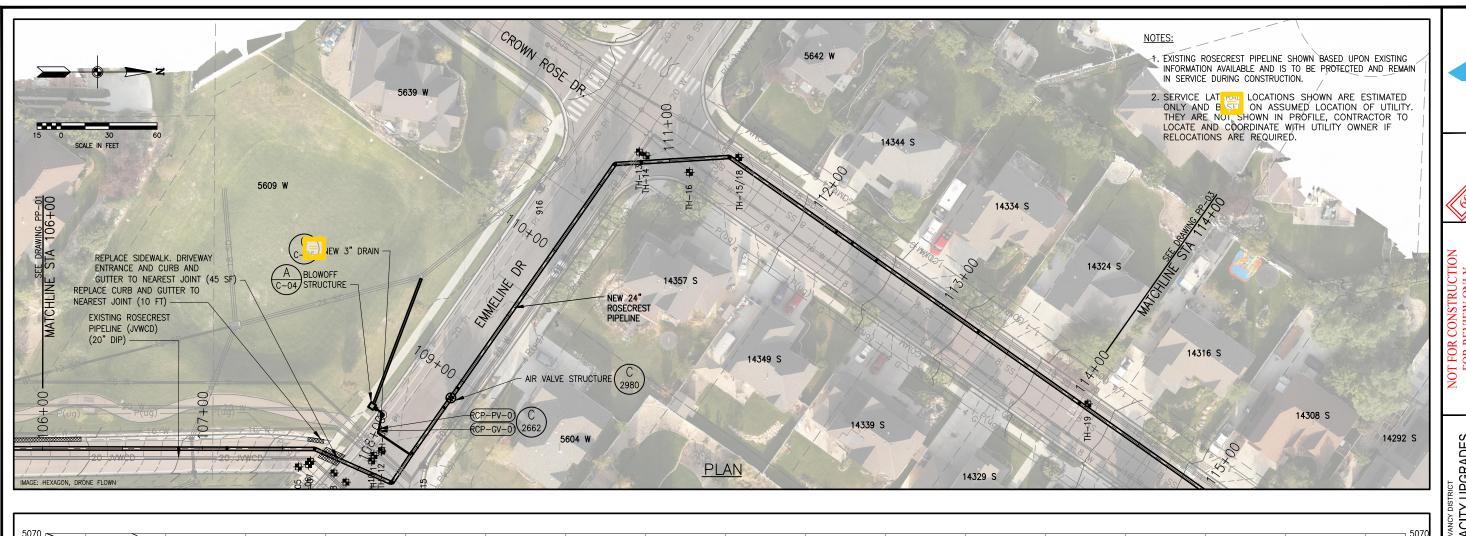

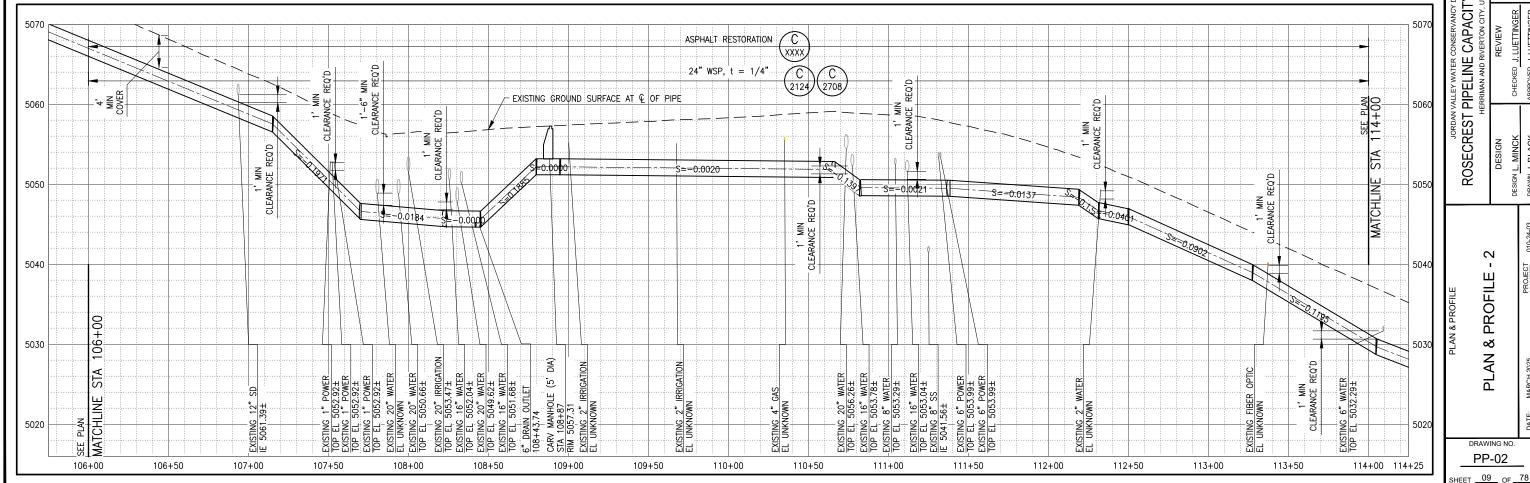

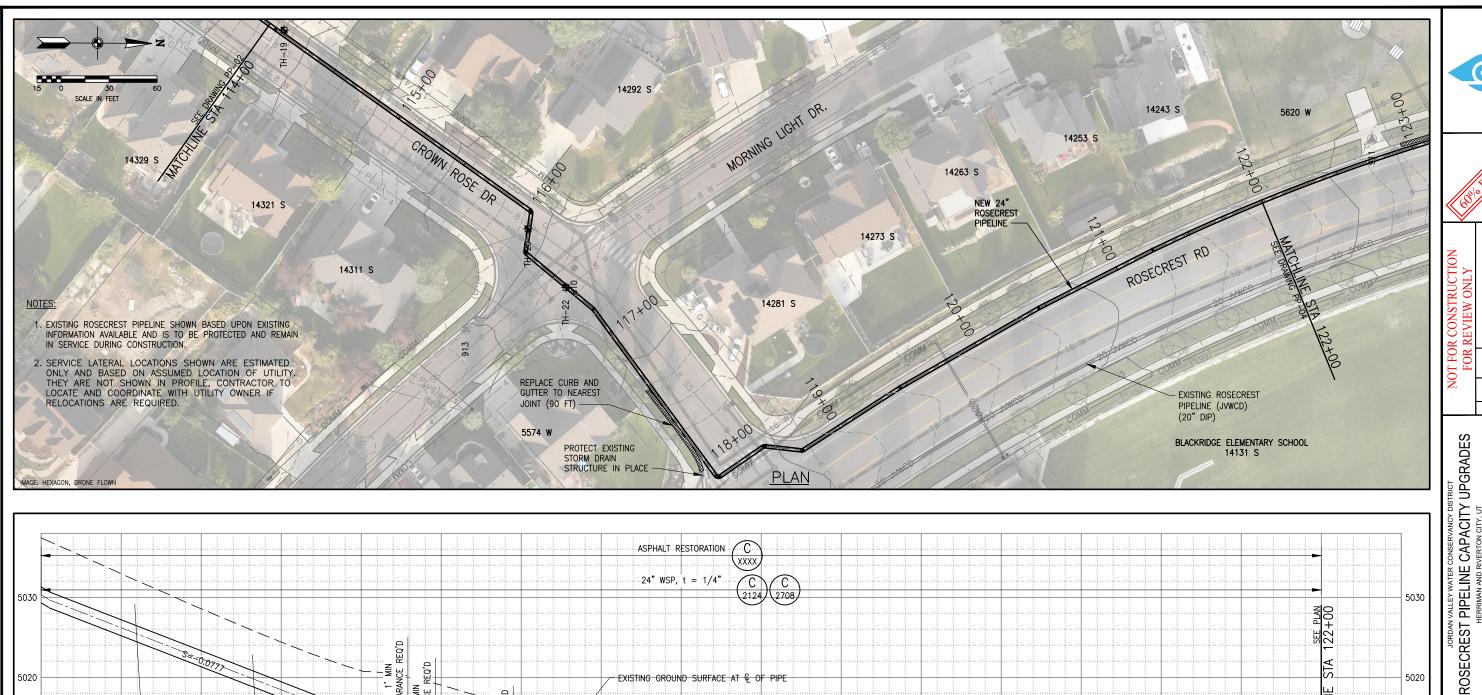

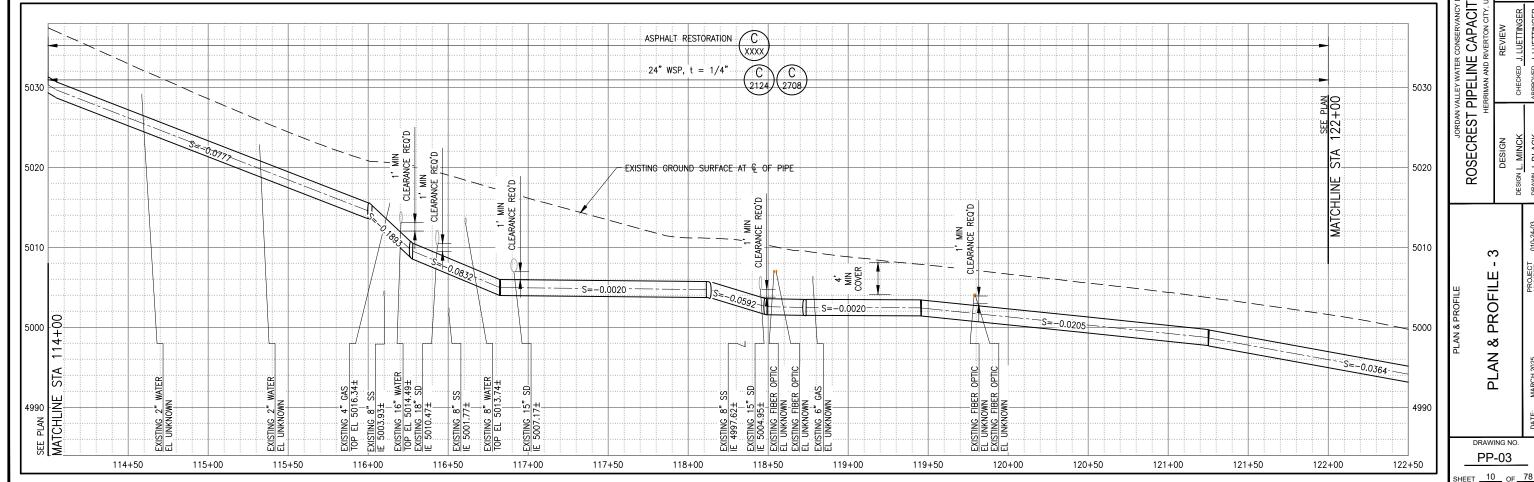


 $^{\circ}$ 


PROFILE

જ

PLAN


PP-03

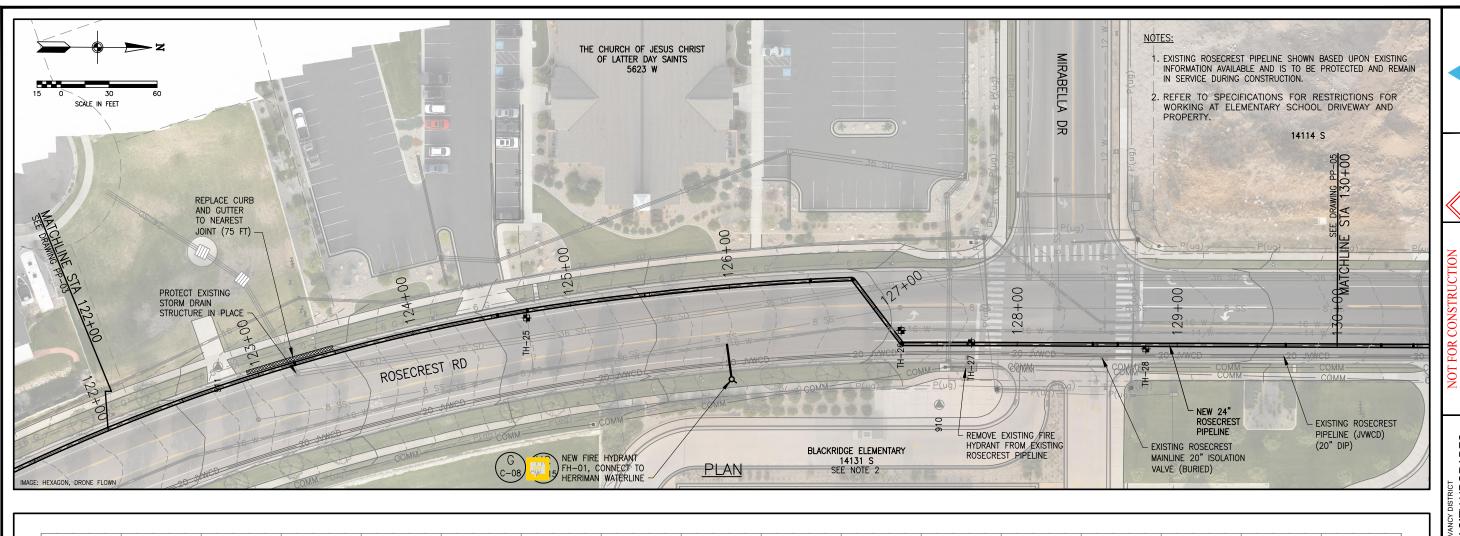

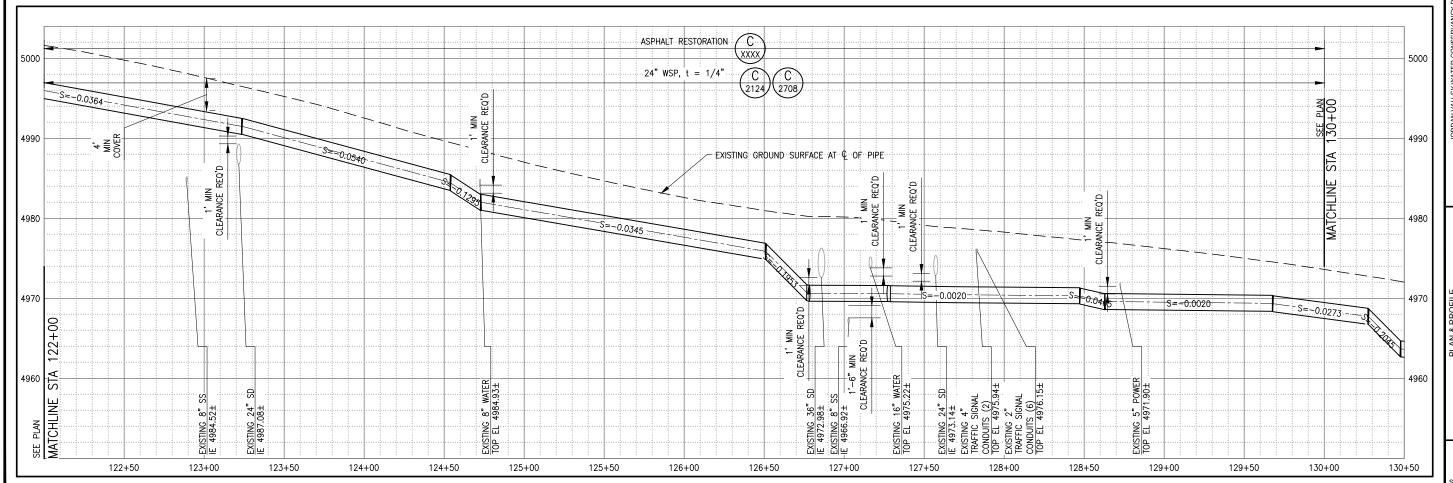

. O COSECREST PIPELINE CAPACITY UPGRADES
HERRIMAN AND RIVERTON OFF. 17 PROFILE જ PLAN PP-04 SHEET 11 OF 78

PAJORDAN VALLEY WCD1010-24-03 ROSECREST PIPELINE CAPACITY LIPGRADESIZ 0 DESIGN PHASE/2 9 DRAWINGSISHT01102403 PP-04 dwg Plottert 3/27/2025 3:19 PM By Jeremy Black

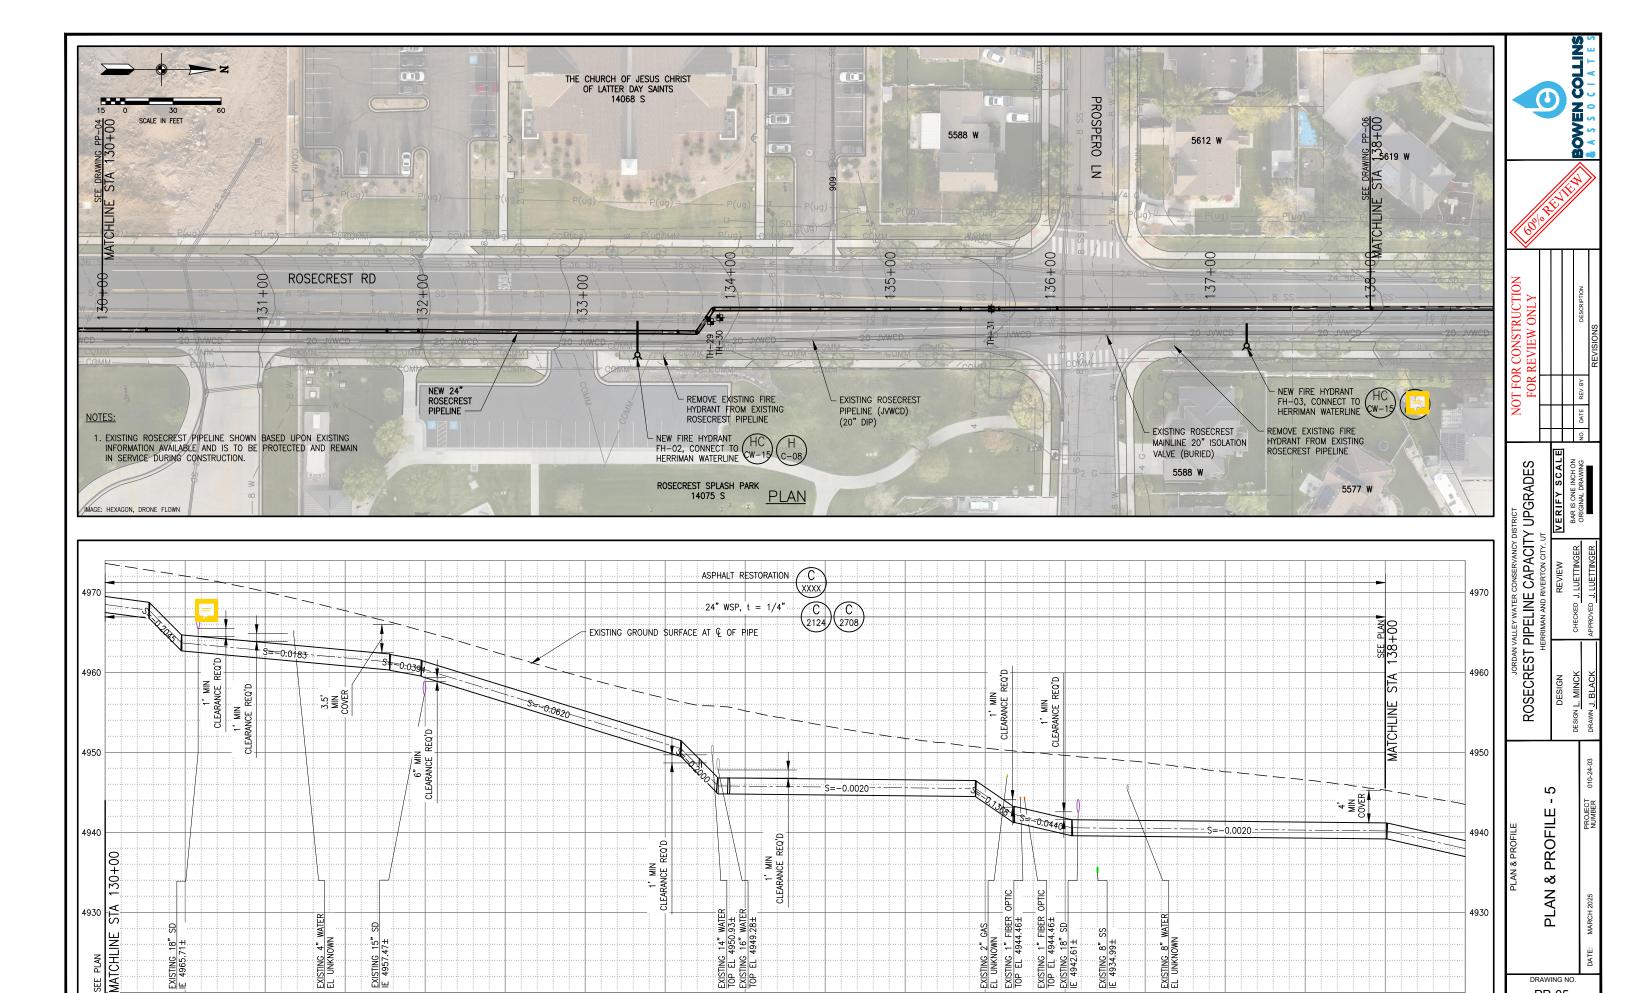

EXIST TOP I

134+00

134+50

135+00

133+50

133+00

132+50

135+50

136+00

136+50

137+00

137+50

138+00

138+50

PP-05


SHEET 12 OF 78


131+00

131+50


132+00


130+50

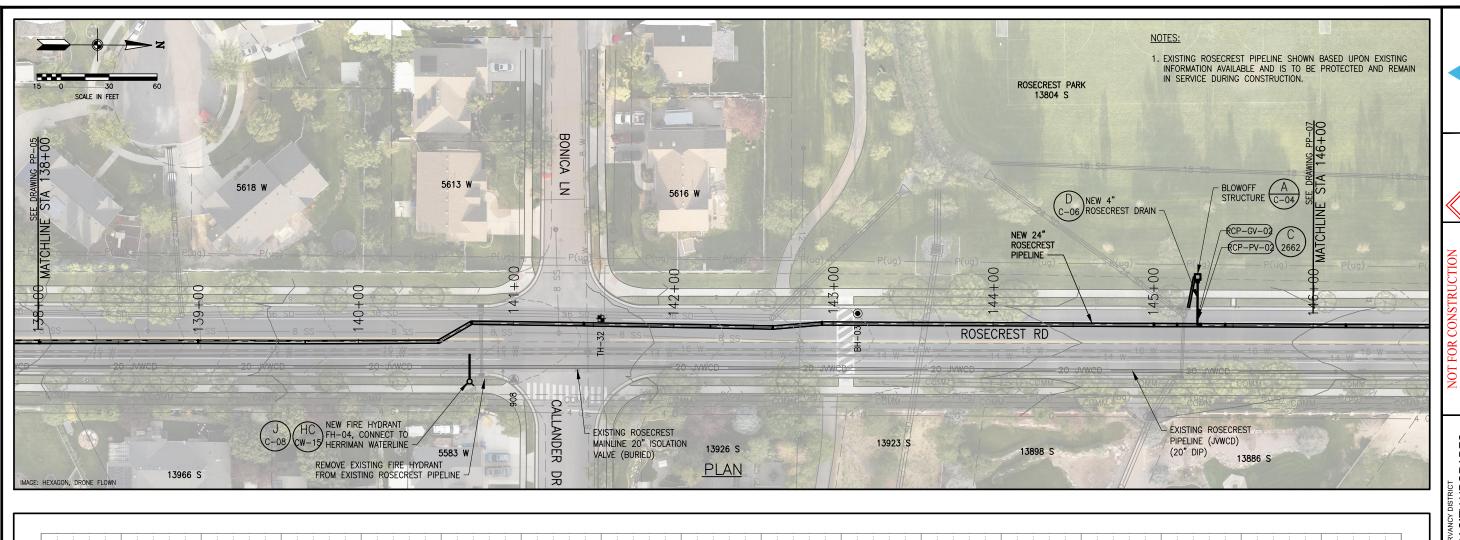


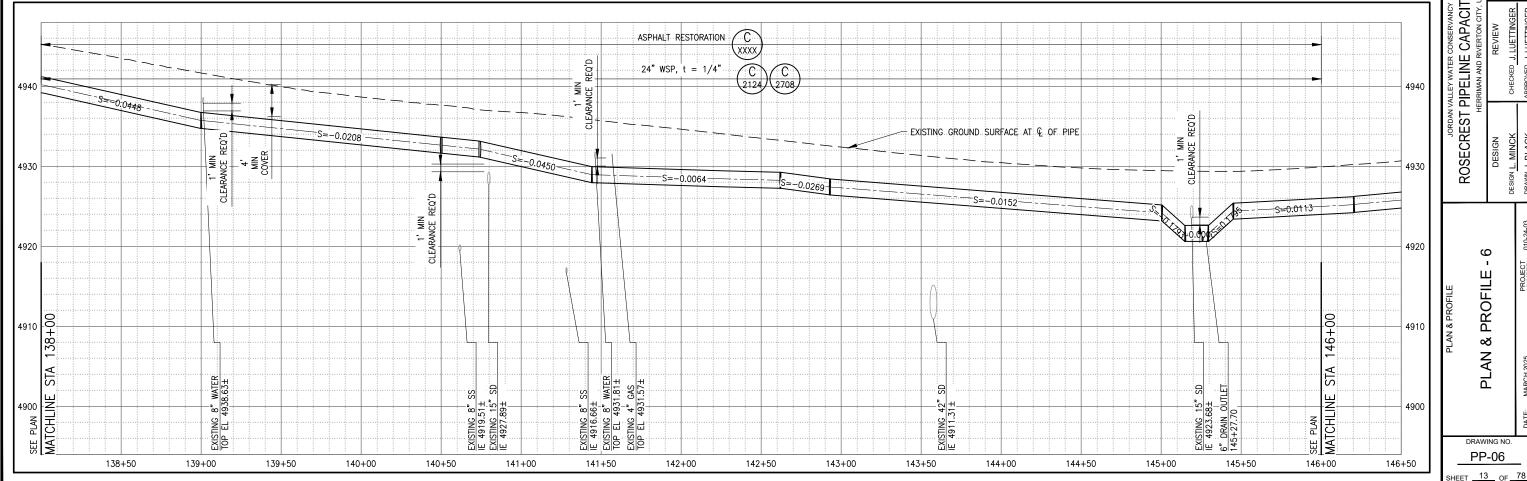





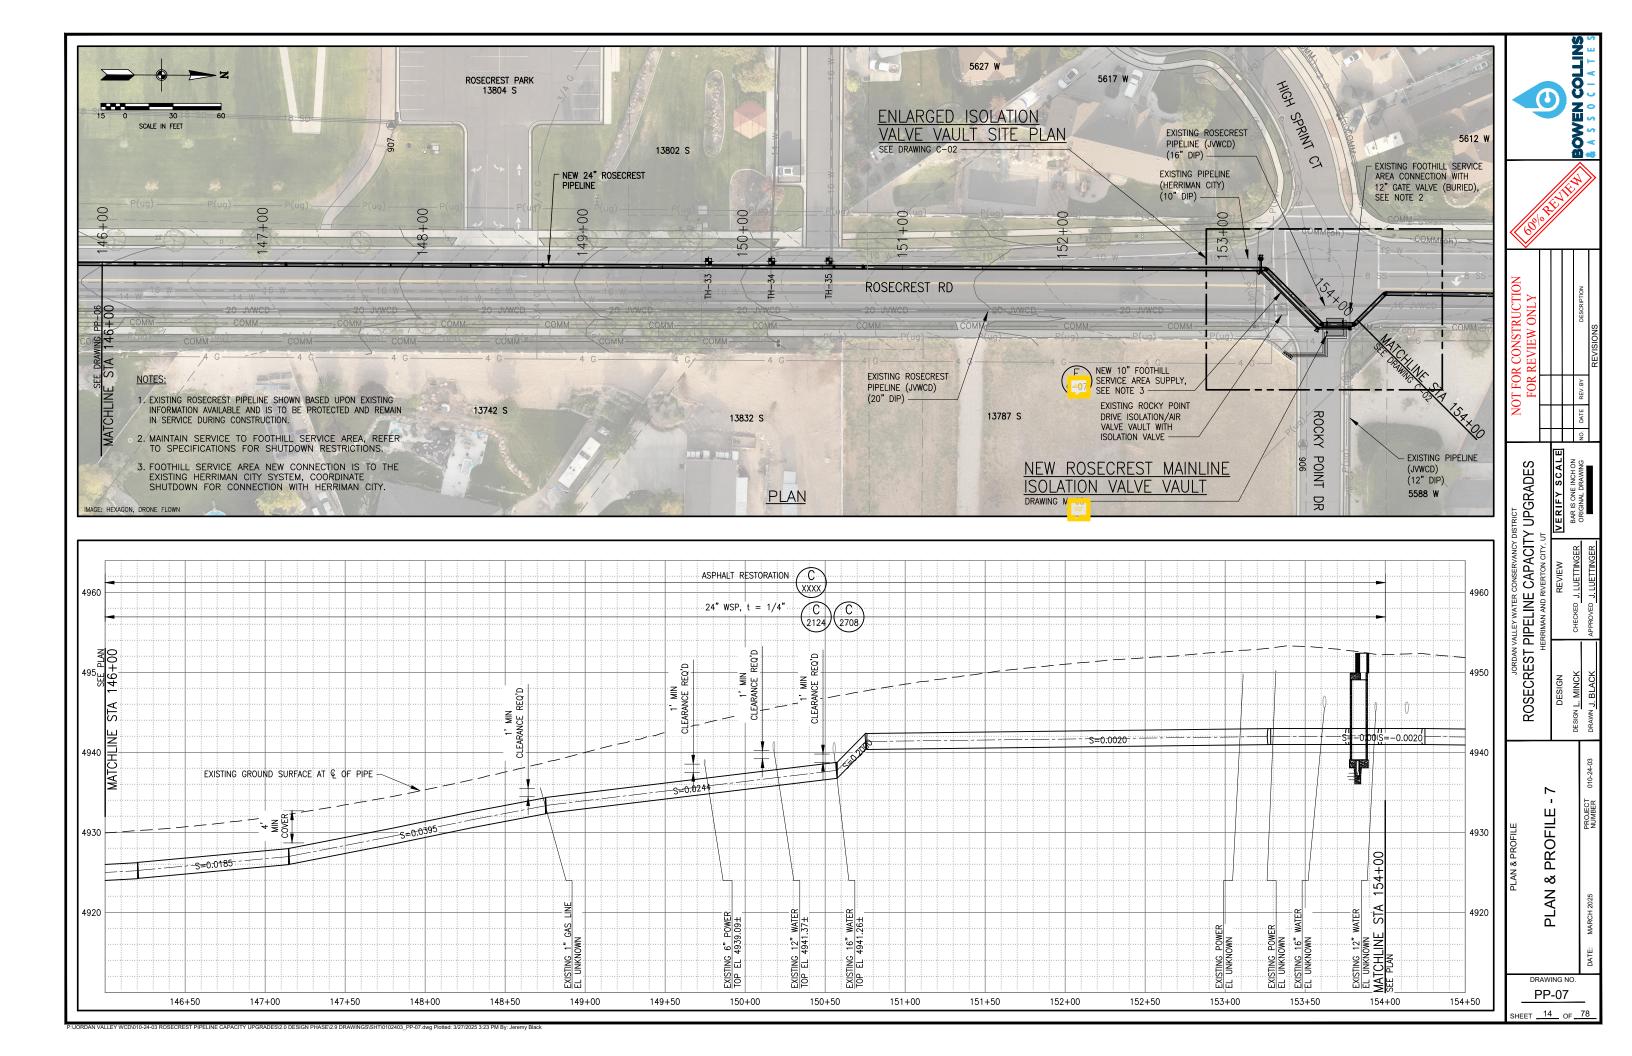


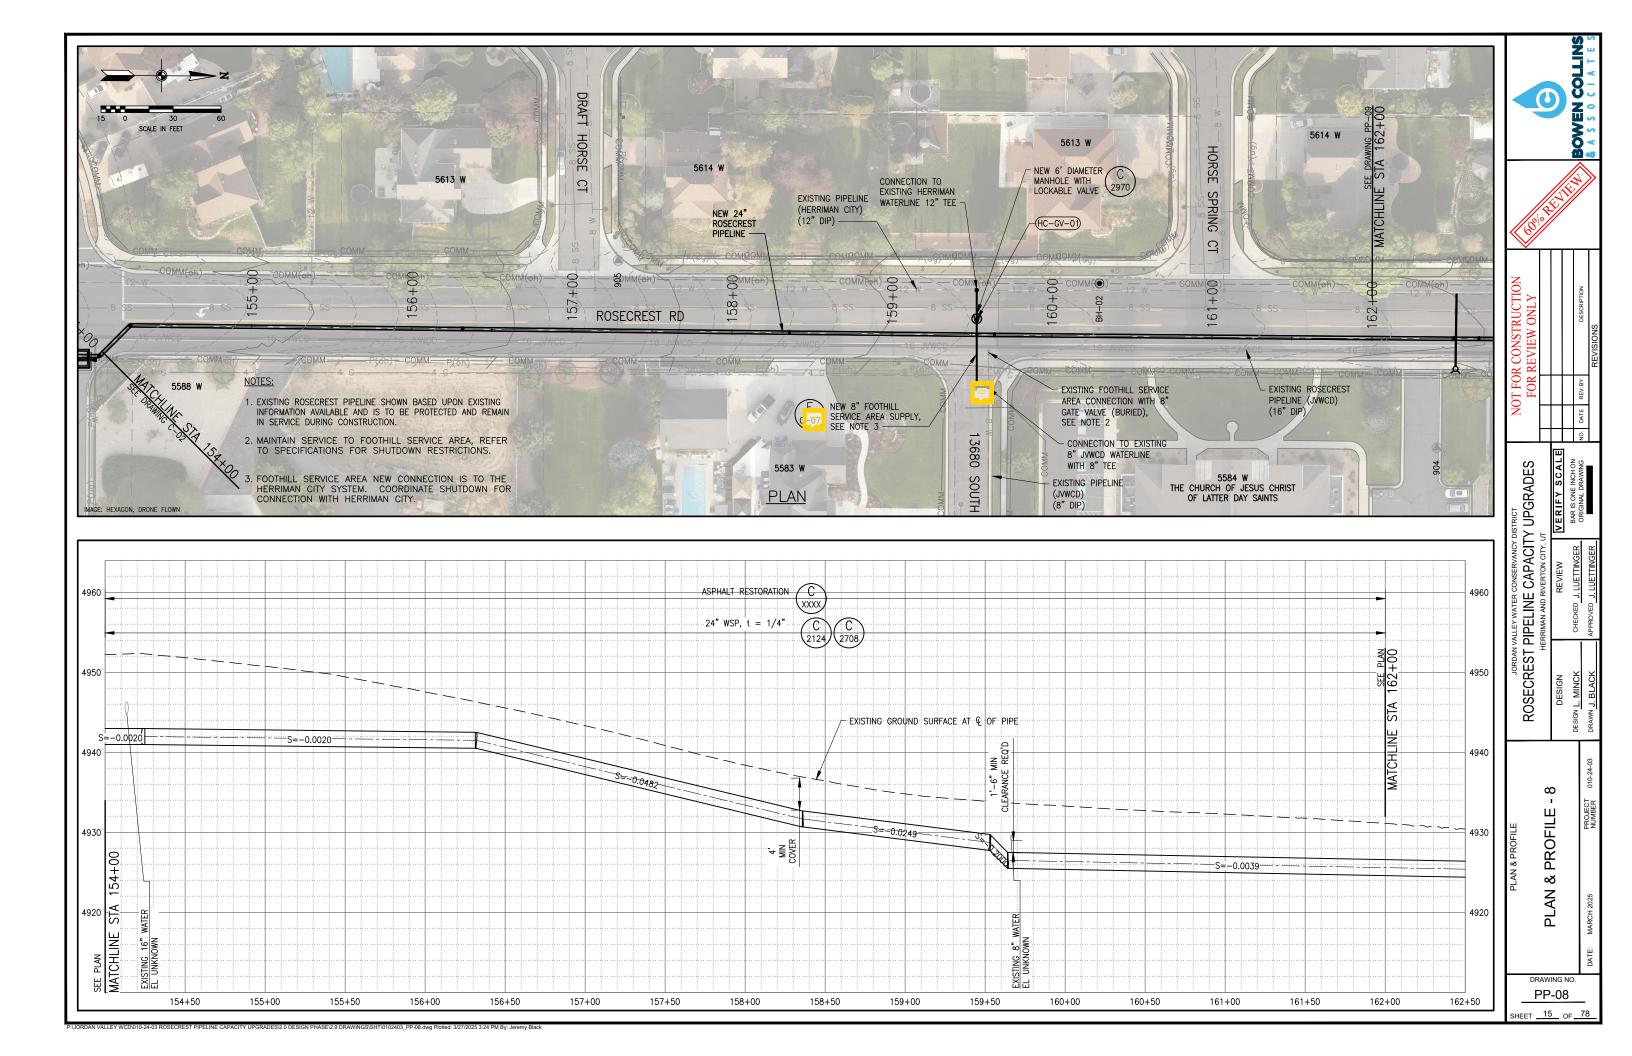


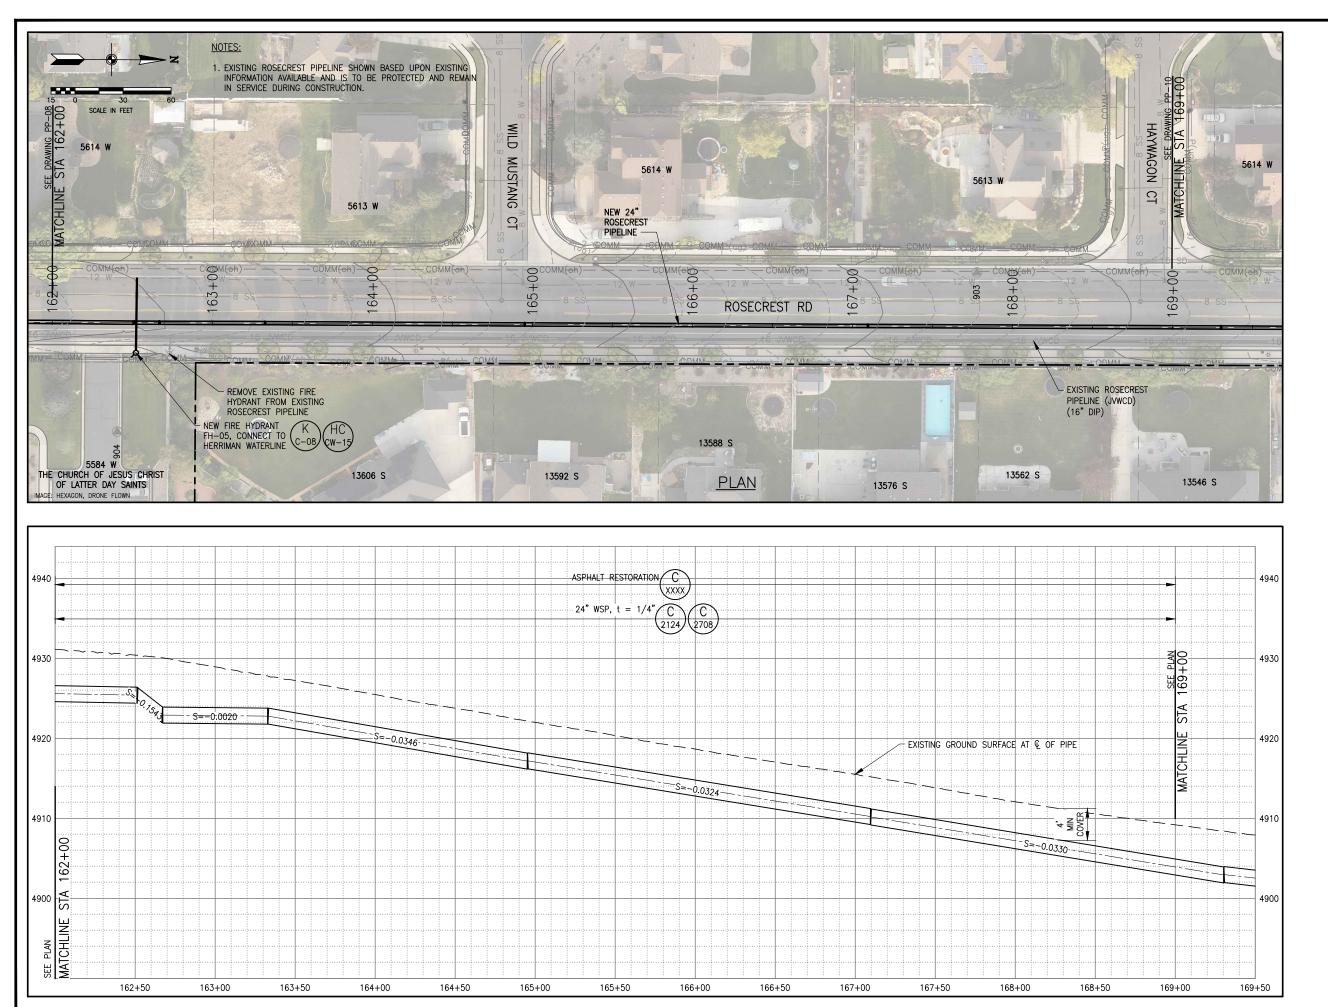


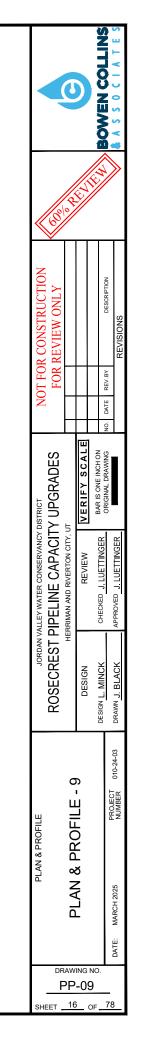


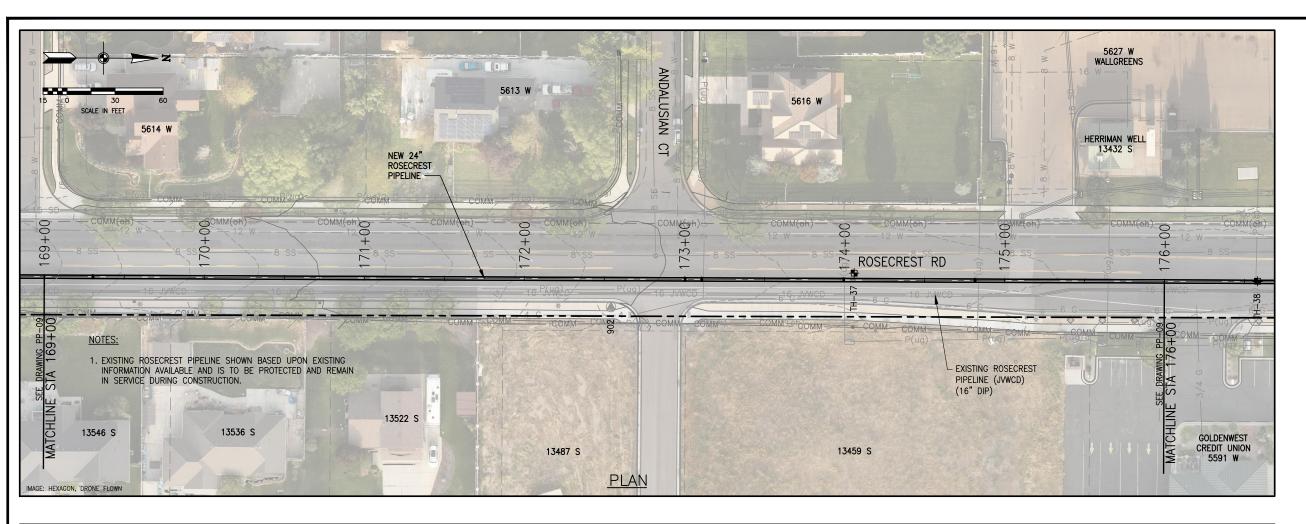

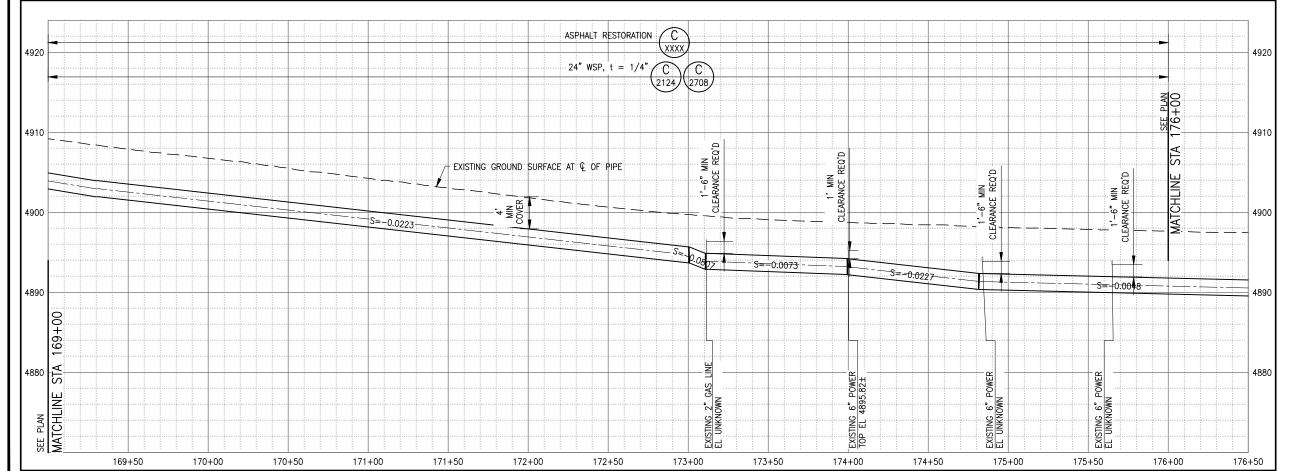

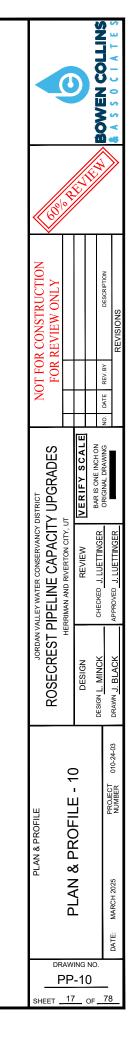

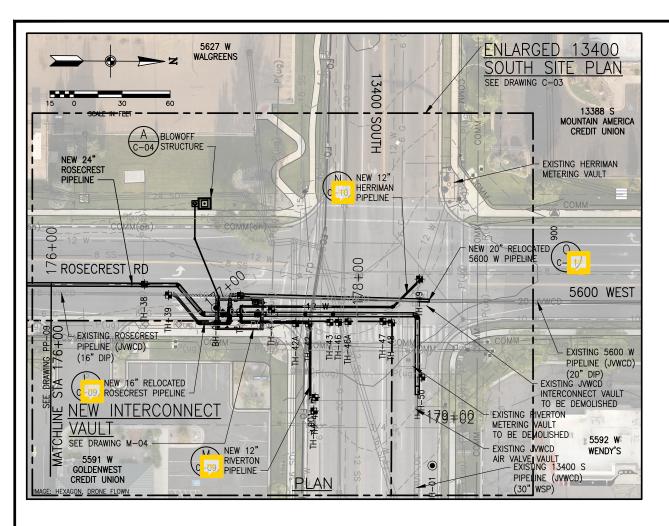

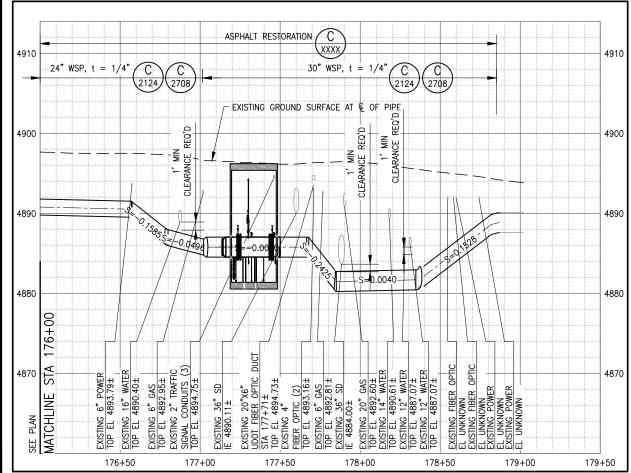

# NOTES:

- 1. EXISTING ROSECREST PIPELINE SHOWN BASED UPON EXISTING INFORMATION AVAILABLE AND IS TO BE PROTECTED AND REMAIN IN SERVICE DURING CONSTRUCTION. REFER TO SPECIFICATIONS FOR SHUTDOWN RESTRICTIONS.
- 2. THE PROJECT AT THIS LOCATION IS WITHIN RIVERTON CITY AND HERRIMAN CITY, THE BOUNDARY IS WITHIN 13400 SOUTH AND ROSECREST ROAD, COORDINATE TRAFFIC CONTROL, PERMITTING AND RESTORATION REQUIREMENTS AS REQUIRED FOR BOTH ENTITIES,
- 3. CONTRACTOR TO POTHOLE AND LOCATE EXISTING PIPELINE PRIOR TO FABRICATION OF SPECIAL FITTINGS FOR CONNECTIONS.
- 4. REFER TO SPECIFICATIONS FOR SHUTDOWN REQUIREMENTS AND COORDINATION FOR JVWCD, HERRIMAN CITY AND RIVERTON CITY. EXISTING ROSECREST PIPELINE TO BE PROTECTED IN PLACE AND PROVIDE SERVICE UNTIL THE NEW ROSECREST PIPELINE IS AVAILABLE TO PROVIDE SERVICE.
- 5. RESTORATION OF PARKSTRIPS TO INCLUDE GRADING BACK TO EXISTING SURFACE ELEVATION, REPLACING EXISTING SOD AND ANY IRRIGATION, STAMPED CONCRETE AND OTHER ITEMS NECESSARY TO BRING BACK TO ORIGINAL CONDITIONS.





NOT FOR CONSTRUCTION
FOR REVIEW ONLY

DATE REV. BY

DESCRIPTION

DESCRIPTION

ROSECREST PIPELINE CAPACITY UPGRADES

HERRIMAN AND RIVERTON CITY, UT

DESIGN

REVIEW

BAR IS ONE INCHON

DESIGN

DESIGN

DESIGN

REVIEW

DESIGN

DESIG


PLAN & PROFILE - 11


DESIGN


DRAWING NO.


PP-11

SHEET 18 OF 78

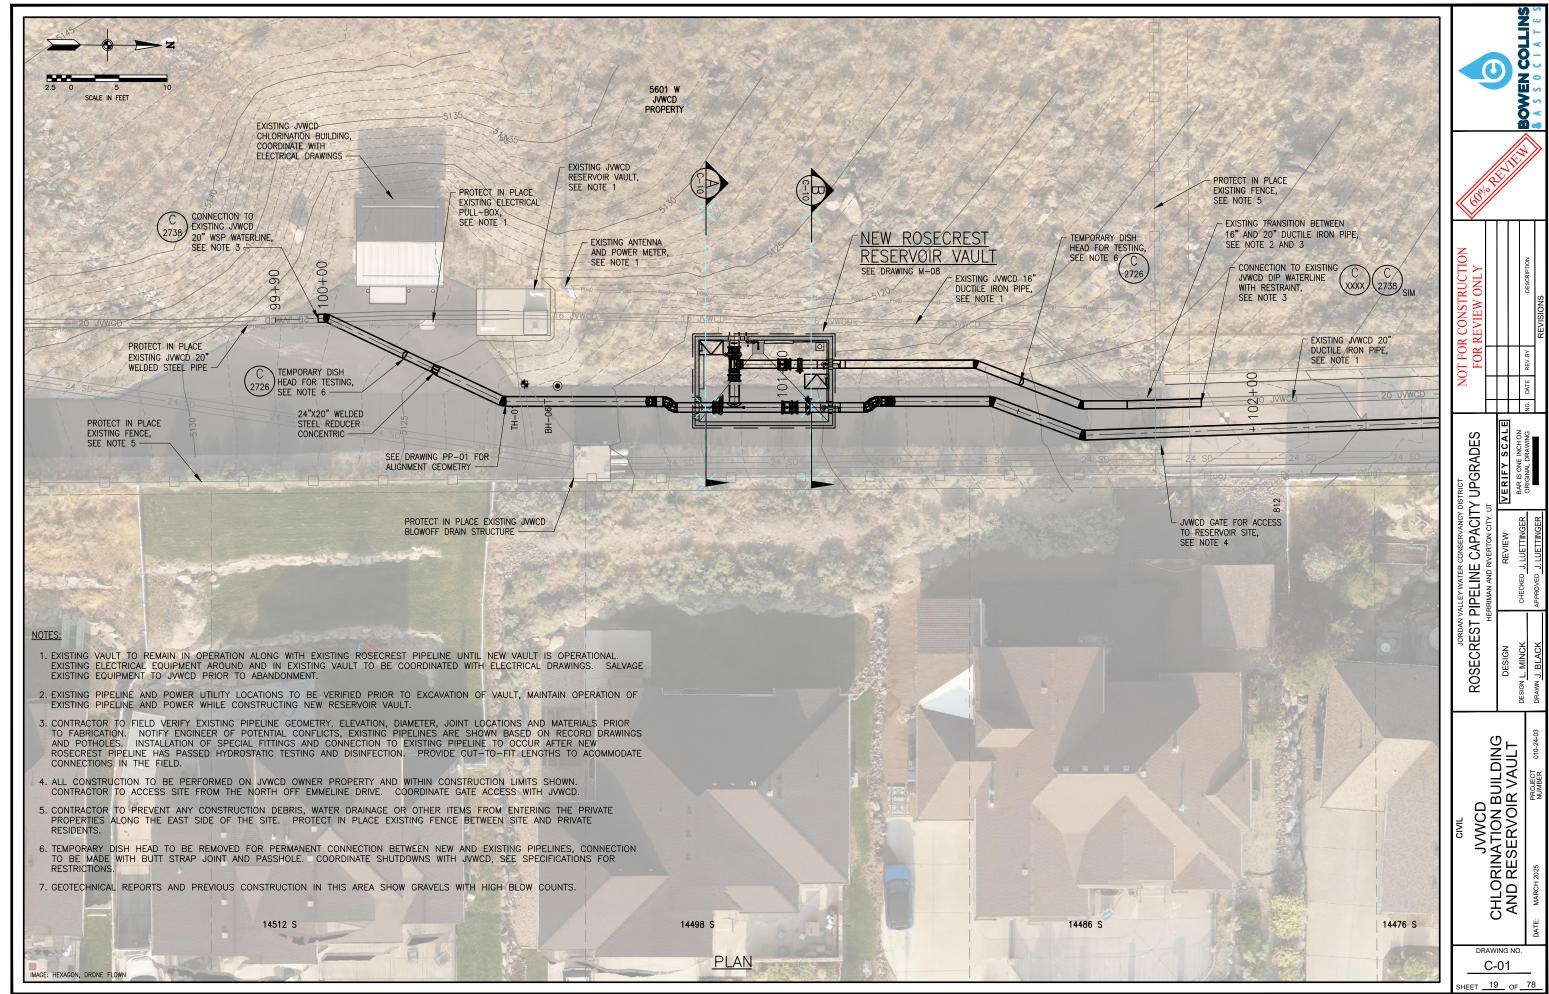


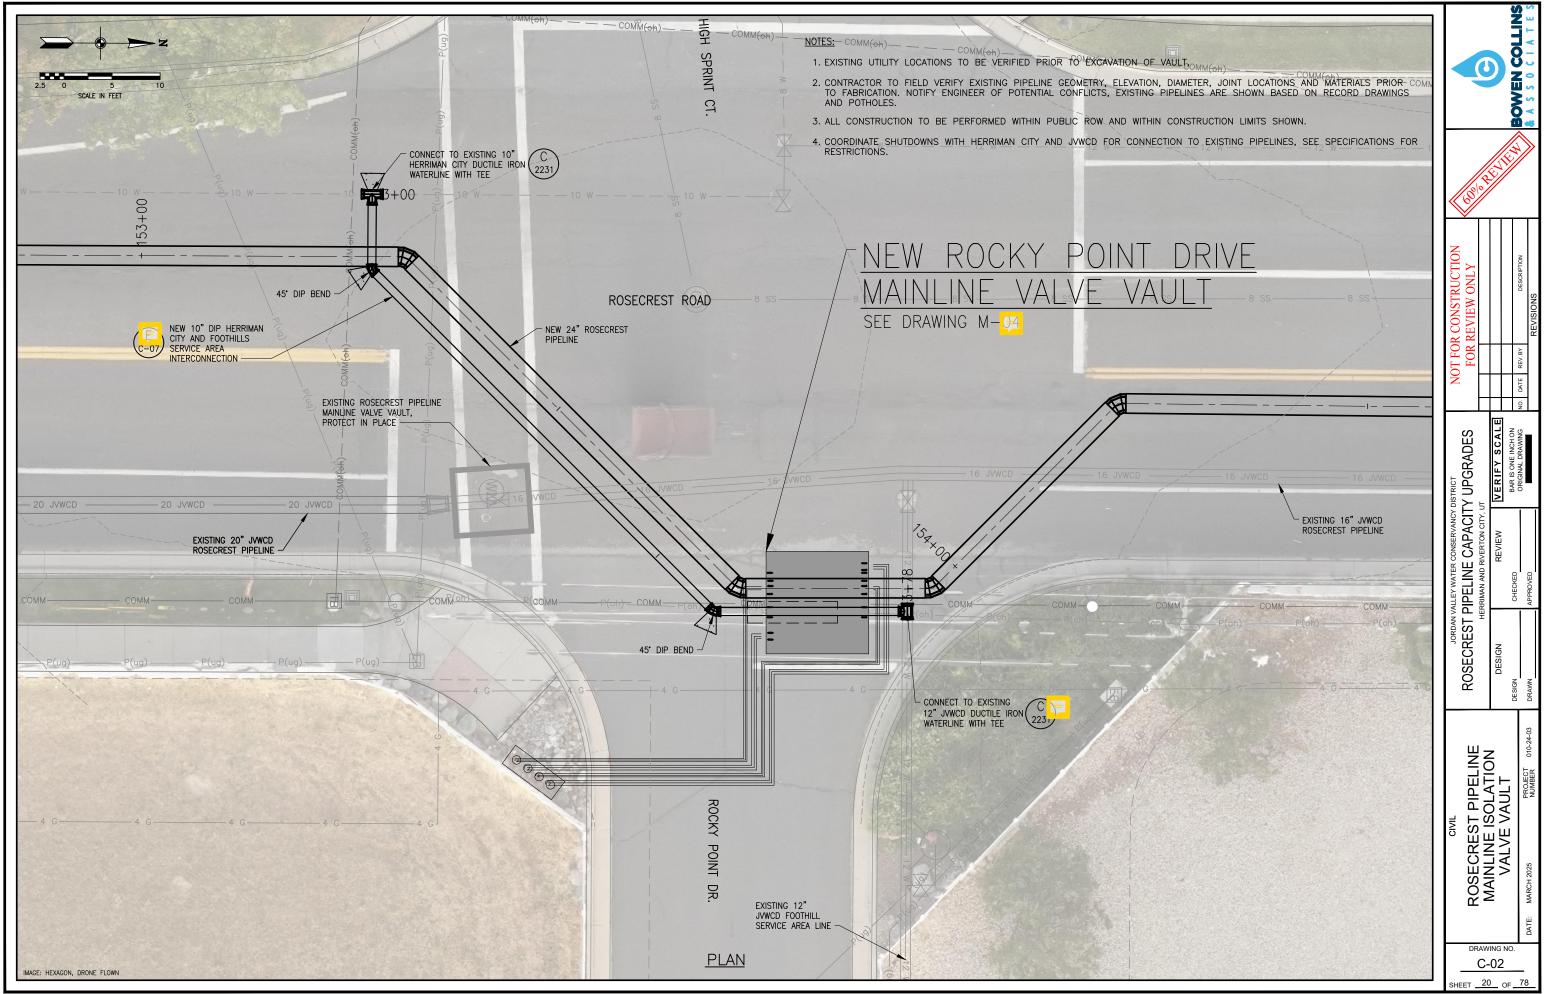

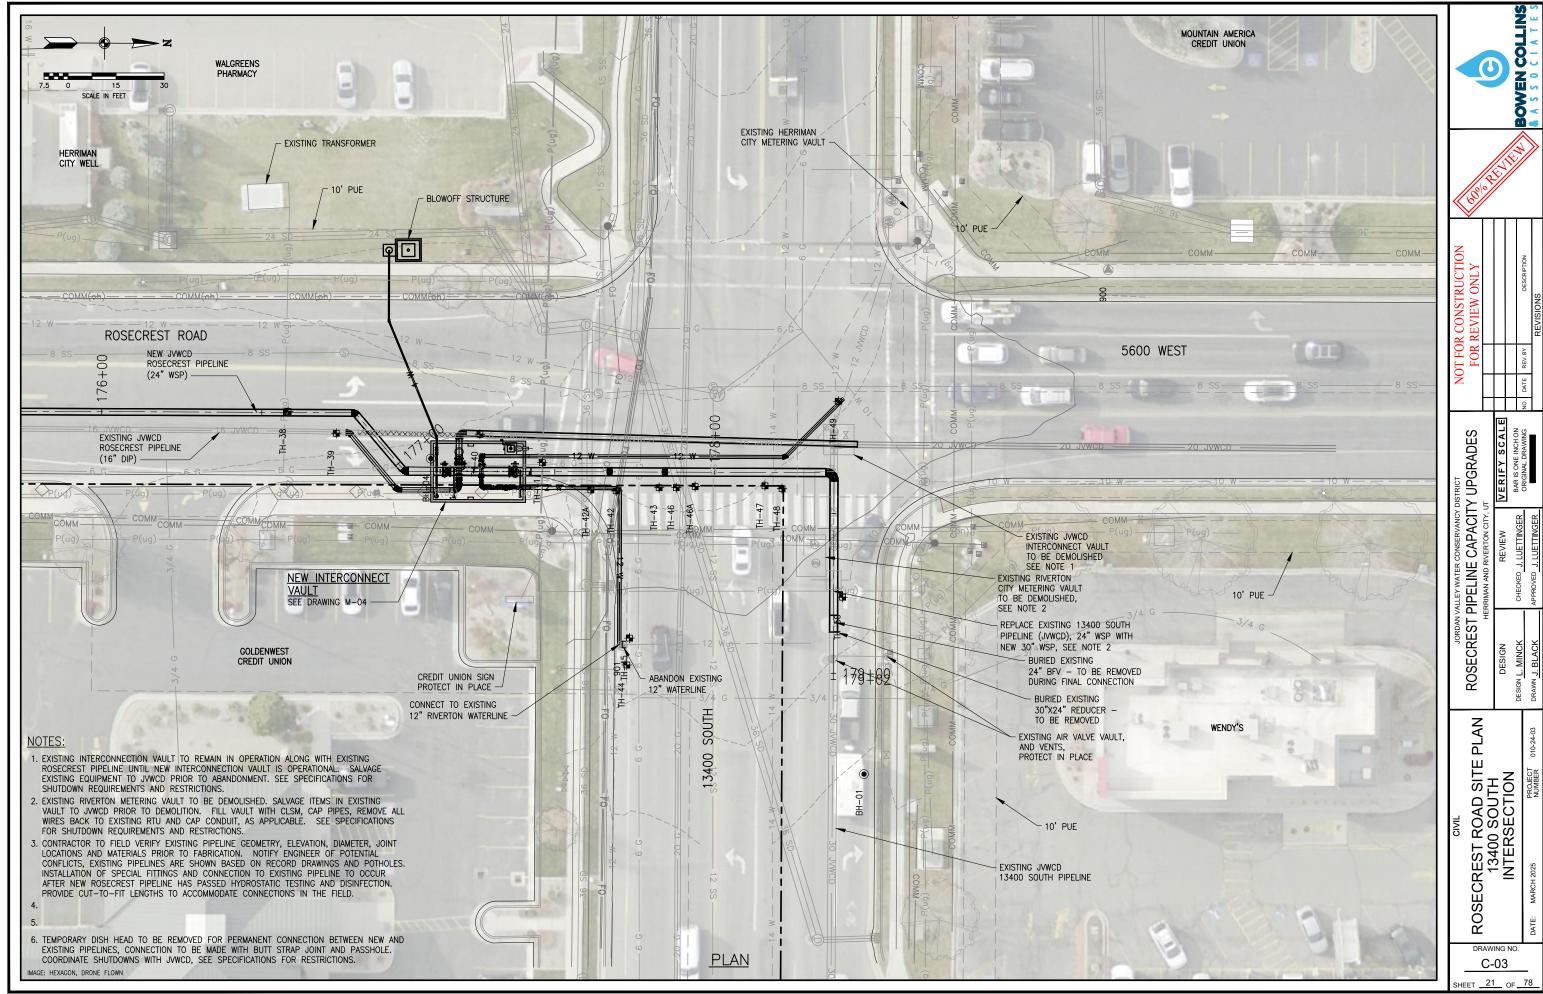

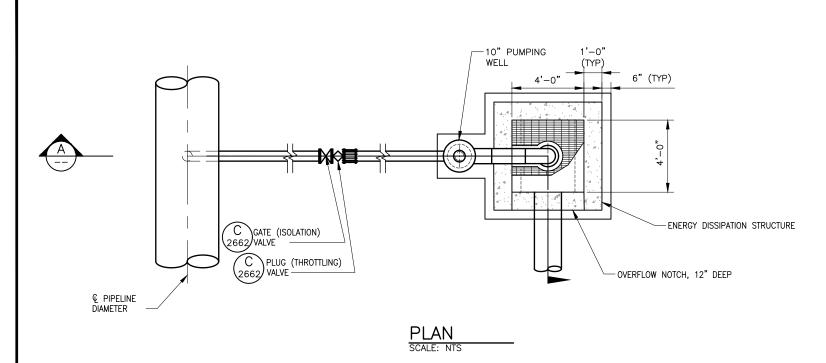

				I	TAB	LE 1					T
STATION	SHEET(S)	PROFILE	'A'	'B'	'c'	'D'	'E'	'F'	'G'	'H'	NOTES
108+43	PP-02	C C-06	3"	5046.4	5045.6						
145+27	PP-06	(C-06)	4"	4922.4	4921.6						
177+21	PP-11, C-01, M-04	P C-12	4"	SEE MECHANICAL DWGS	4885.8						VALVES FOR DRAIN I VAULT, SEE MECHANICAL DRAWING

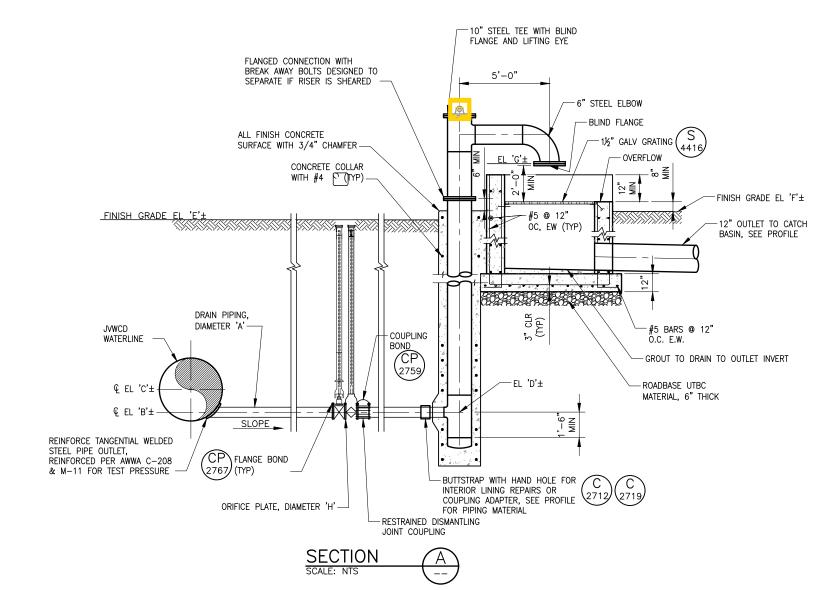

# NOTES:

- 1. SEE TABLE 1 FOR INDIVIDUAL DRAIN ELEVATIONS, SIZES, AND REQUIREMENTS.
- 2. ALL STEEL BLOWOFF PIPING TO BE STANDARD WEIGHT. COAT PER SPECIFICATIONS.
- 3. ENERGY DISSIPATION STRUCTURE DEPTH, INVERT PIPE ELEVATION, OUTLET PIPE SIZE AND DEPTH OF STRUCTURE TO BE COORDINATED WITH EXISTING STORM DRAIN SYSTEM. SEE PROFILE DRAWINGS FOR APPROXIMATE DEPTH.
- 4. FLANGE WITH BREAKAWAY BOLTS REQUIRED FOR BLOW-OFF. ALL FLANGES TO MEET THE PRESSURE REQUIREMENTS OF THE SYSTEM.
- 5. PROVIDE SMOOTH AND SLOPED CONCRETE TRANSITION SO THAT ALL WATER FLOWS AWAY FROM STRUCTURE.
- 6. SEE MECHANICAL SCHEDULE, SHEET M-03, FOR VALVE SIZES AND TYPES. VALVE LOCATIONS PER PLAN AND PROFILE DRAWINGS. FIELD VERIFY LOCATION ONSITE WITH OWNER REPRESENTATIVE.

		S	. 5
		OFFIN	_
		3	V
		Q	-
	0	2	0
-		<b>VEN</b>	2
		₹	5
		б	٧
		Ď	15
	/		<b>&gt;&gt;</b>
	//3	S//	
	X/	//	
//3	//		
$\mathbb{W}$			
	_		_

	/				_
NOT FOR CONSTRUCTION FOR REVIEW ONLY				DESCRIPTION	REVISIONS
OT FC FOR				REV. BY	
N				DATE	
				ON.	
SES		CALE	100	AWING	

ROSECREST PIPELINE CAPACITY UPGRAL

THERRIMAN AND RIVERTON CITY. IT

DESIGN

DESIGN

CHECKED J. LUETTINGER

DRAWN J. HUNTER

APPROVED J. LUETTINGER

REALING BARIS ONE IN

RAPROVED J. LUETTINGER

PROMIND DRAWN J. HUNTER

REALING BARIS ONE IN


BLOWOFF STRUCTURE

MARCH 2025


PROJECT 010-24-03

C-04

SHEET 22 OF 78

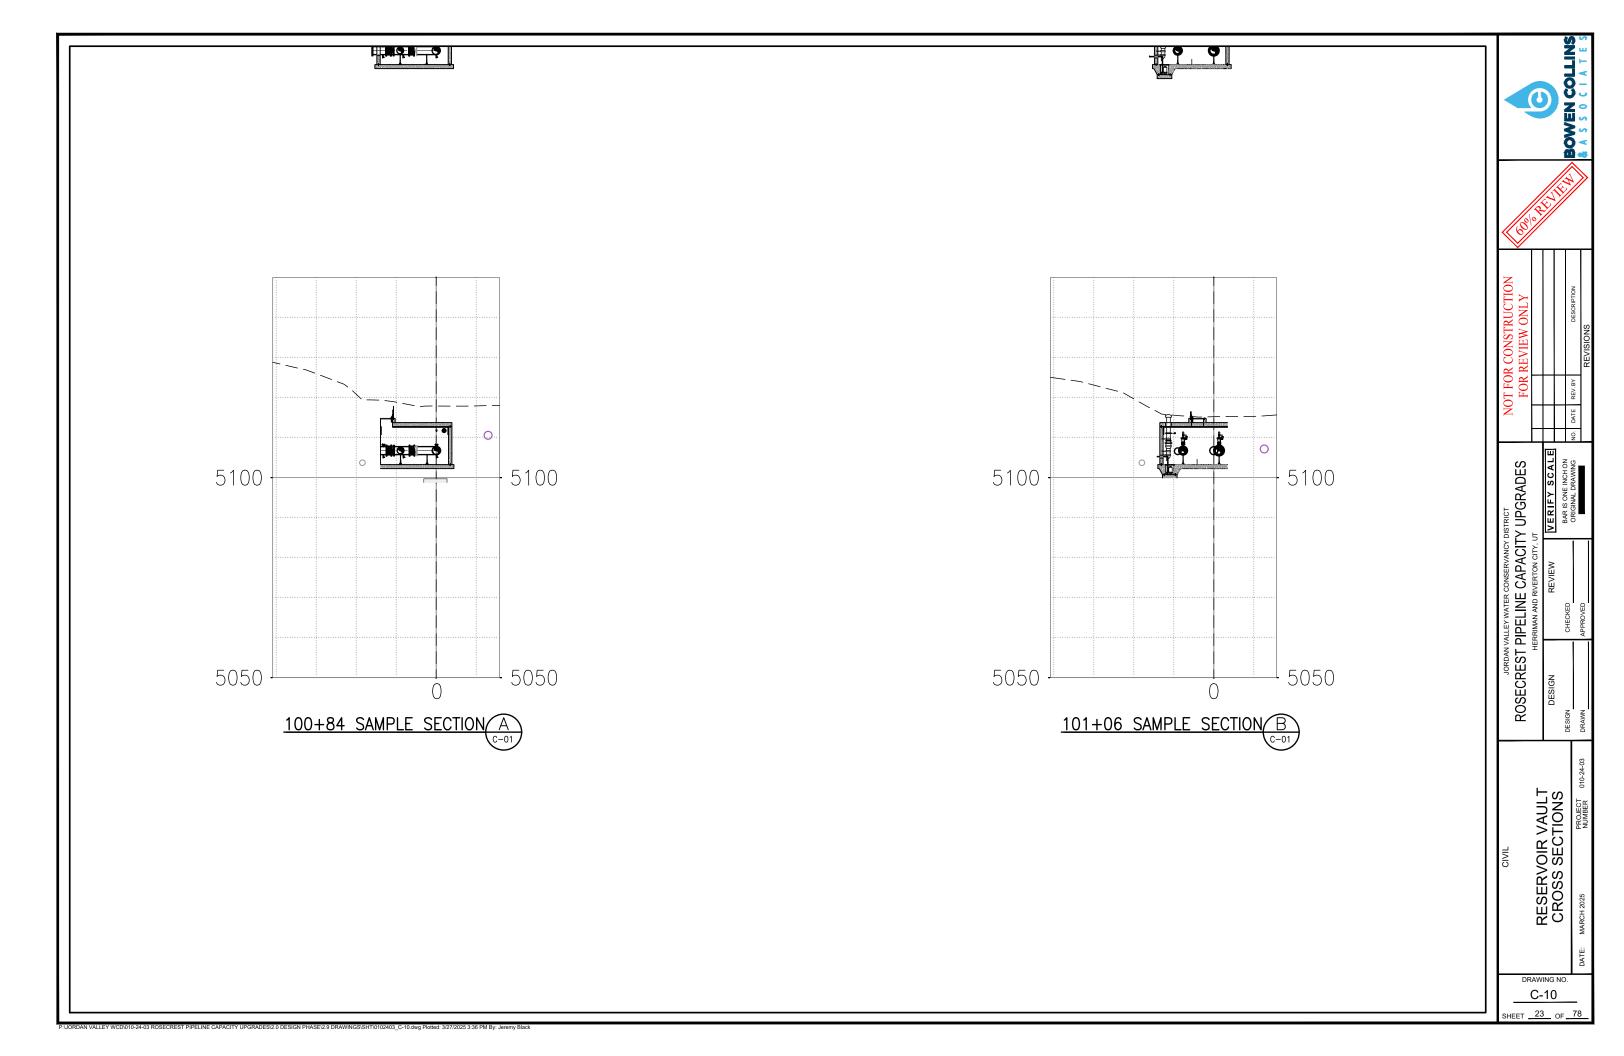

										POTH	HOLE DATA			Ι	<u>v</u>
TEST HOLE NO.	DATA	SIZE	TYPE	MATERIAL	OWNER	NORTHING	EASTING	GROUND ELEVATION	DEPTH (FEET)	TOP ELEVATION	SURFACE TYPE	PAVEMENT DEPTH	COMMENTS		Z
<u>1</u> 2	1/15/2025 1/15/2024	1" 20" PER PLAN	ELECTRIC WATER	PLASTIC METAL	JVWCD	7346813.14 7347129.79	1494557.9 1494556.5	5120.9 5090.35	1.18 4.18	5119.72 5086.17	NATURAL GROUND ASPHALT	N/A 4"	UNABLE TO VISUALLY VERIFY ENTIRE PIPE TO OBTAIN SIZE MEASUREMENT. STANDBY CONFIRMED THE LINE. APPEARS TO BE POLYWRAP ON THE LINE.	1 _	
<u>3</u>	1/10/2025	(2) 1"	ELECTRIC	DIRECT BURY	ROCKY MOUNTAIN POWER	7347189.55	1494560.8	5086.74	3.58	5083.16	ASPHALT	3"			<u>3 8</u>
4	N/A	N/A	ELECTRIC	DIRECT BURY	ROCKY MOUNTAIN	N/A	N/A	N/A	N/A	N/A	N/A	N/A	LOCATED IN TH-03.		<b>7</b> Z
5	12/31/2024	(3) 1"	ELECTRIC	DIRECT BURY	POWER ROCKY MOUNTAIN	7347519.45	1494564.1	5057.28	5.95	5051.33	ASPHALT	5"		1	≥
6	1/27/2025	20" PER PLAN	WATER	METAL	POWER JVWCD	7347525.83	1494562.6	5056.7	3.16	5053.54	ASPHALT	5"	DUE TO THE PIPE BEING SHALLOW, IT WAS NOT POSSIBLE TO FULLY EXPOSE THE LINE WITHOUT CORING AN ADDITIONAL HOLE. PIPE HAD DAMAGED POLYWRAP.	1	8
7	N/A	20" PER PLAN	WATER	UNKNOWN	HERRIMAN CITY	N/A	N/A	N/A	N/A	N/A	SIDEWALK	N/A	UNABLE TO DIG IN SIDEWALK WITHOUT SIDEWALK PANEL REPLACEMENT PER HERRIMAN CITY.		
<u>8</u>	1/17/2025	20" PER PLAN	WATER	METAL	HERRIMAN CITY	7347541.72	1494568	5056.04	5.73	5050.31	ASPHALT	5"	UNABLE TO FULLY EXPOSE THE LINE AND OBTAIN SIZE MEASUREMENT DUE TO THE WALLS COLLAPSING FROM THE SAND.  TEST HOLE REQUEST CALLED FOR 8". LINE WAS NOT TONABLE AND COMPLETED ON THE BLUE STAKES MARKS. UNABLE TO OBTAIN A GOOD PICTURE SHOWING AN ACCURATE SIZE		
9	1/17/2025	20"	IRRIGATION	PLASTIC	HERRIMAN CITY	7347549.13	1494573.8	5056.28	2.19	5054.09	ASPHALT	3.5"	MEASUREMENT DUE TO THE SHALLOW DEPTH OF THE LINE. VISUALLY VERIFIED THE LINE AT 20".		\$\\\\
<u>10</u> <u>11</u>	1/17/2025 1/18/2025	16" 20" PER PLAN	WATER	PLASTIC METAL	HERRIMAN CITY HERRIMAN CITY	7347565.32 7347566.69	1494560.6 1494557.2	5056.47 5056.56	4.63 7.08	5051.84 5049.48	ASPHALT ASPHALT	3" 5"		/s/2	//
12	1/27/2025	15"	WATER	PLASTIC	HERRIMAN CITY	7347571.47	1494554.5	5056.67	5.04	5051.63	ASPHALT	3"			
<u>13</u> 14	1/24/2025 1/24/2025	15" 12" W <b>I</b> DE	UNKNOWN	METAL UNKNOWN	HERRIMAN CITY UNKNOWN	7347733.73 7347737.96	1494368.6 1494370.9	5059.1 5058.96	5.29 5.42	5053.81 5053.54	ASPHALT ASPHALT	6" 6"	UNABLE TO DETERMINE IF THIS IS THE WATERLINE ENCASED IN FLOWABLE FILL. UNABLE TO DIG TO THE SIDES DUE TO LARGE ROCKS.		
15	1/18/2025	(2) 5"	ELECTRIC	PLASTIC	ROCKY MOUNTAIN	7347795.82	1494372.5	5057.36	4.04	5053.32	ASPHALT	5"	ON DEE TO BE EXAMINE IT THIS TO THE TATLETE ENGINEER FILE, ON DEE TO BE ON THE OBJECT OF BINGE NOON.	Z	
<u>–</u> <u>16</u>	1/23/2025	8"	WATER	PLASTIC	POWER HERRIMAN CITY	7347764.94	1494381.4	5058.23	5.19	5053.04	ASPHALT	6"		110 Y	NOITdi
<u>17</u>	N/A	16" PER PLAN	WATER	UNKNOWN	HERRIMAN CITY	N/A	N/A	N/A	STOPPED AT 7 FT	N/A	N/A	N/A	UNABLE TO LOCATE WATER LINE AT THIS LOCATION DUE TO LARGE ROCKS. DUG TO APPROXIMATELY 7 FEET.		DESCR
<u>18</u>	N/A	N/A	ELECTRIC	PLASTIC	ROCKY MOUNTAIN POWER	N/A	N/A	N/A	N/A	N/A	N/A	N/A	LINE REQUESTED IN TEST HOLE 18 LOCATED IN TEST HOLE 15.	STR	
<u>19</u>	1/23/2025	6"	WATER	PLASTIC	HERRIMAN CITY	7348013.09	1494527.7	5036.42	4.34	5032.08	ASPHALT	5"	OF AAC INC NODE A JEAANNO	VIE	
<u>20</u> <u>21</u>	1/9/2025 N/A	4" 16" PER PLAN	GAS WATER	PLASTIC UNKNOWN	ENBRIDGE GAS HERRIMAN CITY	7348165.55 N/A	1494651.8 N/A	5020.63 N/A	4.32 STOPPED AT 6 FT	5016.31 N/A	ASPHALT N/A	4" N/A	2" GAS LINE INSIDE A 4" CASING.  UNABLE TO LOCATE WATER LINE AT THIS LOCATION DUE TO LARGE ROCKS. DUG TO APPROXIMATELY 6 FEET.	R C RE	
<u>22</u>	1/10/2025	8"	WATER	PLASTIC	HERRIMAN CITY	7348189.28	1494688.5	5018.41	4.71	5013.7	ASPHALT	4"		FO	\ B∀
<u>23</u> 24	N/A N/A	N/A N/A	COMMUNICATION COMMUNICATION	PLASTIC PER PLAN PLASTIC PER PLAN	LUMEN LUMEN	N/A N/A	N/A N/A	N/A N/A	N/A N/A	N/A N/A	N/A N/A	N/A N/A	NO FIELD EVIDENCE OF LUMEN LINES AT THIS LOCATION.  NO FIELD EVIDENCE OF LUMEN LINES AT THIS LOCATION.		- H
<u>25</u>	1/8/2025	8"	WATER	PLASTIC	HERRIMAN CITY	7348885.89	1494565.3	4988.65	3.6	4985.05	ASPHALT	5"	NO FIELD EVIDENCE OF LOWEN LINES AT THIS LOCATION.	1~	DATE
<u>26</u>	1/23/2025	16"	WATER	PLASTIC	HERRIMAN CITY	7349119.94	1494573.2	4979.78	4.77	4975.01	ASPHALT	5"			Ö
<u>27</u>	1/9/2025	(6) 2 / (2) 4"	TRAFFIC SIGNAL	PLASTIC	HERRIMAN CITY	7349163.87	1494580.8	4978.73	2.45	4976.28	ASPHALT	5.5"	UNABLE TO VISUALLY VERIFY BOTTOM CONDUITS TO OBTAIN SIZE MEASURE BUT APPEAR TO BE 4". DEPTH SHOWN IS TO TOP OF UTILITY. UTILITY BOTTOM AT 2.99'. UTILITY BOTTOM NOTED IS APPARENT BOTTOM UNLESS NOTED AS ACTUAL BOTTOM.		ALE No No
<u>28</u>	1/9/2025	5"	ELECTRIC	PLASTIC	ROCKY MOUNTAIN POWER	7349272.82	1494584.6	4976.57	4.96	4971.61	ASPHALT	5.5"		GRADE	S C A
<u>29</u>	1/13/2025 1/23/2025	14" 16" PER PLAN	WATER WATER	METAL PLASTIC	JVWCD HERRIMAN CITY	7349772.6 7349778.37	1494577.5 1494575	4955.58 4955.3	4.36 5.84	4951.22 4949.46	ASPHALT ASPHALT	4" 6"	PLAN CALLED FOR 12". OD MEASURED AT 14" INCLUDES THE POLY WRAP ON THE LINE.  UNABLE TO FULLY EXPOSE PIPE TO OBTAIN SIZE MEASUREMENT DUE TO PEA GRAVEL COLLAPSING.	1 ₹	FY S ONE
<u>31</u>	1/13/2025	(2) 2"	FIBER OPTIC	PLASTIC	LUMEN	7349776.37	1494569.6	4950.27	5.65	4944.62	ASPHALT	5"	UNABLE TO FULL EAFOGE FIFE TO OBTAIN SIZE WEASONEMENT DUE TO FEA GRAVEL CULLAFOING.	UPG	ERI 3AR IS ORIGI
<u>32</u>	1/8/2025	4"	GAS	PLASTIC	ENBRIDGE GAS	7350536.56	1494554.8	4935.47	4.01	4931.46	ASPHALT	6"			<u> </u>
<u>33</u>	1/6/2025	6"	ELECTRIC	PLASTIC	ROCKY MOUNTAIN POWER	7351360.57	1494557.6	4943.77	4.57	4939.2	ASPHALT	5"			,
<u>34</u> 35	1/6/2025 1/7/2025	12" 16"	WATER	METAL PLASTIC	HERRIMAN CITY HERRIMAN CITY	7351399.99 7351435.88	1494557.6 1494557.5	4945.47 4946.83	4.25 5.75	4941.22 4941.08	ASPHALT ASPHALT	5" 4"		APA	M ⊞
<u>36</u>	N/A	16"	WATER	DIP PER PLAN	JVWCD	N/A	N/A	N/A	STOPPED AT 6 FT	N/A	N/A	N/A	UNABLE TO LOCATE WATER AT THIS LOCATION DUE TO GROUND COLLAPSING. DUG TO APPROXIMATELY 6 FEET.		REV
<u>37</u>	1/13/2025	6"	ELECTRIC	PLASTIC	ROCKY MOUNTAIN POWER	7353765.46	1494586.9	4898.74	3	4895.74	ASPHALT	3"		A HE A	
<u>38</u>	12/19/2024	6"	ELECTRIC	PLASTIC	ROCKY MOUNTAIN POWER	7354017.48	1494591.9	4897.48	3.76	4893.72	ASPHALT	6"		LEY V PEL	CHEC
<u>39</u>	12/19/2024	16"	WATER	METAL	JVWCD	7354032.54	1494598.7	4897.22	6.77	4890.45	ASPHALT	6"		N VALLE  PIP	$\vdash$
<u>40</u> 41	12/19/2024 1/10/2025	16" (3) 2"	WATER TRAFFIC SIGNAL	METAL PLASTIC	JVWCD	7354077.43 7354096.92	1494599 1494607.9	4896.89 4896.34	7.58 1.17	4889.31 4895.17	ASPHALT ASPHALT	6" 6.5"		JRDAN EST	
<u>41</u> <u>42</u>	1/10/2025	(2) 4"	FIBER OPTIC	PLASTIC	LUMEN	7354096.92	1494616.7	4895.99	2.98	4893.01	ASPHALT	7"		CRE	N
<u>42A</u>	1/10/2025	20" WIDE	FIBER OPTIC	CONCRETE DUCT	UDOT	7354112.07	1494616.4	4895.75	1.41	4894.34	ASPHALT	5.5"	DEPTH SHOWN IS TO TOP OF UTILITY. UTILITY BOTTOM AT 1.99'. UTILITY BOTTOM NOTED IS APPARENT BOTTOM UNLESS NOTED AS ACTUAL BOTTOM. ADDITIONAL MATERIAL AND/OR UTILITIES MAY EXIST BELOW APPARENT OR ACTUAL BOTTOM.	]	DESI
<u>43</u>	1/10/2025	6"	GAS	PLASTIC	ENBRIDGE GAS	7354133.42	1494615.7	4896.25	3.44	4892.81	ASPHALT	7"	AND ON A HELLIEU MATERIAL PART OF ACTUAL BOTTOM.	ROSE	J MÖ
<u>44</u> 45	1/6/2025	2"/UNKNOWN	CABLE TV	PLASTIC	COMCAST	7354123.3	1494671.1	4894.12	4.8	4889.32	ASPHALT	5" 5"	DEPTH SHOWN IS TO TOP OF UNKNOWN SIZE LINE. DEPTH TO TOP OF 2" FIBER LINE IS 4.80'.  NO VISUAL SIGNS OF ANY DAMAGE TO THE POLYWRAP.	<u> </u>	DES
<u>45</u> <u>46</u>	1/6/2025 1/10/2025	12" 14"	WATER GAS HP	METAL METAL	RIVERTON CITY ENBRIDGE GAS	7354124.15 7354138.79	1494662.7 1494615.7	4894.43 4896.26	6.98 3.74	4887.45 4892.52	ASPHALT ASPHALT	7"	NO VISUAL SIGNS OF ANY DAMAGE TO THE POLYWRAP.  PER STANDBY, THIS IS THE 14" ABANDONED HIGH PRESSURE LINE.	1	
<u>46A</u>	1/24/2025	20" PER PLAN	GAS HP	METAL	ENBRIDGE GAS	7354144.69	1494615.4	4896.22	4.36	4891.86	ASPHALT	6"	UNABLE TO VISUALLY VERIFY ENTIRE PIPE TO OBTAIN SIZE MEASUREMENT AT STANDBY'S REQUEST TO PROTECT THE LINE FROM DAMAGE.	1	
<u>47</u> 48	1/8/2025 1/8/2025	14" UNKNOWN	WATER WATER	METAL METAL	HERRIMAN CITY HERRIMAN CITY	7354166.51 7354171.83	1494615.2 1494616.1	4895.93 4895.64	5.28 8.54	4890.65 4887.1	ASPHALT ASPHALT	6" 6"	NO VISUAL SIGNS OF ANY DAMAGE TO THE POLYWRAP.  UNABLE TO VISUALLY VERIFY PIPE DUE TO THE SOIL AND ROCKS COLLAPSING. FIELD EVIDENCE SUGGEST THAT CREWS WERE ABLE TO FEEL THE PIPE AT A DEPTH OF 8.54.	1	
<u>49</u>	1/27/2025	18"	WATER	METAL	JVWCD	7354171.83	1494588.7	4896.02	5.62	4890.4	ASPHALT	9"	WRAP APPEARS TO BE IN GOOD CONDITION. OD OF PIPE 19".	1 :	<
<u>50</u>	1/3/2025	30" PER PLAN	WATER	METAL	JVWCD	7354190.77	1494650	4894.45	6.41	4888.04	ASPHALT	7"	UNABLE TO VISUALLY VERIFY ENTIRE PIPE DUE TO THE LARGE PIPE SIZE.	] :	Ψľ
<u>50</u>	1/3/2025	30" PER PLAN	WATER	METAL	JVWCD	7354190.77	1494650	4894.45	6.41	4888.04	ASPHALT	7*	UNABLE TO VISUALLY VERIFY ENTIRE PIPE DUE TO THE LARGE PIPE SIZE.	CIVIL	POTHOLE DATA
															WING I
														-	-11
					1T\0102403_C-11.dwg Plotted:									SHEET _2	<u>.4</u> of

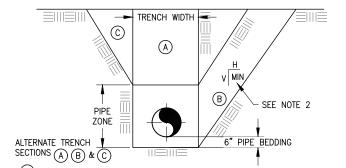

- (A) VERTICAL TRENCH WALL
- MAX UNSUPPORTED HEIGHT = 3.5 FT.
- FOR DEPTH OVER 3.5 FT SHORING OR SHEATHING REQUIRED.
- B SLOPING TRENCH WALL

ADDITIONAL

■—REMOVAL

NOTES 2 &

SECOND SAW

CUT, FULL

COMPACT EXISTING

AGGREGATE PRIOR

NEW AC PAVEMENT

SEE NOTE 5 AND 6

NEW AGGREGATE BASE

MATERIAL (TYPE "G")

TO PLACING ASPHALT

DEPTH, TYP

- NOT TO BE USED WITHOUT APPROVAL OF ENGINEER.
- REQUIRES IMPROVED PIPE ZONE BACKFILL OR INCREASE IN PIPE CLASS.
- (C) COMBINATION VERTICAL/SLOPING TRENCH TRENCH IN PIPE ZONE SHALL HAVE VERTICAL WALLS WHERE STABLE SOIL EXISTS.
- TRENCH EXCAVATIONS TO BE IN ACCORDANCE WITH OSHA SAFETY AND HEALTH STANDARDS FOR CONSTRUCTION. (29 CFR 1926).
- CONTRACTOR TO PROVIDE SHORING OR TRENCH BOX IN ROADWAY AREAS TO MINIMIZE TRENCH WIDTH.
- CONTRACTOR TO PROVIDE ALL DEWATERING MEASURES AS REQUIRED. GROUNDWATER ELEVATION SHALL BE MAINTAINED AT LEAST 2' BELOW BOTTOM OF TRENCH UNTIL BACKFILL IS COMPLETE.

2" OVERLAY MILL AS REQUIRED

LIMITS OF PAVING

SEE NOTES 2 & 4

- TRENCH

INITIAL SAW CUT,

ALL AROUND, TYP

SLIDE SLOPES SHALL MEET MINIMUM REQUIREMENTS OF THE GEOTECHNICAL

# TYPICAL TRENCH **EXCAVATION SECTION**

2'-0"

MIN



2'-0"

SEE TABLE

ADDITIONAL

REMOVAL

NOTES 2 & 3

MILL AND OVERLAY 2

INCHES OF BITUMINOUS


CONCRETE DURING OR

NFW PAVEMENT

TRENCH BACKFILL 2124

WHERE REQUIRED

AFTER INSTALLATION OF

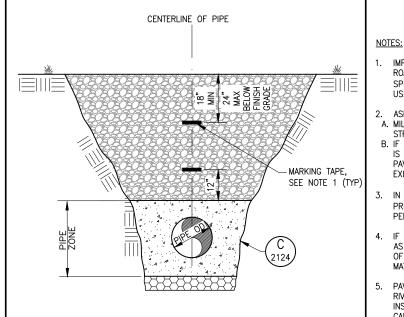

### NOTES:

1. MARKING TAPE TO BE CUSTOM TO JVWCD, SEE SPECIFICATIONS.

# MARKING TAPE PLACEMENT

2123

MATERIAL AS SHOWN.

CANNOT BE MET

OF THE PIPE ZONE.

RIVERTON CITY REQUIREMENTS. TEMPORARY ASPHALT TO BE

PEA GRAVEL AND "SQUEEGEE" ARE NOT ALLOWED IN ANY PART

INSTALLED WHEN TEMPERATURES FOR PERMANENT ASPHALT


# NOTES:

- CONTRACTOR SHALL PERMANENTLY REPLACE ALL PAVEMENT SURFACES, STRIPING, AND TRAFFIC CONTROLS IN ACCORDANCE WITH STANDARDS FOR INDIVIDUAL JURISDICTIONS PRIOR TO REMOVING DETOURS.
- REMOVE ADDITIONAL PAVEMENT TO A PAINTED LANE STRIPE, A LIP OF GUTTER, A CURB, AN EXISTING PAVEMENT PATCH, OR AN EDGE OF THE PAVEMENT IF SUCH A FEATURE IS WITHIN FIVE FEET OF THE SECOND SAW CUT. IN NO CASE SHALL ASPHALT SEAM BE PLACED IN WHEEL PATH. IF MORE THAN 50% OF THE PERMANENT SURFACING OF A TRAVELED LANE IS IMPACTED BY THE EXCAVATION, THE ENTIRE LANE WIDTH SHALL BE SAW CUT, REMOVED, AND REPLACED.
- ALL CONTRACTOR DAMAGED PAVEMENT OUTSIDE OF THE LIMITS SHOWN SHALL BE REMOVED AND REPLACED AT CONTRACTORS EXPENSE.
- AMBIENT TEMPERATURE MUST BE 45° F AND RISING IN ORDER TO PLACE ASPHALT. ASPHALT PLACEMENT SHALL BE PER THE GOVERNING AGENCIES REQUIREMENTS
- RIVERTON CITY: ASPHALT PLACED BETWEEN OCTOBER 15 AND MARCH 1 WILL BE CONSIDERED TEMPORARY ONLY, AND MUST BE REPLACED ACCORDING TO APWA STANDARDS AND SPECIFICATIONS BETWEEN THE FOLLOWING APRIL 1 AND JUNE 1.
- HERRIMAN CITY: PROVIDE A COLD WEATHER PLAN WHEN PLACEMENT DURING WEATHER <70 DEGREES F AMBIENT OR EXISTING SURFACE.
- HOT ASPHALTIC CONCRETE PAVEMENT SHALL BE PLACED IN A MINIMUM TWO LIFTS. A TACK COAT SHALL BE PLACED BETWEEN LIFTS AND ALONG ALL VERTICAL SURFACES OF EXISTING PAVEMENT.
- ASPHALT MIX DESIGN SHALL MEET LATEST VERSION OF THE GOVERNING AGENCIES CONSTRUCTION SPECIFICATIONS, SEE TABLE. MIX DESIGN MUST BE SUBMITTED AND APPROVED PRIOR TO PLACEMENT.
- SURVEY MONUMENTS MUST HAVE PERMIT THROUGH SALT LAKE COUNTY SURVEYOR PRIOR TO DISTURBANCE OR INSTALLATION OF ANY

LOCATION	UTBC THICKNESS	ASPHALT CONCRETE THICKNESS	ASPHALT TYPE	ROAD CATEGORY
13400 SOUTH	10" MIN - MATCH EXISTING	5" MIN - MATCH EXISTING	PG 64-34 DM 1/2"	HIGH TRAFFIC ROAD (CLASS III)
ROSECREST ROAD	10" MIN - MATCH EXISTING	6" MIN - MATCH EXISTING	PG 58-28 DM 1/2"	LOWER TRAFFIC ROAD (CLASS II)
LOCAL ROADS	8" MIN - MATCH EXISTING	4" MIN - MATCH EXISTING	PG 58-28 DM 1/2"	LOWER TRAFFIC ROAD (CLASS I)

# TRENCH BACKFILL AND SURFACE RESTORATION IN PAVED AREAS



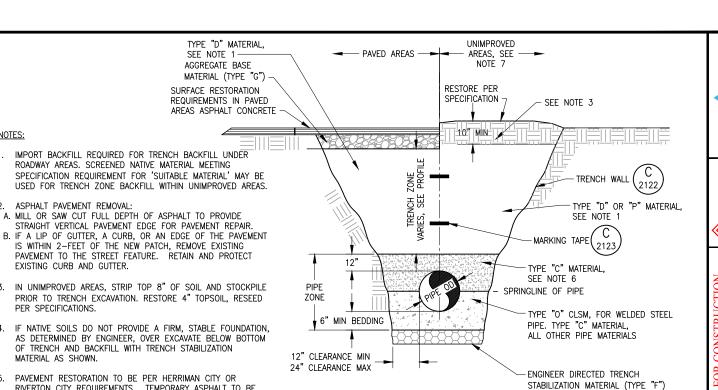

TYPICAL TRENCH BACKFILL SECTION

── WIDTH OF DUCT+8" ∠ ALL PIPES PIPE 0.D.+8" → AND CONDUITS 4" TYP -THICK EXPANSION VARIFS VARIFS JOINT FILLER MATERIA NOTF '

SECTION

ENCASE ROCK IN NON-WOVEN

2124

GEOTEXTILE FABRIC, SEE NOTE 4

# NOTES:

EXISTING PIPE OR

THICK PREFORMED

EXPANSION JOINT FILLER BETWEEN PIPE AND CLSM

TYPE "O" CLSM FULL WIDTH

DUCT

OF TRENCH

-PIPELINE

- 1. BACKFILL TO BE BROUGHT UP UNIFORMLY ON BOTH SIDES OF
- 2. CONTRACTOR SHALL BE FULLY AND SOLELY RESPONSIBLE TO DETERMINE THE REQUIREMENTS OF PROVIDING ALL TEMPORARY SUPPORTS TO SUSPEND EXISTING UTILITIES IN OR ACROSS TRENCH DURING THE CONSTRUCTION OF THE NEW PIPE AND PRIOR TO THE COMPLETION OF THIS NEW SUPPORT.

UNDERGROUND UTILITY SUPPORT 2128 ROSECREST CIVIL GENERAL O DRAWING NO. GC-01


SHEET 25 OF 78

Ö


UPGRADES

CAPACITY (

2125

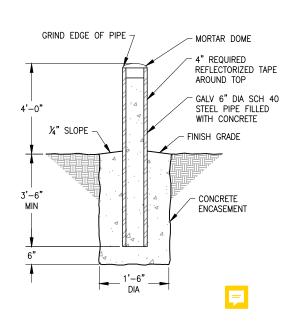


2205

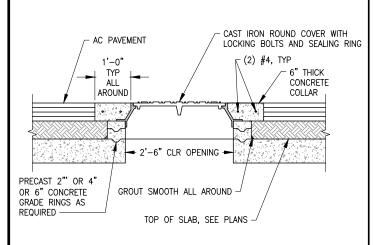


**BOLLARD** 


- SET MANHOLE COVER AND CONCRETE COLLAR '%" BELOW
  GRADE IN PAVED AREAS AND FLUSH WITH FINISH GRADE
- 2. MANHOLE TO INCLUDE CIVILI NAME CAST INTO COVER.



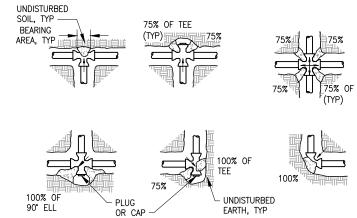

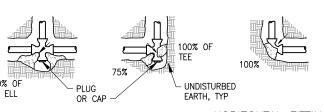




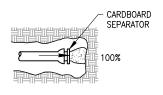

# <u>DEAD-END</u>

# NOTES: 1. ARROWS INDICATE THRUST DIRECTION

- 2. FIGURE (100%) AT THRUST BLOCK INDICATES PERCENT OF TOTAL THRUST TO BE APPLIED FOR BEARING AREA.
- 3. CONCRETE FOR THRUST BLOCKS SHALL BE 4,000 PSI.

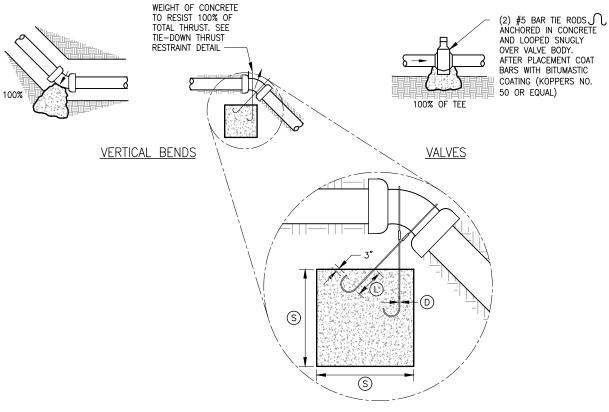

# NOTES:

- 1. THRUST BLOCKS TO BE INSTALLED IN ACCORDANCE WITH DETAIL SHOWN ABOVE.
- 2. CONCRETE MUST BE ALLOWED TO CURE IN THRUST RESTRAINTS FOR 5 DAYS PRIOR TO PRESSURIZING WATER LINES OR HAVE ADDITIONAL APPROVED THRUST RESTRAINTS INSTALLED PRIOR TO PRESSURIZING THE WATERLINE.
- 3. PRIOR TO POURING CONCRETE FOR THRUST BLOCKS, WRAP PIPE SYSTEM WITH 8 MILLIMETER THICK PLASTIC SHEET AND TAPE PER AWWA C105 TO PREVENT BONDING OF CONCRETE TO PIPE SYSTEM.
- 4. VALUES PROVIDED ASSUME AT LEAST 4' OF COVER SOIL BEARING STRENGTH OF 1,500 PSF, AND TEST PRESSURE OF 200 PSI.
- 5. RESTRAINED LENGTH GIVEN FOR BENDS REPRESENTS THE RESTRAINED LENGTH REQUIRED FOR EACH SIDE OF BEND.
- 6. CONTRACTOR SHALL INSTALL THRUST RESTRAINT AT ALL FITTINGS PRIOR TO PRESSURIZING THE WATER LINE. IN ALL AREAS WHERE THE PIPELINE WILL NOT BE PRESSURIZED FOR 5 DAYS, CONTRACTOR SHALL HAVE THE OPTION OF USING RESTRAINED PIPE LENGTHS OR CONCRETE THRUST BLOCKS IN ACCORDANCE WITH THE TABLES ABOVE. WHERE THE NEW LINES WILL CONNECT TO EXISTING WATER MAINS, MECHANICAL THRUST RESTRAINTS AND THRUST BLOCKS WILL BE REQUIRED TO ALLOW THE NEW PIPELINE TO BE PUT INTO SERVICE IMMEDIATELY AFTER ACCEPTANCE.

# REQUIRED LENGTH OF RESTRAINED PIPE FOR VARIOUS FITTINGS (FT)

	POLY-WRAPPED DUCTILE IRON								
PIPE SIZE	DEAD END OR TEE	90° ELBOW	45° ELBOW	22½° ELBOW					
4"	46	18	27	4					
6"	66	26	39	5					
8"	84	32	49	7					
10"	105	39	61	8					
12"	122	45	71	9					
14"	142	52	83	11					
16"	160	58	93	12					
18"	179	64	104	13					
20"	196	69	113	14					

MINIMUM BEARING AREA OF CONCRETE THRUST BLOCKS FOR VARIOUS FITTINGS (FT <sup>2</sup> )								
PIPE SIZE	DEAD END OR TEE	90° ELBOW	45* ELBOW	22½* ELBOW	111/4° ELBOW			
4"	4	6	3	2	1			
6"	8	11	6	3	2			
8"	13	19	10	5	3			
10"	20	28	15	8	4			
12"	28	39	21	11	6			
14"	37	52	29	15	8			
16"	48	68	37	19	10			
18"	60	85	46	24	12			
20"	74	104	57	20	15			

80

41

21

148

105

24"

TIE-DOWN (GRAVITY)	THRUST RESTRAINT FOR	45° VERTICAL BENDS	TABLE OF DIMENSIONS
PIPE SIZE	VOLUME OF BLOCK (CF)	DIA OF SHANK OR REBAR RODS	DEPTH OF ROD
	S	D	(L)
4"	29	5%"	2.0
6"	60	%"	2.5
8"	102	5 <sub>8</sub> "	3.0
10"	153	%"	3.0
12"	217	%"	4.0
14"	292	34"	4.0
16"	377	34"	4.0
20"	581	34"	4.0

CONCRETE THRUST BLOCKS



(ge)		


JORDAN VALLEY WATER CONSERVANCY DISTRICT
ROSECREST PIPELINE CAPACITY UPGRADES
HERRIMAN AND RIVERTON CITY IT


CIVIL 3-2

GENERAL O

DRAWING NO. GC-02

SHEET <u>26</u> OF <u>78</u>

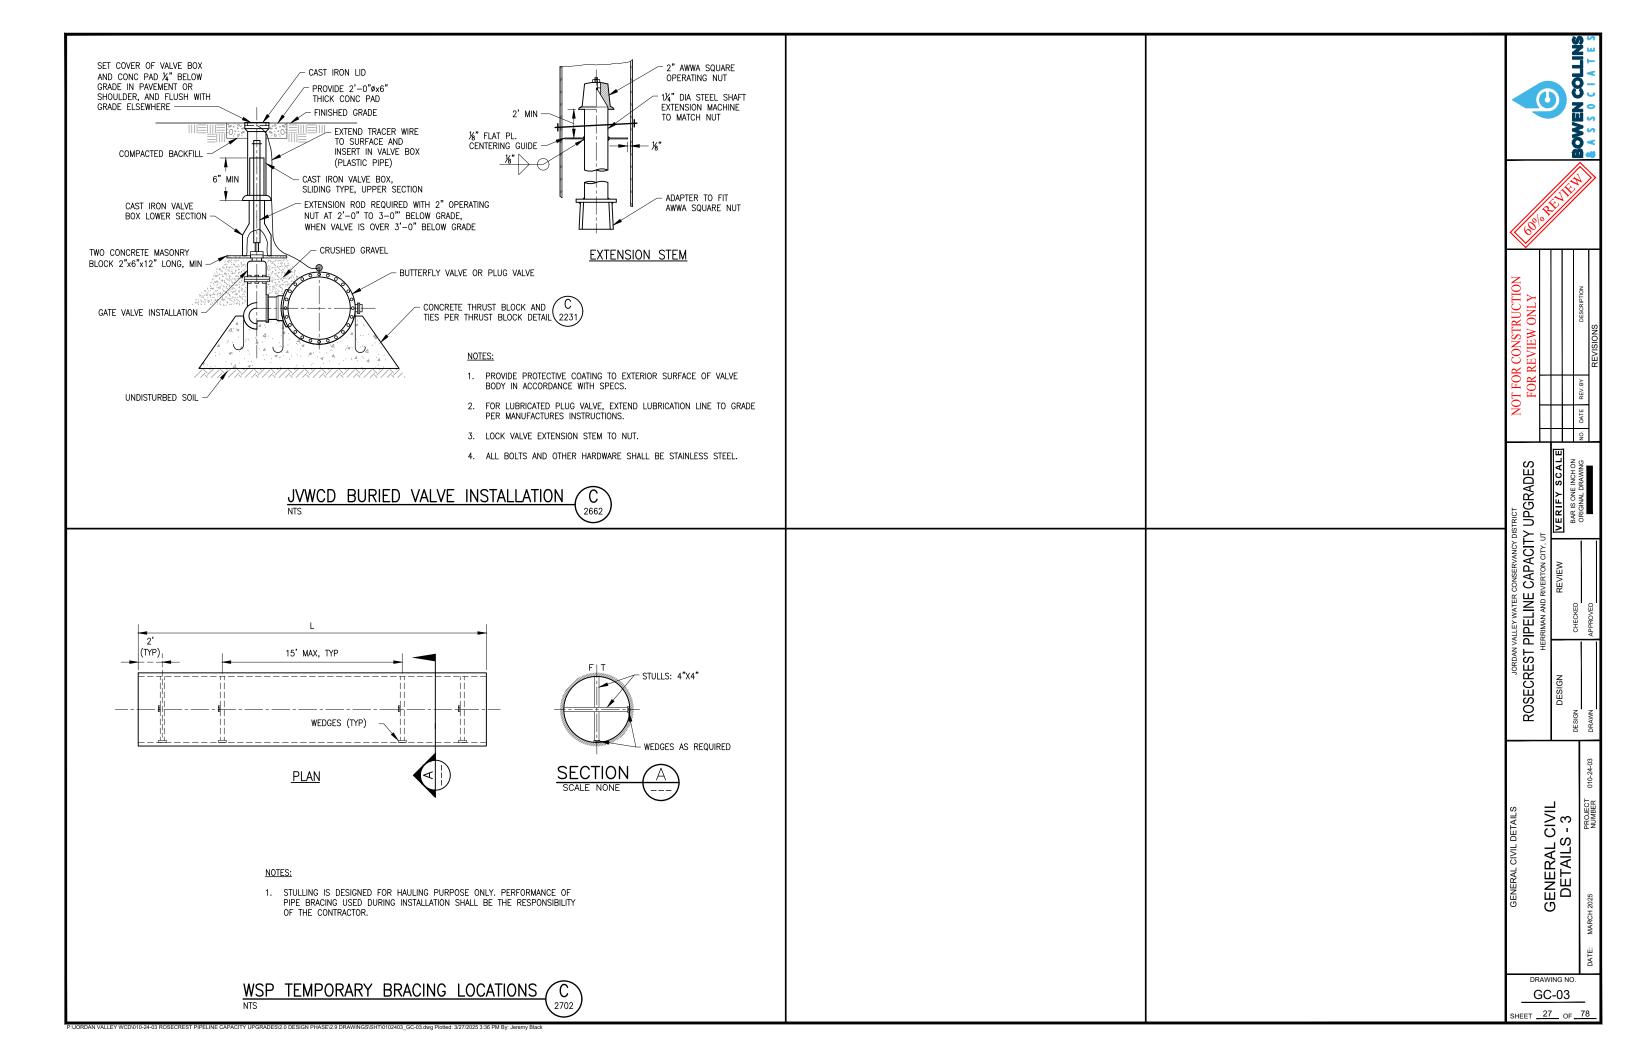

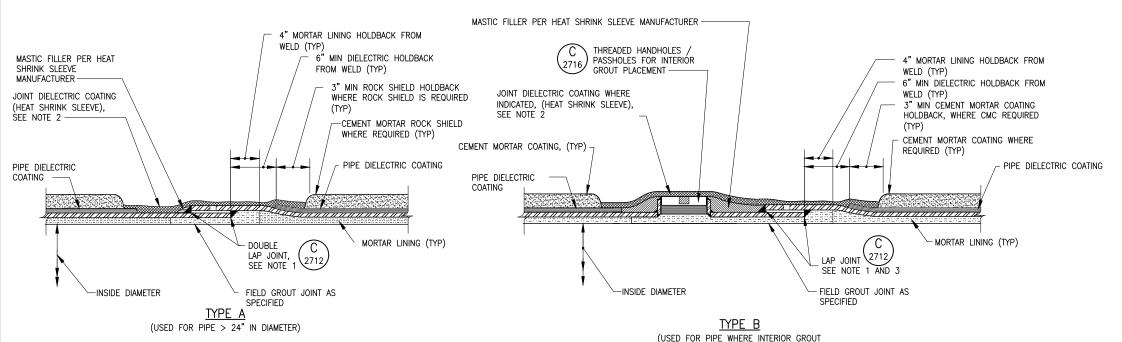

### NOTES:

- WHERE DOUBLE LAP WELDED JOINTS ARE REQUIRED, CONTRACTOR SHALL CONDUCT AN AIR/SOAP SOLUTION LEAK TEST AT 40 PSI AIR PRESSURE IN ADDITION TO DYE PENETRATE OR MAGNETIC PARTICLE TESTING AS REQUIRED BY SPECIFICATIONS. IF LEAKS ARE DETECTED, THE CONTRACTOR SHALL REPAIR AND RETEST THE WELDS UNTIL THERE ARE NO DEFECTS. PLUG TAPS WITH THREADED PLUG AND SEAL WELD PLUG AT COMPLETION OF TEST AND COAT AND LINE AS SHOWN OR SPECIFIED. TAP HOLES MAY BE ON INSIDE OR OUTSIDE
- AFTER INSTALLATION OF JOINT DIELECTRIC COATING, A HOLIDAY TEST SHALL BE COMPLETED AS SPECIFIED BY NACE CERTIFIED
- WHERE SINGLE LAP WELDED JOINTS ARE REQUIRED, WELD MAY BE ON INSIDE OR OUTSIDE OF JOINT. AIR/SOAP LEAK TEST IS NOT REQUIRED AND WELD TO BE INSPECTED PER SPECIFICATIONS.
- JOINTS ONLY FOR PIPE WITH LESS THAN 24" DIAMETER TO BE TYPE B TO ALLOW CONTRACTOR DIFFERENT METHODS OF INTERIOR LINING GROUT REPLACEMENT.

STEEL PIPE BEYOND

BACKING PLATE



	<u> </u>			
NOT FOR CONSTRUCTION FOR REVIEW ONLY			DESCRIPTION	REVISIONS
OT FO FOR			REV. BY	
N			DATE	
			NO.	

JORDAN VALLEY WATER CONSERVANCY DISTRICT
ROSECREST PIPELINE CAPACITY UPGRADES
HERRIMAN AND RIVERTON CITY, UT

CIVIL 3 - 4

GENERAL O

DRAWING NO.


GC-04 SHEET 28 OF 78

# LAP WELDED STEEL PIPE JOINT C

LINING PLACED VIA HANDHOLES) SEE NOTE 4

### NOTES:

- DIMENSION "A" CORRESPONDS TO THE COMPLETED JOINT OVERLAP AFTER WELDING. DIMENSION "A" SHALL BE 3" MINIMUM FOR STANDARD JOINTS. FOR SPECIAL TEMPERATURE CONTROL JOINTS, THE DIMENSION "A" JOINT OVERLAP SHALL BE INCREASED BY 3 INCHES AS FURTHER DISCUSSED IN NOTE 3.
- FOR STANDARD JOINTS THE MINIMUM DIMENSION "B" SHALL BE AS REQUIRED TO PROVIDE THE MINIMUM OVERLAP DIMENSION "A" AND MAINTAIN THE INDICATED HOLDBACK FOR THE WELD.
- FOR SPECIAL TEMPERATURE CONTROL JOINTS, THE MINIMUM DIMENSION "B" SHALL BE INCREASED BY AT LEAST 3 INCHES. AT THE TIME OF INSTALLATION AND PRIOR TO WELDING, THE SPIGOT SHALL BE INSERTED INTO THE LENGTHENED BELL TO PROVIDE "A" +3 INCHES MINIMUM JOINT OVERLAP. SEE SPECIFICATIONS FOR SPECIAL TEMPERATURE CONTROL JOINT WELDING REQUIREMENTS.
- FILLET WELDS FOR BELL AND SPIGOT LAP JOINTS SHOWN. FILLET WELDS ON OTHER JOINTS SIMILAR
- CONTRACTOR SHALL CONDUCT AN AIR/SOAP SOLUTION LEAK TEST AT 40 PSI AIR PRESSURE IN ADDITION TO DYE PENETRATE OR MAGNETIC PARTICLE TESTING AS REQUIRED BY SPECIFICATIONS. IF LEAKS ARE DETECTED, REPAIR AND RETEST UNTIL THERE ARE NO DEFECTS. PLUG TAPS WITH THREADED PLUG AND SEAL WELD PLUG AT COMPLETION OF TEST AND COAT AND LINE AS SHOWN OR SPECIFIED. TAP HOLES MAY BE ON INSIDE OR OUTSIDE OF JOINT.
- THE JOINTS SHALL BE FABRICATED AND INSTALLED TO BE WITHIN THE TOLERANCES INDICATED. THE TOLERANCE REQUIREMENTS SHALL APPLY TO BOTH WELDS AND TO BOTH STRAIGHT AND DEFLECTED JOINTS.
- LAP JOINTS SHALL BE DOUBLE LAP, UNLESS NOTED OTHERWISE. SINGLE LAP JOINTS SHALL BE INSIDE OR OUTSIDE AT CONTRACTORS OPTION. REFER TO SPECIFICATIONS FOR SPECIAL REQUIREMENTS.

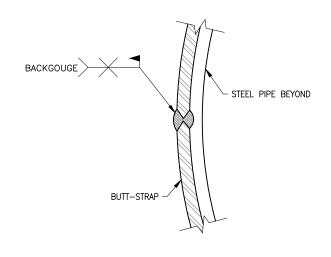

NOTES:

1. LININGS AND COATINGS ARE NOT SHOWN FOR CLARITY.

TYPE A (USED FOR PIPE > 36" Ø ACCESS TO

BOTH INSIDE AND OUT)

1. LININGS AND COATINGS ARE NOT


NOTES:

BUTT-STRAP

TYPE B

(USED FOR PIPE ≤ 36" Ø ACCESS TO OUTSIDE ONLY)

**BUTT-STRAP WELD** 

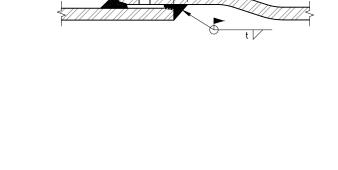

- B NOTE 2&3

NOTE 1

MIN

- POINT OF TANGENCY OF BELL RADIUS

(LAP JOINT)


1/4" NPT TAP FOR


AIR/SOAP TEST, TWO

SEPARATION, SEE NOTE

REQUIRED AT 180°


JOINT WELD

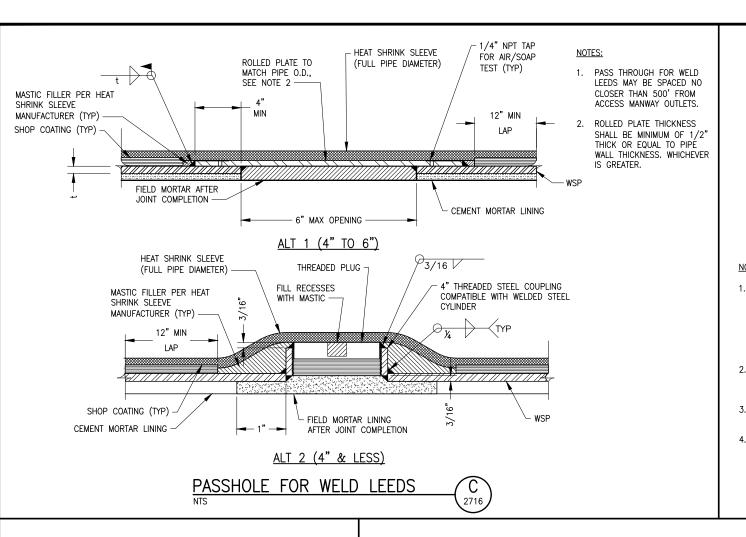

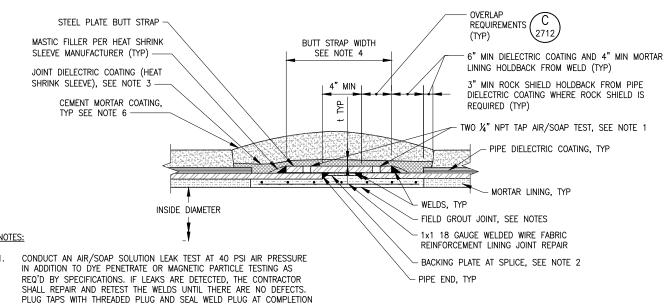

- GROUT FOR JOINT LINING SHALL BE ONE PART CEMENT TO TWO PARTS SAND AND SUFFICIENT WATER FOR DRY-PACK CONSISTENCY.
- CEMENT MORTAR COATING (GROUT DIAPERS) NOT REQUIRED ON DIELECTRICALLY COATED PIPE. UNLESS OTHÉRWISE NOTED ON PLANS.

EXTERIOR BUTT-STRAP JOINT

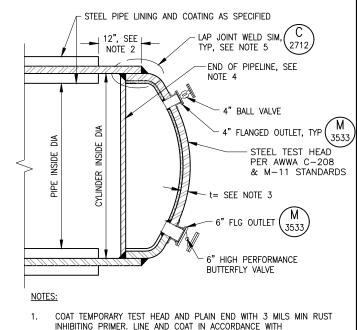

FOR STATION AND LOCATION OF PIPELINE ENDS, SEE DRAWINGS.

BE SUBSTITUTED FOR LAP JOINT SHOWN.

DISH HEAD END CAP

BUTT STRAP CONNECTION, OR FULL PENETRATION BUTT WELDS MAY

STA XX+XX.XX (HORIZONTAL CURVE) Δ H (HORIZONTAL DEFLECTION ANGLE) N (NORTHING COORDINATE) H ← E (EASTING COORDINATE) HORIZONTAL CURVES DISTANCE BETWEEN VPI SLOPE BETWEEN VPI VPI (VERTICAL CURVE)

2728

VERTICAL CURVES

HORIZONTAL AND VERTICAL CURVES SHALL BE MADE USING BEVELED JOINTS AND/OR DEFLECTED JOINTS. DO NOT USE COMBINED BEVELED AND DEFLECTED JOINTS.

OF TEST AND COAT AS SHOWN OR SPECIFIED. TAP HOLES MAY BE ON

FOR FIELD WELDING OF INDIVIDUAL BUTT STRAP PIECES TO EACH OTHER USING BUTT WELDS, SEE  $\bigcirc$ 

AFTER INSTALLATION OF JOINT DIELECTRIC COATING, A HOLIDAY TEST

SHALL BE COMPLETED AS SPECIFIED BY NACE CERTIFIED SPECIALIST.

UNLESS OTHERWISE NOTED, BUTT STRAP WIDTH SHALL CONFORM TO THE LIMITATIONS SHOWN FOR PIPE END SEPARATION AND STEEL OVERLAP

INSIDE OR OUTSIDE OF JOINT.

NOTES:


CIRCULAR.

REQUIREMENTS.

THE MAXIMUM BEVEL ANGLE FOR BEVELED PIPE ENDS SHALL BE 5 DEGREES. SEE SPECIFICATIONS FOR MAXIMUM (NON-BEVELED) JOINT DEFLECTIONS.

ALL HORIZONTAL AND VERTICAL CURVES ARE

- ALL BEVEL OR DEFLECTION ANGLES SHALL BE EQUALLY DIVIDED THROUGHOUT THE CURVE.
- FOR COMBINATION VERTICAL AND HORIZONTAL CURVES THE REQUIREMENTS FOR BOTH CONDITIONS SHALL BE COMBINED.
- REFER TO PLAN AND PROFILE DRAWINGS FOR VERTICAL AND HORIZONTAL CURVE LOCATIONS.
- 50' PIPE LENGTHS WERE ASSUMED TO DEVELOP VERTICAL CURVE DATA SHOWN ON PLANS. COORDINATE WITH ENGINEER IF DIFFERENT.
- ALL PROFILE ELEVATIONS ARE SHOWN TO
- REDUCED PIPE SEGMENTS LENGTHS MAY BE USED IN LIEU OF BEVELED OR MITERED JOINTS THROUGH CURVES. COORDINATE SHOP DRAWINGS WITH

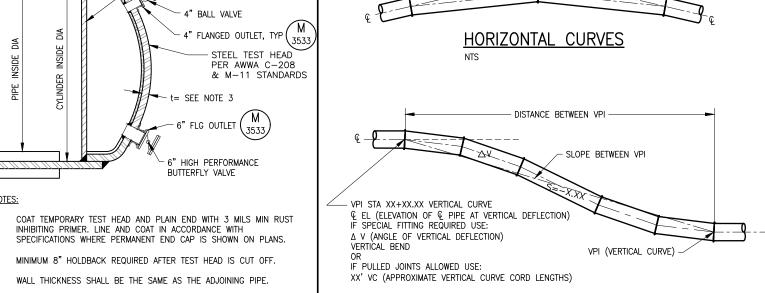


PIPELINE CURVES

o o UPGRADES CAPACITY ( JORDAN VALLEY WATER C ROSECREST PIPELINE HERRIMAN AND RY CIVII GENERAL DETAILS GC-05 SHEET 29 OF 78

2726




- 1. SEQUENCE FOR TESTING NEW CONNECTIONS TO THE EXISTING PIPELINE:
  - A) INSTALL TEST HEAD ON NEW PIPE.
  - B) TEST AND DISINFECT NEW PIPE IN ACCORDANCE WITH SPECIFICATIONS. TO REMAIN,
  - C) COORDINATE WITH JVWCD FOR SHUTDOWN REQUIREMENTS. DEWATER EXISTING PIPELINE AND REMOVE EXISTING DISHHEAD AT CONNECTION LOCATIONS WHERE REQUIRED BY PLAN. SEE SPECIFICATIONS.
  - D) CONNECT THE EXISTING PIPE TO THE NEW PIPE USING CLOSURE SECTIONS AS SHOWN, PER PLAN.
  - E) TEST JOINTS AS REQUIRED.
  - F) INSTALL FIELD APPLIED LININGS AND COATINGS AT THE CLOSURE SECTION
  - G) DISINFECT CONNECTION FITTING AND SURROUNDING PIPELINE. COORDINATE WITH JVWCD TO RETURN PIPELINE TO SERVICE.
  - H) CONCRETE ANCHOR BLOCK TO CURE MINIMUM 48 HRS PRIOR TO RETURNING PIPELINE TO SERVICE
- FIELD VERIFY OUTSIDE DIAMETER, GEOMETRY, MATERIAL, ALIGNMENT OF EXISTING PIPE AND FIELD VERIFY DIMENSIONS AND ANGLES OF FITTING PRIOR TO FABRICATION OF NEW CONNECTION FITTINGS.
- FIELD LOCATION AND CONNECTION DETAILS SHALL BE INCLUDED WITH THE SHOP DRAWINGS SUBMITTALS. FOLLOWING THE INSTALLATION OF THE CLOSURE SECTION, THE CONTRACTOR SHALL BACKFILL THE NEW AND EXISTING PIPELINE AND RESTORE THE GROUND SURFACE.
- GENERAL CONFIGURATION SHOWN IN THIS DETAIL, SEE DRAWINGS FOR EACH SPECIFIC LOCATION.
- 5. REFER TO SPECIFICATIONS FOR SCHEDULE CONSTRAINTS REGARDING CONNECTION TO EXISTING PIPELINE.
- 6. REINFORCE CONNECTION PER AWWA C-208 & M-11.
- INSTALL DISH HEAD A MINIMUM OF 10 FT AWAY FROM EXISTING PIPELINE FOR TESTING.

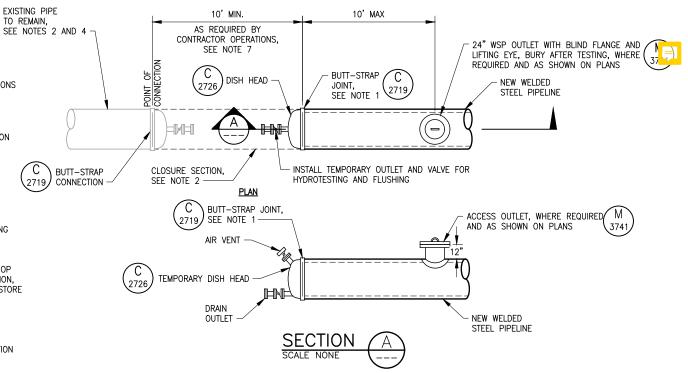

FINAL TIE-IN CONNECTION TO EXISTING PIPELINE C 2738



- . DIMENSION 'A' IS A MINIMUM DIMENSION ONLY. ACTUAL VAULT HEIGHTS VARY BY LOCATION, SEE PLAN AND PROFILE DRAWINGS. VAULT HEIGHTS FOR EACH VAULT TO BE THE GREATER OF MINIMUM DIMENSION 'A' OR THE HEIGHT NECESSARY TO RAISE VAULT TO FINISH GRADES SHOWN ON PLAN AND PROFILE DRAWINGS.
- SEE PLAN AND PROFILE DRAWINGS FOR LOCATION OF MANHOLE AND VALVE IDENTIFICATION TO INDICATE VALVE REQUIREMENTS PER MECHANICAL SCHEDULE ON M-03.
- CONCRETE: CLASS 4000.
   REINFORCEMENT: DEFORMED 60 KSI YIELD GRADE STEEL, ASTM A615.
   BACKFILL: COMMON FILL, MAXIMUM PARTICLE SIZE 2—INCHES.
   BASECOURSE: COMPACTION 95% OR GREATER, MODIFIED PROCTOR
   DENSITY.
- COATING OF PIPE IN STRUCTURE TO BE TRENTON WAX TAPE, SYSTEM NO. 2 PER SPECIFICATIONS.

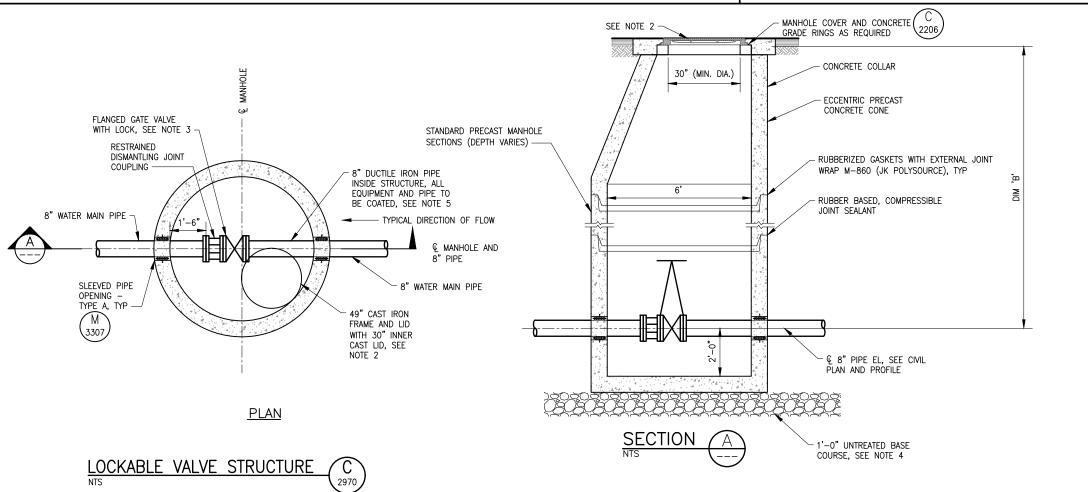

CAPACITY UPGRADES


JORDAN VALLEY WATER C ROSECREST PIPELINE HEBRIMAN AND RIV


> CIVIL 5-6


GENERAL O


DRAWING NO.


GC-06 SHEET 30 OF 78

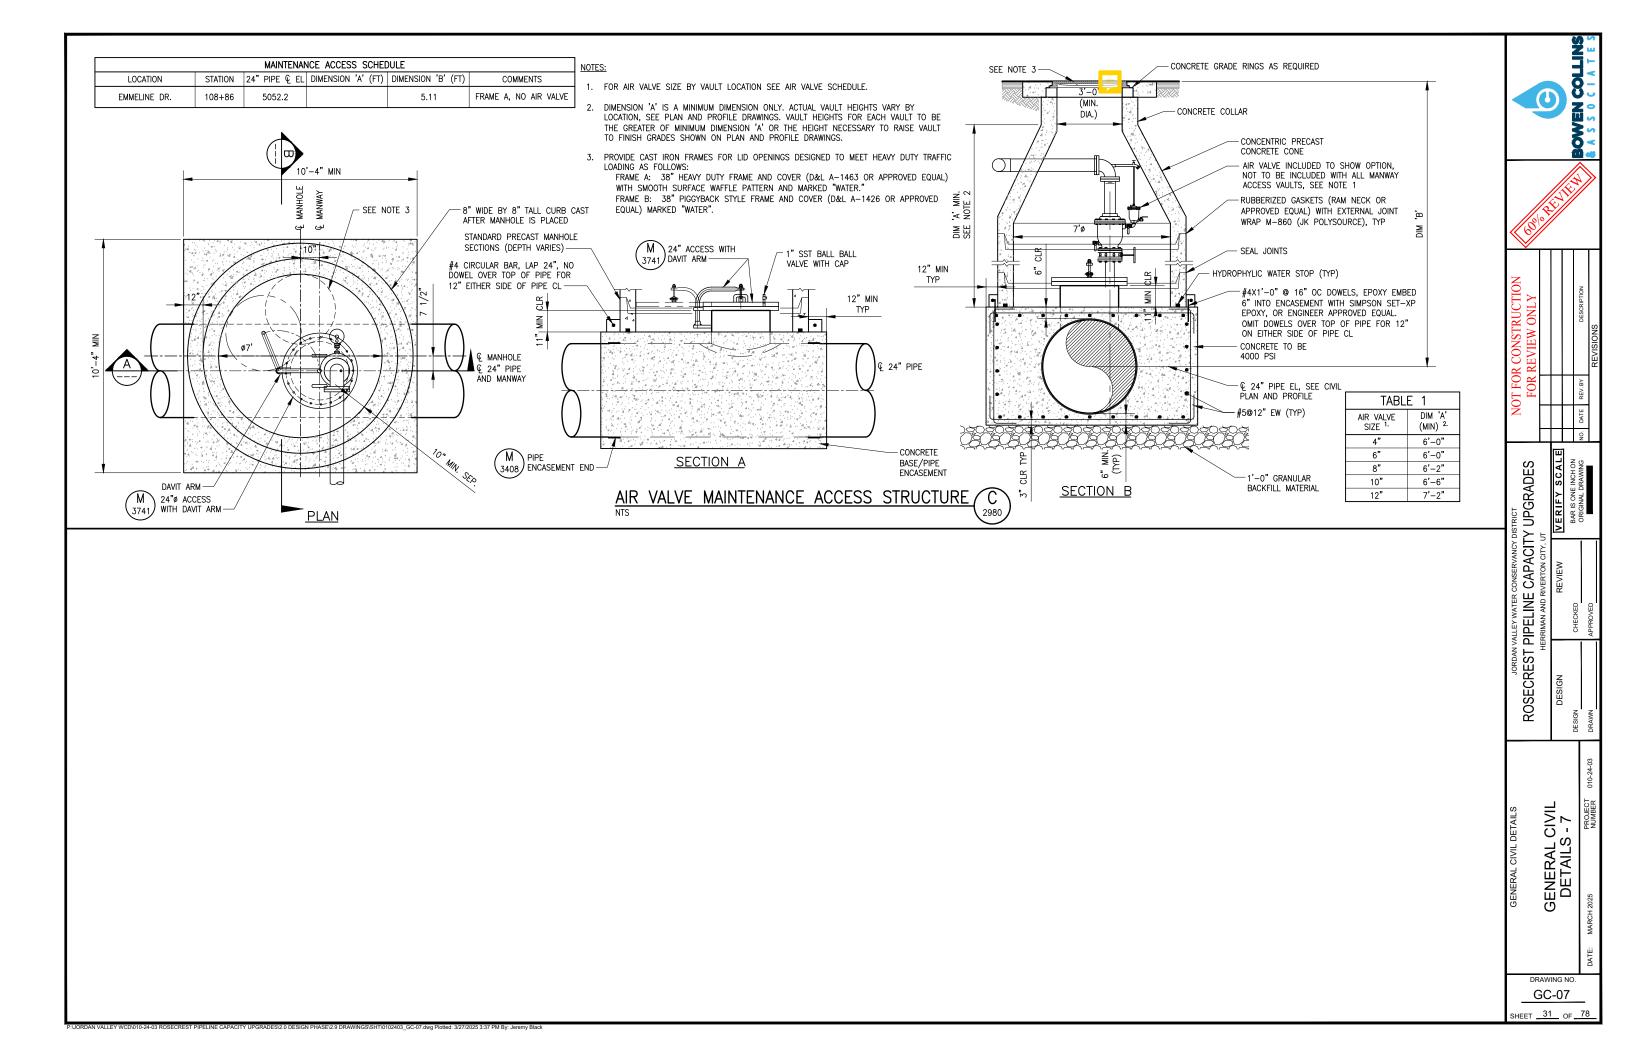


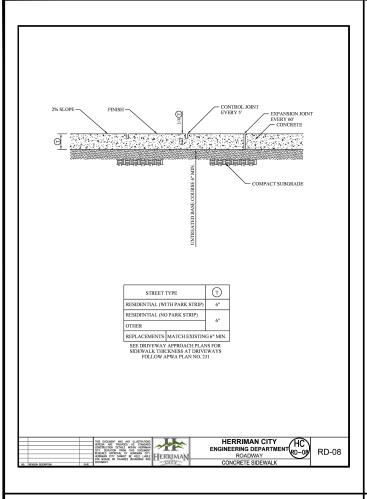


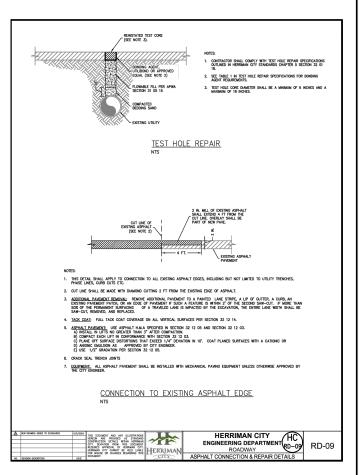


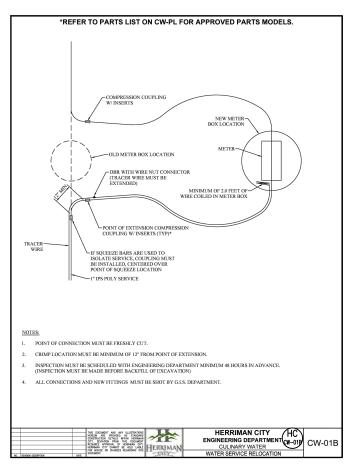

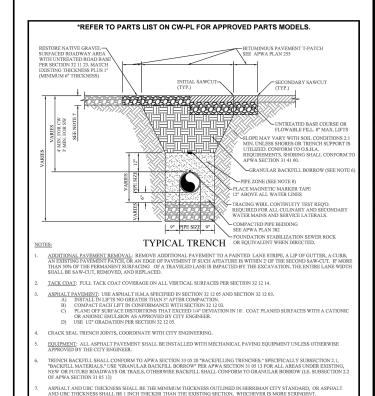

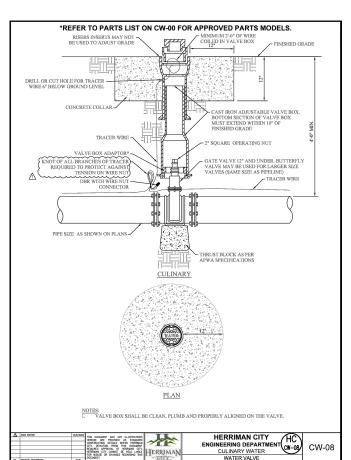

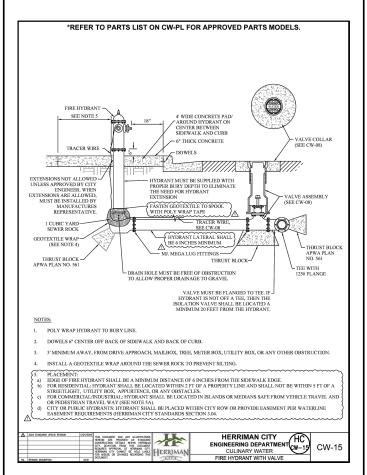

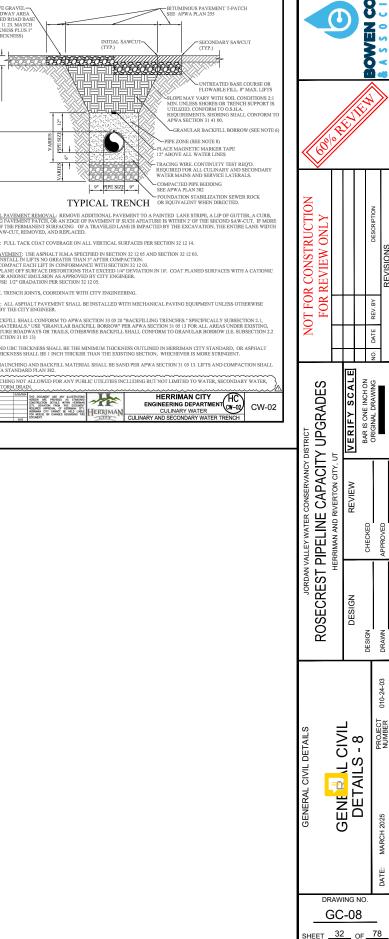

# CATHODIC PROTECTION GENERAL **NOTES**

USE POST MOUNT STYLE UNLESS OTHERWISE SPECIFIED.

- MARK POST MOUNT STYLE STATIONS WITH UTILITY APPROVED LABEL MARKER ON POST, SEE SPECIFICATIONS.
- PROVIDE WIRE LOOP AT BASE OF TEST STATION AND AT PIPE CONNECTIONS TO MINIMIZE SETTLEMENT STRESSES ON WIRE.
- USE STANDARD COLOR CODE AS SHOWN ON DETAILS AND AS FOLLOWS: WHITE - DISTRICT PIPELINE

GREEN - UNPROTECTED PIPELINE BLUE - INSULATION

ORANGE - CASING RED - FOREIGN/GAS CROSSING YELLOW - REFÉRENCE ELECTRODE

BLACK - ANODES

- ALL TEST STATION WIRES TO BE INSTALLED SPLICE FREE.
  IN UNDEVELOPED OR CULTIVATED AREAS, BURY WIRES A MINIMUM OF 30—INCHES OR PLACE IN RIGID CONDUIT, SEE OFFSET TEST STATION DETAIL FOR CONDUIT
- ALL TEST WIRE CONNECTIONS TO PIPE SHALL BE THERMITE WELDED CONNECTIONS, INDIVIDUAL WIRES SHALL BE CONNECTED TO PIPE WITH A MINIMUM OF 6-INCHES SEPARATION.
- QUANTITY OF TERMINALS AND WIRING CONNECTIONS VARIES, SEE APPLICABLE TEST STATION TYPE.
- ALL WIRES UNDER ROADWAY MUST BE PROTECTED BY PVC COATED STEEL CONDUIT AS SHOWN IN DETAIL, SEAL ENDS OF PIPE DUCT COMPOUND OR URETHANE FOAM, PROVIDE 2" CONDUIT FOR WIRES ONLY, DO NOT CONNECT ROADWAY CONDUIT TO TEST STATION CONDUIT.
- 10. CONFIRM LOCATION OF TEST STATIONS WITH OWNER AND ENGINEER IN THE FIELD PRIOR TO INSTALLATION. TEST STATIONS PLACED IN UNAPPROVED LOCATIONS WILL BE MOVED AT THE CONTRACTOR'S EXPENSE.

# ELECTRICAL CONTINUITY

- 1. ALL BURIED OR VAULT JOINTS SHALL BE BONDED FOR ELECTRICAL
- PROVIDE TWO BONDS, MINIMUM, ON EACH JOINT UNLESS SPECIFIED
- OTHERWISE FOR PIPE DIAMETER. SEE SPECIFICATIONS.

  3. FLEXIBLE COUPLINGS, FLANGE COUPLING ADAPTERS, OR DEPEND—O—LOC JOINTS SHALL BE BONDED SIMILAR TO FLEXIBLE JOINT.
- BURIED OR VAULT FLANGE JOINTS SHALL BE BONDED.

### **ELECTRICAL ISOLATION:**

- PROVIDE INSULATING JOINTS IN PIPELINE WHERE INDICATED ON THE DRAWINGS.
- TEST ALL INSULATING JOINTS FOR ELECTRICAL ISOLATION BEFORE PIPE IS BACKFILLED AS SPECIFIED.
- ALL MISCELLANEOUS PIPING AND ELECTRICAL CONDUITS TO BE ELECTRICALLY ISOLATED FROM PIPES.
- MAINTAIN AND VERIFY ELECTRICAL ISOLATION BETWEEN PIPING AND STEEL VAULT REINFORCEMENT.

PIPE LINE PLAN AND PROFILE TEST


STATION LEGEND

EXST TEST STATION

NEW TEST STATION


X=TYPE

	TEST STATION SCHEDULE							
PIPE	STATION	STYLE	TYPE	OFFSET	COMMENTS	SHEET		

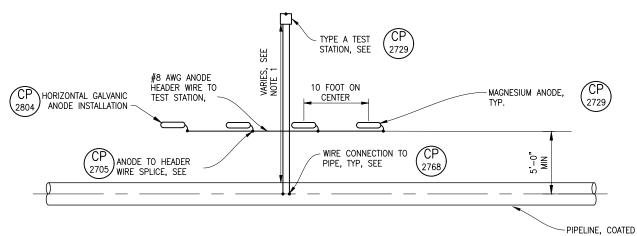

GALVANIC ANODE GROUNDBED PLAN (CF

- NOTES:
  1. FOR TYPE A TEST STATION LOCATIONS SEE TEST STATION SCHEDULE.
- 2. PLACE TEST STATION OVER PIPE CENTERLINE, OFFSET ONLY IF SHOWN OTHERWISE IN
- BURY HEADER WIRE 2.5-FEET DEEP MINIMUM, 36-INCHES IN CULTIVATED FIELDS.
- 4. WATER ANODES AFTER BACKFILLING TO 12-INCHES ABOVE ANODE

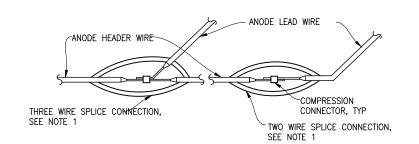

- FOR THREE WIRE SPLICE CONNECTION, USE 3M SCOTCHCAST WYE RESIN SPLICE KIT. FOLLOW PRODUCT MIXING AND APPLICATION PROCEDURES.
- FOR TWO WIRE SPLICE CONNECTION, USE 3M SCOTCHCAST INLINE RESIN SPLICE KIT. FOLLOW PRODUCT MIXING AND APPLICATION PROCEDURES.
- 3. DETAIL SIMILAR FOR ANODE HEADER WIRE SPLICES, SIZE COMPRESSION CONNECTORS AS

GALVANIC ANODE WIRE SPLICES






JORDAN VALLEY WATER CONSERVANCY DISTRICT
ROSECREST PIPELINE CAPACITY UPGRADES
HERRIMAN AND RIVERTAN CITY ...

CATHODIC PROTECTION SCHEDULES, GENERAL NOTES, AND DETAILS - 1

DRAWING NO.

CP-01 SHEET 33 OF 78

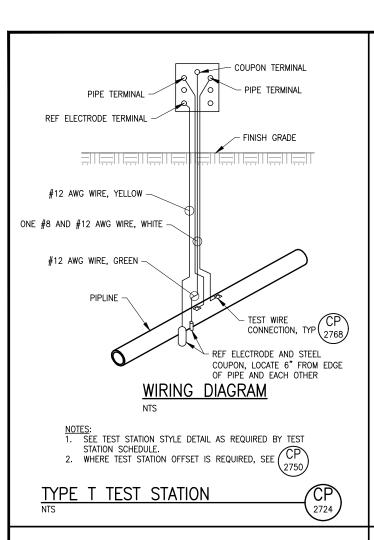

- CURB

ROADWAY


<u>⅓"</u> PER FT. 12"


WIRE LOOP

POLYURETHANE FOAM.

INSTALLATION

PIPELINE

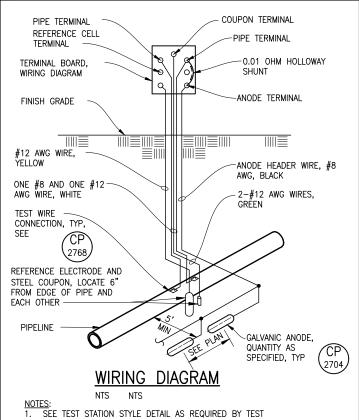


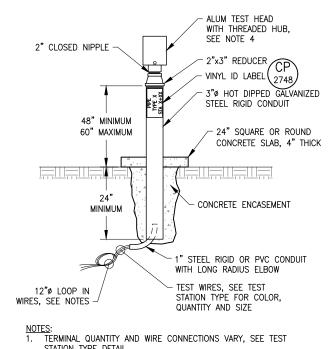

- STATION TYPE DETAIL.
- LOOP WIRE AT BASE OF POST TO MINIMIZE WIRE STRESS COAT THREADS WITH INORGANIC ZINC PRIMER OR COLD GALVANIZING REPAIR COATING
- TESTOX SERIES 700 TEST STATION FOR TYPE T, C, AND I TEST STATIONS OR TESTOX SERIES 2000 TEST STATION FOR TYPE F AND A TEST STATIONS WITH THREADED HUBS.
- SLIP FIT HUBS WILL NOT BE PERMITTED.



%"ø STEEL ROD, CUT TO LENGTH

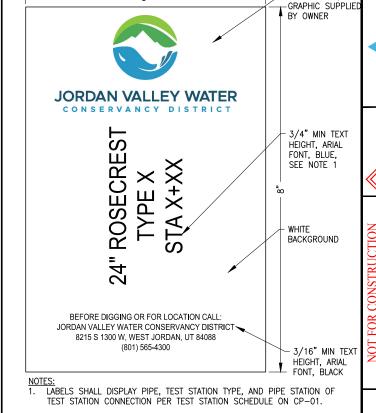



Y = FLG DIFFERENTIAL + 1" MIN

<u>STEEL FLAT BAT BOND</u>

DIMENSIONS:

 $X = FLG \ Q \ WIDTH$ 



JVWCD LOGO,

CAPACITY UPGRADES

Ö

JORDAN VALLEY WATER O ROSECREST PIPELINE

CATHODIC PROTECTION DETAILS - 2


CP-02 SHEET 34 OF 78

#2 AWG STRANDED #10 AWG STRANDED WIRE WIRE, HMWPE PIGTAIL, HMWPE, TYP OF 2 INSULATION WELD, TYP

STATION SCHEDULE.

2. WHERE TEST STATION OFFSET IS REQUIRED, SEE

TYPE A TEST STATION

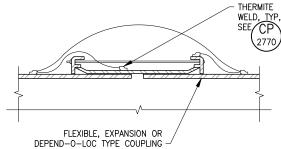

- COUPLING JOINT SHOWN, SIMILAR FOR RESTRAINED JOINTS, DEPEND-O-LOC, FLANGED ADAPTERS, AND OTHER TYPE DISMANTLING JOINTS.
- 2. INSTALL TWO BONDS AT EACH JOINT, MINIMUM, SEE SPECS FOR QUANTITY REQUIRED FOR PIPEØMETER.
- 3. SEE THERMITE WELD DETAIL FOR COATING REQUIREMENTS.


COUPLING JOINT BOND



2729

THERMITE

2770

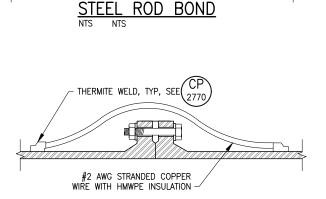

WIRE BOND NTS NTS

- NOTES:

  1. CONTRACTOR MAY INSTALL EITHER STEEL ROD, STEEL FLAT BAR, OR BOND WIRE AS SHOWN, EXCEPT WHERE ARC WELDING TO FLANGE IS NOT
- INSTALL TWO BONDS AT EACH JOINT, MINIMUM, SEE SPECS FOR QUANTITY REQUIRED FOR PIPE DIAMETER.
- COAT STEEL ROD OR FLAT BAR AND WELDS WITH FAST CURE EPOXY (BURIED) OR WITH COATING SYSTEM TO MATCH PIPE (VAULT).
- FOR WIRE BONDS, SEE THERMITE WELD DETAIL FOR COATING
- REQUIREMENTS. PROVIDE SST FLAT BAR IN LIEU OF STEEL WHERE COATING CANNOT BE PROPERLY APPLIED TO INTERIOR SURFACES.

2767

BURIED FLANGE JOINT BOND NTS NTS

TEST STATION ROADWAY OFFSET

NOTES:

1. DO NOT CONNECT CONDUIT TO POST STYLE TEST STATION.

SEE PLANS FOR LOCATIONS OF TEST STATIONS. VERIFY

SEAL BOTH ENDS OF CONDUIT WITH DUCT COMPOUND OR

BURIED CONDUIT TO BE RIGID PVC COATED STEEL.

LOCATION WITH OWNER AND ENGINEER PRIOR TO

2750

POST MOUNT STYLE, SEE NOTE 4 CP

1" PVC SWEEP ELBOW,


TYP EACH END, SEE NOTE 1


SIDEWALK

PVC COATED STEEL CONDUIT FOR OPEN CUT, 1-1/2" HDPE CONDUIT FOR

HORIZONTAL DIRECTIONAL DRILLING

2747

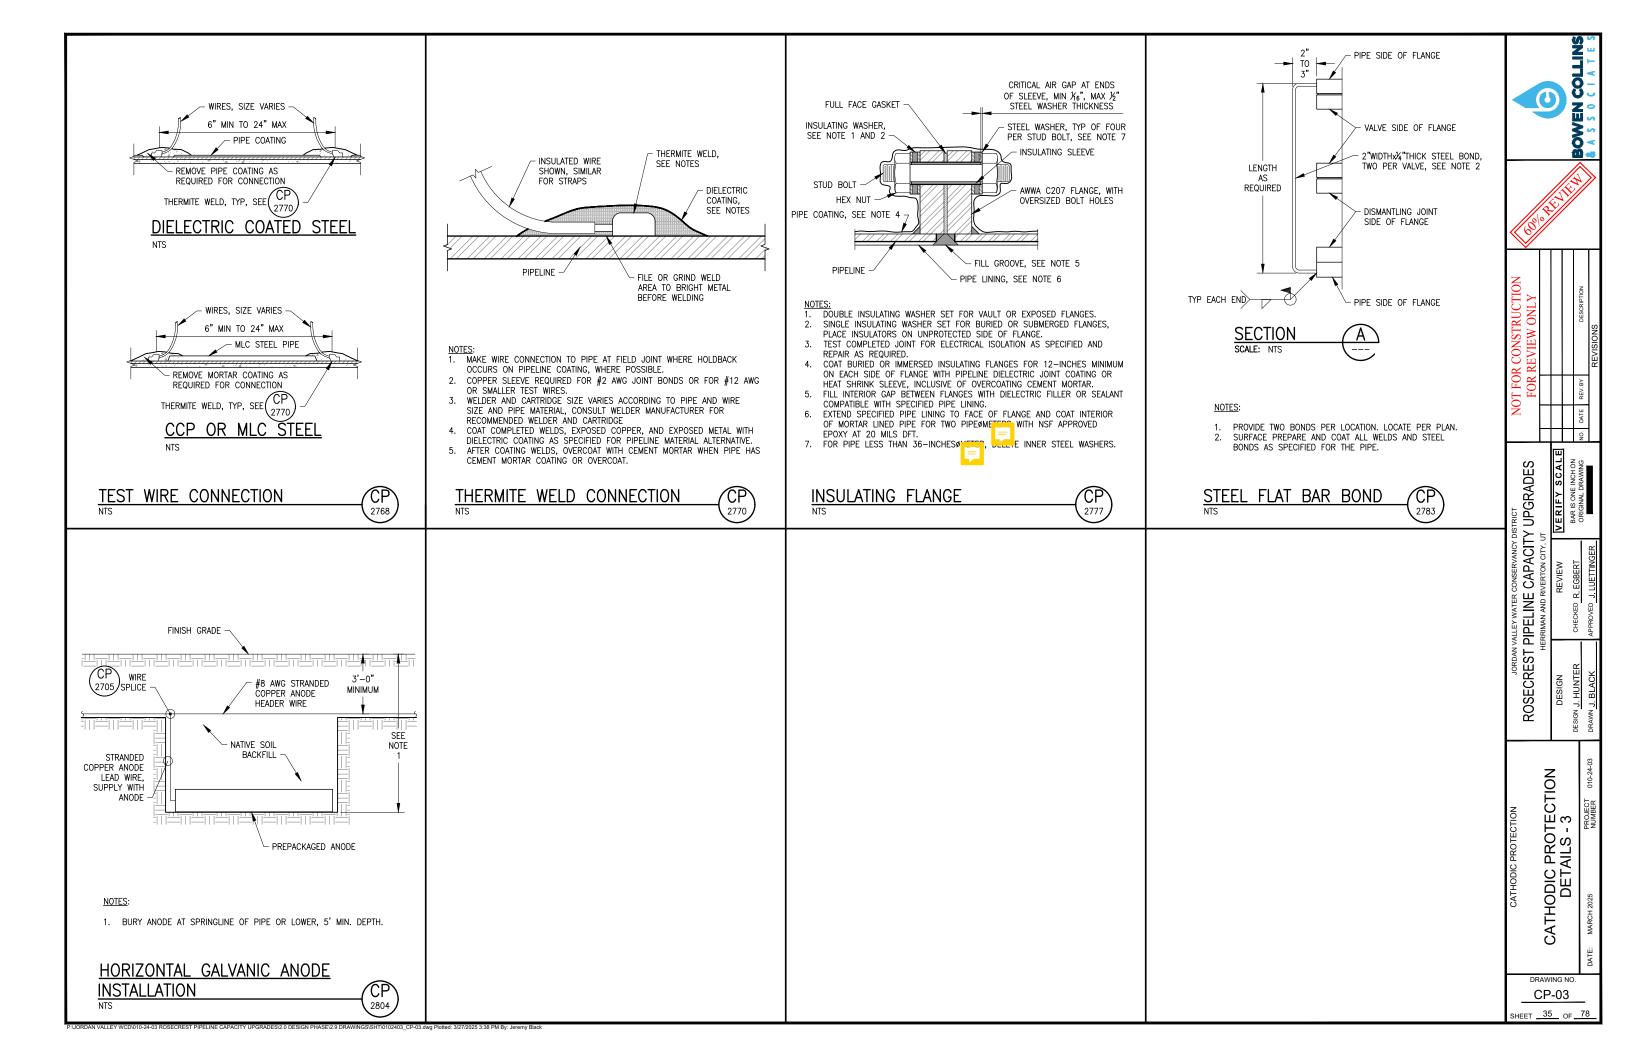

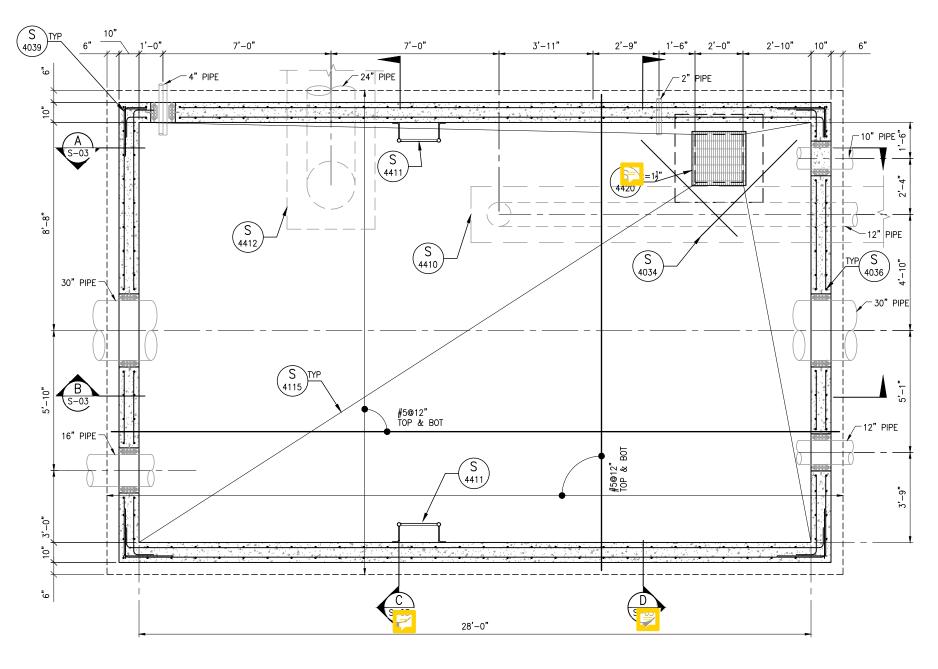

BASE PLAN

SCALE: 1/2"=1'-0"

#### DRAWING NOTES

- 1. FOR GENERAL STRUCTURAL NOTES, REFER TO DRAWING GS-01.
- 2. IT IS THE CONTRACTOR'S RESPONSIBILITY TO COORDINATE THE STRUCTURAL DRAWINGS WITH ALL OTHER CONTRACT DOCUMENTS. STRUCTURAL DRAWINGS DO NOT ATTEMPT TO SHOW ALL MECHANICAL AND ELECTRICAL PENETRATIONS AND ROUTINGS.
- 3. OVER EXCAVATE BENEATH BASE SLAB AND PLACE 1'-0" MINIMUM COMPACTED THICKNESS OF GRANULAR STRUCTURAL FILL. EXTEND MINIMUM OF 2' BEYOND EDGE OF BASE SLAB.
- 4. THE EXPOSED INTERIOR FACES OF THE CONCRETE WALLS AND TOP SLAB SHALL BE GIVEN A RUBBED FINISH. TOPS SURFACES OF BOTH SLABS SHALL BE GIVEN A FLOATED SURFACE FINISH CONSISTENT WITH REQUIREMENTS FOR A PAINTED COATING.
- 5. APPLY FLUID-APPLIED WATERPROOFING TO ALL EXTERIOR BURIED CONCRETE SURFACES OF THIS VAULT.
- 6. UNLESS SPECIFICALLY NOTED OTHERWISE, MISCELLANEOUS METAL ITEMS WITHIN THIS STRUCTURE ARE TO BE STAINLESS STEEL.
- 7. ALL REBAR SHALL BE EPOXY COATED PER UDOT SPECIFICATIONS.
- 8. UNO, HATCH SHALL HAVE A CONCEALED RECESSED PADLOCK HASP AND SHALL BE INSULATED WITH RIGID FOAM BOARD.
- 9. WALLS AND ROOF SLAB SHALL BE INSULATED WITH RIGID FOAM BOARD.

		4/
ION (		NOIL


FOR FOR
FOR REVIEW ONLY FOR REVIEW ONLY  FOR REVIEW ONLY  FOR REVIEW ONLY  BEXAGENIAR

JORDAN VALLEY WATER CONSERVANCY DISTRICT
ROSECREST PIPELINE CAPACITY UPGRALE
HERRIMAN AND RIVERTON CITY 1.17

ROSECRESTS ROAD VAULT FOUNDATION PLAN

DRAWING NO.

S-01 SHEET 36 OF 78

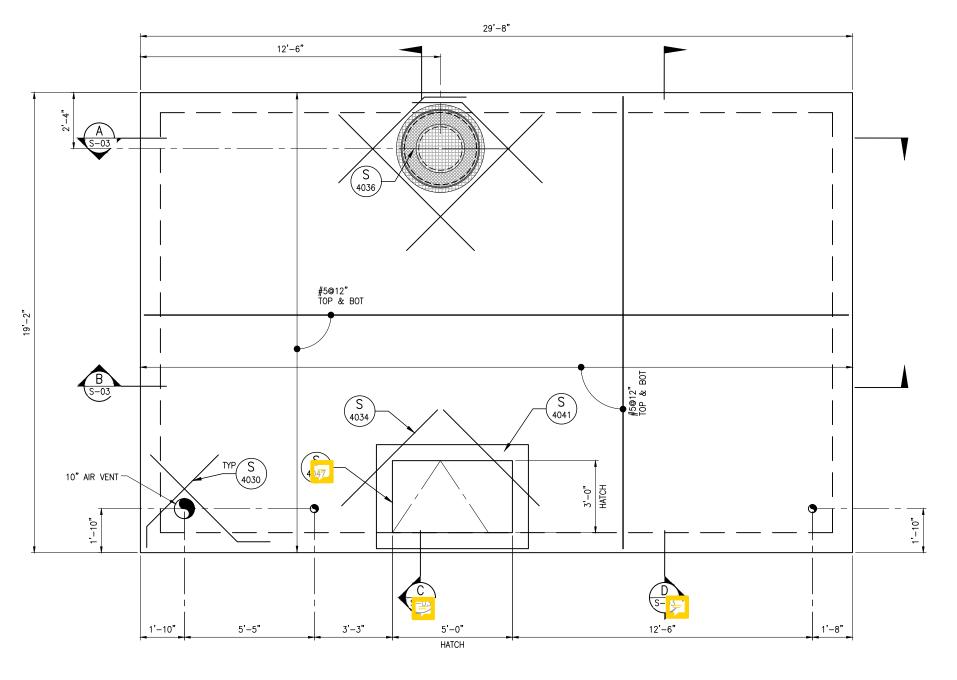

#### ROOF PLAN

SCALE: 1/2"=1'-0"

- 1. FOR GENERAL STRUCTURAL NOTES, REFER TO DRAWING GS-01.
- ELECTRICAL PENETRATIONS AND ROUTINGS.
- 3. OVER EXCAVATE BENEATH BASE SLAB AND PLACE 1'-0" MINIMUM COMPACTED THICKNESS OF GRANULAR STRUCTURAL FILL. EXTEND MINIMUM OF 2' BEYOND EDGE OF BASE SLAB.
- 4. THE EXPOSED INTERIOR FACES OF THE CONCRETE WALLS AND TOP SLAB SHALL BE GIVEN A RUBBED FINISH. TOPS SURFACES OF BOTH SLABS SHALL BE GIVEN A FLOATED SURFACE FINISH CONSISTENT WITH
- 5. APPLY FLUID—APPLIED WATERPROOFING TO ALL EXTERIOR BURIED CONCRETE SURFACES OF THIS VAULT.
- 6. UNLESS SPECIFICALLY NOTED OTHERWISE, MISCELLANEOUS METAL ITEMS WITHIN THIS STRUCTURE ARE TO BE STAINLESS STEEL.
- 8. UNO, HATCH SHALL HAVE A CONCEALED RECESSED PADLOCK HASP AND SHALL BE INSULATED WITH RIGID FOAM BOARD.
- 9. WALLS AND ROOF SLAB SHALL BE INSULATED WITH RIGID FOAM BOARD.

BOWEN COLLINS							
OT FOR CONSTRUCTION FOR REVIEW ONLY				NOESCRIPTION		REVISIONS	
ON				NO DATE REV BY			
DISTRICT  TY UPGRADES	UT	VERIFY SCALE					
<	RRIMAN AND RIVERTON CITY, UT	REVIEW		CHECKED S. COHEN		APPROVED S COHEN	
JORDAN V ROSECREST P	HERF	DESIGN		DESIGN S.PUGH		DRAWN S. PUGH	

#### DRAWING NOTES


- IT IS THE CONTRACTOR'S RESPONSIBILITY TO COORDINATE THE STRUCTURAL DRAWINGS WITH ALL OTHER CONTRACT DOCUMENTS. STRUCTURAL DRAWINGS DO NOT ATTEMPT TO SHOW ALL MECHANICAL AND
- REQUIREMENTS FOR A PAINTED COATING.


- 7. ALL REBAR SHALL BE EPOXY COATED PER UDOT SPECIFICATIONS.


S-02 SHEET 37 OF 78

DRAWING NO.

ROSECREST ROAD VAULT ROOF PLAN

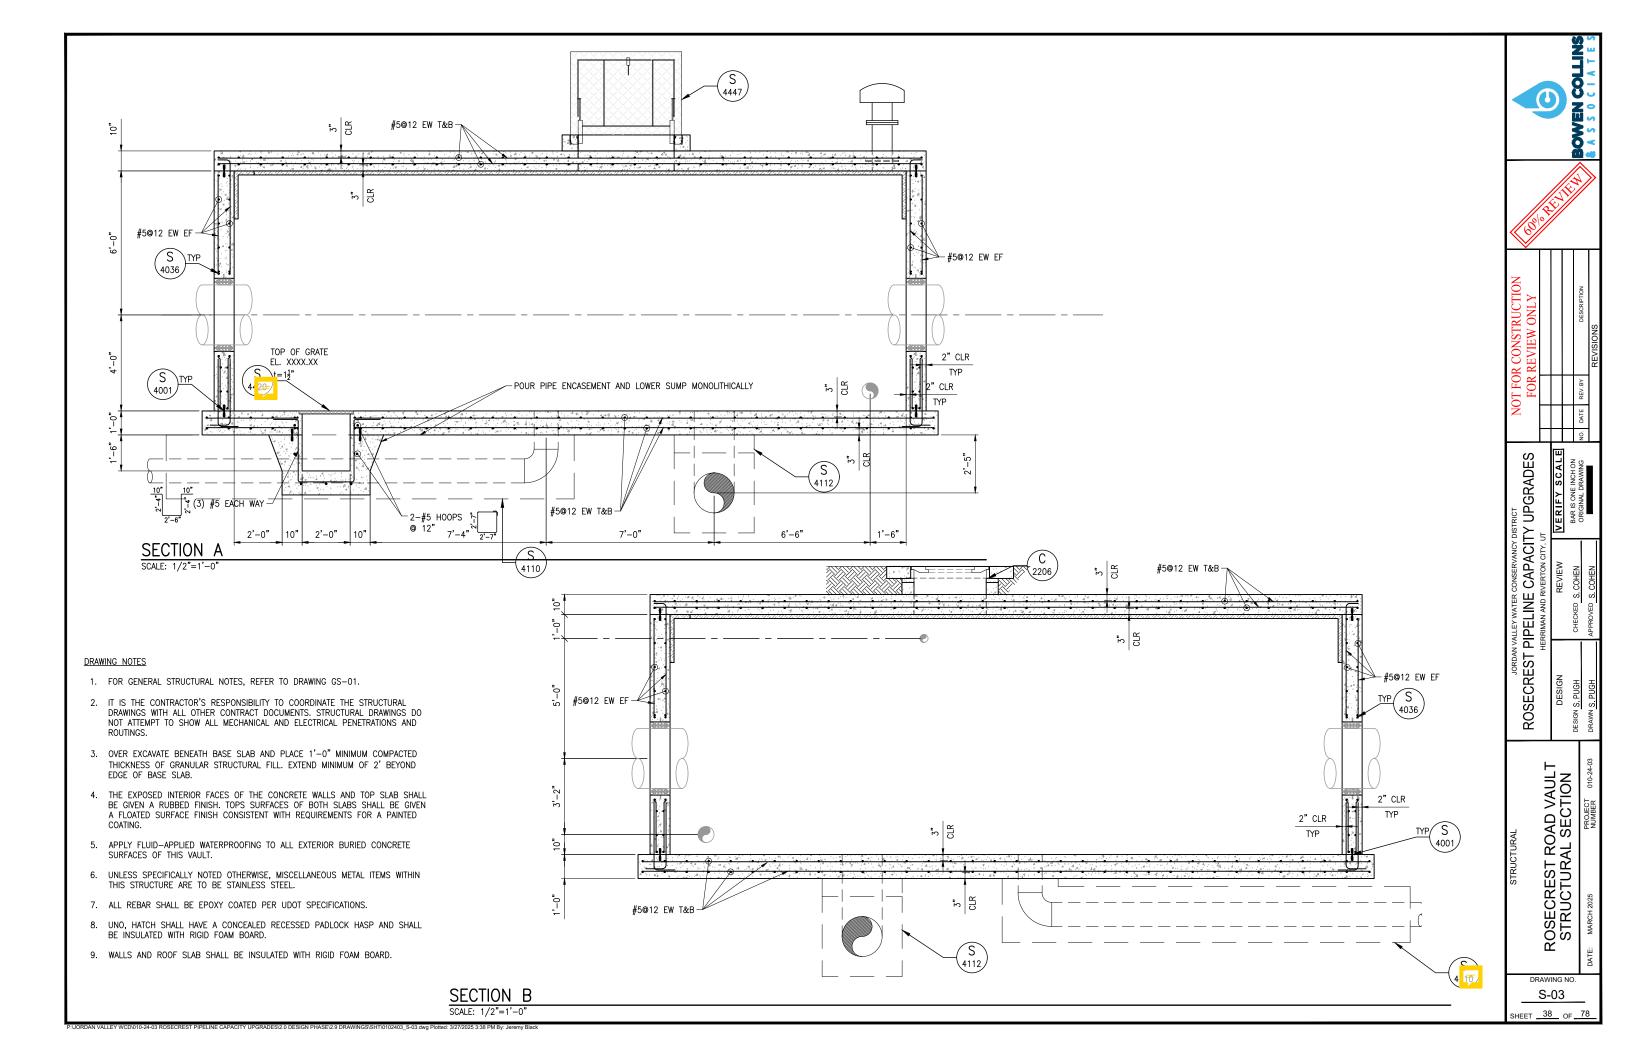

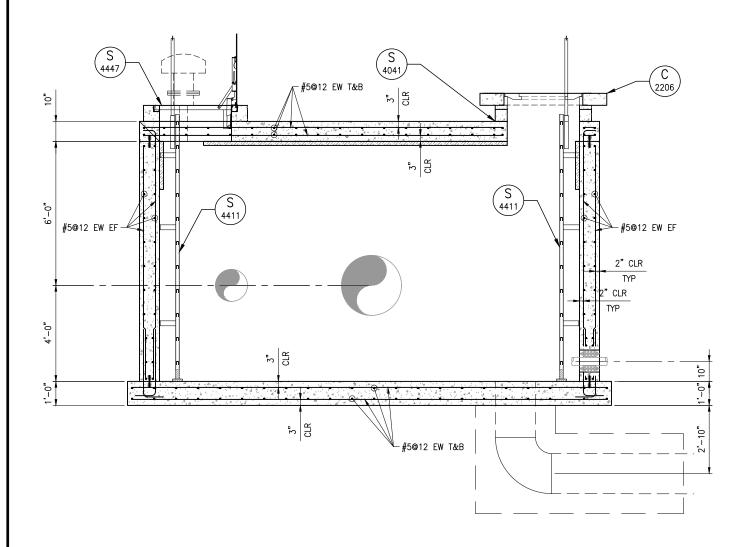

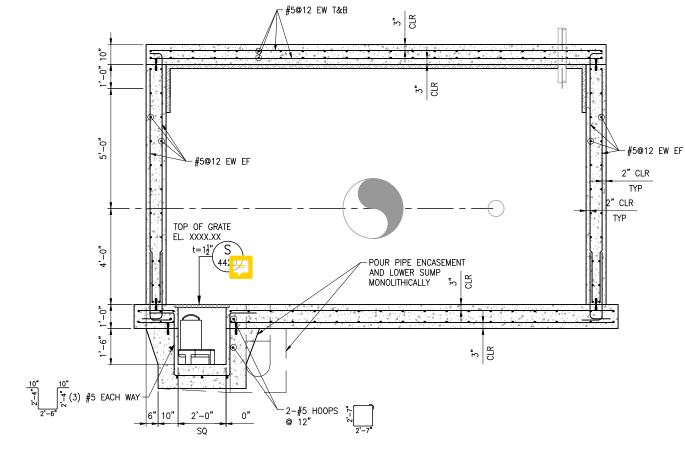


SECTION C SCALE: 1/2"=1'-0"


#### <u>DRAWING NOTES</u>


- 1. FOR GENERAL STRUCTURAL NOTES, REFER TO DRAWING GS-01.
- 2. IT IS THE CONTRACTOR'S RESPONSIBILITY TO COORDINATE THE STRUCTURAL DRAWINGS WITH ALL OTHER CONTRACT DOCUMENTS. STRUCTURAL DRAWINGS DO NOT ATTEMPT TO SHOW ALL MECHANICAL AND ELECTRICAL PENETRATIONS AND ROUTINGS.
- 3. OVER EXCAVATE BENEATH BASE SLAB AND PLACE 1'-0" MINIMUM COMPACTED THICKNESS OF GRANULAR STRUCTURAL FILL. EXTEND MINIMUM OF 2' BEYOND EDGE OF BASE SLAB.
- 4. THE EXPOSED INTERIOR FACES OF THE CONCRETE WALLS AND TOP SLAB SHALL BE GIVEN A RUBBED FINISH. TOPS SURFACES OF BOTH SLABS SHALL BE GIVEN A FLOATED SURFACE FINISH CONSISTENT WITH REQUIREMENTS FOR A PAINTED COATING.
- 5. APPLY FLUID-APPLIED WATERPROOFING TO ALL EXTERIOR BURIED CONCRETE SURFACES OF THIS VAULT.
- 6. UNLESS SPECIFICALLY NOTED OTHERWISE, MISCELLANEOUS METAL ITEMS WITHIN THIS STRUCTURE ARE TO BE STAINLESS STEEL.
- 7. ALL REBAR SHALL BE EPOXY COATED PER UDOT SPECIFICATIONS.
- 8. UNO, HATCH SHALL HAVE A CONCEALED RECESSED PADLOCK HASP AND SHALL BE INSULATED WITH RIGID FOAM BOARD.
- 9. WALLS AND ROOF SLAB SHALL BE INSULATED WITH RIGID FOAM BOARD.

SECTION D SCALE: 1/2"=1'-0" JORDAN VALLEY WATER CONSERVANCY DISTRICT
ROSECREST PIPELINE CAPACITY UPGRADES
HERRIMAN AND RIVERTON CITY IT S-04 SHEET 39 OF 78

LIORDAN VALLEY WCD010-24-03 ROSECREST PIPELINE CAPACITY LIPGRADESI2 0 DESIGN PHASEV 9 DRAWINGSISHT0102403 S-04 dwo Plotted: 3/27/2025 3:38 PM Rv. Jeremy Black

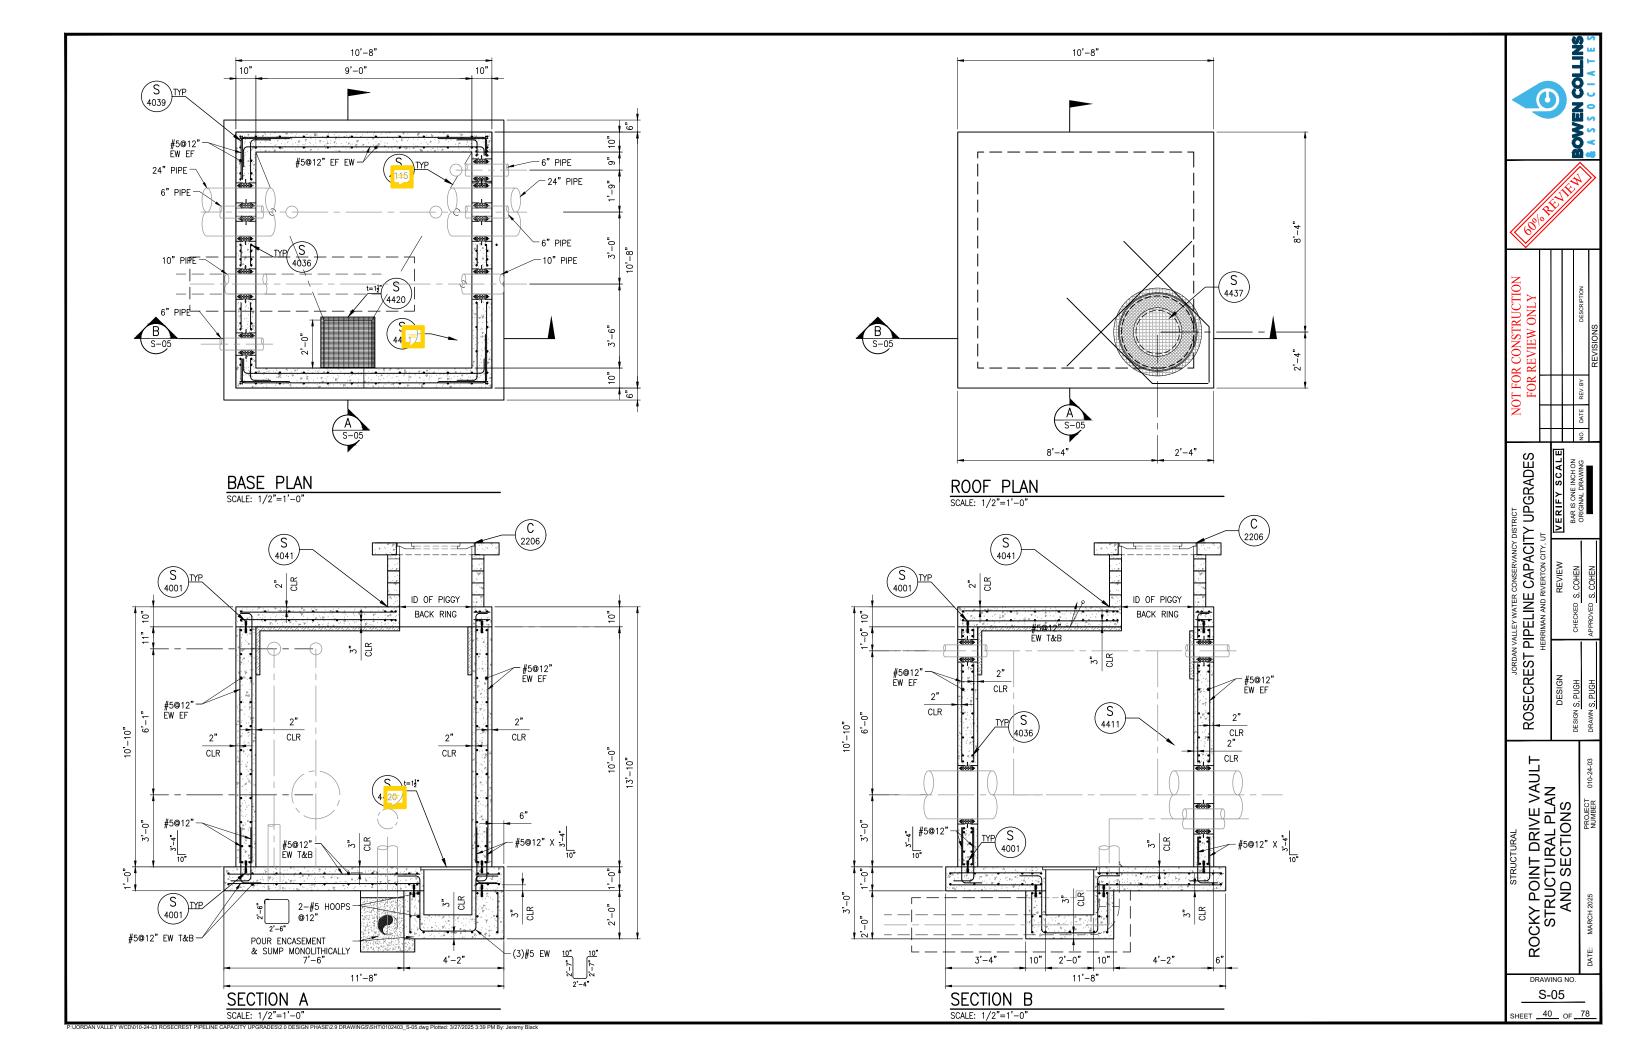

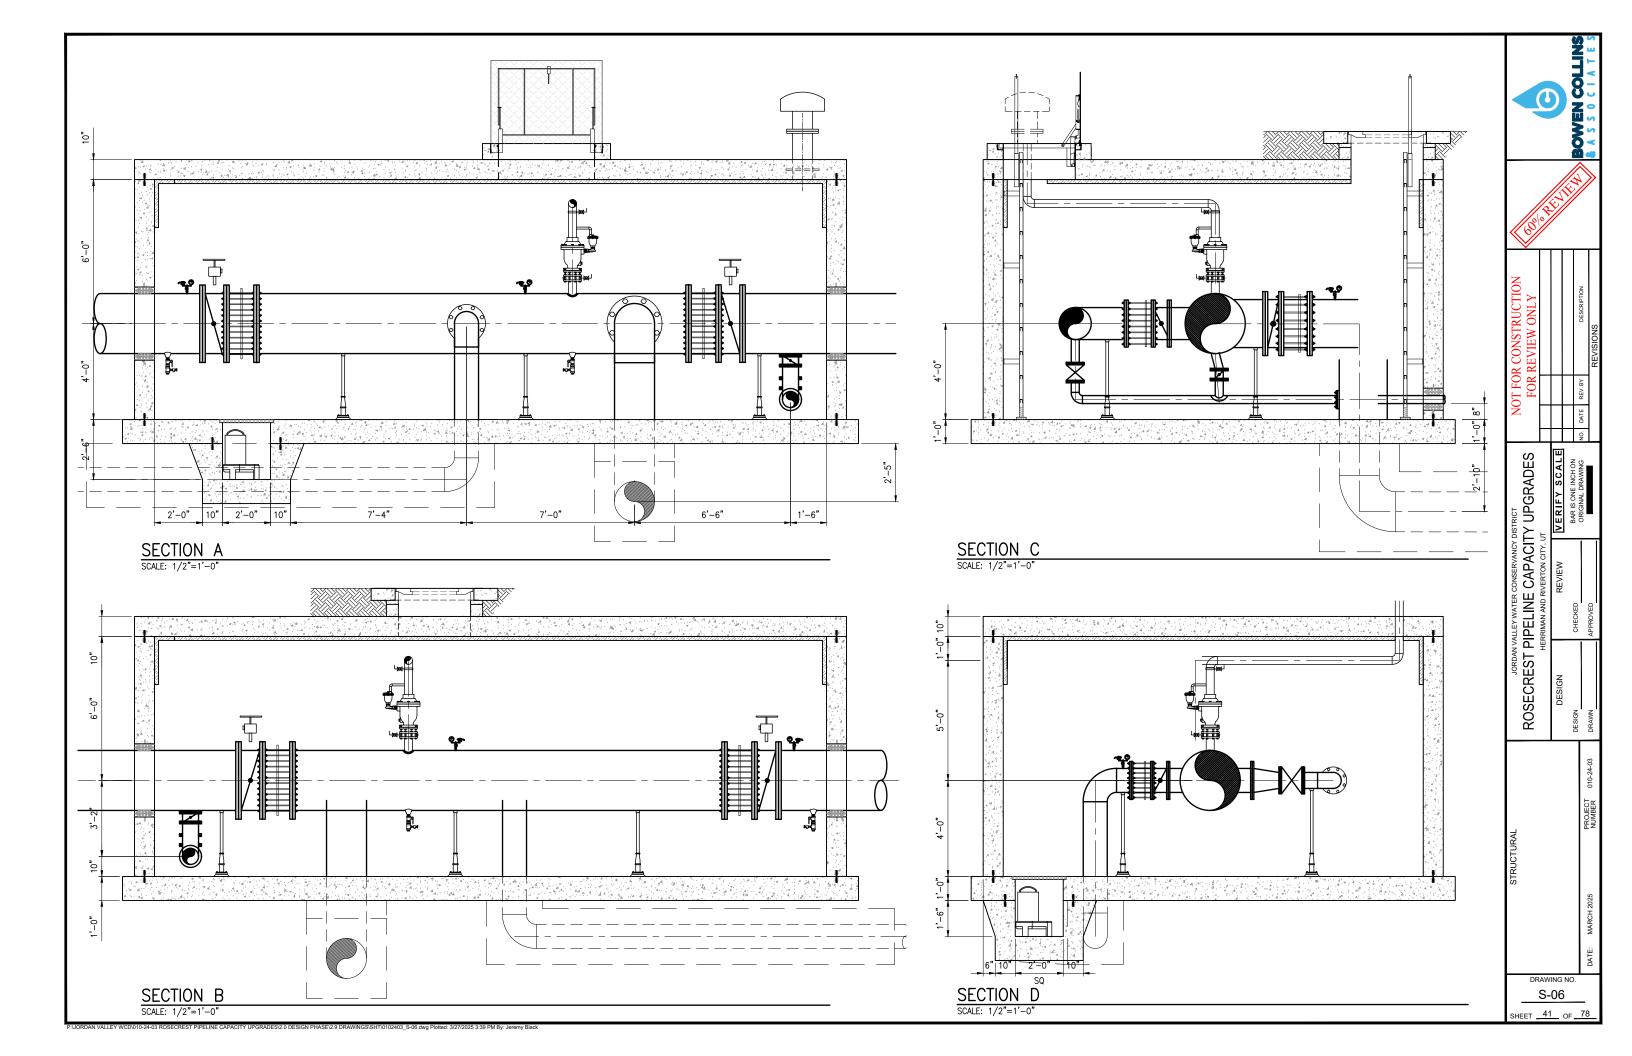

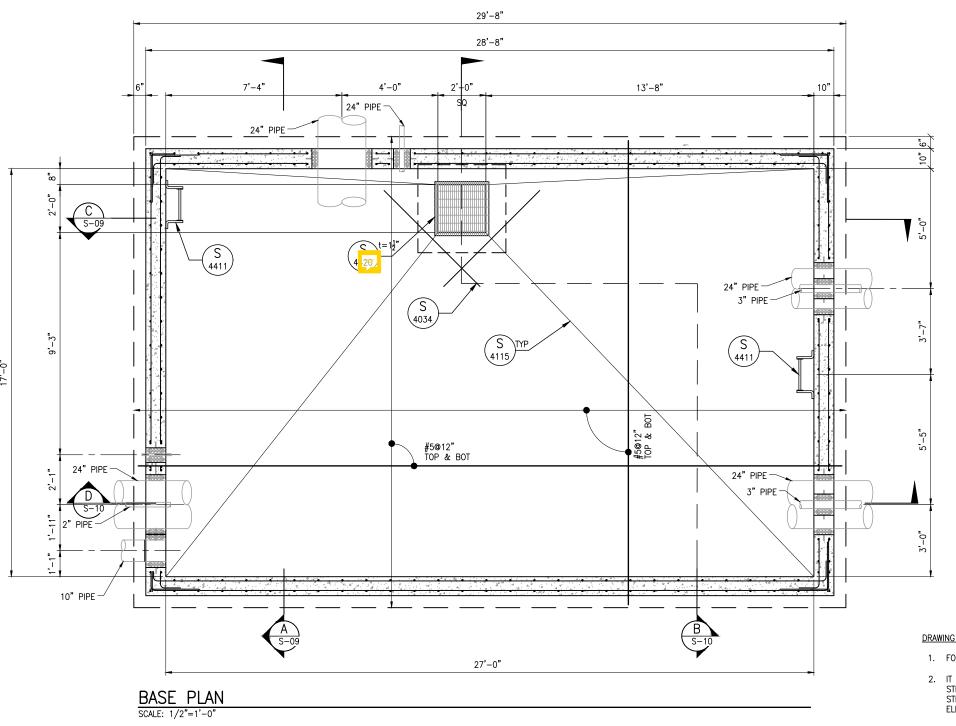

DRAWING NOTES

- 1. FOR GENERAL STRUCTURAL NOTES, REFER TO DRAWING GS-01.
- 2. IT IS THE CONTRACTOR'S RESPONSIBILITY TO COORDINATE THE STRUCTURAL DRAWINGS WITH ALL OTHER CONTRACT DOCUMENTS.
  STRUCTURAL DRAWINGS DO NOT ATTEMPT TO SHOW ALL MECHANICAL AND ELECTRICAL PENETRATIONS AND ROUTINGS.
- 3. OVER EXCAVATE BENEATH BASE SLAB AND PLACE 1'-0" MINIMUM COMPACTED THICKNESS OF GRANULAR STRUCTURAL FILL. EXTEND MINIMUM OF 2' BEYOND EDGE OF BASE SLAB.
- 4. THE EXPOSED INTERIOR FACES OF THE CONCRETE WALLS AND TOP SLAB SHALL BE GIVEN A RUBBED FINISH. TOPS SURFACES OF BOTH SLABS SHALL BE GIVEN A FLOATED SURFACE FINISH CONSISTENT WITH REQUIREMENTS FOR A PAINTED COATING.
- 5. APPLY FLUID—APPLIED WATERPROOFING TO ALL EXTERIOR BURIED CONCRETE SURFACES OF THIS VAULT.
- 6. UNLESS SPECIFICALLY NOTED OTHERWISE, MISCELLANEOUS METAL ITEMS WITHIN THIS STRUCTURE ARE TO BE STAINLESS STEEL.
- 7. ALL REBAR SHALL BE EPOXY COATED PER UDOT SPECIFICATIONS.
- UNO, HATCH SHALL HAVE A CONCEALED RECESSED PADLOCK HASP AND SHALL BE INSULATED WITH RIGID FOAM BOARD.
- 9. WALLS AND ROOF SLAB SHALL BE INSULATED WITH RIGID FOAM BOARD.

//	
	<i>//</i>


NOT FOR CONSTRUCTION FOR REVIEW ONLY			DESCRIPTION	01101011
OT FC FOR			REV. BY	
N(			DATE	
			NO.	
ES	旦	] -		

JORDAN VALLEY WATER CONSERVANCY DISTRICT
ROSECREST PIPELINE CAPACITY UPGRADE
HERRINAN AND RIVERTON CITY IIT

ROSECREST RESERVOIR VAULT STRUCTURAL BASE PLAN

DRAWING NO. S-07


SHEET 42 OF 78

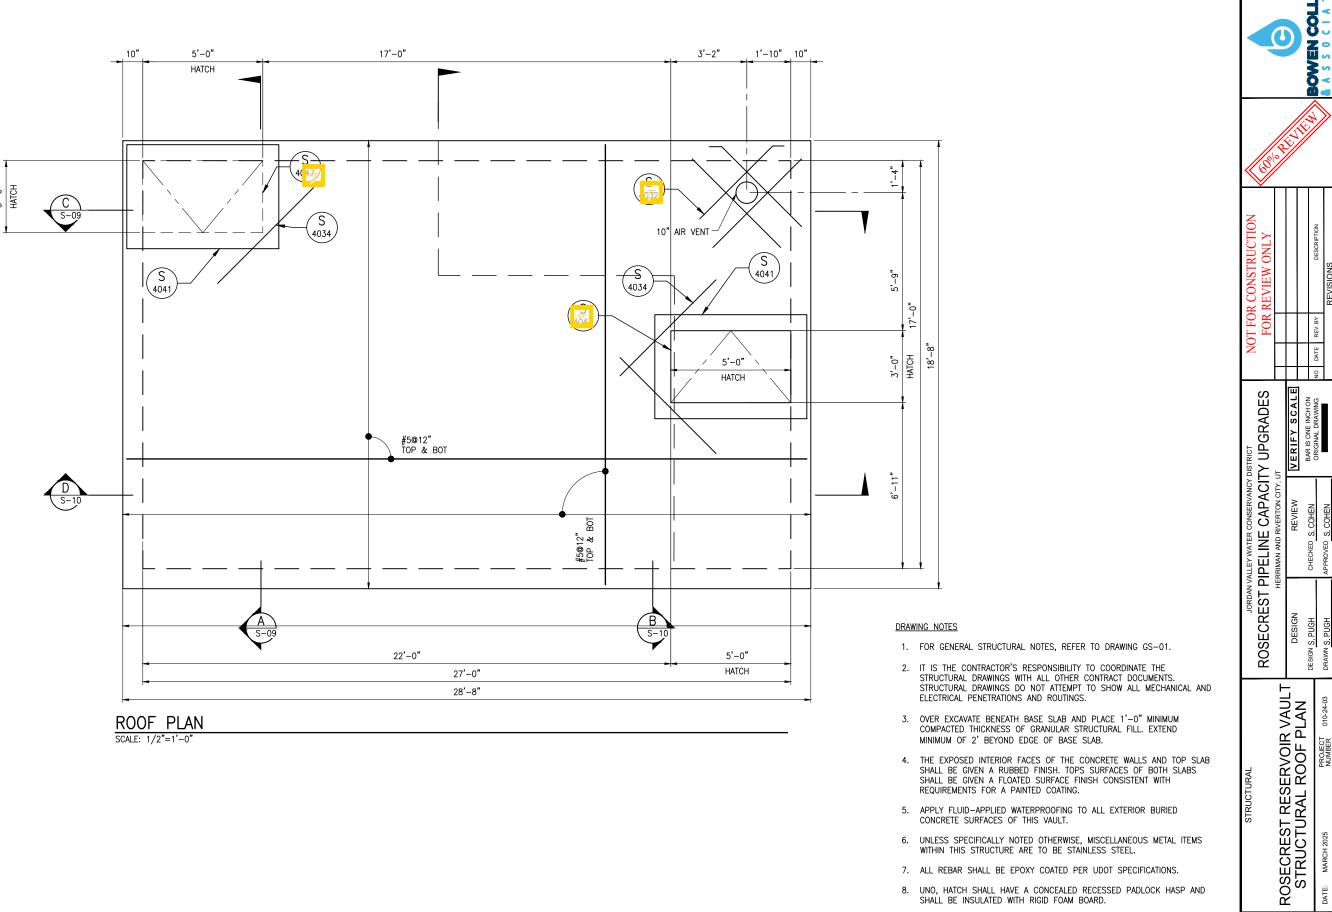


DRAWING NO.

9. WALLS AND ROOF SLAB SHALL BE INSULATED WITH RIGID FOAM BOARD.

S-08 SHEET 43 OF 78

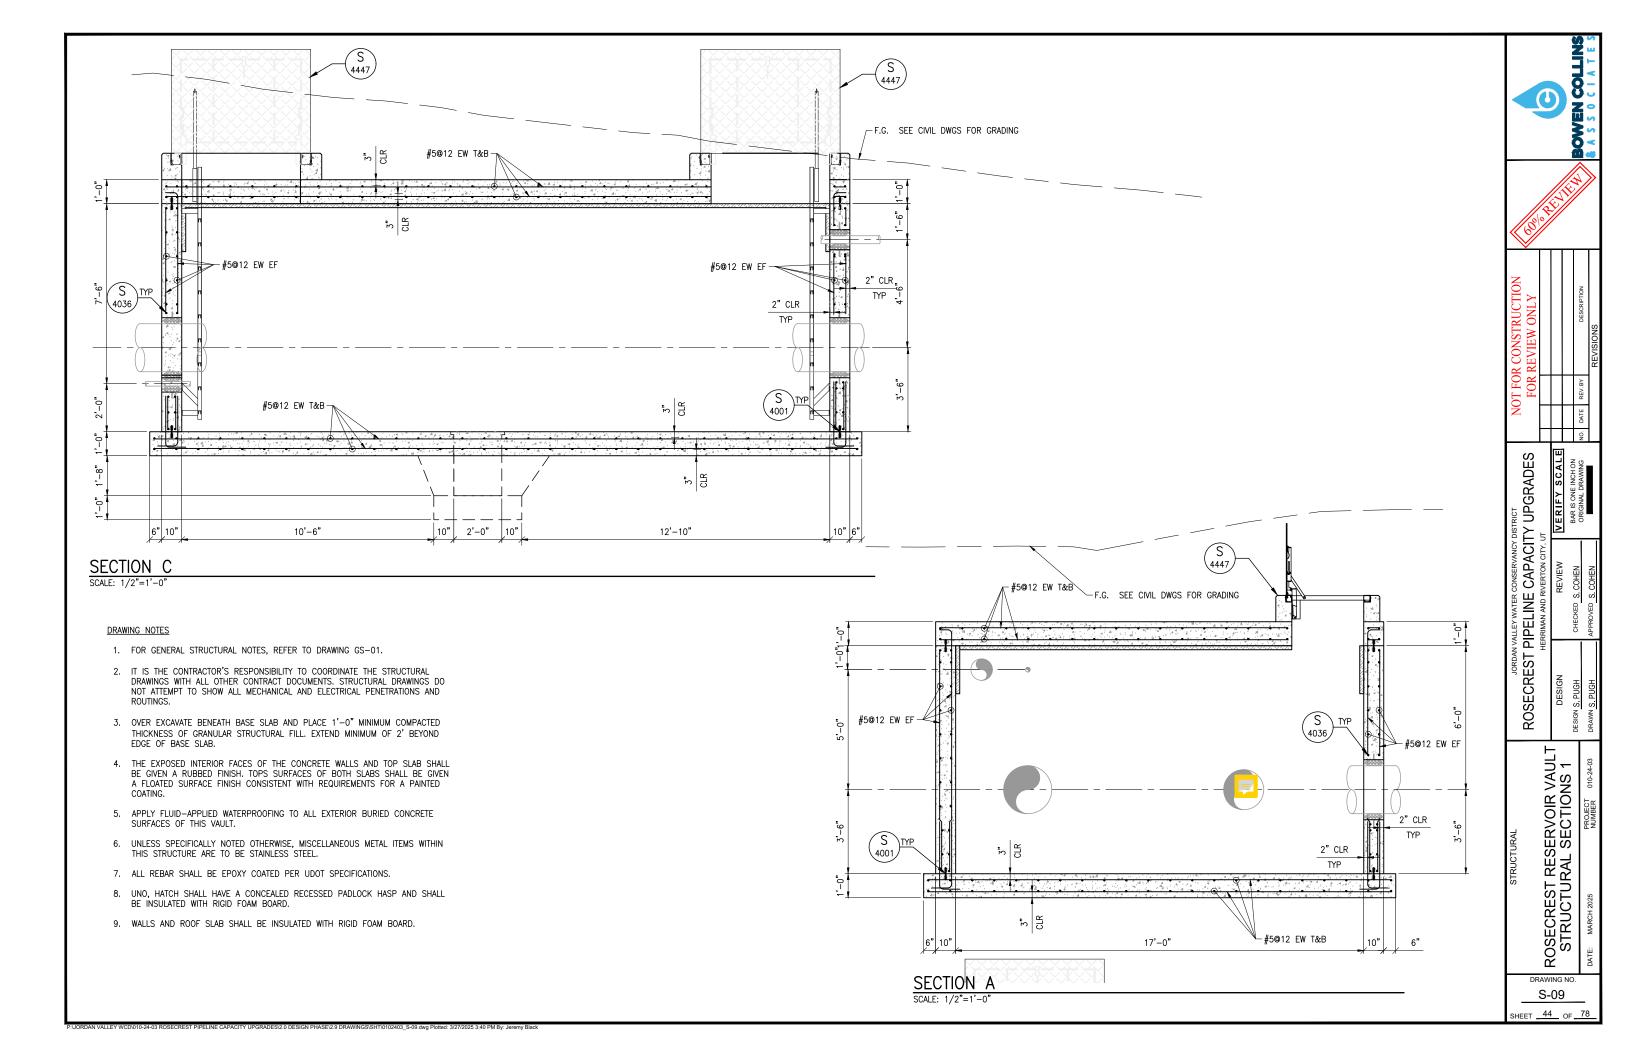

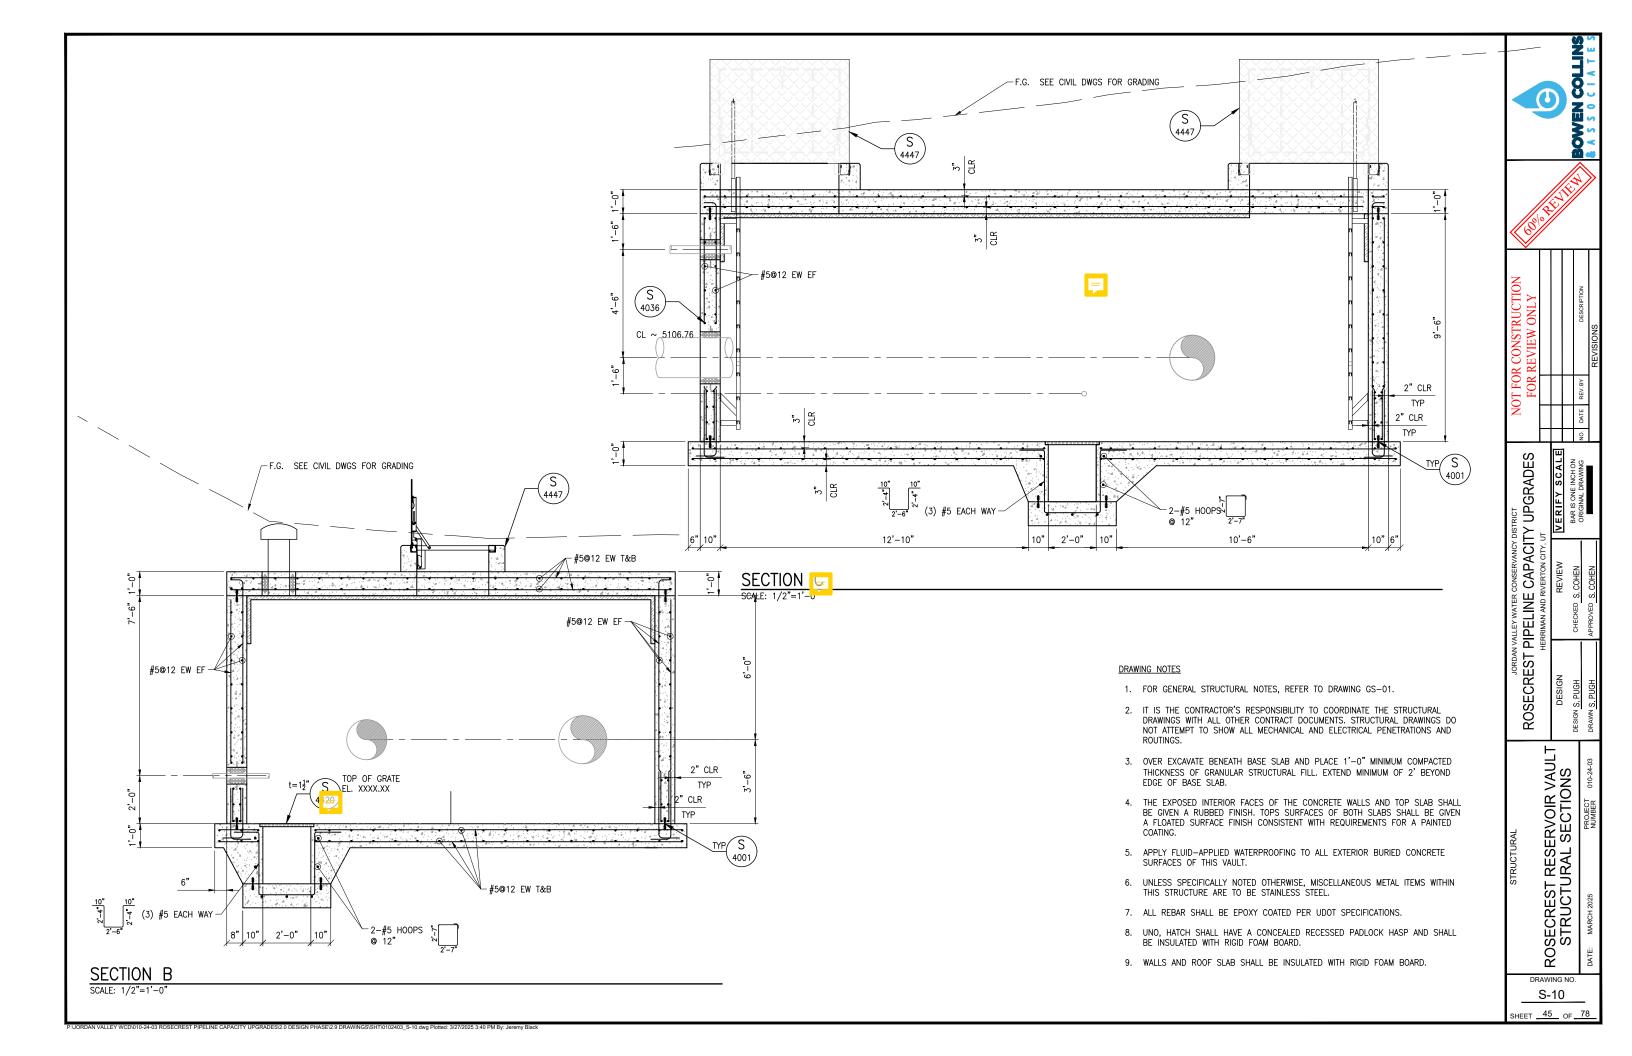

#### **GENERAL STRUCTURAL NOTES**

#### **GENERAL**

- THE SPECIFICATIONS AND REQUIREMENTS INDICATED ON THIS SHEET ARE INTENDED AS A
  BASIC SUMMARY OF THE MATERIAL CONSTRUCTION AND INSPECTION REQUIREMENTS FOR
  THIS PROJECT. ADDITIONAL REQUIREMENTS ARE GIVEN IN THE PROJECT SPECIFICATIONS. IN
  THE EVENT OF A CONFLICT BETWEEN THESE GENERAL NOTES AND THE REQUIREMENTS GIVEN
  IN THE PROJECT SPECIFICATIONS, THE ENGINEER SHALL BE CONTACTED TO DETERMINE
  WHICH PROVISION GOVERNS.
- FOR LOCATION AND DIMENSIONS OF SLEEVES, CURBS, OPENINGS, AND DEPRESSIONS NOT SHOWN ON THE STRUCTURAL DRAWINGS, SEE CIVIL, MECHANICAL, AND ELECTRICAL DRAWINGS. THE CONTRACTOR SHALL VERIFY AND COORDINATE PENETRATIONS SHOWN ON THE OTHER PROJECT DRAWINGS, WHETHER THEY ARE SHOWN ON THE STRUCTURAL DRAWINGS OR NOT.
- EMBEDDED ITEMS, SUCH AS PIPE SLEEVES, CONDUITS, AND INSERTS SHALL ALL BE RIGIDLY INSTALLED IN PLACE BEFORE CONCRETE IS POURED. SEE CIVIL, MECHANICAL, AND ELECTRICAL DRAWINGS FOR ITEMS REQUIRING SLEEVES AND EMBEDMENTS IN CONCRETE, WHICH ARE NOT SHOWN ON THE STRUCTURAL DRAWINGS
- 4. NO STRUCTURAL MEMBER SHALL BE CUT FOR PIPES, DUCTS, ETC. UNLESS SPECIFICALLY DETAILED OR APPROVED IN WRITING BY THE ENGINEER.
- 5. DESIGN DETAILS AS SHOWN ON THE DRAWINGS ARE INTENDED TO BE TYPICAL AND APPLY TO ALL SIMILAR SITUATIONS OCCURRING ON THE PROJECT, WHETHER OR NOT THEY ARE SPECIFICALLY REFERENCED IN EACH LOCATION. CONSULT THE ENGINEER FOR CONCURRENCE PRIOR TO CONSTRUCTION.
- 6. SUBMIT DRAWINGS AND RECEIVE REVIEW OF ALL STRUCTURAL RELATED SHOP DRAWINGS PRIOR TO ERECTION OR CONSTRUCTION.
- . APPLICABLE BUILDING CODE FOR THE PROJECT IS THE 2018 EDITION OF THE INTERNATIONAL BUILDING CODE (IBC). ANY CHANGES MADE DURING CONSTRUCTION TO THE APPROVED CONSTRUCTION DOCUMENTS SHALL BE APPROVED BY THE ENGINEER AND SHALL BE RESUBMITTED TO THE BUILDING OFFICIAL FOR APPROVAL AS AN AMENDED SET OF CONSTRUCTION DOCUMENTS.

#### SITE PREPARATION NOTES

- SITE PREPARATION NOTES FOR THIS PROJECT ARE BASED ON RECOMMENDATIONS
  CONTAINED IN A SOILS REPORT BY RBAG ENGINEERING, INC., DATED FEBRUARY 2025, ALONG
  WITH ANY ADDENDA THERETO, WHICH HAVE BEEN PREPARED FOR THIS PROJECT. A
  REFERENCE COPY IS AVAILABLE UPON REQUEST FROM THE ENGINEER (or IS INCLUDED IN THE
  APPENDIX CHAPTER OF THE SPECIFICATIONS)
- 2. ALL FOOTINGS AND MAT SLAB SHALL BE SUPPORTED UPON 12" OF STRUCTURAL FILL EXTENDING TO FIRM NATURAL SOILS. IF FIRM UNDISTURBED SOILS BECOME LOOSE OR DISTURBED, THEY SHALL BE REMOVED AND REPLACED WITH COMPACTED STRUCTURAL FILL PRIOR TO PLACEMENT OF CONCRETE. THE OWNER'S TESTING LABORATORY SHALL OBSERVE THE NATURAL SOILS AT THE TIME OF FOOTING EXCAVATION, PRIOR TO PLACEMENT OF FORMWORK OR REINFORCING STEEL, TO DETERMINE THE SUITABILITY OF THE NATURAL SOILS FOR SUPPORTING THE FOOTINGS.
- STRUCTURAL FILL, SHALL CONSIST OF FREE DRAINING GRANULAR BACKFILL CLASSIFIED AS GRANULAR BACKFILL BORROW PER UDOT SPECIFICATIONS AND BE PLACED A MINIMUM OF 3"-0" FROM THE FACE OF THE WALL AND A MINIMUM 2"-6" FROM THE FACE OF THE FOOTING, WHICHEVER IS GREATER.
- 4. STRUCTURAL FILL BELOW FOOTINGS AND BELOW SLAB ON GRADE SHALL BE PLACED IN MAXIMUM 8 INCH LOOSE LIFTS AND COMPACTED TO AT LEAST 95% OF MAXIMUM DENSITY AS DETERMINED BY ASTM D-1557 AND SHALL BE COMPACTED AT A MOISTURE CONTENT WITHIN 2% OF THE OPTIMUM MOISTURE CONTENT.
- 5. COMPACTION OF ALL STRUCTURAL FILL SHALL BE OBSERVED AND TESTED BY OWNER'S TESTING LABORATORY TO ENSURE THAT THE ABOVE REQUIREMENTS ARE ACHIEVED.

#### **FORMWORK, SHORING, AND BRACING**

- CONFORM TO ACI 347 "RECOMMENDED PRACTICE FOR CONCRETE FORMWORK" FOR DESIGN AND CONSTRUCTION OF CONCRETE FORMWORK AND BRACING. CONTRACTOR IS RESPONSIBLE FOR DESIGN AND CONSTRUCTION OF FORMWORK AND BRACING.
- 2. STRUCTURES AS SHOWN ON THESE DRAWINGS INDICATE THE FINAL CONDITION ONLY AND DO NOT INCLUDE THE NECESSARY COMPONENTS OR EQUIPMENT FOR STRUCTURAL STABILITY DURING CONSTRUCTION. CONTRACTOR IS RESPONSIBLE FOR WORK RELATED. CONSTRUCTION ERECTION METHODS, BRACING, SHORING, RIGGING, GUYS, SCAFFOLDING, FORMWORK, AND OTHER WORK AIDS REQUIRED TO SAFELY PERFORM THE WORK SHOWN.
- 3. TEMPORARY SHORING TO REMAIN IN PLACE UNTIL ELEVATED CONCRETE SLABS HAVE REACHED 28-DAY DESIGN STRENGTH AS DETERMINED BY CYLINDER BREAKS.

#### **FOOTINGS**

1. NO FOOTINGS SHALL BE PLACED IN WATER OR ON FROZEN GROUND.

#### CONCRETE

- ALL CONCRETE CONSTRUCTION TO CONFORM TO ACI 318 "BUILDING CODE REQUIREMENTS FOR STRUCTURAL CONCRETE", INCLUDING BAR BENDS AND HOOKS UNLESS SPECIFICALLY DETAILED OTHERWISE ON THESE DRAWINGS.
- CAST-IN-PLACE CONCRETE TO HAVE A MINIMUM 28-DAY COMPRESSIVE STRENGTH OF 4,000
  PSI, UDOT STANDARD CLASS AA(AE) WITH MAXIMUM NOMINAL AGGREGATE SIZE OF 1 INCH AND
  MAXIMUM WATER CEMENT RATIO OF 0.44.
- 3. A STATEMENT OF MIX DESIGN FOR ALL CONCRETE SHALL BE SUBMITTED TO AND REVIEWED BY THE STRUCTURAL ENGINEER PRIOR TO COMMENCING WORK.
- 4. NON-STRUCTURAL ELEMENTS, SUCH AS ENCASEMENTS, CURBS, SIDEWALKS AND LEAN CONCRETE TO HAVE A MINIMUM 28-DAY COMPRESSIVE STRENGTH OF 3000 PSI
- 5. USE CEMENT CONFORMING TO ASTM C595, TYPE IL (10) (MS).
- ALL CONSTRUCTION JOINTS, EXPANSION JOINTS, AND OTHER TYPES OF JOINTS, OTHER THAN
  THOSE SPECIFICALLY SHOWN ON THE DRAWINGS TO BE APPROVED BY THE ENGINEER PRIOR
  TO PLACING CONCRETE.
- PROVIDE 3/4-INCH CHAMFER AT ALL EXPOSED EDGES AND CORNERS UNLESS NOTED OTHERWISE.
- 8. BEFORE PLACING THE SECOND POUR AT CONSTRUCTION JOINTS, THOROUGHLY CLEAN AND ROUGHEN ALL JOINT SURFACES TO A MINIMUM AMPLITUDE OF 1/4 INCH.

#### REINFORCEMENT STEEL

- PROVIDE REINFORCEMENT STEEL CONFORMING TO ASTM A615, GRADE 60 AND EPOXY COATED PER ASTM ATT5 OR GALVANIZED PER AASHTO M111.
- DIMENSIONS GIVEN FOR REINFORCING BARS ARE TO BAR CENTERS UNLESS NOTED
   OTHERWISE. BAR COVER IS THE CLEAR DISTANCE BETWEEN BAR AND CONCRETE SURFACE.
   CLEARANCE FOR REINFORCEMENT BARS PER THE FOLLOWING UNLESS SHOWN OTHERWISE:

WHEN PLACED AGAINST GROUND	3"
FORMED SURFACES IN CONTACT WITH THE GROUND	
OR EXPOSED TO THE WEATHER	2"
INTERIOR WALL SURFACES	1"
ALL OTHER CONCRETE SURFACES	2"

- CONTINUE WALL CORNER AND WALL INTERSECTION REINFORCEMENT BARS AROUND CORNERS AND THROUGH COLUMNS OR PILASTERS. EXTEND REINFORCEMENT INTO CONNECTING WALLS AND LAP ON THE OPPOSITE FACE OF THE CONNECTING WALLS.
- 4. UNLESS OTHERWISE NOTED, ALL HOOKS SHOWN ARE  $90^{\circ}$  STANDARD HOOK AS DEFINED IN ACI 318-14.
- 5. LAP VERTICAL WALL BARS WITH DOWELS FROM BELOW AND EXTEND THROUGH SLABS ABOVE TO TOP FACE. BEND AND/OR LAP TO TOP SLAB REINFORCEMENT AS INDICATED.
- UNLESS OTHERWISE INDICATED, CONTRACTOR MAY SPLICE CONTINUOUS SLAB OR
  LONGITUDINAL BEAM BARS AT LOCATIONS OF HIS CHOOSING, EXCEPT THAT TOP BAR SPLICES
  ARE TO BE LOCATED AT MIDSPAN AND BOTTOM BAR SPLICES ARE TO BE LOCATED AT
  SUPPORTS. MINIMUM LAP REQUIREMENTS ARE AS FOLLOWS UNLESS OTHERWISE INDICATED.

LAP LENGTHS* – CONCRETE								
BAR SIZE	#4	#5	#6	#7	#8	#9	#10	#11
CONCRETE DESIGN STRENGTH = 4,000 PSI								
LAP LENGTH 2'-7" 3'-3" 3'-10" 4'-10" 6'-5" 8'-1" 10'-3" 12'-7'								
ASSUMES 2" MINIMUM CLEARANCE TO SURFACE								

#### STRUCTURAL STEEL

- UNLESS NOTED OTHERWISE, PROVIDE STRUCTURAL STEEL CONFORMING TO ASTM A36.
   ROLLED WIDE FLANGE SHAPES TO CONFORM TO ASTM A992. PIPE TO CONFORM TO ASTM A53,
   TYPE E OR S, GRADE B. STRUCTURAL TUBING TO CONFORM TO ASTM A1085. FABRICATE AND
   ERECT ALL STRUCTURAL STEEL IN CONFORMANCE WITH AISC SPECIFICATIONS.
- USE A325 OR F1852 BOLTS FOR STEEL TO STEEL CONNECTIONS, F1554 GR36 FOR ANCHOR BOLTS, AND A307 BOLTS FOR ALL OTHER CONNECTIONS (UNLESS SPECIFIED OTHERWISE ON DRAWINGS). USE 3/4" DIAMETER MINIMUM.
- 3. ALL HIGH-STRENGTH BOLTS SHALL BE INSTALLED IN ACCORDANCE WITH AISC

  "SPECIFICATIONS FOR STRUCTURAL JOINTS USING ASTM A325 OR A490 BOLTS." THE TURN-OFNUT METHOD MAY BE USED. PROVIDE CARBONIZED WASHERS UNDER THE TURNED ELEMENT.

- USE ONLY CERTIFIED WELDERS FOR ALL WELDING WORK. USE FILLER METAL HAVING A MINIMUM TENSILE STRENGTH OF 70 KSI AND PERFORM ALL WORK IN ACCORDANCE WITH THE CURRENT STRUCTURAL WELDING CODE (AWS D1.1).
- UNLESS OTHERWISE NOTED, COAT ALL STRUCTURAL STEEL COMPONENTS WITH PAINT OR OTHER PROTECTIVE COATINGS AS SPECIFIED IN THE PROJECT SPECIFICATIONS.
- 6. MINIMUM THICKNESS FOR GUSSET PLATES IS 3/8 INCH
- 7. STRUCTURAL STEEL, WHICH IS TO BE EMBEDDED INTO CONCRETE TO BE CLEAN AND FREE OF PAINT. OIL. OR DIRT.

#### STAINLESS STEEL

- WHERE REQUIRED, PROVIDE STAINLESS STEEL SHAPES, PLATES, BARS, AND RODS CONFORMING TO ASTM A666 AND A276, TYPE 316 OR 316L.
- 2. PROVIDE STAINLESS STEEL BOLTS AND NUTS CONFORMING TO ASTM F593 AND F594.

#### **ALUMINUM**

- 1. WHERE REQUIRED, PROVIDE ALLOY 6061-T6 FOR ALL ALUMINUM STRUCTURAL MATERIALS.
- COAT ALL ALUMINUM SURFACES IN CONTACT WITH CONCRETE OR DISSIMILAR METALS AS
   DETAILED IN THE SPECIFICATIONS TO PREVENT ALUMINUM-CONCRETE REACTION OR
   FLECTROLYTIC ACTION
- 3. PERFORM ALUMINUM WELDING TO CONFORM TO THE PROVISIONS OF THE LATEST STRUCTURAL WELDING CODE (AWS D1.2).

#### **EPOXY ANCHORS**

- 1. EPOXY ANCHORS SHALL BE AN ADHESIVE ANCHOR SYSTEM AS LISTED BELOW:
- A. HILTI HIT-HY 200 OR HIT-RE 500 V3 FOR CONCRETE
- . HILTI HIT-HY 70 FOR MASONRY
- C. ITW RED HEAD C6+, A7+ OR G5
- D. SIMPSON AT, SET OR SET-3G
- ANCHOR RODS SHALL BE STAINLESS STEEL, DIAMETER AS INDICATED ON DRAWINGS, THREADED AND GALVANIZED.

#### **LOADING CRITERIA**

1.	BUILDING RISK CATEGORY	III
2.	DEAD LOAD	CALCULATED FROM UNIT WEIGHT
3.	LIVE LOADS: VAULT ROOF SLABS	150 PSF
4.	LATERAL EARTH PRESSURE (EFP) NON SATURATED TRAFFIC SURCHARGE HYDROSTATIC FLUID PRESSURE	60 PCF 2 FT OF EARTH 62.4 PCF
5.	SNOW LOAD: GROUND SNOW LOAD FLAT ROOF SNOW LOAD SNOW EXPOSURE COEFFICIENT SNOW IMPORTANCE FACTOR SNOW THERMAL FACTOR	31 PSF 28 PSF 0.9 1.2 1.2
6.	FROST DEPTH:	30 INCHES

2 500 PSF

#### **SPECIAL INSPECTIONS**

7. ALLOWABLE SOIL BEARING CAPACITY

INSPECTIONS TO BE PROVIDED PER UDOT REQUIREMENTS.



		(\$)	
ONSTRUCTION /IEW ONLY			DESCRIPTION

# PIPELINE CAPACITY UPGRADES HERRIMAN AND RIVERTON CITY, UT REVIEW REVIEW BAR IS ONE INCHON CHECKED NOT REVIEW BAR IS ONE INCHON

ROSECREST

ഗ


NOT

STRUCTURAL


DRAWING NO.


GS-01

SHEET 46 OF 78

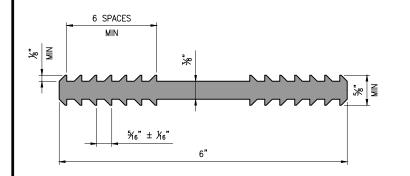



NOTE: WATERSTOP IS PREFORMED PLASTIC ADHESIVE TYPE.

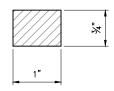

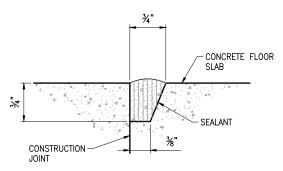

- 1. AT CONTRACTOR'S OPTION, SEALANT GROOVES MAY CONTINUE STRAIGHT ACROSS CONSTRUCTION JOINT INTERSECTION OR BE STAGGERED UPON APPROVAL OF THE ENGINEER.
- 2. NO BOND BREAKER WHERE SEALANT GROVE IS CONSTRUCTED.

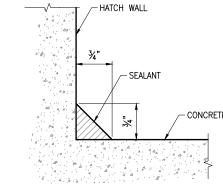

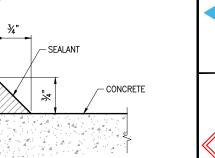

**WATERSTOP** 

**WATERSTOP** 




EXTENSION TO MATCH NORMAL



4007

– ADD



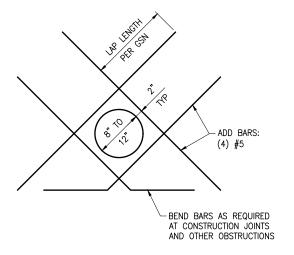

#### **DETAIL NOTES:**

- 1. THIS DETAIL TO BE USED WHEN CALLED FOR ON THE DRAWINGS OR WHEN NO OTHER DETAIL IS SPECIFIED.
- 2. CUT NORMAL REINFORCING 2" CLEAR OF OPENING.
- 3. DIAGONAL BARS TO BE PLACED:

   AT CENTERLINE OF WALL OR SLAB WHERE SINGLE
  MAT OF REINFORCEMENT IS PROVIDED.

   AT EACH FACE OF WALL OR SLAB WHERE TWO MATS
  - OF REINFORCEMENT ARE PROVIDED.
  - NO DIAGONAL REINFORCING REQUIRED FOR OPENINGS SMALLER THAN 8".

# NORMAL REINFORCING PER PLAN INTERRUPTED NORMAL REINFORCING BARS #5x4'-0" DIAGONAL LAP PER

DISTANCE OF 2X WALL/SLAB THICKNESS FROM EDGE OF 3. CUT NORMAL REINFORCING 2"

**DETAIL NOTES:** 

1. THIS DETAIL TO BE USED

WHEN CALLED FOR ON THE DRAWINGS OR WHEN NO OTHER ADDITIONAL

REINFORCING IS SPECIFIED.

2. AREA OF ADD BARS AT EACH EDGE OF OPENING IN EACH

LARGER THAN NORMAL

DIRECTION SHALL MATCH ½
THE CROSS SECTIONAL AREA OF THE INTERRUPTED BARS. BARS UP TO TWO BAR SIZES

REINFORCING MAY BE USED.

FIT ADD BARS WITHIN A

4. PROVIDE STANDARD ACI HOOKS ON BARS/DOWELS IF STRAIGHT EXTENSION PAST THE OPENING CANNOT BE

CLEAR OF OPENING.


5. PLACE ADD BARS IN SAME PLANES AS NORMAL REINFORCING INDICATED.

6. PLACE #5 ADD DIAGONAL CORNER BARS UNDER NORMAL REINFORCING

7. NO ADDITIONAL REINFORCING REQUIRED FOR OPENINGS SMALLER THAN 12" SQUARE.

8. WHEN AN INTERSECTING SLAB OR WALL OCCURS WITHIN ONE WALL/SLAB THICKNESS OF THE EDGE OF OPENING, NO ADD BARS ARE REQUIRED ON THAT SIDE.

## DIAGONAL REINFORCEMENT AT CIRCULAR OPENINGS

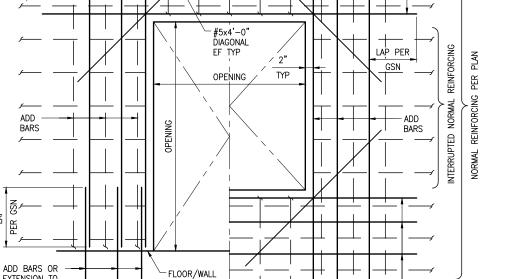


ADDITIONAL REINFORCING AT RECTANGULAR OPENINGS IN WALLS/SLABS

4034


GS-02 SHEET 47 OF 78


JORDAN VALLEY WATER CONSERVANCY DISTRICT
ROSECREST PIPELINE CAPACITY UPGRADES
HERRIMAN AND RIVERTON CITY, UT

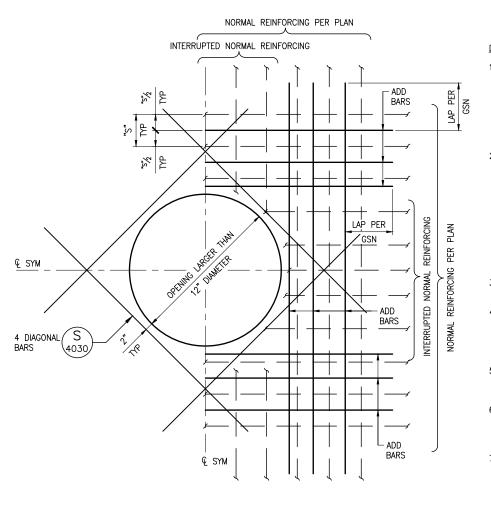

#### **DETAIL NOTES:**

- 1. THIS DETAIL TO BE USED FOR OPENINGS LARGER THAN 12"ø AND WHEN CALLED FOR ON THE DRAWINGS OR WHEN NO OTHER ADDITIONAL REINFORCING IS SPECIFIED. FOR OPENINGS SMALLER THAN 12"ø, USE DETAIL S/4030.
- 2. AREA OF ADD BARS AT EACH EDGE OF OPENING IN EACH DIRECTION SHALL MATCH ½
  THE CROSS SECTIONAL AREA OF THE INTERRUPTED BARS. BARS UP TO TWO BAR SIZES LARGER THAN NORMAL REINFORCING MAY BE USED. FIT ADD BARS WITHIN A DISTANCE OF 2X WALL/SLAB THICKNESS FROM EDGÉ OF
- 3. CUT NORMAL REINFORCING 2" CLEAR OF OPENING.
- 4 PROVIDE STANDARD ACL HOOKS ON BARS/DOWELS IF STRAIGHT EXTENSION PAST THE OPENING CANNOT BE ACHIEVED.
- 5. PLACE ADD BARS IN SAME PLANES AS NORMAL REINFORCING INDICATED.
- 6. PLACE #5 ADD DIAGONAL CORNER BARS UNDER NORMAL REINFORCING INDICATED.
- 7. WHEN AN INTERSECTING SLAB OR WALL OCCURS WITHIN ONE WALL/SLAB THICKNESS OF THE EDGE OF OPENING NO ADD BARS ARE REQUIRED ON THAT SIDE.

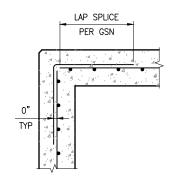


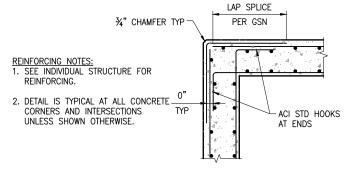


SINGLE-CURTAIN REINFORCING

#### DOUBLE-CURTAIN REINFORCING


#### WALL REINFORCING AT CORNERS

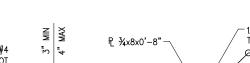

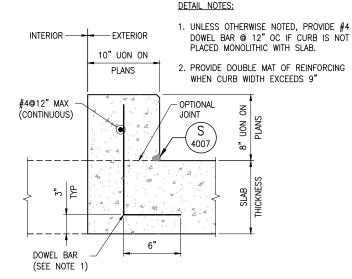

CONCRETE CURB

NOT TO SCALE

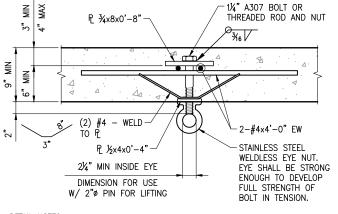

#### **DETAIL NOTES:**

NOT TO SCALE

4041

JFTING EYE

- 1. MAXIMUM LOAD RATING FOR LIFTING EYE IS 7,000 LBS.
- 2. SUBMIT DATA ON EYE BOLT WITH SHOP DRAWINGS.

## ADDITIONAL REINFORCING AT CIRCULAR OPENINGS IN WALLS/SLABS

EQ

EQ

**DETAIL NOTES:** 1. THICKNESS "B" OF SADDLE IS AS FOLLOWS: B=6" WHEN "D" ≤ 24"


B=10" WHEN 24" < "D" < 42" B=12" WHEN D > 42"

PIPE SUPPORT W/ STRAP

PIPE SUPPORT W/O STRAP


2. FOR "B"=10" AND THICKER, USE 2 LAYERS OF REINFORCING AND TURN HOOKS ON HORIZONTAL 4104/STRAP BARS AROUND VERTICAL BARS. WIDTH "B" OF SADDLE, SEE NOTES. ⅓₄" BOLT (4124*)* 34" NEOPRENE BEARING -AS BOTTOM
R OF SLAB
FORCING PAD (DURO 40) #4 BARS 450 #5@12" MAX CLR ~ CONCRETE SLAB-#5@12 MAX PER PLAN

"D"+9" %"ø HOLES⁻ (TYP) · 凡 ½"x6" - 凡½" STIFFENERS (4 REQ'D) 4124 34" BOLT EXTEND TO 2" CLR AT

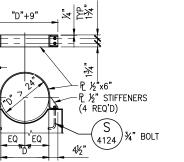

PIPE STRAP NOT TO SCALE

CONST JOINT TYPICAL OPENING REINF AROUND -PIPE SEE S/4036 -EXTEND ENCASEMENT VERTS SLAB THICKNESS AND BEND 1'-0" INTO TOP OF SLAB 2'-0" TYP -2-#5 EACH SIDE BOTTOM "U" SECTION OF TIES CONT TO END OF ENCASEMENT TYPICAL PIPE ENCASEMENT REINF BEND & LAP PIPE ENCASEMENT REINF 1'-0" TYP PROVIDE LEVEL BEARING AREA BELOW VERT PIPE RISER EQUAL TO ENCASEMENT GROSS END AREA COMPACTED GRANULAR

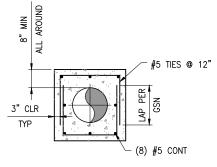

**SECTION** 

SECTION APPLIES TO PIPES W/ DIAMETERS SMALLER THAN 18". FOR 20" DIAMETER PIPES AND LARGER, SEE S/4112.

**ELEVATION** PIPE ENCASEMENT UNDER STRUCTURES

ROSECREST

o g

CAPACITY UPGRADES

IN VALLEY WATER CO.

PIPELINE (
HERRIMAN AND RIV


GS-03 SHEET 48 OF 78


NOT TO SCALE


TOP OF CONCRETE


4101

S

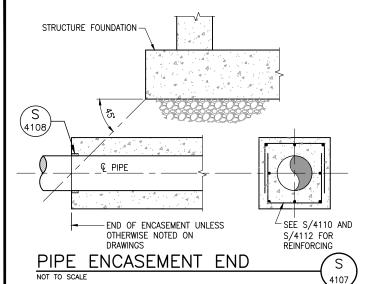

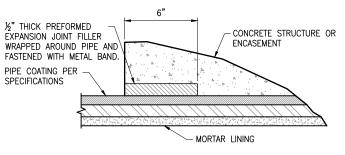

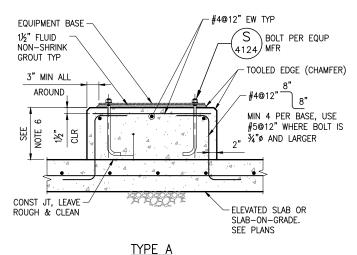

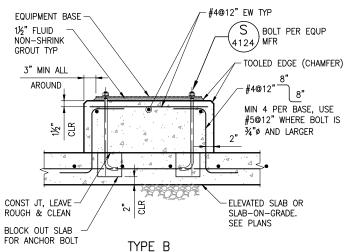

#### PIPE ENCASEMENT END

PIPE ENCASEMENT TABLE									
PIPE DIA (IN)	H = 1	0 FEET	H = 2	0 FEET	FEET H = 30 FEET		H = 40 FEET		
	"t" (IN)	REINF	"t" (IN)	REINF	"t" (IN)	REINF	"t" (IN)	REINF	
20 THRU 30	8	#5@12"	10	#5@12"	10	#5@12"	10	#6@12"	
36 THRU 42	10	#5@12"	10	#6@12"	10	#7@12"	10	#6@6"	
48 THRU 54	10	#6@12"	10	#7@12"	10	#7 <b>@</b> 6"	12	#6@6"	

HEAVY DARK LINE INDICATES BREAK BETWEEN ONE LAYER OF REINFORCING AND TWO. SEE NOTE 2 BELOW

#### **DETAIL NOTES:**

- THIS DETAIL APPLIES TO PIPE DIAMETER OF 20" AND LARGER. FOR SMALLER THAN 20", SEE DETAIL S/4110
- 2. FOR "t"=8" REINFORCING SHALL BE ONE LAYER AND CENTERED IN SLABS OR WALLS SIM S/4110.
- 3. SEE S/4110 FOR ENCASEMENT AT PIPE RISER

TOP OF CONCRETE

- 4. "H" IS FILL HEIGHT OR WATER DEPTH OR COMBINATION ABOVE.
- WHEN PIPE ENCASEMENT IS CLOSER THAN 4" TO SLAB ABOVE, THICKEN SLAB OVER ENCASEMENT TO BEAR DIRECTLY ON ENCASEMENT, CONSTRUCTION JOINT ALLOWED.

"E".

R=3"D"

## **EQUIPMENT PAD NOTES**

- 1. PAD SIZE SHALL BE MINIMUM INDICATED OR AS SHOWN ON THE DRAWINGS. VERIFY ALL PAD SIZE REQUIREMENTS WITH EQUIPMENT SHOP DRAWINGS OF ACTUAL EQUIPMENT FURNISHED AND OBTAIN ENGINEER'S APPROVAL OF FINAL DIMENSIONS.
- THE SIZE, NUMBER, TYPE, LOCATION, AND THREAD PROJECTION OF THE ANCHOR BOLTS SHALL BE DETERMINED BY THE EQUIPMENT MANUFACTURER, AND SHALL BE AS APPROVED BY THE ENGINEER. ANCHOR BOLTS SHALL BE HELD IN POSITION WITH TEMPLATES MATCHING THE EQUIPMENT BASE PLATE, WHILE PAD IS BEING POURED.
- 3. INSTALL EQUIPMENT BASES LEVEL UNLESS SPECIFIED OTHERWISE.
- TYPE "C" DETAIL SHALL BE USED ONLY FOR SLABS ON GRADE AND AT GRADE. THE SURROUNDING FLOOR SLAB SHALL NOT BE PLACED UNTIL THE EXACT SIZE AND LOCATION OF THE EQUIPMENT PAD IS KNOWN.
- WEDGES OR SHIMS SHALL BE USED TO SUPPORT THE BASE WHILE THE NON-SHRINK GROUT IS PLACED. TEMPORARY LEVELING NUTS SHALL BE BACKED OFF. IF LEFT IN PLACE, THE WEDGES AND SHIMS SHALL NOT BE EXPOSED TO VIEW.
- HEIGHT OF PADS SHALL BE MINIMUM REQUIRED FOR ANCHOR BOLT CLEARANCE TO KEEP ANCHOR BOLT OUT OF SLAB (SEE TABLE BELOW). WHERE EQUIPMENT OR PIPING ELEVATIONS REQUIRE A PAD HEIGHT LESS THAN THE MINIMUM SHOWN, USE TYPE B WITH BLOCKOUT.

BOLT DIA (IN)	1/2	5/8	3/4	7∕8	1
MIN PAD HEIGHT	9	11	13	17	21

#### WHEN ANCHORAGE OF EQUIPMENT TO SLAB IS #4@12" EW TYP REQUIRED, USE SST CONCRETE ANCHORS EQUIPMENT BASE TOOLED EDGE (CHAMFER) #4@12" MIN 4 PER BASE PAD HT 2" MIN 6"MAX CONST JT, LEAVE -ROUGH & CLEAN ELEVATED SLAB OR SLAB-ON-GRADE. SEE PLANS

TYPE D

EQUIPMENT PAD DETAILS

#### PIPE ENCASEMENT UNDER STRUCTURES

**SECTION** 

COMPACTED GRANULAR FILL

REINF T&B, SEE TABLE

SEE NOTE 2 FOR "t"=8"

-REINF TYP EACH

- OPTIONAL CONST

ÄLL AROUND

#4@12" LONG TYP

SIDE

JOINT

REINF T&B. SEE TABLE

SEE NOTE 2 FOR "t"=8"

BOTTOM OF SLAB-


. ACE.

3." CLR

"t"

FLOOR SLOPE

SEE NOTE 5

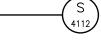


- PROJECTION

AS REQUIRED

4108

I	ANCHOR BOLT SCHEDULE						
I	"D"	"E"	"B"	REMARKS			
I	¾"	1½"	8"				
	½"	1½"	10"				
I	%"	3"	12"				
	¾"	3"	14"				
	%"	4"	16"				
	1"	4"	20"				
1							

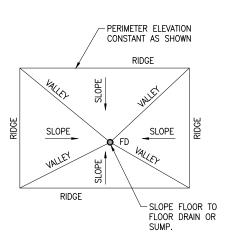


ANCHOR BOLT (TYPE VI)

N VALLEY WATER OF PIPELINE ( ROSECREST DRAWING NO. GS-04

SHEET 49 OF 78

Ö

CAPACITY UPGRADES

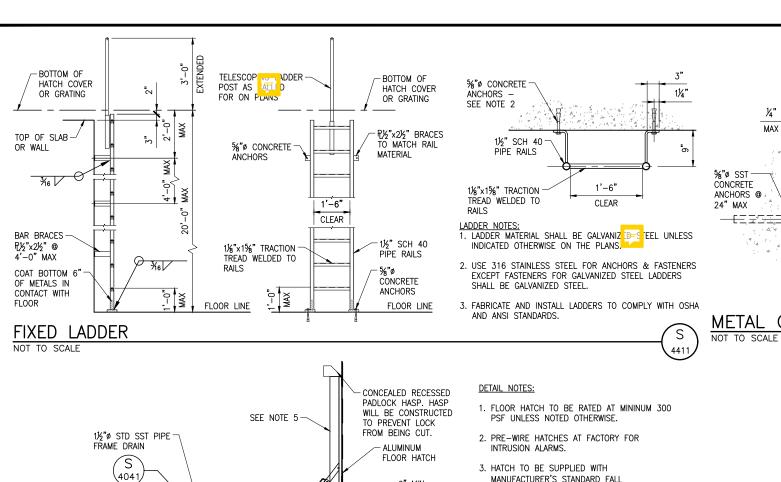

CONCRETE VAULT

STRUCTURE PER

**PLANS** 

1½" 1/4" 1/4" MAX MAX BANDING BAR BANDING BAR GRATING -**見 ¼x"T"** %"ø SST CONCRETE ANCHORS @ / 24" MAX 18" MAX -L3x2x¼ (LLV) OR AS INDICATED ON L3x2x1/4 (LLV) OR AS DRAWINGS INDICATED ON DIMENSIONS SHOWN ON PLANS ARE TO FACE OF CONCRETE METAL GRATING

**DETAIL NOTES:** 

- 1. GRATING DEPTH "T" AS NOTED ON DRAWINGS.
- 2. ALL EDGES AND OPENINGS ARE TO BE BANDED.
- 3. WEIGHT OF INDIVIDUAL GRATING SECTION SHALL NOT EXCEED 80 LBS.
- METAL BEARING BARS ARE TO BE DEPTH "T"x3/16" @ 13/6" OC. CROSS BARS ARE TO BE AT 4" OC.
- PROVIDE A MINIMUM OR 4 CLIPS PER GRATING PANEL AND LOCATE APPROXIMATELY 4" FROM PANEL CORNERS. MAXIMUM SPACING OF CLIPS IS 3'-0".

MATERIALS:

MAILERIALS:
ALUMINUM GRATING — USE ALUMINUM ANGLE SUPPORTS
AND STAINLESS STEEL BOLTS AND CLIPS.
GALVANIZED STEEL GRATING — USE GALVANIZED STEEL
SUPPORTS, BOLTS, AND CLIPS. HOT—DIP GALVANIZE AFTER FABRICATION.

STAINLESS STEEL GRATING - USE 316 STAINLESS STEEL ANGLE SUPPORTS, BOLTS, AND CLIPS.

JORDAN VALLEY WATER CONSERVANCY DISTRICT
ROSECREST PIPELINE CAPACITY UPGRADES
HERRIMAN AND RIVERTON CITY III

GS-05

SHEET 50 OF 78

- MANUFACTURER'S STANDARD FALL
  PROTECTION GRATING, MEETING THE REQUIREMENTS OF OSHA STANDARD 29 CFR
- 4. HARDWARE SHALL BE TYPE 316 STAINLESS
- 5. PREMANUFACTURED LID SHALL BE INSULATED WITH RIGID POLYSTYRENE INSULATION BOARD AND SHALL BE FULLY PROTECTED BY A COVERED LINER. INSULATION SHALL BE INSTALLED BY THE MANUFACTURER AT THE TIME OF FABRICATION.

OPENING PER PLAN

FINISH GRADE

**HATCH** NOT TO SCALE

NO			PIPING (SEE SCHEDU	FIELD TEST REQUIRMENTS (SEE NOTE 3 AND NOTE 4)				
FLUID ABBREVIATION	FUNCTION (SEE NOTE 5)		D PIPING IOTE 14)	1	PIPING NOTE 13)	MIN TEST PRESSURE	. TEST	LEAKAGE ALLOWANCE
ABI		2" DIA & SMALLER	2 1/2 " DIA & LARGER	2" DIA & SMALLER	2 1/2 " DIA & LARGER	PSI	MEDIUM	(SEE NOTE 2
AD	ACID DRAIN	16	16	16	16	NOTE 6	WATER	A, E
AF	ANTI-FREEZE	47				3	3	A, 3
ATF	AUTOMATIC TRANSMISSION FLUID	47				3	3	A, 3
AV	AIR VENT	2, 16, 24, 29	2, 16, 24, 29	16, 24, 29	16, 24, 29	NOTE 7		
BPF	BELT PRESS FEED		11		11	125	WATER	Α
BWW	BELT WASH WATER	2	2	2	2	125	WATER	Α
CTA	CITRIC ACID	16	16	16	16	125	WATER	Α
CLS	CHLORINE SOLUTION	16		16		125	WATER	Α
D	DRAIN	27, 11	11, 12, 27	27	11, 12, 27	NOTE 6	WATER	A, E
FA	FOUL AIR		18, 37		18, 37			
FE	FINAL EFFLUENT				11, 22	15	WATER	Α
FOR	FUEL OIL RETURN	9	9			3	3	A
FOS	FUEL OIL SUPPLY	9	9			3	3	A
FOV	FUEL OIL VENT	9	9			3	3	Α
FSP	FIRE FLOW PROTECTION	NOTE 10	NOTE 10	NOTE 10	NOTE 10	NOTES 3, 9	WATER	
FW	FIRE WATER	52	52	51	51, 11	NOTE 9	WATER	A
GHA	GASEOUS HYDROCHLORIC ACID	41				125 125	AIR WATER	A
GS	GRIT SLURRY	48	48		11	3	WATER 3	A
HF	HYDRAULIC FLUID	24, 50	50	24	2, 24	3	3	A
HW	HOT WATER OUR	50	50	24	24	3	3	A
LO	HOT WATER CIRC	47	47		Z+ 	3	3	A, D
	LUBE OIL MIXED LIQUOR		11		11	125	WATER	Α Α
MLR	MIXED LIQUOR RECYCLE	+	11			125	WATER	A
MO	MOTOR OIL	47	47			3	3	A
NG	NATURAL GAS	9	9			3	3	A
ORD	OVERFLOW ROOF DRAIN	12	12		12	3	3	A
PA	PROCESS AIR		5, 39, 40		5, 39, 40	125	AIR	A
PDR	PLANT DRAIN RETURN		22		22	NOTE 6	WATER	С
PLS	POLYMER SOLUTION	16	16	16	16	125	WATER	Α
PW	POTABLE WATER	2, 16, 24	2, 16, 24,	16, 24	16, 24,	125	WATER	Α
		47	47			3	3	A
PWP	PRESSURE WASH PIPE	<del>  '</del>	11		11	125	WATER	Α
RAS RD	RETURN ACTIVATED SLUDGE ROOF DRAIN	12	12		12	3	3	A
	RAW INFLUENT	1	11		11, 22	12	WATER	A
RW	RAW WATER	2, 16, 24	2, 16, 24	16, 24	8, 16	AS NOTED	WATER	A
SD	STORM DRAIN	4, 12	4, 12	12	22	NOTE 7		
SE	SECONDARY EFFLUENT		11		11	125	WATER	A
SMP	SAMPLE	15, 16, 18,		15, 16, 18,		125	WATER	Α
SPD	SUMP PUMP DISCHARGE	24	16, 26	24 2, 16	16, 26	50	WATER	A
SS	SANITARY SEWER	11,12	11, 12		12,22,27	NOTE 18	AIR	
SV	SANITARY VENT	11, 27	11, 12, 27	27	11, 12, 27	NOTE 6	WATER	A
SSC	SECONDARY SCUM		11		11	125	WATER	A
ST	SEPTAGE		11		11	125	WATER	Α
SW	SEAL WATER	24		24		25	WATER	Α
TW	TEMPERED WATER	50	50	24	24	3	3	
UD	UNDER DRAIN				27, 33			
UW	UTILITY WATER	2, 16, 24	2, 11, 16	2, 16, 24	2, 11, 16	125	WATER	
V	VENT	16, 24, 29	2, 16, 29	16, 24, 29	2, 16, 29	15 IN HG	NOTE 7	A, E
WAS	WASTE ACTIVATED SLUDGE		11		11	125	WATER	A
WO	WASTE OIL	47	47			3	3	A
		47	47			3	3	A

PIPE MATERIAL SCHEDULE 1 OI	)F 2
-----------------------------	------

ROUP	PIPE	PIPE MATERIAL SCHEDULE (SEE NOTE 4)  FITTINGS	VALVES
NO.	STEEL, ASTM 53 SCHEDULE 40, BLACK WELDED.		BRONZE, THREADED, GATE, GLOBE, CHECK,
1	STEEL, ASIM 33 SCHEDULE 40, BLACK WELDED.	2-1/2 INCH AND SMALLER, MALLEABLE IRON, ANSI B16.3. THREADED, BANDED, BLACK, 150 PSI OR STEEL, ANSI B16.9 BUTT-WELDED. 3-INCH AND LARGER, CAST IRON, ANSI B16.1, 125 PSI FLANGED OR MECHANICAL COUPLINGS.	STEEL LUBRICATED PLUG, ECCENTRIC PLUG.
2	STEEL, ASTM 53 SCHEDULE 40, GALVANIZED.	2-1/2 INCH AND SMALLER, MALLEABLE IRON, ANSI B16.3, THREADED, BANDED, GALVANIZED 150 PSI, 3 INCH AND LARGER, CAST IRON ANSI B16.1, 125 PSI FLANGED OR MECHANICAL COUPLINGS.	2-1/2 INCH AND SMALLER, ECCENTRIC PLUG SYNTHETIC RUBBER FACED, AWWA C500, BUTTERFLY, AWWA, FLANGED.
3	STEEL, ASTM A106 OR A53, SCHEDULE 80, SEAMLESS, BLACK.	FORGED STEEL, ANSI B16.11, SOCKET WELDED OR THREADED, BLACK, 2000 PSI, OR STEEL, ANSI B16.9, BUTT—WELDED, SCHEDULE 80.	CAST IRON, LUBRICATED PLUG.
4	STEEL, ASTM 53 SCHEDULE 40, BLACK WELDED.	CAST IRON, ANSI B16.12, THREADED, DRAINAGE PATTERN.	
5	WELDED STEEL, AWWA C200, UNLINED.	WELDED STEEL, FABRICATED, AWWA C200, UNLINED.	AS INDICATED ON DRAWINGS.
6	STEEL, ASTM A106, OR A53, SCHEDULE 40, SEAMLESS, BLACK.	STEEL, ANSI B16.9, BUTT-WELDED, CAST IRON, ANSI B16.1, 125 PSI, FLANGED, FORGED STEEL, SOCKET WELDED, ANSI B16.11, 2000 PSI OR STEEL, ANSI B16.5, 150 PSI FLANGED.	CAST IRON, FLANGED, LUBRICATED PLUG.
7	STEEL, ASTM 53 SCHEDULE 40, GALVANIZED.	MALLEABLE IRON, ANSI B16.3, THREADED, BANDED, GALVANIZED, 300 PSI.	BRONZE, THREADED GLOBE, BALL, CHECK.
8	WELDED STEEL, AWWA C200.	WELDED, STEEL, AWWA C200, FABRICATED.	AS INDICATED ON DRAWINGS.
9	STEEL, ASTM 53 SCHEDULE 40, BLACK WELDED GRADE B, WALL THICKNESS OF WROUGHT STEEL PIPE.	2-1/2 INCH AND SMALLER, MALLEABLE IRON, ANSI B16.3, THREADED, BANDED, BLACK, 150 PSI, 3-INCH AND LARGER, STEEL. ANSI B16.9, BUTT-WELDED.	ECCENTRIC PLUG, SEE SPECIFICATIONS FOR VALVES USED IN FUEL SYSTEM.
10	STEEL, ASTM A106 OR A53, SCHEDULE 80, SEAMLESS, BLACK.	1-1/4 INCH AND SMALLER, FORGED STEEL, ANSI B16.11, THREADED OR SOCKET WELDED, BLACK, 3000 PSI, WITH FLANGED AMMONIA UNIONS. 1-1/2 INCH AND LARGER, STEEL, ANSI B16.9, BUTT-WELDED OR FLANGED, SCHEDULE 80.	SEMI-PLUG AND YOKE TYPE OR BALL FOR CHLORINE SERVICE, FORGED CARBON STEEL.
11	DUCTILE IRON, ANSI A21.51, (AWWA C151), CLASS 51 (350 PSI), BELL AND SPIGOT, MECHANICAL JOINTS, MECHANICAL COUPLINGS (AWWA C111), OR 125 PSI FLANGED (TYPICAL SERVICE – WATER LINES) PER SPECIFICATION SECTION 02565.	DUCTILE IRON OR CAST IRON, ANSI A21.10 OR AWWA C110, BELL AND SPIGOT, MECHANICAL COUPLINGS, FLANGED OR MECHANICAL JOINTS (AWWA C111), 250 PSI (PRESSURE RATING) 12—INCHES AND SMALLER, 150 PSI (PRESSURE RATING) 14—INCHES AND LARGER, WITH 125 PSI ANSI B16.1 FLANGES.	GATE, AWWA C900, 'O' RING SEALS, MECHANICAL JOINT ENDS, BUTTERFLY C-504.
12	CAST IRON SOIL, ANSI/ASTM A-74, SERVICE WEIGHT, BELL AND SPIGOT OR HUBLESS, AT THE OPTION OF THE CONTRACTOR, DUCTILE IRON (GROUP NO. 11) MAY BE SUBSTITUTED.	CAST IRON SOIL, ANSI/ASTM A-74, SERVICE WEIGHT, BELL AND SPIGOT OR HUBLESS. AT THE OPTION OF THE CONTRACTOR, DUCTILE IRON (GROUP NO. 11) MAY BE SUBSTITUTED.	AS INDICATED ON DRAWINGS.
13	CORROSION RESISTANT (HIGH SILICON CONTENT) CAST IRON, SERVICE WEIGHT, BELL AND SPIGOT OR HUBLESS.	CORROSION RESISTANT (HIGH SILICON CONTENT) CAST IRON, SERVICE WEIGHT, BELL AND SPIGOT OR HUBLESS.	
14	STAINLESS STEEL, TYPE 316, ASTM A312, SCHEDULE 40S.	STAINLESS STEEL, TYPE 316 ANSI B16.3, SCREWED, 150 PSI, ANSI B16.9, BUTT-WELDED, SCHEDULE 40S, OR 150 PSI FLANGED.	STAINLESS STEEL, BALL, FLANGED, CHECK, LADISH, AS SHOWN ON DRAWINGS.
15	STAINLESS STEEL, TYPE 316, ASTM A312, SCHEDULE 40S.	STAINLESS STEEL, TYPE 316 ANSI B16.9, BUTT-WELDED SCHEDULE 10S OR 150 PSI FLANGED.	STAINLESS STEEL, AS INDICATED ON DRAWING
16	POLYVINYL, CHLORIDE, SCHEDULE 80, NORMAL IMPACT, ASTM D1785.	POLYVINYL CHLORIDE, SCHEDULE 80, NORMAL IMPACT, SOCKET SOLVENT WELD JOINTS, ASTM D2467.	POLYVINYL CHLORIDE, BALL, DIAPHRAGM, BUTTERFLY, BALL OR LIFT CHECK.
17	POLYPROPYLENE, ASTM D4101, SCHEDULE 40, WITH HEAT FUSED JOINTS.	POLYPROPYLENE, SCHEDULE 40, DRAINAGE TYPE WITH HEAT FUSED SOCKET JOINTS.	
18	FIBERGLASS REINFORCED PLASTIC, ASTM D2996, FILAMENT WOUND, SOCKET AND SPIGOT ENDS, ADHESIVE BONDED.	FIBERGLASS REINFORCED PLASTIC, FILAMENT—WOUND, SOCKET ENDS, ADHESIVE BONDED, OR FIBERGLASS FLANGED.	PLASTIC LINED, FLANGED, FLANGES TO MATCH 150 PSI ANSI B16.5 DIMENSIONS, OR AS INDICATED ON DRAWINGS.
19	POLYVINYL CHLORIDE PRESSURE PIPE ASTM D2241 WITH BELL AND SPIGOT JOINTS.	CAST IRON, 150 PSI, FOR POLYVINYL CHLORIDE PIPE, AWWA C110 CEMENT MORTAR LINED, AWWA C104.	GATE, AWWA C500, 'O' RING SEALS, MECHANICAL JOINT ENDS, BUTTERFLY, AWWA C504, ECCENTRIC PLUG, BALL.
20	NOT USED.	NOT USED.	NOT USED.
21	NOT USED.	NOT USED.	NOT USED.
22	REINFORCED CONCRETE, ASTM C76, GASKETED.  TEMPERED GLASS, (ARMORED, WHERE BURIED). ANSI/ASTM	SAME AS GROUP NO. 8.  TEMPERED GLASS DRAINAGE TYPE WITH COMPRESSION COUPLINGS	 
23	COPPER, ASTM B88, TYPE K, SOFT TEMPERED WHERE	AND TEFLON JOINTS, ANSI/ASTM C599 (ARMORED WHERE BURIED).  WROUGHT COPPER OR CAST BRONZE, ANSI B16.22, SOLDER	BRONZE, SOLDER JOINT, GLOBE, CHECK, GAT
24	BURIED, HARD TEMPERED WHERE EXPOSED.	WINDUSTI COPPER OR CAST BROWSE, ANSI BIOLOZ, SOLDER JOINT, 150 PSI, OR COMPRESSION FITTINGS, (FOR OXYGEN PIPING USE SILVER SOLDER, FOR COMPRESSED AIR PIPING USE 95–5 TIN–ANTIMONY SOLDER).	SEE SPECIFICATIONS.
25	STEEL, ASTM A106 OR A53, SCHEDULE 40, SEAMLESS, BLACK, SARAN OR POLYPROPYLENE-LINED.	STEEL, ANSI B16.5, 150 PSI FLANGED, SARAN OR POLYPROPYLENE—LINED.	CAST STEEL PLUG, DIAPHRAGM OR CHECK, 1 PSI FLANGED, SARAN OR POLYPROPYLENE—LINED.
26	SAME AS GROUP NO. 11 (TYPICAL SERVICE - SLUDGE AND SEWAGE LINES).	DUCTILE IRON OR CAST IRON, ANSI A21.10 OR AWWA C110, BELL AND SPIGOT, MECHANICAL COUPLINGS, FLANGED OR MECHANICAL JOINTS (AWWA C111), 250 PSI (PRESSURE RATING) 12-INCHES AND SMALLER, 150 PSI (PRESSURE RATING) 14-INCHES AND LARGER, WITH 125 PSI ANSI B16.1 FLANGES.	SEE VALVE SCHEDULE AND SPECIFICATIONS.
27	POLYVINYL CHLORIDE GRAVITY SEWER PIPE, SDR 35 ASTM D3034, BELL AND SPIGOT.	POLYVINYL CHLORIDE, ANSI/ASTM D3034 & F679, BELL AND/OR SPIGOT, DRAIN, WASTE, AND VENT.	
28	REINFORCED CONCRETE, AWWA C302, CLASS— SEE DRAWINGS. (TYPICAL SERVICE — PRESSURE PIPELINES).	SAME AS GROUP NO. 8.	AS INDICATED ON DRAWINGS.
29	STEEL, ASTM 53 SCHEDULE 40, BLACK WELDED.	2-INCH AND SMALLER, MALLEABLE IRON, ANSI B16.3, THREADED, BANDED, BLACK, 150 PSI, 2-1/2 INCH AND LARGER, STEEL ANSI B16.9, BUTT-WELDED.	SAME AS GROUP NO. 1, EXCEPT LUBRICATED PLUG SEE SPECIFICATIONS.
30	SAME AS GROUP NO. 11, GLASS-LINED OR STEEL ASTM A120, SCHEDULE 40, GLASS-LINED.	SAME AS GROUP NO. 11, GLASS-LINED OR STEEL, ANSI B16.9, SCHEDULE 40, GROOVED WITH MECHANICAL COUPLINGS, GLASS-LINED.	SEE SPECIFICATIONS.
31	2-1/2 INCH AND SMALLER, STEEL, ASTM A106 OR A53, SCHEDULE 80, SEAMLESS, BLACK. 3-INCH AND LARGER DUCTILE IRON, ANSI A21.51 (AWWA C151) OR CAST IRON ANSI A21.56 OR A21.8 MECHANICAL COUPLINGS OR 125	2-1/2 INCH AND SMALLER, FORGED STEEL, ANSI B16.11, SOCKET-WELDED OR THREADED, BLACK, 2000 PSI, OR STEEL, ANSI B16.9, BUTT-WELDED SCHEDULE 80. 3-INCH AND LARGER, DUCTILE IRON OR CAST IRON, ANSI A21.10 OR AWWA C110, MECHANICAL COUPLING OR 125 PSI FLANGED.	CAST IRON, LUBRICATED PLUG.




ים יים		MATERIAL SCHEDULE (SEE NOTE 4)	I
ROUP NO.	PIPE	FITTINGS	VALVES
20	REINFORCED CONCRETE, AWWA C302, CLASS— SEE DRAWINGS. (TYPICAL SERVICE — PRESSURE PIPELINES).	SAME AS GROUP NO. 8.	AS INDICATED ON DRAWINGS.
29	STEEL, ASTM 53 SCHEDULE 40, BLACK WELDED.	2—INCH AND SMALLER, MALLEABLE IRON, ANSI B16.3, THREADED, BANDED, BLACK, 150 PSI, 2—1/2 INCH AND LARGER, STEEL ANSI B16.9, BUTT-WELDED.	SAME AS GROUP NO. 1, EXCE LUBRICATED PLUG SHALL BE ROCKWELL FIG. 114 OR 115, POWELL FIG. 2202 OR 2203.
30	SAME AS GROUP NO. 11, GLASS-LINED OR STEEL ASTM A120, SCHEDULE 40, GLASS-LINED.	SAME AS GROUP NO. 11, GLASS-LINED OR STEEL, ANSI B16.9, SCHEDULE 40, GROOVED WITH MECHANICAL COUPLINGS, GLASS-LINED.	SEE SPECIFICATIONS.
31	2-1/2 INCH AND SMALLER, STEEL, ASTM A106 OR A53, SCHEDULE 80, SEAMLESS, BLACK. 3-INCH AND LARGER DUCTILE IRON, ANSI A21.51 (AWWA C151) OR CAST IRON ANSI A21.56 OR A21.8 MECHANICAL COUPLINGS OR 125 PSI FLANGED.	2-1/2 INCH AND SMALLER, FORGED STEEL, ANSI B16.11, SOCKET-WELDED OR THREADED, BLACK, 2000 PSI, OR STEEL, ANSI B16.9, BUTT-WELDED SCHEDULE 80. 3-INCH AND LARGER, DUCTILE IRON OR CAST IRON, ANSI A21.10 OR AWWA C110, MECHANICAL COUPLING OR 125 PSI FLANGED.	CAST IRON, LUBRICATED PLUG ROCKWELL FIG. 142 OR 143, POWELL FIG. 2200 OR 2201.
32	PVC TYPE 1, GRADE 1, 18 ASTM D-1784 AWWA C-905.	SHORT BODY CAST IRON OR DUCTILE IRON AWWA C110.	GATE, AWWA C-500, 'O' RING SEALS, MECHANICAL JOINT ENI BUTTERFLY C-504, ECCENTRIC PLUG.
33	CORRUGATED HDPE SLOTTED, SPLIT COUPLING JOINTS.	FABRICATED OR MOLDED.	
34	FIBERGLASS DOUBLE CONTAINMENT (FOR USE WITH	FIBERGLASS.	AS PER MANUFACTURER'S
35	FLAMMABLE LIQUIDS) SEE SPECS.  CENTRIFUGALLY CAST FIBERGLASS REINFORCED POLYMER MORTAR PIPE, SN-46, PER ASTM D3262 WITH FILAMENT WOUND SLEEVE COUPLINGS WITH ELASTOMERIC MEMBRANE	SAME MATERIAL, CONSTRUCTION AND JOINT DESIGN AS THE MAIN SEWER PIPE.	RECOMMENDATIONS.
36	GASKET JOINTS PER ASTM D-4161. HIGH DENSITY POLYETHYLENE WATER PIPE PER AWWA C-901, 2 INCHES AND SMALLER, DR-7, 200 PSI,	BRASS COMPRESSION OR PACK-JOINT FITTINGS MEETING AWWA COO. USE BRASS DOUBLE STRAP SERVICE SADDLES WITH CC	BRASS CORPORATION STOPS, CURB STOPS PER AWWA C-80
37	MEETING ASTM PE3406—3408, TABLE 6.  HIGH DENSITY POLYETHYLENE PIPE PER AWWA PE 4710, C-906, SDR-11 MEETING ASTM D3350, ASTM F-714. JOINTS SHALL BE BUTT FUSION PER ASTM D2657 AND MANUFACTURER'S RECOMMENDATIONS, TO PROVIDE HEAT WELD AS STRONG AS PIPE WALL.	THREAD.  SAME MATERIAL, CONSTRUCTION AND JOINT DESIGN AS THE MAIN PIPE.	
38	POLYVINYL CHLORIDE, DR-PER PLAN, AWWA C-900, MADE TO DUCTILE IRON O.D. FOR "PUSH-ON" JOINTS. JOINTS SHALL BE BELL AND SPIGOT WITH ELASTOMERIC GASKET MEETING REQUIREMENTS OF ASTM D3139.	DUCTILE IRON, CLASS 250, MEETING AWWA C-110 WITH CEMENT LINING PER AWWA C-104 AND 1-MIL BITUMINOUS TAR COATING. JOINTS SHALL BE MECHANICAL JOINTS MEETING AWWA C-111. DUCTILE IRON FITTINGS SHALL BE WRAPPED IN POLYETHYLENE ENCASEMENT PER AWWA C-105.	SEE SPECIFICATIONS.
39	STAINLESS STEEL, TYPE 304L, ASTM A774, SCH 105, 6-INCH AND SMALLER.	STAINLESS STEEL, TYPE 304L, ANSI B16.9 BUTTWELDED, SCH 105 OR 150 PSI FLANGED.	STAINLESS STEEL, AS INDICATE ON DRAWINGS.
40	STAINLESS STEEL, TYPE 304L ASTM A774,	STAINLESS STEEL, TYPE 304L, ANSI B16.9 BUTTWELDED, SCH 5S	STAINLESS STEEL, AS INDICATE
41	SCH 5S, 8-INCH AND LARGER.  MONEL TUBING, SERIES 400.	OR 150 PSI FLANGED.  MONEL COPRESSION FITTINGS.	ON DRAWINGS.  STAINLESS STEEL, TYPE 316,
41	STEEL, ASTM A 53/A 53M, TYPE E OR S, GRADE B,	1. MALLEABLE—IRON THREADED FITTINGS: ASME B16.3, CLASS	BALL VALVES.  SEE SPECIFICATIONS.
42	SCHEDULE 40, BLACK. WALL THICKNESS OF WROUGHT-STEEL PIPE SHALL COMPLY WITH ASME B36.10M.	150, STANDARD PATTERN, WITH THREADED ENDS ACCORDING TO ASME B1.20.1. 2. STEEL THREADED FITTINGS: ASME B16.11, FORGED STEEL WITH THREADED ENDS ACCORDING TO ASME B1.20.1. 3. UNIONS: ASME B16.39, CLASS 150, MALLEABLE IRON WITH BRASS—TO—IRON SEAT, GROUND JOINT, AND THREADED ENDS ACCORDING TO ASME B1.20.1. 4. GASKET MATERIAL: THICKNESSS, MATERIAL, AND TYPE SUITABLE FOR FUEL OIL.	
43	FLEXIBLE UL 971 COMPLIANT, DOUBLE-CONTAINMENT PIPING. CARRIER PIPE PVDF COMPLYING WITH ASTM D 3222. CONTAINMENT PIPE PE ASTM D 4976.	PLASTIC TO STEEL PIPE TRANSITION FITTINGS: FACTORY—FABRICATED FITTINGS WITH PLASTIC END MATCHING OR COMPATIBLE WITH CARRIER PIPING, AND STEEL PIPE END COMPLYING WITH ASTM A 53/A 53M, BLACK STEEL, SCHEDULE 40, TYPE E OR S, GRADE B.	SEE SPECIFICATIONS.
44	PVC_SOLID_WALL_PIPE, ASTM_D_2665. DRAIN, WASTE, AND	PVC SOCKET FITTINGS: ASTM D 2665, SOCKET TYPE, MADE TO	SEE SPECIFICATIONS.
45	VENT.  STAINLESS STEEL PIPE, ASTM A312, TYPE 304/304L, FULL FINISHED ANNEALED AND CERTIFIED FOR USE WITH THE VIC-PRESS 304 PIPING SYSTEM.  1. AVAILABLE MANUFACTURERS: SUBJECT TO COMPLIANCE WITH REQUIREMENTS, MANUFACTURERS OFFERING PRODUCTS THAT MAY BE INCORPORATED INTO THE WORK INCLUDE, BUT ARE NOT LIMITED TO, THE FOLLOWING:  1.1. VICTAULIC COMPANY, VIC-PRESS 304.  1.2. OR EQUAL.	ASTM D 3311, DRAIN, WASTE, AND VENT PATTERNS.  PRESSURE FIT FITTINGS AND CONNECTION FOR PIPING SYSTEMS 2-INCH AND SMALLER, FITTINGS SHALL BE PRECISION, COLD DRAWN, AUSTENITIC STAINLESS STEEL WITH ELASTOMERIC O-RING SEALS, AND PRESSURE-SEALED ENDS.	SEE SPECIFICATIONS.
46	HARD COPPER, ASTM B88, TYPE L AND ASTM B 88, TYPE M DRAWN TEMPER.	1. CAST-COPPER SOLDER-JOINT FITTINGS: ASME B16.18, PRESSURE FITTINGS. 2. WROUGHT-COPPER SOLDER-JOINT FITTINGS: ASME B16.22, WROUGHT-COPPER PRESSURE FITTINGS. 3. BRONZE FLANGES: ASME B16.24, CLASS 150, WITH SOLDER-JOINT ENDS. 4. COPPER UNIONS: MSS SP-123, CAST-COPPER-ALLOY, HEXAGONAL-STOCK BODY, WITH BALL-AND-SOCKET, METAL-TO-METAL SEATING SURFACES, AND SOLDER-JOINT OR THREADED ENDS. 5. COPPER PRESSURE-SEAL-JOINT FITTINGS: a. MANUFACTURES: SUBJECT TO COMPLIANCE WITH REQUIREMENTS, PROVIDE PRODUCTS BY ONE OF THE FOLLOWING: 1) ELKHART PRODUCTS CORPORATION; INDUSTRIAL DIVISION. 2) NIBCO INC. 3) VIEGA; PLUMBING AND HEATING SYSTEMS. b. NPS 2 AND SMALLER: WROUGHT-COPPER FITTING WITH EPDM-RUBBER O-RING SEAL IN EACH END.	SEE SPECIFICATIONS.
47	CARBON STEEL PIPE, FULLY ANNEALED, SEAMLESS C 1010 CARBON STEEL HYDRAULIC TUBING. ABOVEGROUND PIPING SIZE WALL THICKNESS PSI WORKING 5/8" 0.058 2550 3/4" 0.065 2350 7/8" 0.072 2200 1" 0.083 2250 1 1 1/4" 0.109 2350	FEROLUK "BITE TYPE" COMPRESSION FITTINGS RATED AT MINIMUM 6,000 PSI WORKING PRESSURE MANUFACTURED BY PARKER HANNIFAN CORP OR APPROVED EQUAL.	SEE SPECIFICATIONS.
	1 1/2" 0.134 2450		

	PIPE MATERIAL SCHEDULE (SEE NOTE 4)									
GROUP NO.	PIPE	FITTINGS	VALVES							
49	STEEL PIPE SHALL CONFORM TO ASTM A53/A 53M, TYPE E OR S, GRADE B, BLACK OR HOT-DIPPED ZINC COATED WITH ENDS THREADED ACCORDING TO ASME B1.20.1.  1. AVAILABLE MANUFACTURERS: SUBJECT TO COMPLIANCE WITH REQUIREMENTS, MANUFACTURERS OFFERING PRODUCTS THAT MAY BE INCORPORATED INTO THE WORK INCLUDE, BUT ARE NOT LIMITED TO, THE FOLLOWING:  1.1. ANVIL INTERNATIONAL, INC.  1.2. STAR PIPE PRODUCTS	GROVED-END FITTINGS: ASTM A 47/A 47M, MALLEABLE-IRON CASTINGS OR ASTM A536 DUCTILE IRON CASTING; WITH GROOVES ACCORDING TO AWWA C606 AND DIMENSIONS MATCHING STEEL PIPE.  COUPLINGS: AWWA C606 OR UL 213, FOR STEEL PIPE DIMENSIONS AND RATED FOR 300 PSIG MINIMUM WORKING PRESSURE. INCLUDE FERROUS HOUSING SECTIONS, GASKET SUITABLE FOR COMPRESSED AIR, AND BOLTS, AND NUTS. PROVIDE EPDM GASKETS FOR OIL FREE COMPRESSED AIR. PROVIDE NBR GASKETS IF COMPRESSED AIR CONTAINS OIL OR OIL VAPOR.	SEE SPECIFICATIONS.							
50	COPPER TUBE SHALL CONFORM TO ASTM B 88, TYPE L SEAMLESS, DRAWN-TEMPER.  1. COPPER UNIONS: ASME B16.24, OR MSS SP-123 2. PRESS-TYPE FITTINGS, NPS 2 AND SMALLER: WROUGHT-COPPER FITTING WITH EPDM O-RING SEAL IN EACH END.  3. AVAILABLE MANUFACTURERS: SUBJECT TO COMPLIANCE WITH REQUIREMENTS, MANUFACTURERS OFFERING PRODUCTS THAT MAY BE INCORPORATED INTO THE WORK INCLUDE, BUT ARE NOT LIMITED TO, THE FOLLOWING:  3.1. VICTAULIC TRANSITION COUPLINGS FOR METAL PIPING: MEAL COUPLING OR OTHER MANUFACTURED FITTING SAME SIZE AS, WITH PRESSURE RATING AT LEAST EQUAL TO AND ENDS COMPATIBLE WITH, PIPING TO BE JOINED.		SEE SPECIFICATIONS.							
51	CLASS 51 CEMENT LINED DUCTILE IRON PIPE.	MECHANICAL JOINT TYPE FITTINGS.	SEE SPECIFICATIONS.							
52	SCHEDULE 40 GALVANIZED PIPING WITH INTERIOR ANTIBACTERIAL COATING.	GALVANIZED CAST IRON THREADED FITTINGS JOINED WITH TEFLON TAPE THREAD SEALING COMPOUND. FITTINGS FOR GROOVED END PIPE SHALL BE IN ACCORDANCE WITH NFPA 13.	SEE SPECIFICATIONS.							

#### **GENERAL NOTES:**

1. ALTHOUGH SEVERAL PIPING MATERIALS ARE SHOWN THAT MAY BE USED FOR A GIVEN FUNCTION, ONLY THE CALLED OUT PIPING MATERIAL SHOWN ON THE CONSTRUCTION DRAWINGS AND SPECIFICATION SHALL BE USED. THE CONTRACTOR DOES NOT HAVE THE OPTION TO USE A DIFFERENT MATERIAL.

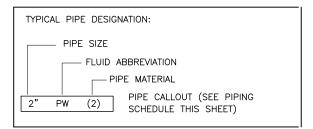

#### **MATERIAL SCHEDULE:**

- PROPRIETARY NAMES HAVE BEEN QUOTED FOR IDENTIFICATION PURPOSES ONLY. SUBSTITUTIONS WILL BE PERMITTED SUBJECT TO REQUIREMENTS OF THE SPECIFICATIONS.
- 2. LEAKAGE ALLOWANCE IS AS FOLLOWS: (A) PIPES SO DESIGNATED SHALL SHOW ZERO LEAKAGE.
  - (B) PIPES SO DESIGNATED SHALL SHOW ZERO LEAKAGE FOR UNBURIED PIPE AND NOT MORE THAN 0.002 GALLON PER HOUR PER INCH DIAMETER PER 100 FEET OF BURIED PIPE.
  - (C) PIPES SO DESIGNATED SHALL NOT SHOW A LEAKAGE OF MORE THAN 0.15 GALLON PER HOUR PER INCH OF DIAMETER PER 100 FEET OF PIPE.
  - (D) PIPES SO DESIGNATED SHALL NOT SHOW A LOSS OF PRESSURE OF MORE THAN 5 PERCENT.
  - (E) PIPES SO DESIGNATED SHALL NOT SHOW A LOSS OF VACUUM OR MORE THAN 4 INCHES MERCURY
- 3. FOR FIELD TEST PROCEDURES AND ADDITIONAL TEST REQUIREMENTS, SEE PIPING SECTION OF SPECIFICATIONS.
- 4. ANY DEVIATION FROM THE PIPING MATERIALS OR FIELD TEST REQUIREMENTS SHOWN WILL BE NOTED IN THE SPECIFICATIONS OR ON THE DRAWINGS.
- 5. PIPING GROUP NUMBER SHOWN THUS \* SHALL BE INSULATED, SEE PIPING SECTION OF SPECIFICATIONS FOR INSULATING MATERIALS.
- 6. STATIC WATER TEST WITH SURFACE 5 FEET ABOVE HIGH
- 7. INSPECTION AND TESTING SHALL BE IN ACCORDANCE WITH APPLICABLE PLUMBING CODE.

- 8. NO APPARENT LEAKS UNDER NORMAL OPERATING CONDITIONS.
- 9. INSPECTION AND TESTING SHALL BE IN ACCORDANCE WITH APPLICABLE NATIONAL FIRE PROTECTION ASSOCIATION
- 10. PIPING MATERIALS SHALL BE IN ACCORDANCE WITH NATIONAL FIRE PROTECTION ASSOCIATION STANDARDS.
- 11. FOR VALVES 4 INCHES AND LARGER SEE VALVE SCHEDULE. FOR SPECIAL VALVES SEE SPECIFICATIONS.
- 12. CHANGE IN PIPING MATERIAL GROUP NUMBER IS INDICATED, THUS: 🔷
- 13. FOR PIPE LINING AND COATING, SEE SPECIFICATIONS.
- 14. EXPOSED PIPING SHALL BE PAINTED IN ACCORDANCE WITH SPECIFICATIONS. COLORS TO BE SELECTED BY
- 15. PIPING MATERIAL SHALL BE NON-ABRASIVE FLEXIBLE RUBBER HOSE AND QUICK CONNECTION COUPLINGS WITH GROUP NO. 1 AT EQUIPMENT.
- 16. VALVES 2-1/2 INCH AND SMALLER MAY HAVE SCREWED ENDS VALVES 3 INCH AND LARGER SHALL HAVE FLANGED ENDS. UNLESS OTHERWISE SHOWN OR SPECIFIED.
- 17. NO PVC PIPE FOR DRAIN OR SANITARY SEWER PLUMBING PIPE MAY BE USED ABOVE GROUND OR BELOW GROUND FOR PLUMBING PURPOSES.
- 18. FOR COMPRESSED AIR PIPING ON PLUMBING DRAWINGS, SEE SPECIFICATIONS.

PIPE MATERIAL SCHEDULE 2 OF 2



NOT FOR CONSTRUCT FOR REVIEW ONLY				Talacsara Na Va	REVISIONS	
PISTRICT Y UPGRADES	Л	VERIFY SCALE	NO HONE INCHON			
JORDAN VALLEY WATER CONSERVANCY DISTRICT REST PIPELINE CAPACITY UPGRADES	HERRIMAN AND RIVERTON CITY, UT	REVIEW		CHECKED J. LUETTINGER	APPROVED J. LUETTINGER	
JORDAN V.	HE			\ \		

2 SCHEDUL **PIPING** 

M-02 SHEET 52 OF 78

	AIR VALVE SCHEDULE										
VALVE NO.	STATION/LOCATION	DRAWING NO.	ELEVATION	WORKING PRESSURE (PSI)	TEST PRESSURE (PSI)	AIR VALVE SIZE (INCH)	AIR VALVE TYPE	AIR VALVE VENT PIPE & ISOLATION VALVE DIA (INCH)	NOTES		
RIV-AV-01	INTERCONNECT VAULT - NORTH SIDE	M-04		130	150	4	CARV	4" - BFV			
RIV-AV-02	INTERCONNECT VAULT — SOUTH SIDE	M-04		130	150	4	CARV	4" - BFV			
RIV-AV-03	INTERCONNECT VAULT - 5600 WEST PIPE	M-04		130	150	2	CARV	2" — BALL VALVE			
RIV-AV-04	INTERCONNECT VAULT - HERRIMAN SUPPLY PIPE	M-04		130	150	2	CARV	2" — BALL VALVE			
RPD-AV-01	ROCKY POINT DRIVE VAULT — NORTH SIDE	M-07		100	150	6	CARV	6" - BFV			
RPD-AV-02	ROCKY POINT DRIVE VAULT — SOUTH SIDE	M-07		100	150	6	CARV	6" - BFV			
RCP-AV-01	STA 108+90 EMMELINE DRIVE	PP-02		50	100	6	CARV	6" - DEX BFV			
RRV-AV-01	RESERVOIR VAULT - NEW ROSECREST PIPELINE, NORTH SIDE OF VAULT	M-08		15	100	4	CARV	6" - DEX BFV			
RRV-AV-02	RESERVOIR VAULT — TEE	M-08		15	100	2	CARV	2" — BALL VALVE			
RRV-AV-03	RESERVOIR VAULT - EXISTING ROSECREST PIPELINE, NORTH SIDE OF VAULT	M-08		15	100	4	CARV	6" - DEX BFV			

#### NOTES:

- VALVE SCHEDULE IS PROVIDED FOR VALVES 4" AND LARGER, ISOLATION VALVES FOR AIR VALVE ASSEMBLIES ARE ONLY SHOWN IN AIR VALVE SCHEDULE.
- 2. VALVES FOR FIRE HYDRANTS ARE NOT SHOWN IN THE VALVE SCHEDULE.
- 3. AIR VALVES SHALL BE RATED TO ACCOMMODATE THE SPECIFIED WORKING AND TEST PRESSURES SHOWN AT EACH LOCATION. CARV = COMBINATION AIR/RELEASE & AIR/VAC VALVE.

-	
	ξ.
	Ŏ-
	<u> </u>
	/////

/¿		
/	/	

	L	<u> </u>	 ]		
Ň				DATE	
OT FO FOR				NO. DATE REV. BY	
NOT FOR CONSTRUCTION FOR REVIEW ONLY				DESCRIPTION	פואסומי

JORDAN VALLEY WATER CONSERVANCY DISTRICT
ROSECREST PIPELINE CAPACITY UPGRADES
HERRIMAN AND RIVERTON CITY, UT

EQUIPMENT AND VALVE SCHEDULES

M-03 SHEET 53 OF 78

					VALVE SCHEDULE					
VALVE NO.	LOCATION	DRAWING NO.	TYPE	SIZE (INCH)	WORKING PRESSURE (PSI)	TEST PRESSURE (PSI)	OPERATOR	VOLTAGE	PHASE	ACTUATOR TYPE
HPS-BV-01 HERRIMAN PUN	MP STATION - BURIED ISOLATION VALVE	PP-01	DEX BFV	16	30	100	MANUAL - BURIED	N/A	N/A	HAND - BRING OPERATING NUT TO SURFACE WITH EXTENSION STEM
RIV-BV-01 INTERCONNECT	VAULT - NORTH SIDE ISOLATION VALVE	M-04	DEX BFV	30	130	150	MANUAL	N/A	N/A	HANDWHEEL
RIV-BV-02 INTERCONNECT	VAULT - SOUTH SIDE ISOLATION VALVE	M-04	DEX BFV	30	130	150	MANUAL	N/A	N/A	HANDWHEEL
RIV-BV-03 INTERCONNECT	VAULT - 5600 WEST OUTLET	M-04	DEX BFV	24	130	150	MANUAL	N/A	N/A	HANDWHEEL
RIV-BV-04 INTERCONNECT	VAULT — HERRIMAN METERING OUTLET	M-04	DEX BFV	12	130	150	MANUAL	N/A	N/A	HANDWHEEL
RIV-BV-05 INTERCONNECT	VAULT - EXISTING ROSECREST OUTLET	M-04	DEX BFV	16	130	150	MANUAL	N/A	N/A	HANDWHEEL
RIV-GV-01 INTERCONNECT	VAULT - NORTH SIDE RIVERTON METERING	M-04	GATE VALVE	8	130	150	MANUAL	N/A	N/A	HANDWHEEL
RIV-GV-02 INTERCONNECT	VAULT - RIVERTON METERING OUTLET	M-04	GATE VALVE	8	130	150	MANUAL	N/A	N/A	HANDWHEEL
RIV-GV-03 INTERCONNECT	VAULT - NEW ROSECREST DRAIN	M-04	GATE VALVE	4	130	150	MANUAL	N/A	N/A	HANDWHEEL
RIV-GV-04 INTERCONNECT	VAULT — EXISTING ROSECREST DRA	M-04	GATE VALVE	4	130	150	MANUAL	N/A	N/A	HANDWHEEL
RIV-GV-05 INTERCONNECT	VAULT — DRAIN MAINLINE	M-04	GATE VALVE	4	130	150	MANUAL	N/A	N/A	HANDWHEEL
RIV-PV-01 INTERCONNECT	VAULT — DRAIN MAINLINE	M-04	PLUG VALVE	4	130	150	MANUAL	N/A	N/A	HANDWHEEL
RIV-PRV-01 INTERCONNECT	VAULT - RIVERTON METERING	M-04	PRESSURE REDUCING VALVE	8	130	150				
RPD-BV-01 ROCKY POINT	DRIVE VAULT - ROSECREST MAINLINE VALVE	M-07	DEX BFV	24	100	150	MANUAL	N/A	N/A	HANDWHEEL
RPD-GV-02 ROCKY POINT	DRIVE VAULT - FOOTHILL SERVICE AREA VALVE	M-07	GATE VALVE	10	100	150	MANUAL	N/A	N/A	HANDWHEEL WITH LOCK
HC-GV-01 13860 SOUTH	- FOOTHILL SERVICE AREA VALVE	PP-08	GATE VALVE	8	110	150	MANUAL	N/A	N/A	HANDWHEEL WITH LOCK
RRV-BV-01 RESERVOIR VA	ULT - NEW ROSECREST PIPELINE	M-08	DEX BFV	24	15	100	ELECTRIC			OPEN/CLOSE
RRV-BV-02 RESERVOIR VA	ULT - NEW ROSECREST PIPELINE	M-08	DEX BFV	24	15	100	MANUAL	N/A	N/A	HANDWHEEL
RRV-BV-03 RESERVOIR VA	ult - New Rosecrest Pipeline	M-08	DEX BFV	24	15	100	MANUAL	N/A	N/A	HANDWHEEL
RRV-BV-04 RESERVOIR VA	ULT - EX ROSECREST PIPELINE	M-08	DEX BFV	20	15	100	ELECTRIC			OPEN/CLOSE
RRV-BV-05 RESERVOIR VA	ULT - EX ROSECREST PIPELINE	M-08	DEX BFV	20	15	100	MANUAL	N/A	N/A	HANDWHEEL
RCP-GV-01 STA 108+45 [	DRAIN AT EMMELINE DR	PP-02	GATE VALVE	6	50	100	MANUAL - BURIED	N/A	N/A	HAND - BRING OPERATING NUT TO SURFACE WITH EXTENSION STEM
RCP-PV-01 STA 108+45 [	DRAIN AT EMMELINE DR	PP-02	PLUG VALVE	6	50	100	MANUAL - BURIED	N/A	N/A	HAND - BRING OPERATING NUT TO SURFACE WITH EXTENSION STEM
RCP-GV-02 STA 145+30 [	DRAIN AT ROSECREST PARK	PP-06	GATE VALVE	6	105	150	MANUAL - BURIED	N/A	N/A	HAND - BRING OPERATING NUT TO SURFACE WITH EXTENSION STEM
RCP-PV-02 STA 145+30 [	DRAIN AT ROSECREST PARK	PP-06	PLUG VALVE	6	105	150	MANUAL - BURIED	N/A	N/A	HAND - BRING OPERATING NUT TO SURFACE WITH EXTENSION STEM
<u> </u>										

TYPE

ELEC AGNETIC FLOW METER

ELECTROMAGNETIC FLOW METER

SIZE

(INCH)

8

24

20

REMARKS

ENDRESS+HUGR - PROMAG W 400 OR ROSEMOUNT 8750W

ENDRESS+HAUSER - PROMAG W 400 OR ROSEMOUNT 8750W

				EXHAUST	FAN SCHEDULE				
FAN NO.	LOCATION	DRAWING NO.	AIRFLOW (ACFM)				MOTOR	MODEL	
FAN NO.	LOCATION	DRAWING NO.	AT 5,000 FT	ESF INCHES WC	DRIVE	HP	VOLTS	PHASE	(OR ENGINEER APPROVED EQUAL)
RIV-EF-01	ROSECREST INTERCONNECT VAULT	M-04	628	0.5	DIRECT			1	
RRV-EF-01	ROSECREST RESERVOIR VAULT	M-08	536	0.125	DIRECT			1	

DRAWING NO.

M-04

M-08

M-08

	PUMP SCHEDULE										
PUMP NO.	LOCATION	DRAWING NO.	SERVICE	TYPE	DISCHARGE SIZE (INCH)	MAX FLOW (GPM)	MAX HEAD (FT)	VOLTAGE	PHASE	HP (MIN)	REMARKS
RIV-P-01	ROSECREST INTERCONNECTION VAULT	M-04	RAW WATER/DRAIN	Sump	2			120	1		
RRV-P-01	ROSECREST RESERVOIR VAULT - SUMP PUMP	M-08	RAW WATER/DRAIN	Sump	2			120	1		
RRV-P-02	ROSECREST RESERVOIR VAULT - RESERVOIR PUMP	M-08	POTABLE WATER								

WORKING PRESSURE

(PSI)

15

15

FLOWMETER SCHEDULE

TEST PRESSURE

(PSI)

100

100


LOCATION

RIV-FM-01 INTERCONNECTION VAULT - RIVERTON METERING


RRV-FM-01 ROSECREST RESERVOIR VAULT - NEW ROSECREST PIPELINE


RRV-FM-02 ROSECREST RESERVOIR VAULT - ROSECREST PIPELINE

METER NO.

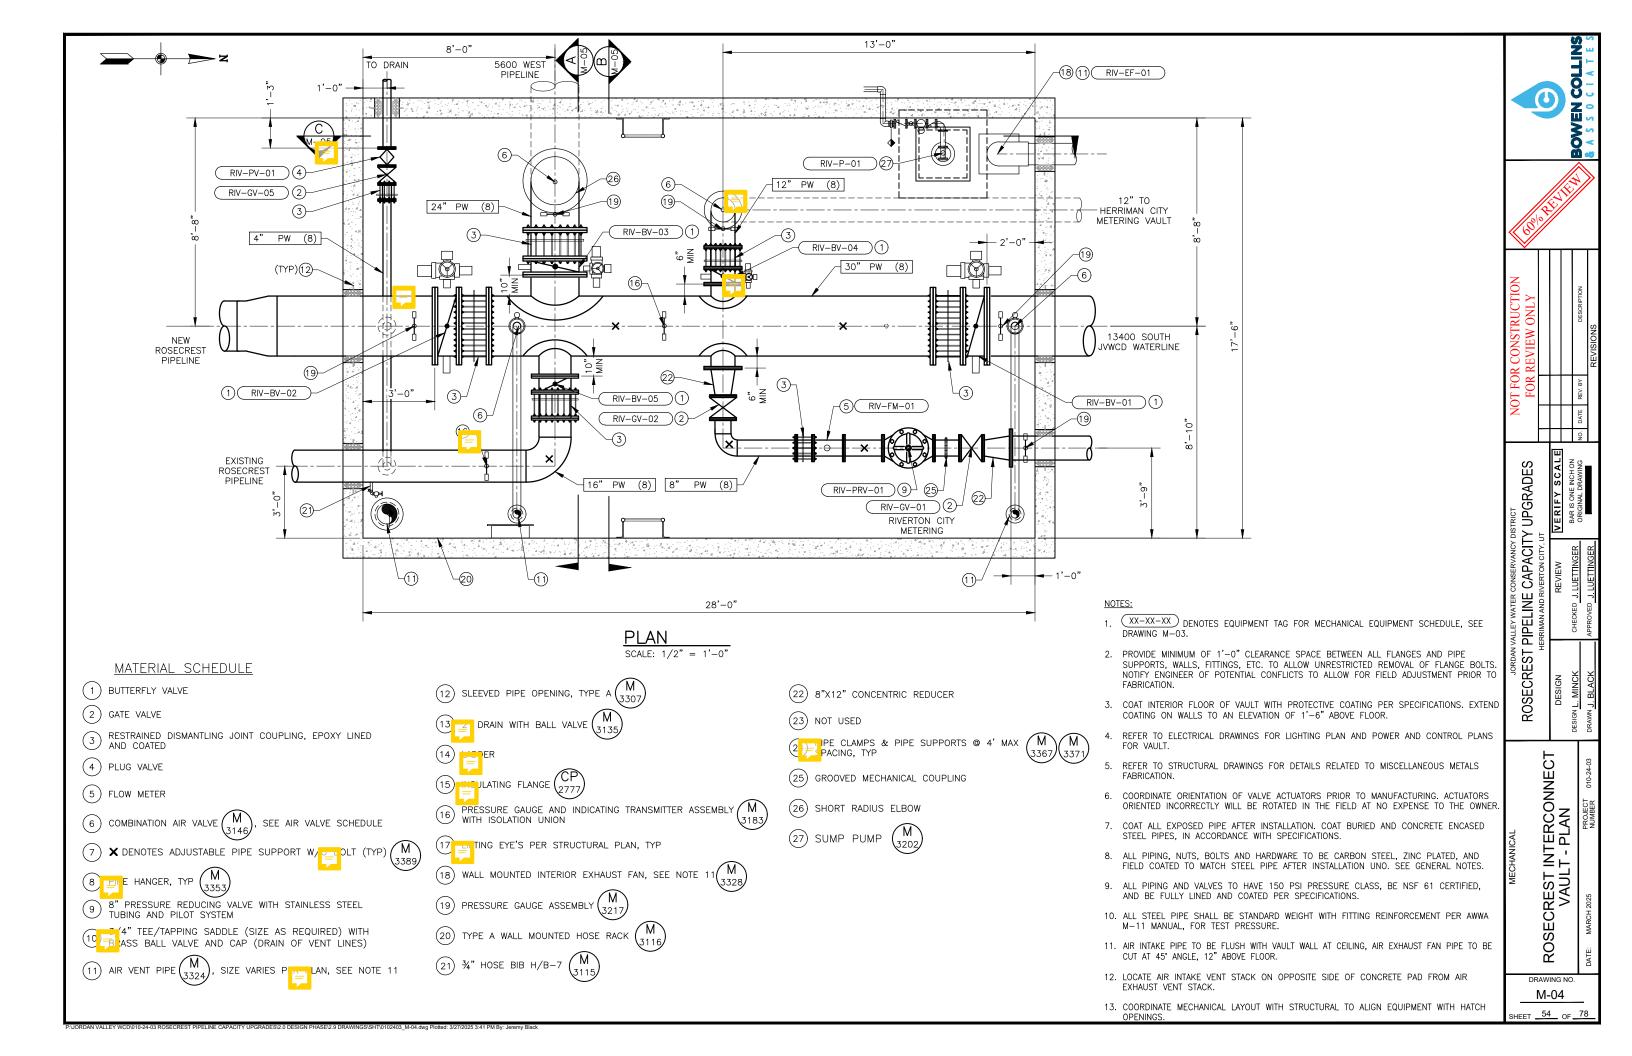



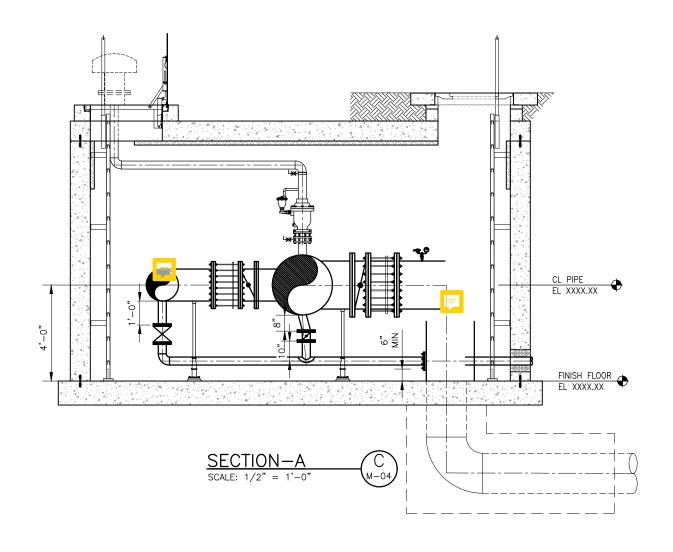

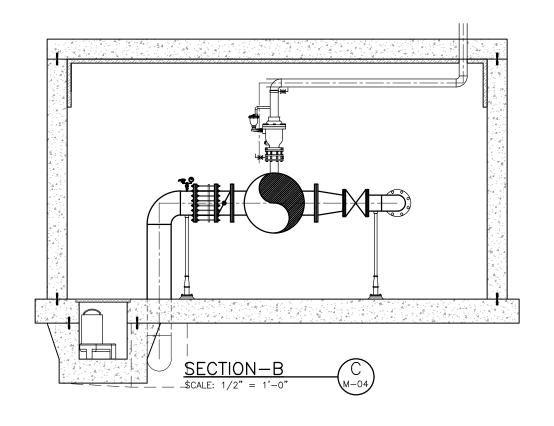




$\vee$				_			
NOT FOR CONSTRUCTION FOR REVIEW ONLY				NO EGI GOOD A	DESCRIPTION	REVISIONS	
)T FO FOR				70 / 10	REV. BY		
N				YO YOU	DAIE		
				2	j Z		
DISTRICT  Y UPGRADES	JT	VERIFY SCALE	NO HONE BAR		ORIGINAL DRAWING		
JORDAN VALLEY WATER CONSERVANCY DISTRICT REST PIPELINE CAPACITY UPC	KUSECKEST PIPELINE CAPACITY UPGRADES HERRIMAN AND RIVERTON CITY, UT	REVIEW		CHECKED		APPROVED	
ROSECREST F		DESIGN		DESIGN		DRAWN	
AECHANICAL	TOUNDOUGHT -		PROFICE A-B			NUMBER 010-24-03	
ME	TIMI TODOCOO	- 01 - 01 - 01 - 01 - 01 - 01 - 01 - 01	VAULI - PRO			DATE: MARCH 2025	

DRAWING NO.

M-05

SHEET 55 OF 78



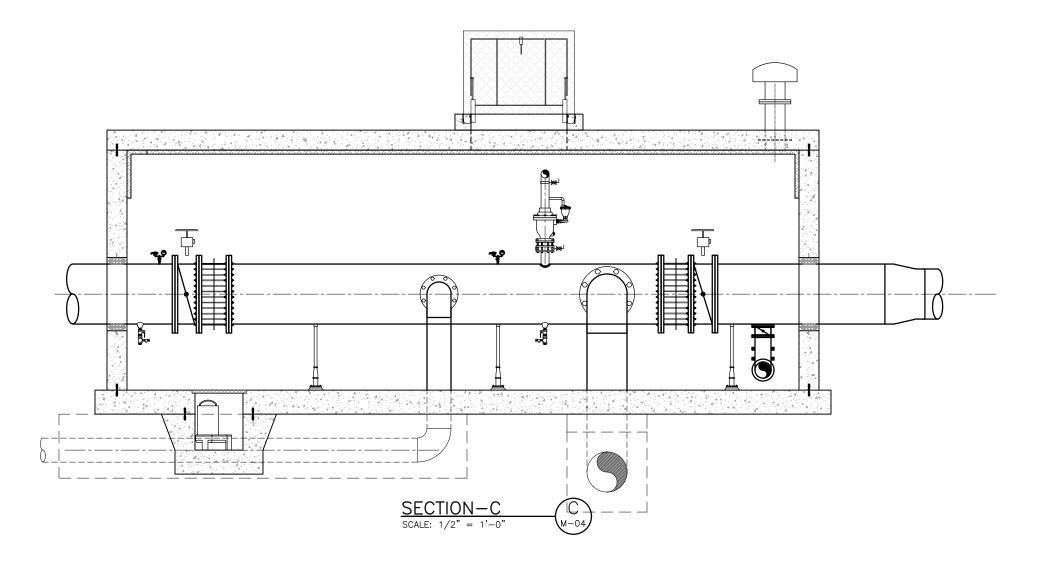

ROSECREST PIPELINE CAPACITY UPGRADES

HERRIMAN AND RIVERTON CITY, UT

DESIGN

REVIEW

BAR IS ONE INCH ON

OHECKED


CHECKED


ORIGINAL DRAWING


NO.

ROSECREST INTERCONNECT VAULT - PROFILE C

DRAWING NO. M-06 SHEET <u>56</u> OF <u>78</u>

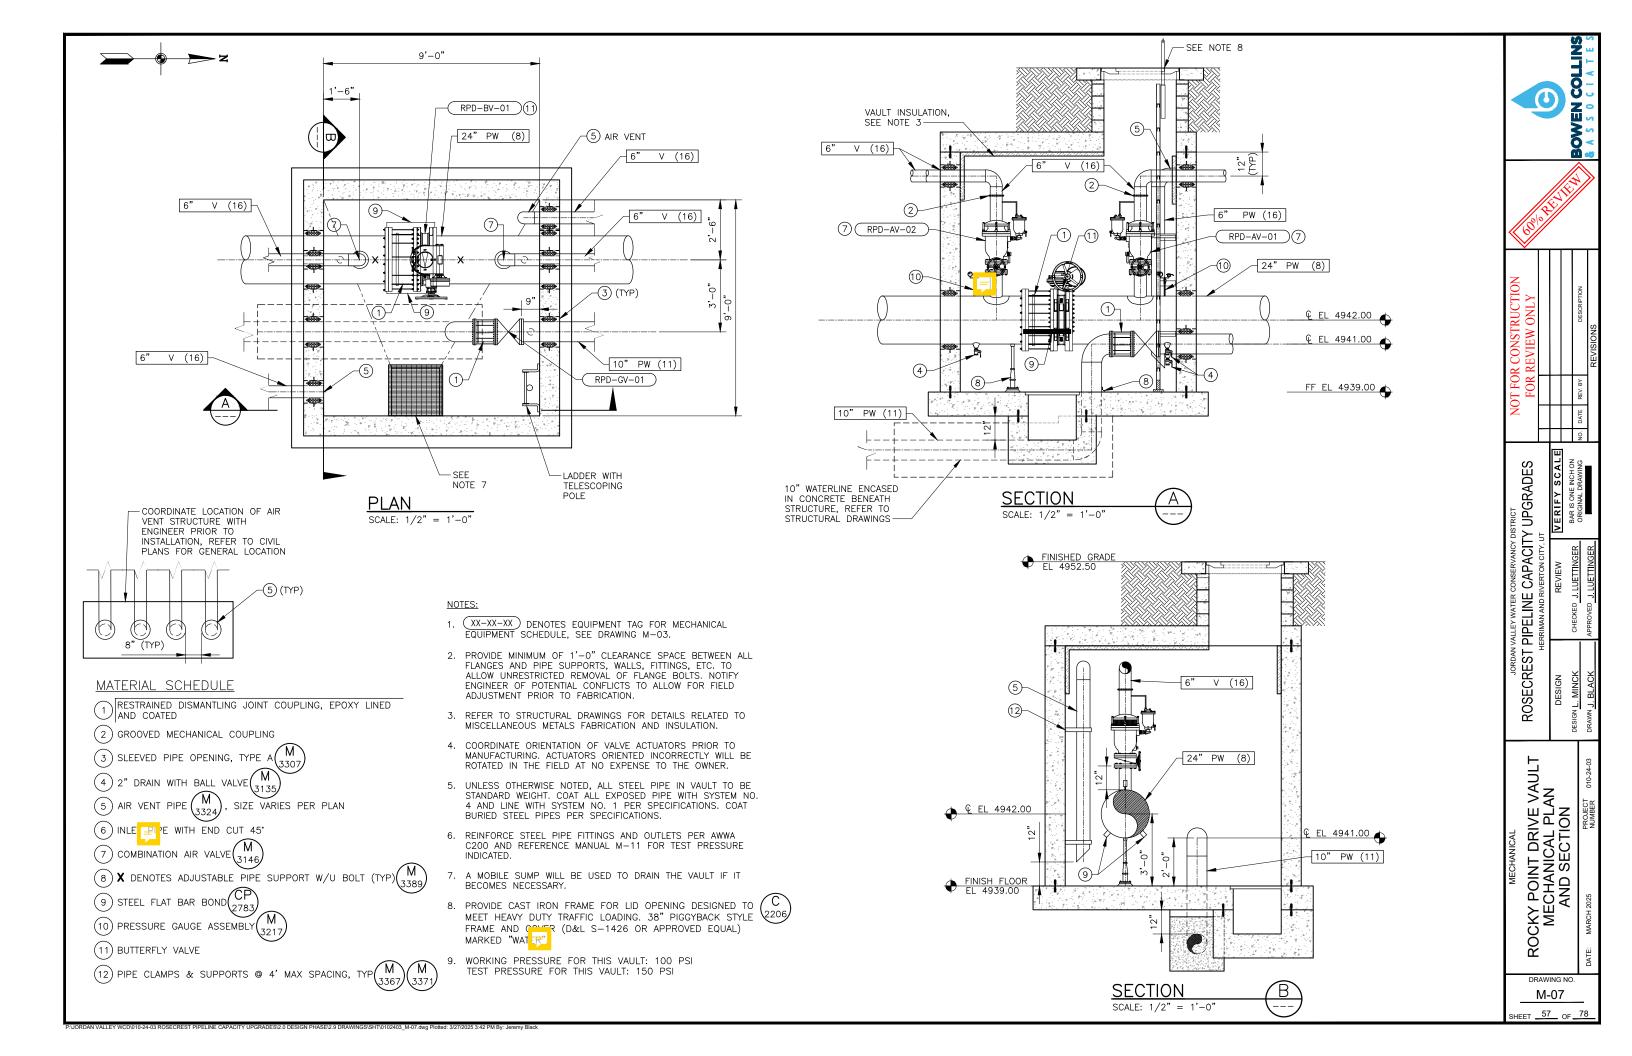


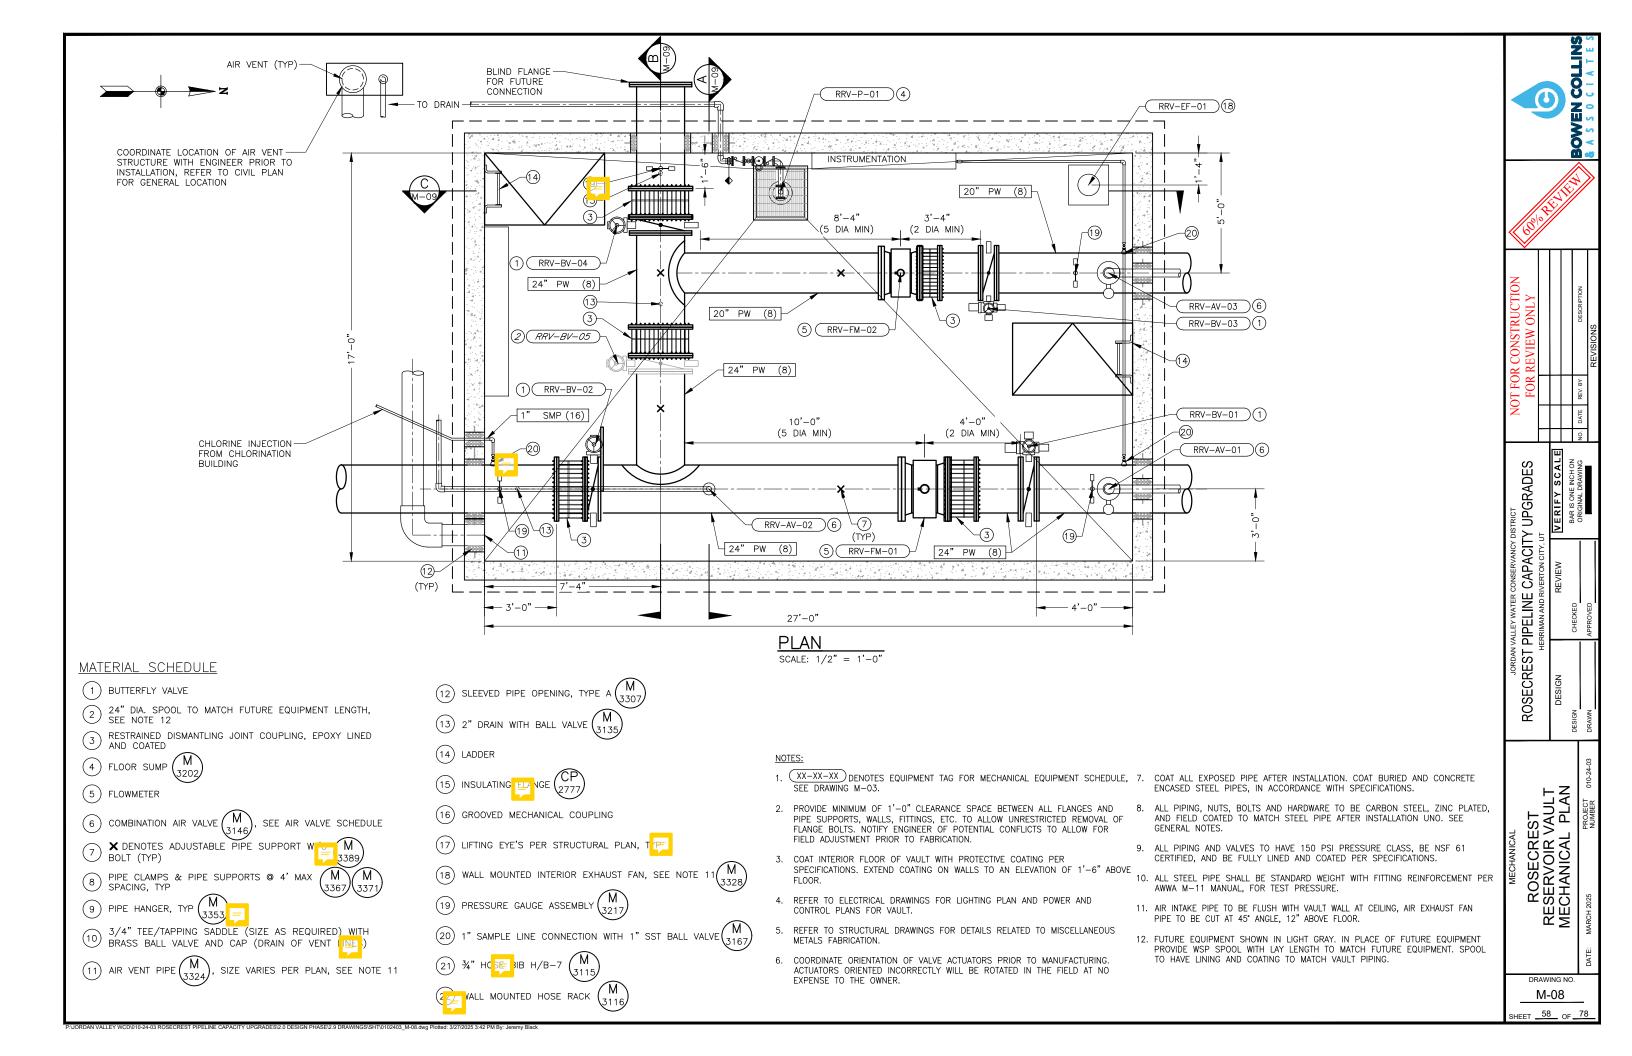

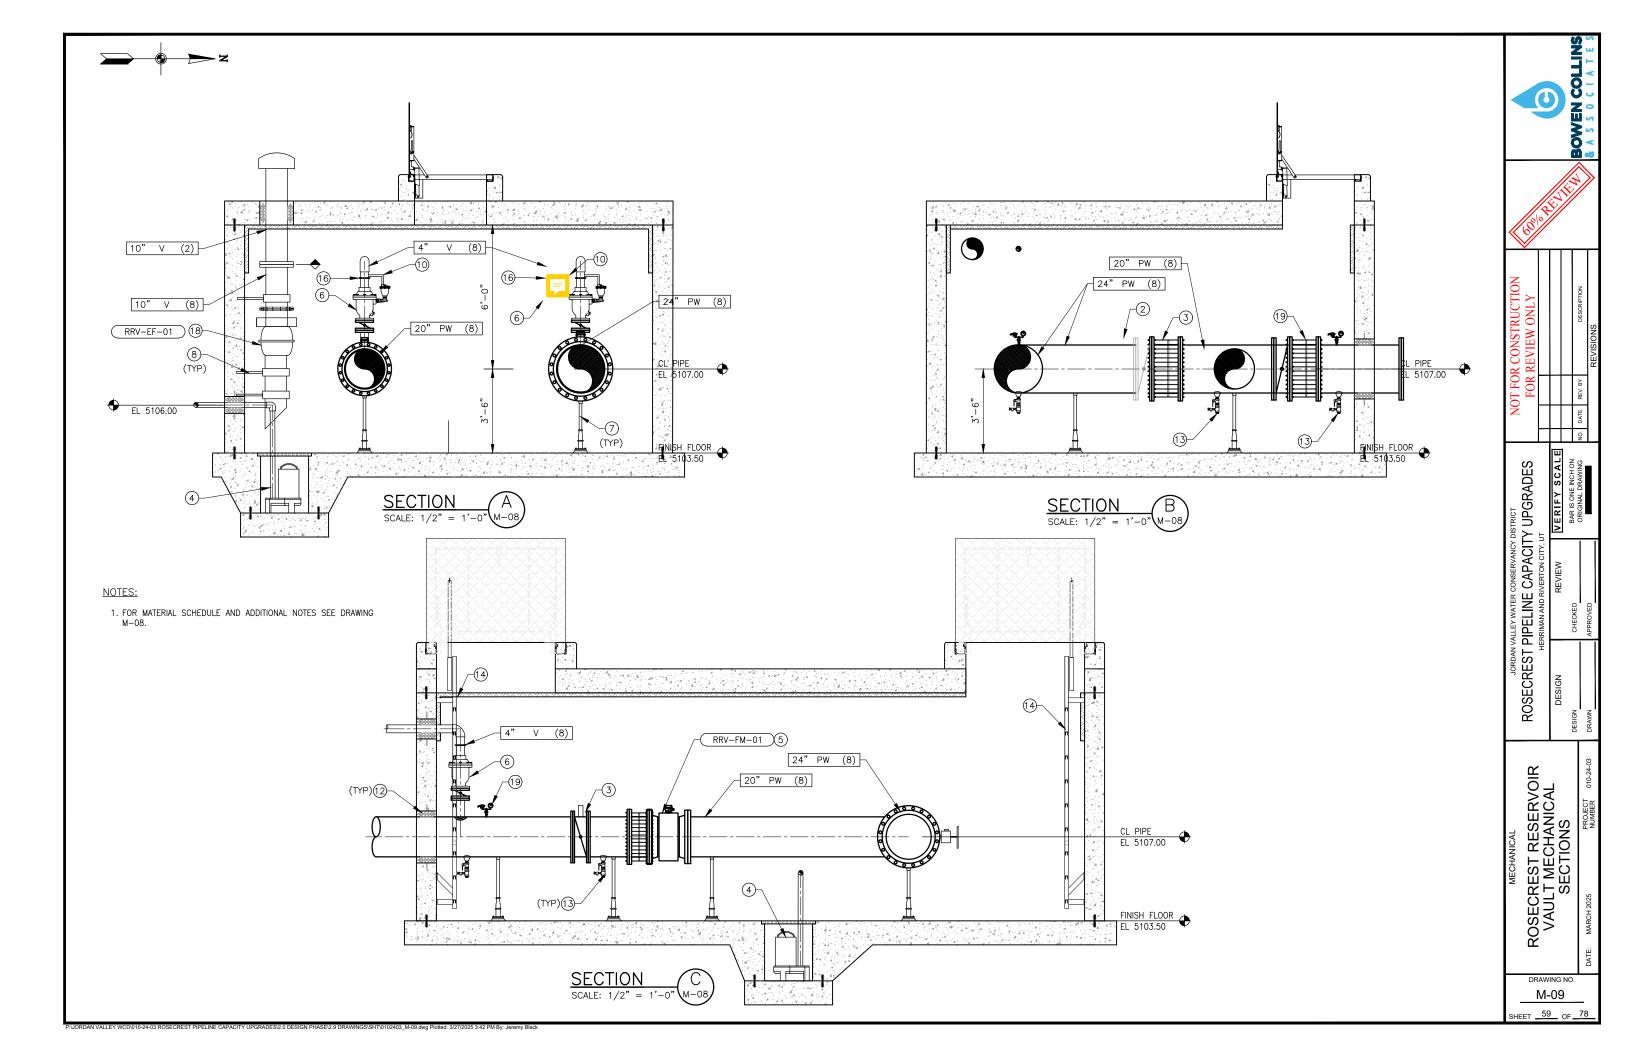





- ALL HOSE BIBBS TO BE CONTROLLED BY INDIVIDUAL SHUT-OFF VALVES EXCEPT WHERE INDIVIDUALLY CONTROLLED BRANCH MAIN SERVES HOSE VALVES ONLY.
- 2. SEE DRAWINGS FOR SIZE AND LOCATION. HOSE BIBB SIZE TO MATCH BRANCH LINE SIZE.
- 3. PROVIDE WARNING SIGN WHEN USED FOR NON-POTABLE WATER.
- 4. PIPE SUPPORT TYPE AND MATERIAL AS SHOWN ON DRAWING.
- 5. ALL COMPONENTS TO BE NSF 61 CERTIFIED FOR DRINKING WATER USE, WHERE CONNECTED TO POTABLE WATER MAIN.
- 6. ALL THREADED HOSE BIBBS SHALL HAVE VACUUM BREAKERS.

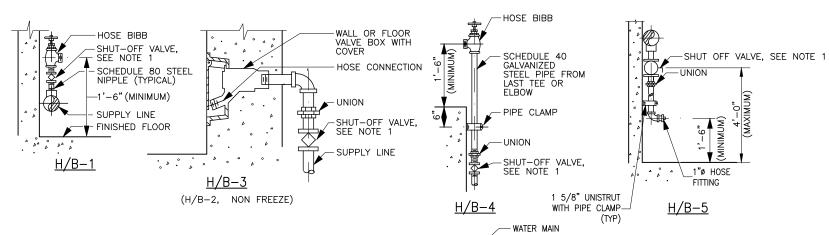


PLAN H/B-7

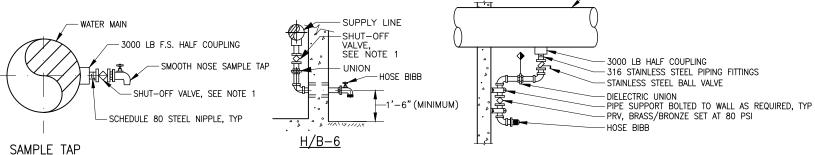





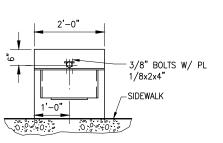


#### PLAN-POST MOUNT

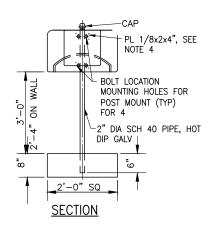

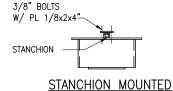

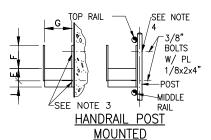

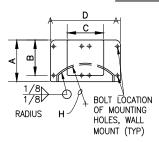


WALL MOUNTED

DIMENSION IN INCHES									
RACK TYPE	Α	В	С	D	ы	F	G	Η	
TYPE A - 3" & 1" HOSE	10½	9	9	18	3	6	7 <del>1</del>	9 <del>3</del>	11/2
TYPE B - 1½" HOSE	14	12	12	24	4	8	10	13	2

#### NOTES:

- INTERIOR UNITS SHALL BE FABRICATED FROM 1/8" A-36 STEEL PLATE AND ENTIRE UNIT SHALL BE HOT DIP GALVANIZED AFTER FABRICATION.
- 2. EXTERIOR UNITS SHALL BE FABRICATED FROM 3/16" 6061-T6 ALUMINUM ALLOY PLATE.
- ATTACH TO CONCRETE WALL WITH (4)-1/4" STAINLESS STEEL STUD TYPE WEDGE ANCHORS.
- 4. ATTACH TO VERTICAL HANDRAIL OR INDIVIDUAL POST WITH PLATES AND (4)-1/4" STAINLESS STEEL BOLTS.
- ATTACH TO STEEL COLUMN WITH (4)-1/4" ROUND HEAD BOLTS, ONE IN EACH CORNER. INSERT DOUBLE SPACER NUTS BETWEEN COLUMN AND HOSF RACK.
- 6. CONTRACTOR TO PROVIDE AND INSTALL 50FT OF HOSE.

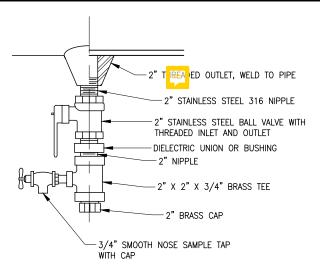

#### NOTE:

- 1. ALL THREADED HOSE BIBS OR SAMPLE TAPS SHALL HAVE VACUUM BREAKERS.
- 2. ALL BRASS AND BRONZE PIPING AND FITTINGS TO BE CERTIFIED FOR POTABLE WATER.

HOSE RACK DETAILS

NTS

M
3116

2" DRAIN ASSEMBLY

DRAWING NO.

GM-01

SHEET 61 OF 78

3135


o g


CAPACITY UPGRADES

JORDAN VALLEY WATER C
ROSECREST PIPELINE
HERRIMAN AND RIV

MECHANICAL FAILS - 1


PUORDAN VALLEY WCD010-24-03 ROSECREST PIPELINE CAPACITY UPGRADES)/2.0 DESIGN PHASE/2.9 DRAWINGSISHT/01024/03 GM-01 dwg Plotted: 3/27/2025 3-43 PM By. Jeremy Ble

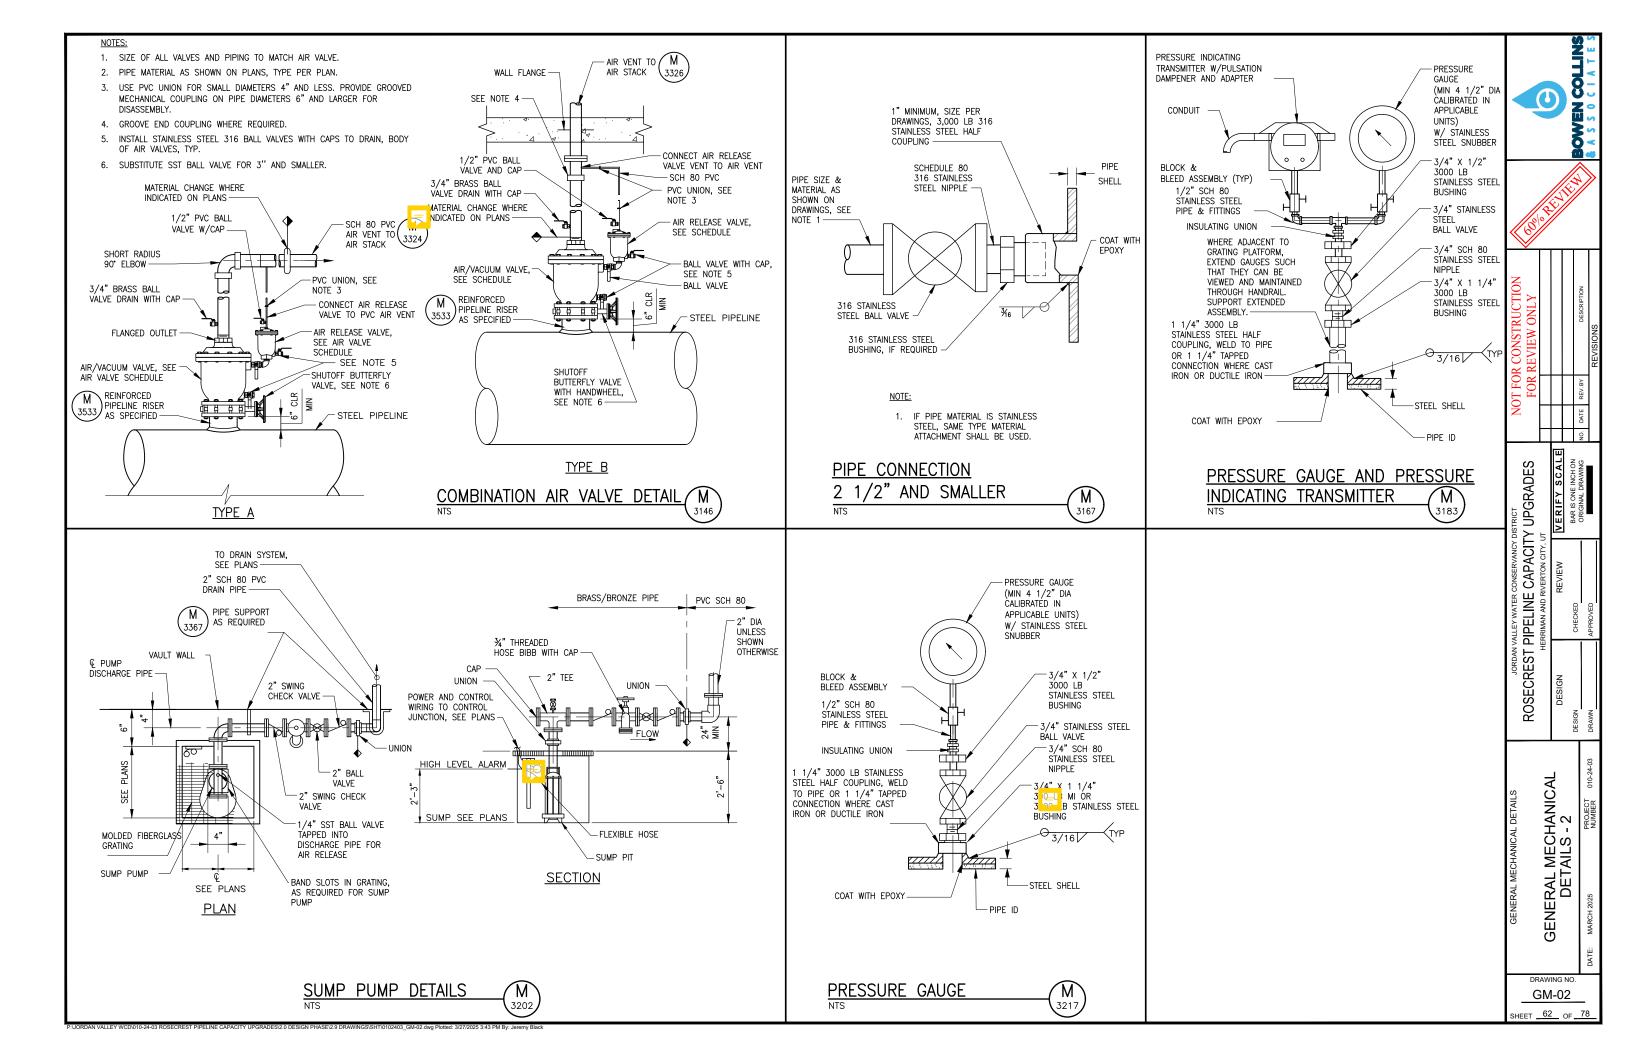

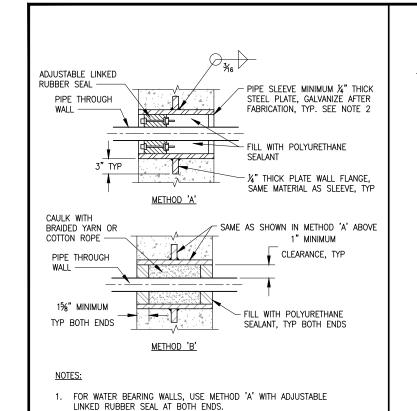

2. SLEEVES ARE NOT REQUIRED IN CORE DRILLED WALLS, PENETRATIONS


THROUGH EXISTING WALLS, OR FLOORS

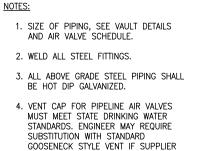

5. VENT PIPE MATERIAL AS SHOWN ON

DOES NOT MEET STATE REQUIREMENTS.

6. WHERE MULTIPLE VENT STACKS ARE ADJACENT TO EACH OTHER, LOCATE VENTS A MINIMUM OF 16" APART.

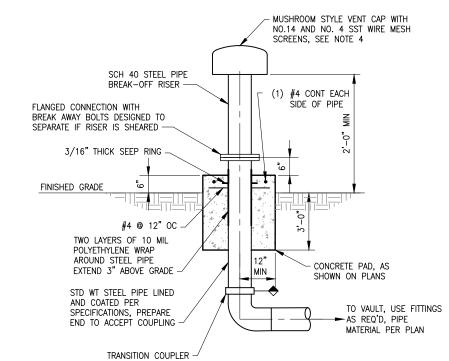


-MUSHROOM STYLE VENT CAP WITH NO. 14 AND NO. 4 STAINLESS STEEL WIRE MESH SCREEN, SEE NOTES 4 THROUGH 6 VENT PIPE, SCHEDULE 40 GALV STEEL. BREAK-OFF-RISER TOP OF BOX OR FLANGED CONNECTION WITH TOP OF FINISH BREAK AWAY BOLTS DESIGNED TO GROUND SURFACE -SEPARATE IF RISER IS SHEARED SEEP RING/WALL FLANGE, WELD ALL AROUND TRANSITION TO VAULT PIPE WITH FLANGED CONNECTION. SEE NOTE 7 NOTES:

- 1. SIZE OF PIPING, SEE VAULT DETAILS, AND AIR VALVE SCHEDULE.
- 2. WELD ALL STEEL FITTINGS.
- 3. ALL ABOVE GRADE STEEL PIPING SHALL BE HOT DIP GALVANIZED.
- 4. VENT CAP FOR PIPELINE AIR VALVES MUST MEET STATE DRINKING WATER STANDARDS. ENGINEER MAY REQUIRE SUBSTITUTION WITH STANDARD GOOSENECK STYLE VENT IF SUPPLIER DOES NOT MEET STATE REQUIREMENTS
- 5. AREA OF SPACE BETWEEN RISER AND MUSHROOM CAP MUST EXCEED AIR FLOW AREA OF RISER PIPE.
- 6. PROVIDE RUBBER GASKETS ABOVE AND BELOW SCREEN.
- 7. VENT PIPE MATERIAL AS SHOWN ON PLANS.

AIR VENT/VENT STACK DETAIL NTS

3326


**VENT STACK** 3324

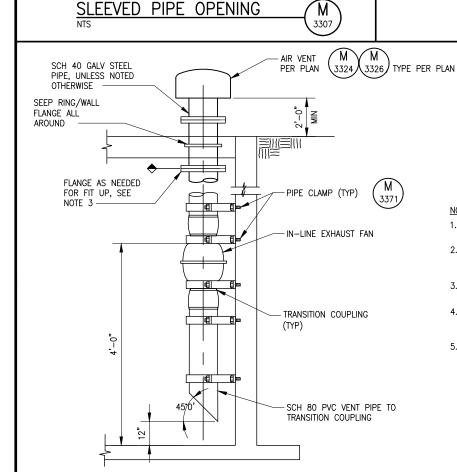

#### NOTES:

3328

- 1. ALL ABOVE GROUND PIPING SHALL BE HOT DIP
- 2. VENT PIPING SHALL MATCH FAN DIAMETER PER PLAN (UNLESS OTHERWISE NOTED), SEE MECHANICAL DRAWINGS FOR ACTUAL SIZES.
- 3. PROVIDE FLANGED CONNECTIONS FOR VENTS LARGER THAN 6" OR LONGER THAN 10 FEET.
- PROVIDE FLEXIBLE FERNCO CONNECTOR WITH SPACE FILLER AROUND FAN CUT FROM ANOTHER RUBBER CONNECTOR.
- 5. INSTALL PIPE CLAMPS ON EACH SIDE OF FAN AND AT BOTTOM OF PIPE INTAKE. INSTALL
  ADDITIONAL CLAMPS AS NEEDED TO SUPPORT

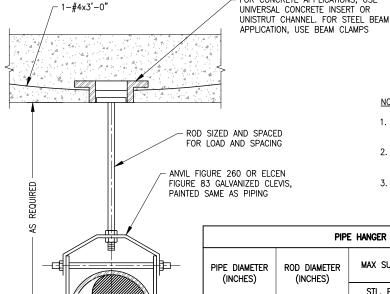

NOTES:

FOR CONCRETE APPLICATIONS, USE

- FOR INSULATED PIPES. USE ANVIL FIG. 167 OR ELCEN FIGURE 219 INSULATION PROTECTION SHIELD.
- TOTAL LOADING ON EACH CONCRETE INSERT OR OTHER TYPE HANGER ROD ANCHOR SHALL NOT EXCEED MFR'S RECOMMENDED LOADINGS.
- PIPE SUPPORT AND HARDWARE SHALL BE STAINLESS STEEL.

PIPE HANGER RODS AND SUPPORT SPACING							
PIPE DIAMETER (INCHES)	ROD DIAMETER (INCHES)	MAX SUPPORT	SPACING (FEET)	WEIGHT LIMIT (POUNDS)			
		STL. PIPE	C.I. PIPE	TYPE 'A'	TYPE 'B'		
1 & SMALLER	¾	6	5	610	1700		
11/4 TO 2	3%	9	5	610	1700		
2½ TO 3½	1/2	12	5	1130	3200		
4 TO 5	%	14	5	1430	3800		
6 TO 8	3⁄4	16	5	1430	3800		
10 TO 12	7/8	18	_	1430	3800		

PIPE HANGER

4" THROUGH

10" PIPE -

3353

ECHANICAL S - 3 ME GENERAL I DET

Ö

UPGRADES


CAPACITY (

PIPELINE (C

ROSECREST


GM-03 SHEET 63 OF 78


EXHAUST VENT DETAIL

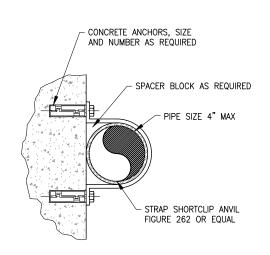



NOTES:

1. ALL HARDWARE SHALL BE STAINLESS STEEL.

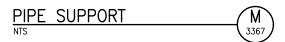

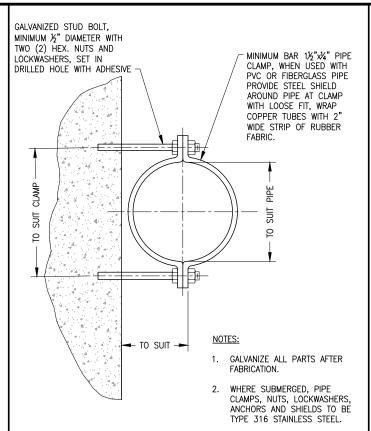

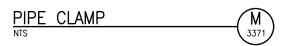

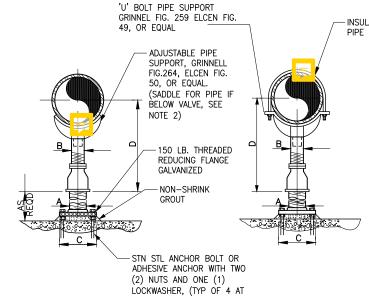

 INSULATE METALLIC PIPES FROM PIPE SUPPORT


DIMENSION TABLE						
PIPE SIZE	A	В	С	D		
				MIN	MAX	
2 ½"	2 ½"	1 ½"	9"	8"	11 ½"	
3"	2 ½"	1 ½"	9"	8 1/4"	11 ¾"	
3 ½"	2 ½"	1 ½"	9"	8 ½"	12"	
4"	3"	2 ½"	9"	10 ¼"	14"	
6"	3"	2 ½"	9"	11 %"	15 1/4"	
8"	3"	2 ½"	9"	13 %"	16 ½"	
10"	3"	2 ½"	9"	14 %"	18 ¼"	
12"	3"	2 ½"	9"	15 %"	19 ¾"	
14"	4"	3"	11"	18 %"	20 ¾"	
16"	4"	3"	11"	19 %"	22 1/4"	
18"	6"	3 ½"	13 ½"	21 1/4"	24"	
20"	6"	3 ½"	13 ½"	23 1/4"	25 ½"	
24"	6"	4"	13 ½"	26 ½"	28 1/4"	
30"	6"	4"	13 ½"	29 %"	31 ½"	
32"	6"	4"	13 ½"	30 %"	32 ¾"	
36"	6"	4"	13 ½"	32 %"	34 ¾"	

#### NOTES:


- 1. ENTIRE UNIT SHALL BE GALVANIZED AFTER FABRICATION.
- 2. WHERE PIPE SUPPORT IS SHOWN BELOW A VALVE, PROVIDE ADJUSTABLE PIPE SUPPORT WITH A FLAT TOP (8"X8"X1/2")

ADJUSTABLE PIPE SUPPORT WITH OR WITHOUT U-BOLT



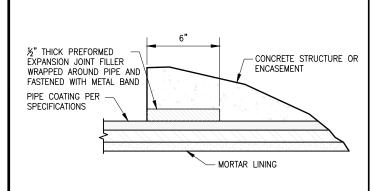

PIPE ENCASEMENT END

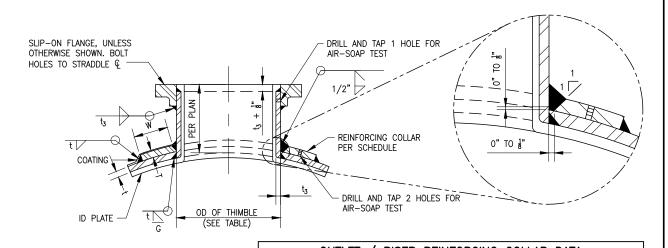

#### NOTES:

- ALL PIPING AND FITTINGS ARE TO BE CEMENT MORTAR LINED AND COATED PER SPECIFICATIONS, UNO.
- 2. COLLAR THICKNESS AND WIDTH ARE MINIMUM TO BE PROVIDED.
- OUTLET REINFORCEMENT TO BE THE GREATER OF WHAT IS SHOWN IN THIS DETAIL OR PER AWWA C-208 AND M-11 FOR WORKING AND TEST PRESSURE REQUIREMENTS.

OUTLET / RISER REINFORCING COLLAR DATA								
NORMAL	SCHEDULE	MINIMUM t3 WALL	O.D. THIMBLE	COLLAR DIMENSIONS				
SIZE	PIPE	THICKNESS (IN)	(IN)	W (IN)	T (IN)			
4	SCH 80	0.337	4 1/2	2 1/4	0.50			
6	SCH 80*	0.375	6 5/8	3 5/16	0.50			
8	SCH 60*	0.375	8 5/8	4 5/16	0.50			
12	STD	0.375	12 3/4	6 3/8	0.50			
16	STD	0.375	16	8	0.50			
24	STD	0.375	24	12	0.50			
30	STD	0.375	30	15	0.50			


\*MATCH SCHEDULE OR MINIMUM THICKNESS

OUTLET DETAIL



JORDAN VALLEY WATER CONSERVANCY DISTRICT
ROSECREST PIPELINE CAPACITY UPGRADES
HERRIMAN AND RIVERTON CITY, UT GENERAL MECHANICAL DETAILS - 4 GM-04 SHEET 64 OF 78


NTS 3408

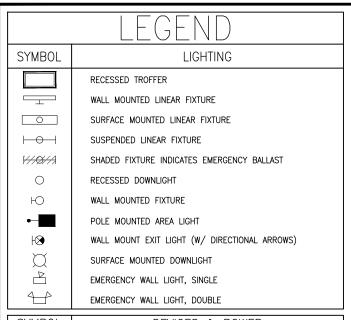


	EMERGENCY WALL LIGHT, DOUBLE
SYMBOL	DEVICES & POWER
\$	SWITCH — SPST  3 THREE WAY  4 FOUR WAY  WP WEATHER PROOF EXP EXPLOSION PROOF M MANUAL MOTOR DISCONNECT/STARTER T TIMER MC MOMENTARY CONTACT HC HANDICAPPED  RECEPTACLE — SIMPLEX
GFI WP	RECEPTACLE — DUPLEX GFI GROUND FAULT INTERRUPT WP WEATHER RESISTANT DEVICE W/ WHILE—IN—USE COVER
	RECEPTACLE — DOUBLE DUPLEX SAME INDICATORS AS SHOWN FOR DUPLEX
IJ HJ	J-BOX, J-BOX WALL MOUNTED, 4"x4"x2 1/8" DEEP UNLESS NOTED OTHERWISE
HT	J-BOX, CONDUIT, PULL STRING BY EC THERMOSTAT, SUPPLIED AND INSTALLED BY MC
•	LCS (LOCAL CONTROL STATION)
	EMERGENCY PUSHBUTTON
<b>©</b>	PHOTOCELL
	SPECIAL PURPOSE CONNECTION, BOX INDICATES FLOOR MOUNTING, WORK AS NOTED PANELBOARD, MOUNTING AS INDICATED ON PANEL SCHEDULE
⊠h	COMBINATION STARTER
ㅁ	DISCONNECT SWITCH
	CONTACTOR
	CIRCUIT BREAKER AF/AT FRAME RATING, TRIP RATING LSIG ADJUSTABLE (L)ONG, (S)HORT, (I)NSTANTANEOUS (G) GROUND FAULT
	ARMS ARC ENERGY REDUCTION MAINTENANCE SWITCH TRANSFORMER, DRY—TYPE
	TRANSFORMER, PAD MOUNTED

	SPECIAL PURPOSE CONNECTION, BOX INDICATES FLOOR MOUNTING, WORK AS NOTED PANELBOARD, MOUNTING AS INDICATED ON PANEL SCHEDULE
⊠h	COMBINATION STARTER
마	DISCONNECT SWITCH
	CONTACTOR  CIRCUIT BREAKER  AF/AT FRAME RATING, TRIP RATING  LSIG ADJUSTABLE (L)ONG, (S)HORT, (I)NSTANTANEOUS  (G) GROUND FAULT  ARMS ARC ENERGY REDUCTION MAINTENANCE SWITCH
	TRANSFORMER, DRY-TYPE
	TRANSFORMER, PAD MOUNTED
SYMBOL	GROUNDING
•	GROUND ROD
	GROUND ROD WITH GROUND TEST WELL
0	GROUND RISER FROM REBAR
	GROUND RISER FROM REBAR  MECHANICALLY CRIMPED OR WELDED GROUND CONNECTIONS
	MECHANICALLY CRIMPED OR WELDED GROUND

SYMBOL	SCHEMATIC
·*·	SELECTOR SWITCH 2 POSITION
TR →	NORMALLY OPEN TIME DELAY CLOSING AFTER
TR ⊶∡°	COIL ENERGIZED  NORMALLY CLOSED TIME DELAY OPENING AFTER  COIL ENERGIZED
<b>₩</b>	INDICATOR LIGHT
$\otimes$	REMOTE DEVICE CONNECTION
И	CLOSED RELAY CONTACT
11	OPEN RELAY CONTACT
	TERMINAL TO EXTERNAL REMOTE DEVICE
0	WIRE TERMINAL OR CONNECTION POINT
o⊸⊐¤ CR	LIMIT SWITCH
	CONTROL RELAY
[uJ]	VT/PT CPT
$\overline{\mathbb{M}}$	VIVIII GIT
HAND OFF AUTO	
* 6	SELECTOR SWITCH 3 POSITION MAINTAINED CONTACT
0 0	
<u>~</u> • ★	LEVEL SWITCH CLOSES ON FALLING LEVEL
0 7	LEVEL SWITCH CLOSES ON RISING LEVEL
,	CONTROL SWITCH PUSHBUTTON, MOMENTARY CONTACT N.C.
<u>=</u>	GROUND CONNECTION
<b>↔</b>	SOLENOID
% प्ते (१	FLOW SWITCH CLOSES ON LOW FLOW PRESSURE SWITCH CLOSES ON RISING PRESSURE
\$ <b>**</b>	TRANSFORMER W/ DELTA—Y AND GROUND
E M	UTILITY METER, UTILITY CT
$^{\circ}$ )	CIRCUIT BREAKER
	ELECTRICAL PANEL
	FUSE
2 <u>9</u>	MOTOR STARTER NEMA SIZE AS NOTED
\one \one \one \one \one \one \one \one	DISCONNECT SWITCH SIZE AS NOTED
AHF	ACTIVE HARMONIC FILTER
PHF	PASSIVE HARMONIC FILTER
(M)	MOTOR (10 HORSEPOWER NOTED)
SPD	SURGE PROTECTION DEVICE
PQM	POWER QUALITY METER
VFD	VARIABLE FREQUENCY DRIVE
PMR	PUMP MONITOR RELAY  REDUCED VOLTAGE SOFT STARTER
	NEDUCED VOLIAGE SUFI STAKTEK

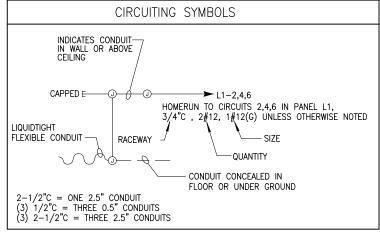

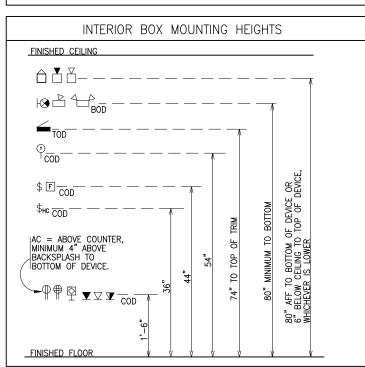

0) (1 1 1 0 1	
SYMBOL	ABBREVIATIONS AND MISCELLANEOUS
ATS	AUTOMACTIC TRANSFER SWITCH
EC	ELECTRICAL CONTRACTOR
MC	MECHANICAL CONTRACTOR
GC	GENERAL CONTRACTOR
C	CONDUIT
GND, G	GROUND
BOD	BOTTOM OF DEVICE
COD	CENTER OF DEVICE
AFF	ABOVE FINISHED FLOOR
AFG	ABOVE FINISHED GRADE
BLG	BELOW GRADE
AC	ABOVE COUNTER, 4" ABOVE BACK SPLASH
BC	BELOW COUNTER, 4" BELOW COUNTER TOP
W/	WITH
a,b,c	SWITCH DESIGNATION
UON	UNLESS OTHERWISE NOTED
UG	UNDERGROUND
WP F0	WEATHER PROOF FIBER OPTIC
MD	MEDIUM VOLTAGE
MD	MEDIUM VOLIAGE
$\left( \times \right)$	INDICATES STANDARD DETAIL
×/	
XXX	EQUIPMENT TAG NUMBER
X,XXX	FAULT CURRENT VALUE
(XXX)	CONDUIT TAG

#### **GENERAL NOTES:**

- 1. NOT ALL EQUIPMENT SYMBOLS SHOWN ARE USED.
- 2. VERIFY ALL EQUIPMENT DIMENSIONS AND LOCATIONS BEFORE BEGINNING ROUGH—IN. CONSULT ALL APPLICABLE CONTRACT DRAWINGS AND SHOP DRAWINGS TO ENSURE NEC CODE CLEARANCE REQUIRED AROUND ALL ELECTRICAL EQUIPMENT
- CONTRACTOR SHALL VERIFY ALL ELECTRICAL LOADS (VOLTAGE, PHASE, CONNECTION REQUIREMENTS, ETC.) OF EQUIPMENT FURNISHED
- SEE APPLICABLE SHOP DRAWINGS FOR ROUGH-IN LOCATION OF ALL EQUIPMENT, WIRING DEVICES, ETC.
- THE ELECTRICAL CONTRACTOR SHALL NOTIFY AND COOPERATE WITH THE MECHANICAL CONTRACTOR SUCH THAT NO PIPING, OR EQUIPMENT FOREIGN TO THE OPERATION OF THE ELECTRICAL EQUIPMENT SHALL BE PERMITTED TO BE INSTALLED IN, ENTER OR PASS THROUGH ELECTRICAL ROOMS OR SPACES; OR ABOVE OR BELOW ELECTRICAL EQUIPMENT IN THE OTHER AREAS.
- ALL PENETRATIONS OF FLOORS, WALLS AND CEILINGS SHALL BE SEALED WITH APPROVED MATERIAL.
- FOR PACKAGE EQUIPMENT PROVIDED ON THE PROJECT, SOME CONDUITS AND WIRES ARE SHOWN ON THE DRAWINGS, BUT IT IS EXPECTED THAT SOME ADDITIONAL CONDUITS AND WIRES MAY BE REQUIRED BY EQUIPMENT MANUFACTURERS TO COMPLETE INSTALLATION. IT IS INCUMBENT UPON THE GENERAL CONTRACTOR TO COORDINATE THIS REQUIREMENT WITH HIS SUBCONTRACTORS TO MAKE SURE THAT EQUIPMENT SUPPLIER PROVIDED ALL NECESSARY ELECTRICAL INFORMATION TO ELECTRICAL SUBCONTRACTOR FOR INCLUSION WHETHER SHOWN OR NOT SHOWN ON THE DRAWINGS.
- IF OTHER THAN FIRST NAMED EQUIPMENT IS USED, IT SHALL BE CAREFULLY CHECKED FOR ELECTRICAL REQUIREMENTS AND CONTROL REQUIREMENTS OF ALTERNATE EQUIPMENT. SHOULD CHANGES OR ADDITIONS OCCUR IN ELECTRICAL WORK, OR THE WORK OF OTHER CONTRACTORS BE REVISED BY THE ALTERNATE EQUIPMENT, THE COST OF ALL CHANGES SHALL BE THE RESPONSIBILITY OF THE ELECTRICAL
- IT IS THE ELECTRICAL SUBCONTRACTOR'S RESPONSIBILITY TO RECEIVE THE COMPLETE SET OF PLANS IN ORDER TO ENSURE THAT ALL ITEMS RELATED TO ELECTRICAL POWER AND CONTROL SYSTEMS ARE COMPLETELY ACCOUNTED FOR.
- 10. ALL EQUIPMENT DIMENSIONS SHOWN ON PLANS AND ELEVATIONS ARE APPROXIMATE ONLY. THE CONTRACTOR SHALL USE THE SHOP DRAWINGS FOR PROPER LAYOUT, FOUNDATION AND PAD, ETC. FOR FINAL INSTALLATION WITHOUT ANY ADDITIONAL COST TO THE OWNER.
- 11. THE DRAWINGS GENERALLY ILLUSTRATE THE APPROXIMATE DESIRED LOCATION AND ARRANGEMENT OF OUTLETS, CONDUIT RUNS, EQUIPMENT AND OTHERS ITEMS. DETERMINE EXACT LOCATIONS IN THE FIELD BASED ON PHYSICAL SIZE AND ARRANGEMENT OF EQUIPMENT, FINISHED ELEVATIONS, EASEMENT LOCATIONS, AND OTHER OBSTRUCTIONS. LOCATIONS SHOWN ON THE DRAWINGS, HOWEVER, SHALL BE ADHERED TO AS CLOSELY AS POSSIBLE.
- 12. THE ELECTRICAL INSTALLATION SHALL COMPLY WITH THE CURRENT VERSION OF THE NEC, LOCAL, AND STATE CODES.



(0)			
EVIEW ONLY		DESCRIPTION	EVISIONS

# Ö 'UPGRADES CAPACITY ( I VALLEY WATER CO PIPELINE ( HERRIMAN AND RIV


ROSECREST

JS, ES	010-24
ELECTRICAL LEGENDS, SYMBOLS, AND NOTES	PROJECT
ELECTRIC SYMBOLS	MARCH 2025

DRAWING NO. E-01 SHEET 65 OF 78

dV/dt

dV/dt FILTER

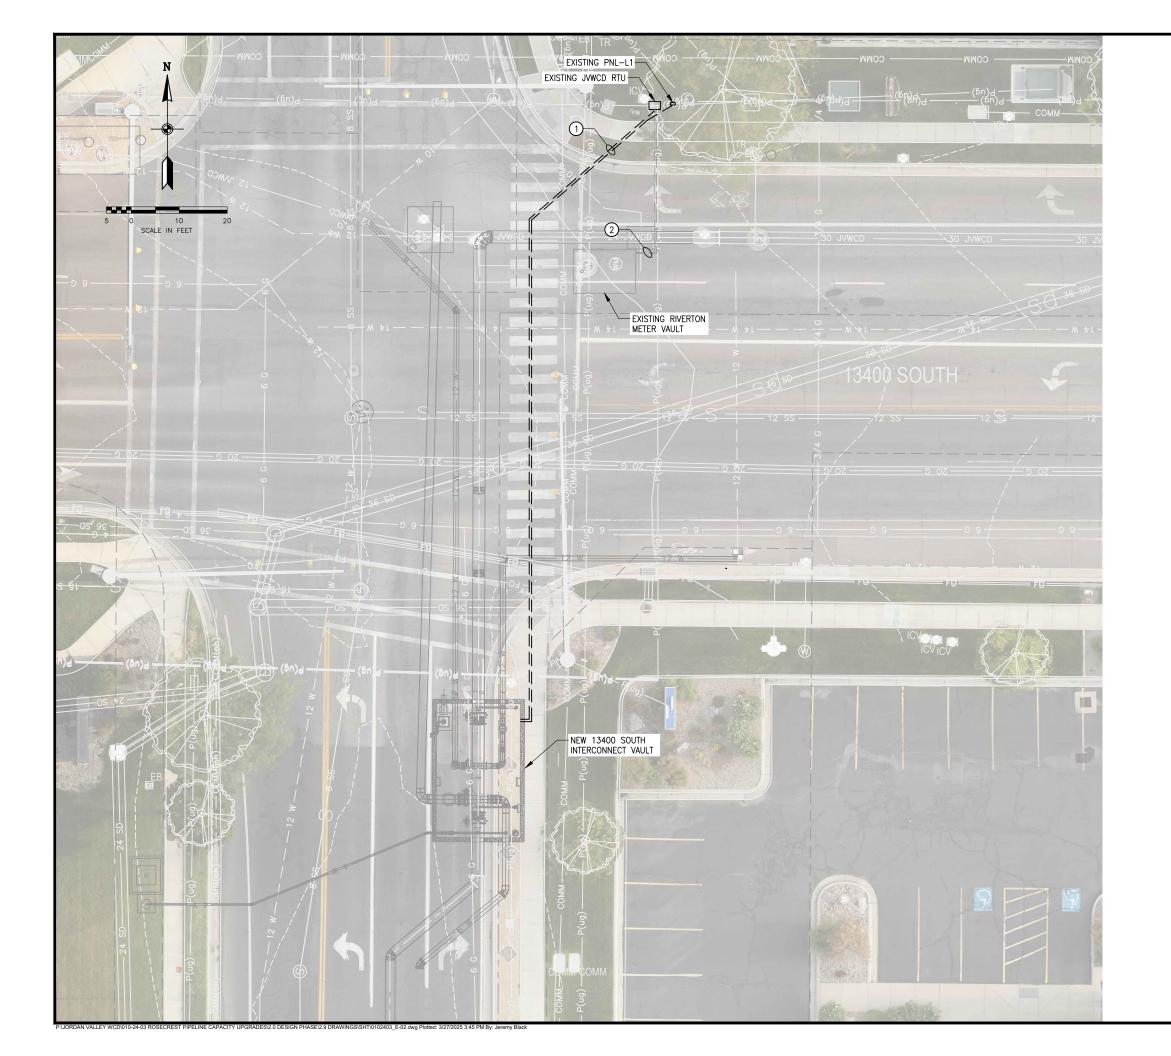

#### **GENERAL NOTES:**

- A. SEE LIGHTING PLAN ON SHEET E-03 AND ELECTRICAL PLAN ON DRAWING E-04 FOR EQUIPMENT LOCATIONS INSIDE THE 13400 SOUTH INTERCONNECT VAULT.
- B. SEE POWER ONE-LINE DIAGRAM ON SHEET E-05 AND CONTROL BLOCK DIAGRAM ON SHEET E-06 FOR INFORMATION REGARDING CONDUIT AND CONDUCTORS.

## KEY NOTES: #

- 1. FURNISH AND INSTALL NEW CONDUIT AND CONDUCTOR FROM EXISTING JYWCD RTU AND PNL-L1 TO NEW 13400 SOUTH INTERCONNECT VAULT. SEE POWER ONE-LINE DIAGRAM ON SHEET E-05 AND CONTROL BLOCK DIAGRAM ON SHEET E-06 FOR MORE INFORMATION.
- 2. REMOVE AND DISPOSE OF CONDUIT AND CONDUCTOR FROM EXISTING JVWCD RTU AND PNL-L1 TO EXISTING RIVERTON METER VAULT. SEE POWER ONE-LINE DIAGRAM ON SHEET E-05 AND CONTROL BLOCK DIAGRAM ON SHEET E-06 FOR MORE INFORMATION.




JORDAN VALLEY WATER CONSERVANCY DISTRICT
ROSECREST PIPELINE CAPACITY UPGRADES
HERRIMAN AND RIVERTON CITY, UT

13400 SOUTH INTERCONNECTION VAULT SITE PLAN

DRAWING NO.

E-02 SHEET 66 OF 78

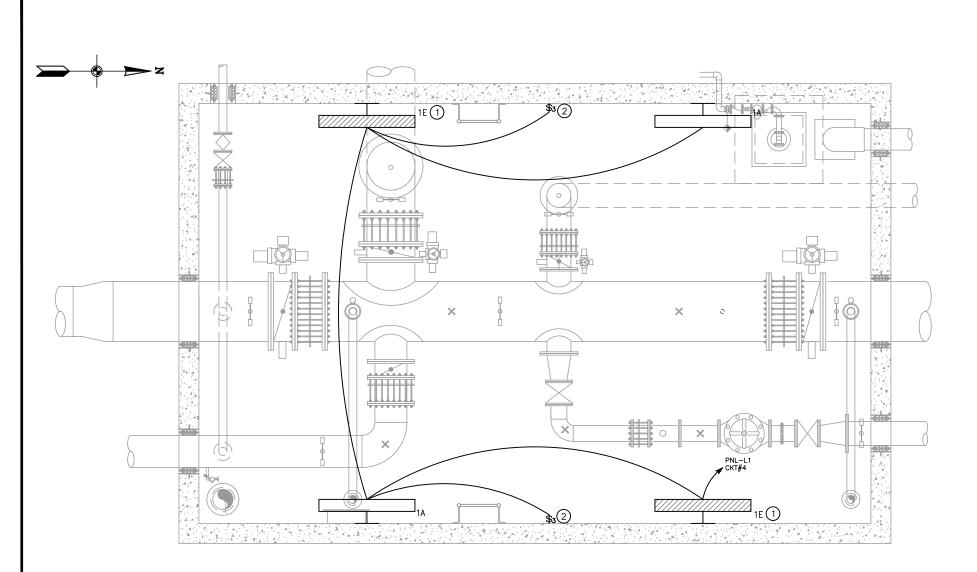

# 13400 SOUTH INTERCONNECTION VAULT LIGHTING PLAN SCALE: 1/2" = 1'-0"

FIXTURE SCHEDULE								
SYMBOL	DESCRIPTION	MANUFACTURER	CATALOG NO.	VA	LAMP	MOUNTING	NOTES	
	ENCLOSED INDUSTRIAL, FIBERGLASS HOUSING GASKETED, LED, 120 VOLT	HOLOPHANE	EVT4 4000LM PCL MD 120 40K 90CRI	33			USE BRACKETS TO MOUNT FIXTURE AT 45-DEGREE ANGLE.	
	ENCLOSED INDUSTRIAL, FIBERGLASS HOUSING GASKETED, LED, 120 VOLT, INTERNAL EMERGENCY BATTERY	HOLOPHANE	EVT4 4000LM PCL MD 120 40K 90CRI BSL722C	33			USE BRACKETS TO MOUNT FIXTURE AT 45-DEGREE ANGLE.	

#### **GENERAL NOTES:**

A. CONCEAL CONDUIT IN WALLS, FLOOR, AND CEILING TO EXTENT POSSIBLE. ALL EXPOSED CONDUIT, BOXES, AND FITTINGS IN THE VAULT SHALL BE GALVANIZED RIGID STEEL SUPPORTED ON ZINC COATED STRUT OR BACKSTRAP CLAMPS. SEALTITE (NOT TO EXCEED 24") MAY BE USED WHERE REQUIRED. CONDUIT EMBEDDED IN CONCRETE SHALI BE SCHEDULE 40 PVC CONDUIT, TRANSITIONS FROM EMBEDDED CONDUIT TO EXPOSED CONDUIT SHALL BE MADE WITH PVC COATED GALVANIZED RIGID STEEL CONDUIT.



C. CONDUIT BODIES AND BOXES FOR WIRING DEVICES SHALL BE MALLEABLE CAST IRON.

### KEY NOTES: #

- PROVIDE UNSWITCHED HOT WIRE TO EACH EMERGENCY FIXTURE FOR NORMAL POWER SENSE.
- 2. MOUNT LIGHT SWITCH JUST BELOW HATCH SO THAT LIGHTS CAN BE TURNED ON BEFORE ENTERING THE VAULT.






	N	OT FO FOR	NOT FOR CONSTRUCTION FOR REVIEW ONLY
NO.	DATE	REV. BY	DESCRIPTION
			REVISIONS

JORDAN VALLEY WATER CONSERVANCY DISTRICT
ROSECREST PIPELINE CAPACITY UPGRADES
HERRIMAN AND RIVERTON CITY, UT

13400 SOUTH INTERCONNECTION VAULT LIGHTING PLAN

DRAWING NO. E-03

SHEET 67 OF 78

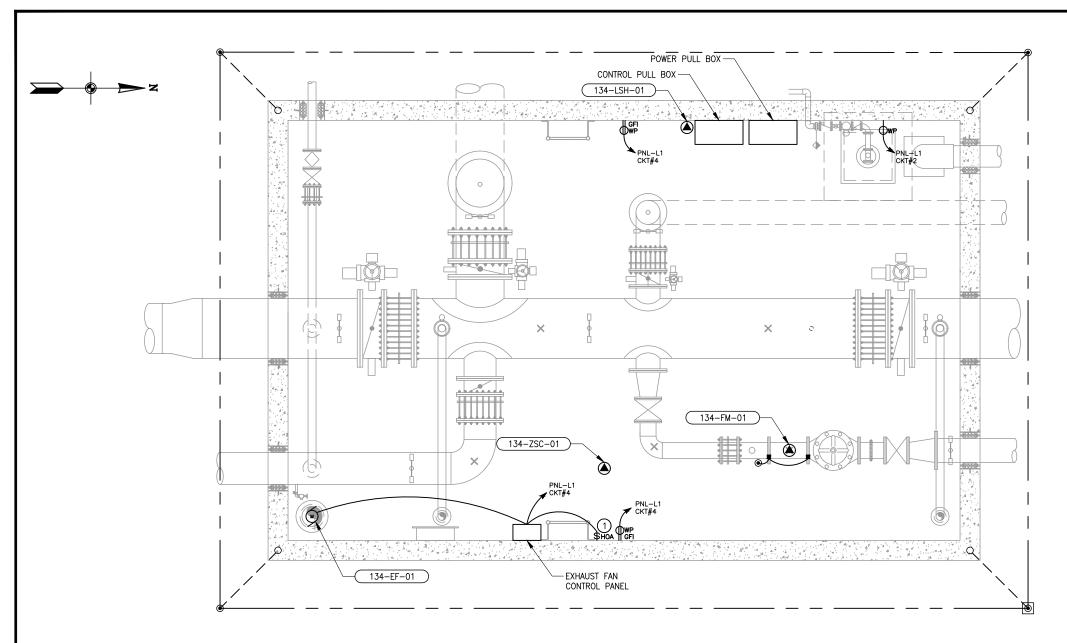

13400 SOUTH INTERCONNECTION VAULT ELECTRICAL PLAN SCALE: 1/2" = 1'-0"

#### **GENERAL NOTES:**

- A. CONCEAL CONDUIT IN WALLS, FLOOR, AND CEILING TO EXTENT POSSIBLE. CONDUITS TO EQUIPMENT IN CENTER OF ROOM WILL BE EMBEDDED IN FLOOR. SUPPORT ELECTRICAL CONDUITS INDEPENDENT OF PIPING. SUPPORTING ELECTRICAL CONDUITS OFF PIPING WILL NOT BE ALLOWED.
- B. ALL EXPOSED CONDUIT, BOXES, AND FITTINGS IN THE VAULT SHALL BE GALVANIZED RIGID STEEL SUPPORTED ON ZINC COATED STRUT OR BACKSTRAP CLAMPS. SEALTITE (NOT TO EXCEED 24") MAY BE USED WHERE REQUIRED. CONDUIT EMBEDDED IN CONCRETE SHALL BE SCHEDULE 40 PVC CONDUIT, TRANSITIONS FROM EMBEDDED CONDUIT TO EXPOSED CONDUIT SHALL BE MADE WITH PVC COATED GALVANIZED RIGID STEEL CONDUIT.
- C. FOR INFORMATION REGARDING CONDUIT AND CONDUCTOR QUANTITY AND SIZES, SEE POWER ONE-LINE DIAGRAM ON SHEET E-05 AND CONTROL BLOCK DIAGRAM ON SHEET
- D. CONDUIT BODIES AND BOXES FOR WIRING DEVICES SHALL BE MALLEABLE CAST IRON.

#### KEY NOTES: #

1. MOUNT HOST TICH JUST BELOW HATCH SO THAT LIGHTS CAN BE TOWNED ON BEFORE ENTERING THE VAULT.



1/2		
	/	


	_			
NOT FOR CONSTRUCTION	FOR REVIEW ONLY		DESCRIPTION	REVISIONS
)T F0	FOR		REV. BY	
N(			DATE	

Ö JORDAN VALLEY WATER CONSERVANCY DISTRICT
ROSECREST PIPELINE CAPACITY UPGRADES
HERRIMAN AND RIVERTON CITY, UT


13400 SOUTH INTERCONNECTION VAULT ELECTRICAL PLAN

E-04

SHEET 68 OF 78

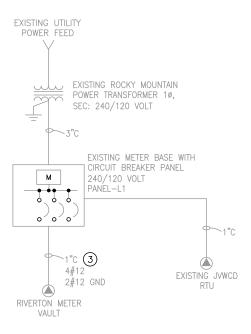


## EXISTING POWER ONE-LINE DIAGRAM

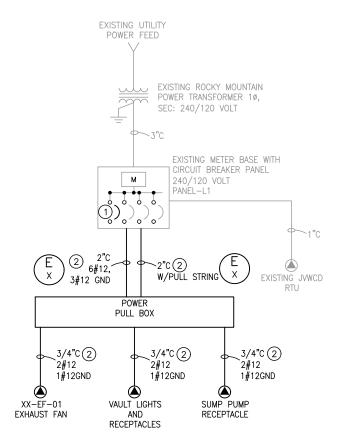

MODIFIED POWER ONE-LINE DIAGRAM

#### JORDAN VALLEY WATER CONSERVANCY DISTRICT INTERCONNECTION VAULT PANEL: PNL L1 VOLT:240/120 AMP:100 PHASE:1 WIRE:3 LOCATION: NOTE AIC RATING: 10,000 TYPE: SURFACE MOUNT **GROUND BUS:** YES TYPE OF MAIN: MOUNTING: SURFACE FEEDER: SEE ONE-LINE FED FROM: SEE ONE-LINE BRK CKT CIRCUIT DESCRIPTION AMP NO NO AMP CIRCUIT DESCRIPTION WATER METER MAIN DISCONNECT 20 RIVERTON SUMP PUMP RECEPT JVWCD RTU 20 1000 SPACE PHASE TOTALS 180 1000 TOTAL WATTS TOTAL AMPS 3/14/25

## EXISTING PANEL SCHEDULE

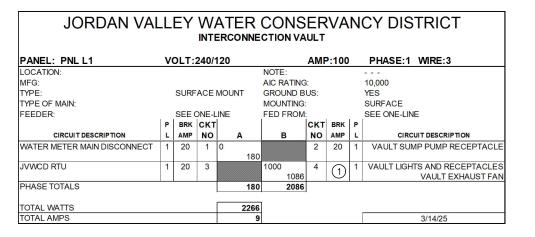

MODIFIED PANEL SCHEDULE

#### **GENERAL NOTES:**

A. FOR EQUIPMENT LOCATIONS SEE SITE PLAN ON SHEET E-02, LIGHTING PLAN ON SHEET E-03, AND ELECTRICAL

#### KEY NOTES: (#)

- 1. FURNISH AND INSTALL EATON BD2020 PLUG-ON TANDEM BREAKER. ONE CIRCUIT SHALL FEED THE VAULT LIGHTS ANI RECEPTACLES, THE OTHER SHALL FEED THE VAULT EXHAUS
- 2. FURNISH AND INSTALL CONDUIT AND CONDUCTORS.
- 3. DEMOLISH AND DISPOSE OF CONDUIT/CONDUCTORS BETWEEN POWER PANEL L1 AND THE RIVERTON METER






JORDAN VALLEY WATER CONSERVANCY DISTRICT
ROSECREST PIPELINE CAPACITY UPGR
HEPRIMAN AND RIVERTON CITY IT

13400 SOUTH INTERCONNECTION VAULT POWER ONE-LINE DIAGRAM


DRAWING NO. E-05

SHEET 69 OF 78

Xref ..\..\2.7 Standard Drawinas\Ref\XXXXXXX Border.dwa

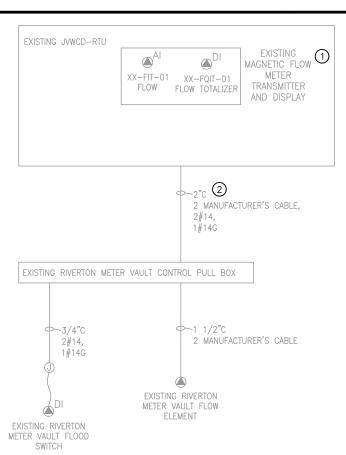

## EXISTING CONTROL BLOCK DIAGRAM

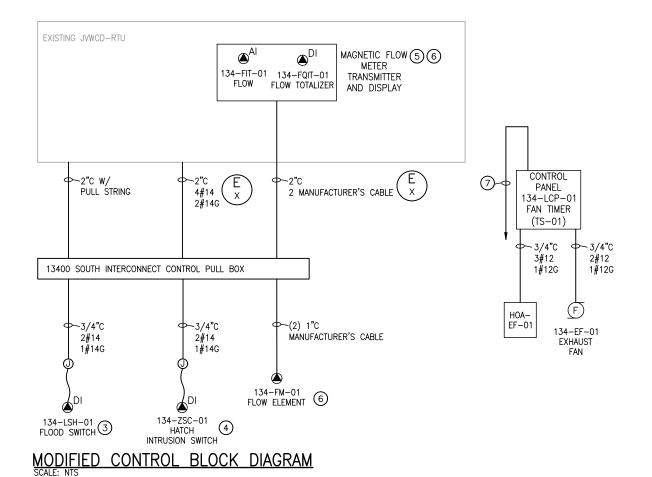

#### **GENERAL NOTES:**

Α. ...

#### KEY NOTES: #

- REMOVE AND DISPOSE OF FLOW METER DISPLAY IN EXISTING JVWCD RTU.
- 2. DEMOLISH AND DISPOSE OF CONDUIT/CONDUCTORS BETWEEN POWER EXISTING JVWCD RTU AND EXISTING RIVERTON METER VAULT.
- 3. FURNISH AND INSTALL FLOOD SWITCH PER DETAIL (E)
- 4. FURNISH AND INSTALL HATCH INSTRUCTION SWITCH PER DETAIL E
- 5. FLOW TRANSMITTER/METER SHALL BE POWERED BY 120VAC SUPPLY IN EXISTING JVWCD RTU.
- 6. FURNISH AND INSTALL MAGNETIC FLOW METER, FLOW ELEMENT, AND TRANSMITTER. FLOW METER SHALL BE ENDRESS+HAUSER PROLINE PROMAG W 400 OR ROSEMOUNT 8750W, NO EQUALS. FLOWTUBE SHALL BE SIZED TO MATCH PIPELINE. FLOW TRANSMITTER SHALL BE CAPABLE OF MODBUS RS485 COMMUNICATION. INSTALL PER DETAIL E
- 7. POWER SUPPLIED FROM PNL-L1. SEE POWER ONE-LINE DIAGRAM ON SHEET E-05 FOR MORE INFORMATION.



(g)		


V			
FOR REVIEW ONLY		DESCRIPTION	REVISIONS
FOR		REV. BY	
		DATE	


CAPACIT	CAPACITY UPGRADES		
/ERTON CITY, UT	Т		
EVIEW	VERIFY SCALE		
	NO HONE INC SI GV G		
OUNGSTROM	ORIGINAL DRAWING	ON.	NO. DAT

JOSECREST PIPELINE - HERRIMAN AND RIV

13400 SOUTH INTERCONNECTION VAULT CONTROL BLOCK DIAGRAM

DRAWING NO. E-06 SHEET 70 OF 78

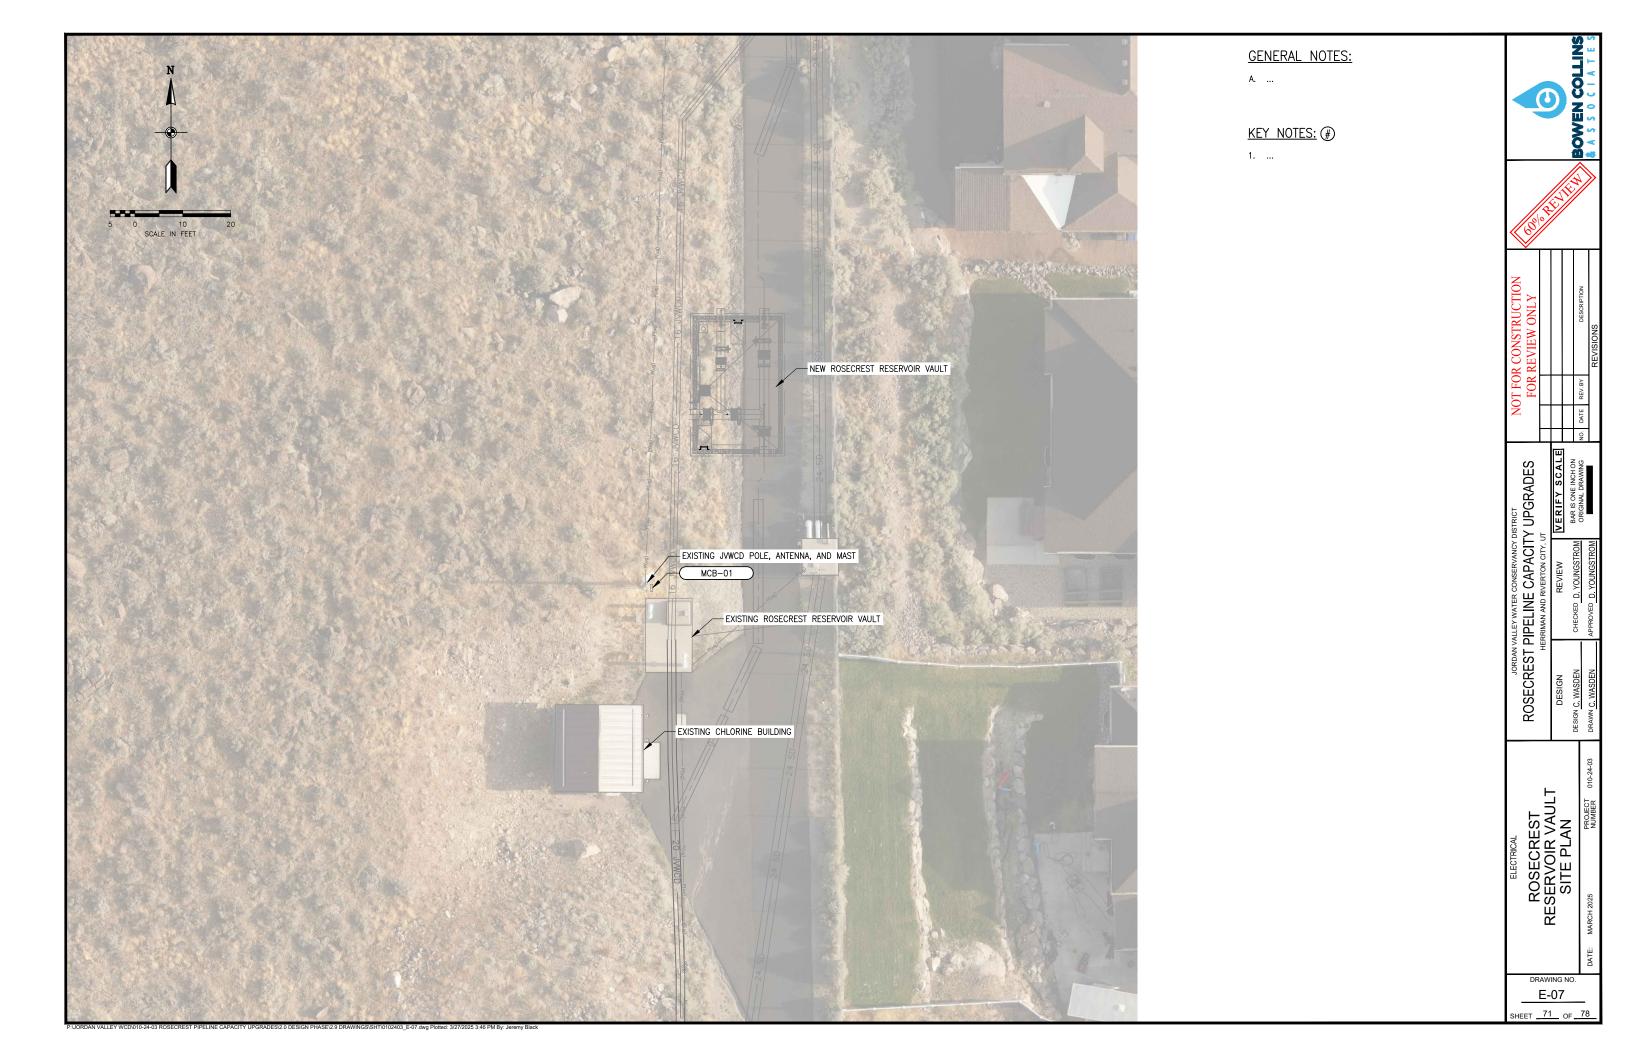

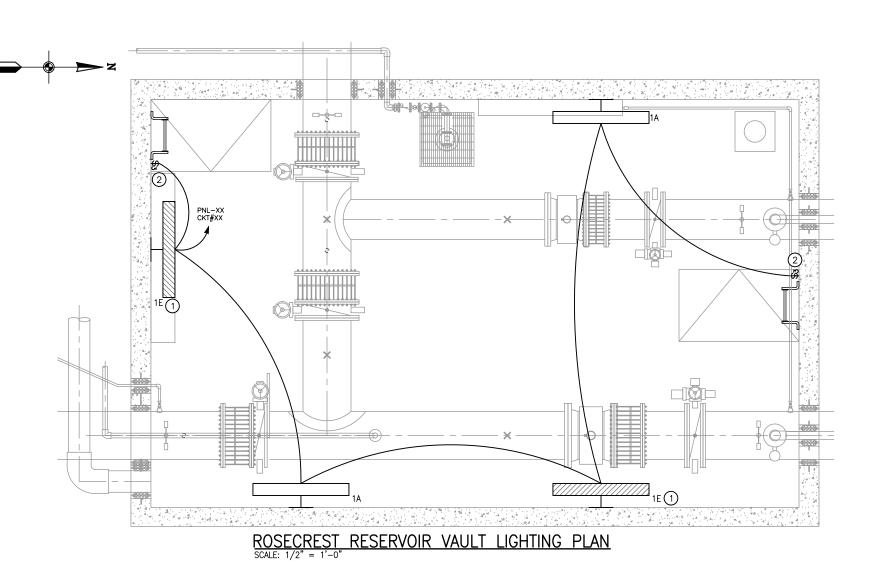

FIXTURE SCHEDULE							
SYMBOL	DESCRIPTION	MANUFACTURER	CATALOG NO.	VA	LAMP	MOUNTING	NOTES
1A	ENCLOSED INDUSTRIAL, FIBERGLASS HOUSING GASKETED, LED, 120 VOLT	HOLOPHANE	EVT4 4000LM PCL MD 120 40K 90CRI	33	LED	WALL AT 8'-0" AFF	USE BRACKETS TO MOUNT FIXTURE AT 45-DEGREE ANGLE.
1E	ENCLOSED INDUSTRIAL, FIBERGLASS HOUSING GASKETED, LED, 120 VOLT, INTERNAL EMERGENCY BATTERY	HOLOPHANE	EVT4 4000LM PCL MD 120 40K 90CRI BSL722C	33	LED	WALL AT 8'-0" AFF	USE BRACKETS TO MOUNT FIXTURE AT 45-DEGREE ANGLE.

#### **GENERAL NOTES:**

- A. CONCEAL CONDUIT IN WALLS, FLOOR, AND CEILING TO EXTENT POSSIBLE. ALL EXPOSED CONDUIT, BOXES, AND FITTINGS IN THE VAULT SHALL BE GALVANIZED RIGID STEEL SUPPORTED ON ZINC COATED STRUT OR BACKSTRAP CLAMPS. SEALTITE (NOT TO EXCEED 24") MAY BE USED WHERE REQUIRED. CONDUIT EMBEDDED IN CONCRETE SHALI BE SCHEDULE 40 PVC CONDUIT, TRANSITIONS FROM EMBEDDED CONDUIT TO EXPOSED CONDUIT SHALL BE MADE WITH PVC COATED GALVANIZED RIGID STEEL CONDUIT.
- B. FOR INFORMATION REGARDING CONDUIT AND CONDUCTOR QUANTITY AND SIZES, SEE PANEL SCHEDULE ON SHEET
- C. CONDUIT BODIES AND BOXES FOR WIRING DEVICES SHALL BE MALLEABLE CAST IRON.

#### KEY NOTES: #

- 1. PROVIDE UNSWITCHED HOT WIRE TO EACH EMERGENCY FIXTURE FOR NORMAL POWER SENSE.
- MOUNT LIGHT SWITCH JUST BELOW HATCH SO THAT LIGHTS CAN BE TURNED ON BEFORE ENTERING THE VAULT.






JORDAN VALLEY WATER CONSERVANCY DISTRICT
ROSECREST PIPELINE CAPACITY UPGRADES
HERRIMAN AND RIVERTON CITY, UT

ROSECREST RESERVOIR VAULT LIGHTING PLAN

E-08

SHEET 72 OF 78

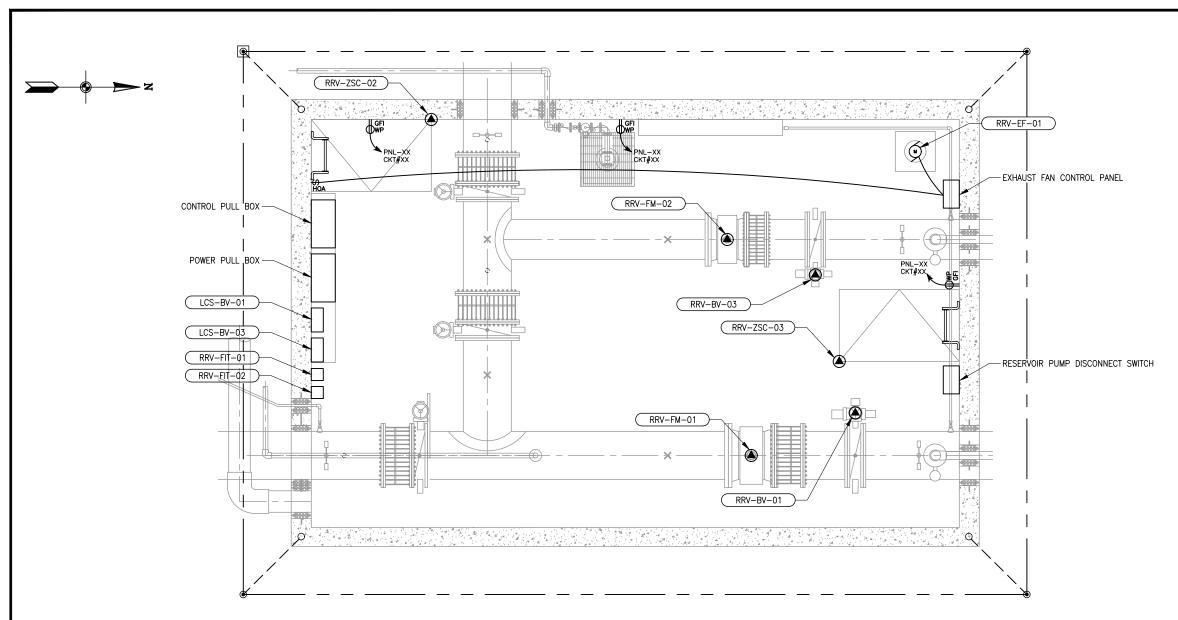

ROSECREST RESERVOIR VAULT ELECTRICAL PLAN SCALE: 1/2" = 1'-0"

#### **GENERAL NOTES:**

- A. CONCEAL CONDUIT IN WALLS, FLOOR, AND CEILING TO EXTENT POSSIBLE. CONDUITS TO EQUIPMENT IN CENTER OF CONDUITS INDEPENDENT OF PIPING. SUPPORTING
- ZINC COATED STRUT OR BACKSTRAP CLAMPS. SEALTITE (NOT TO EXCEED 24") MAY BE USED WHERE REQUIRED.
- C. FOR INFORMATION REGARDING CONDUIT AND CONDUCTOR QUANTITY AND SIZES, SEE POWER ONE-LINE DIAGRAM ON SHEET E-10 AND CONTROL BLOCK DIAGRAM ON SHEET
- D. CONDUIT BODIES AND BOXES FOR WIRING DEVICES SHALL BE MALLEABLE CAST IRON.

#### KEY NOTES: #

1. ...




JORDAN VALLEY WATER CONSERVANCY DISTRICT
ROSECREST PIPELINE CAPACITY UPGRADES
HERRIMAN AND RIVERTON CITY, UT


ROSECREST RESERVOIR VAULT ELECTRICAL PLAN

E-09


SHEET 73 OF 78

ROOM WILL BE EMBEDDED IN FLOOR. SUPPORT ELECTRICAL ELECTRICAL CONDUITS OFF PIPING WILL NOT BE ALLOWED. B. ALL EXPOSED CONDUIT, BOXES, AND FITTINGS IN THE VAULT SHALL BE GALVANIZED RIGID STEEL SUPPORTED ON

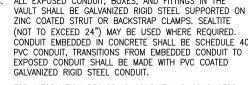

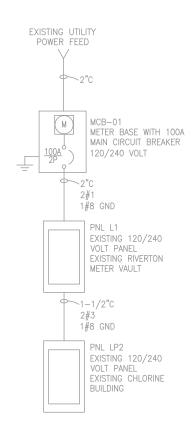

# EXISTING POWER ONE—LINE DIAGRAM SCALE: NTS

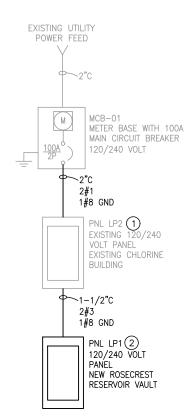

MODIFIED POWER ONE—LINE DIAGRAM SCALE: NTS

#### **GENERAL NOTES:**

Α. ..

#### KEY NOTES: #

- 1. REPLACE EXISTING 70A MCB WITH 100A MCB.
- 2. FURNISH AND INSTALL NEW PANELBOARD WITH 80A MCB.



(Se)		

JORDAN VALLEY WATER CONSERVANCY DISTRICT
ROSECREST PIPELINE CAPACITY UPGRADES
HERRIMAN AND RIVERTON CITY, UT

ROSECREST RESERVOIR VAULT POWER ONE-LINE DIAGRAM

DRAWING NO.

E-10 SHEET \_\_74\_\_ OF \_\_78

